

LAKE TOWNSHIP - LOGAN COUNTY, OHIO
VIRGINIA MILITARY SURVEY NO. 3317

THE BEARINGS IN THE SURVEY REFER TO THE CENTERLINE
OF U.S. ROUTE 68 AS BEING S 15° 31' 30" W.



MIAMI VALLEY DEVELOPMENT COMPANY
VOL. 306 PG. 197 11.604 AC
N 04° 58' 48" W 1180.54'
914.58'

12.572 AC MIAMI VALLEY DEVELOPMENT COMPANY
O.R. VOL. 3 PG. 697
- 6.189 AC TO DAYTON POWER AND LIGHT COMPANY
6.383 AC REMAINING

N 72° 11' E 795'
K. H. MOON
2.83 AC EXCEPTION VOL. 350 PG. 796-797

6.189 ACRES

LEGEND
● = IRON PIN FOUND

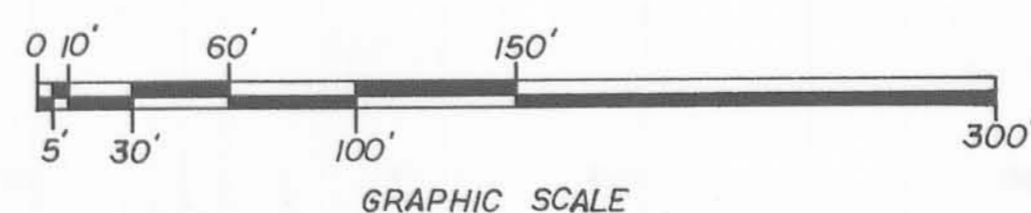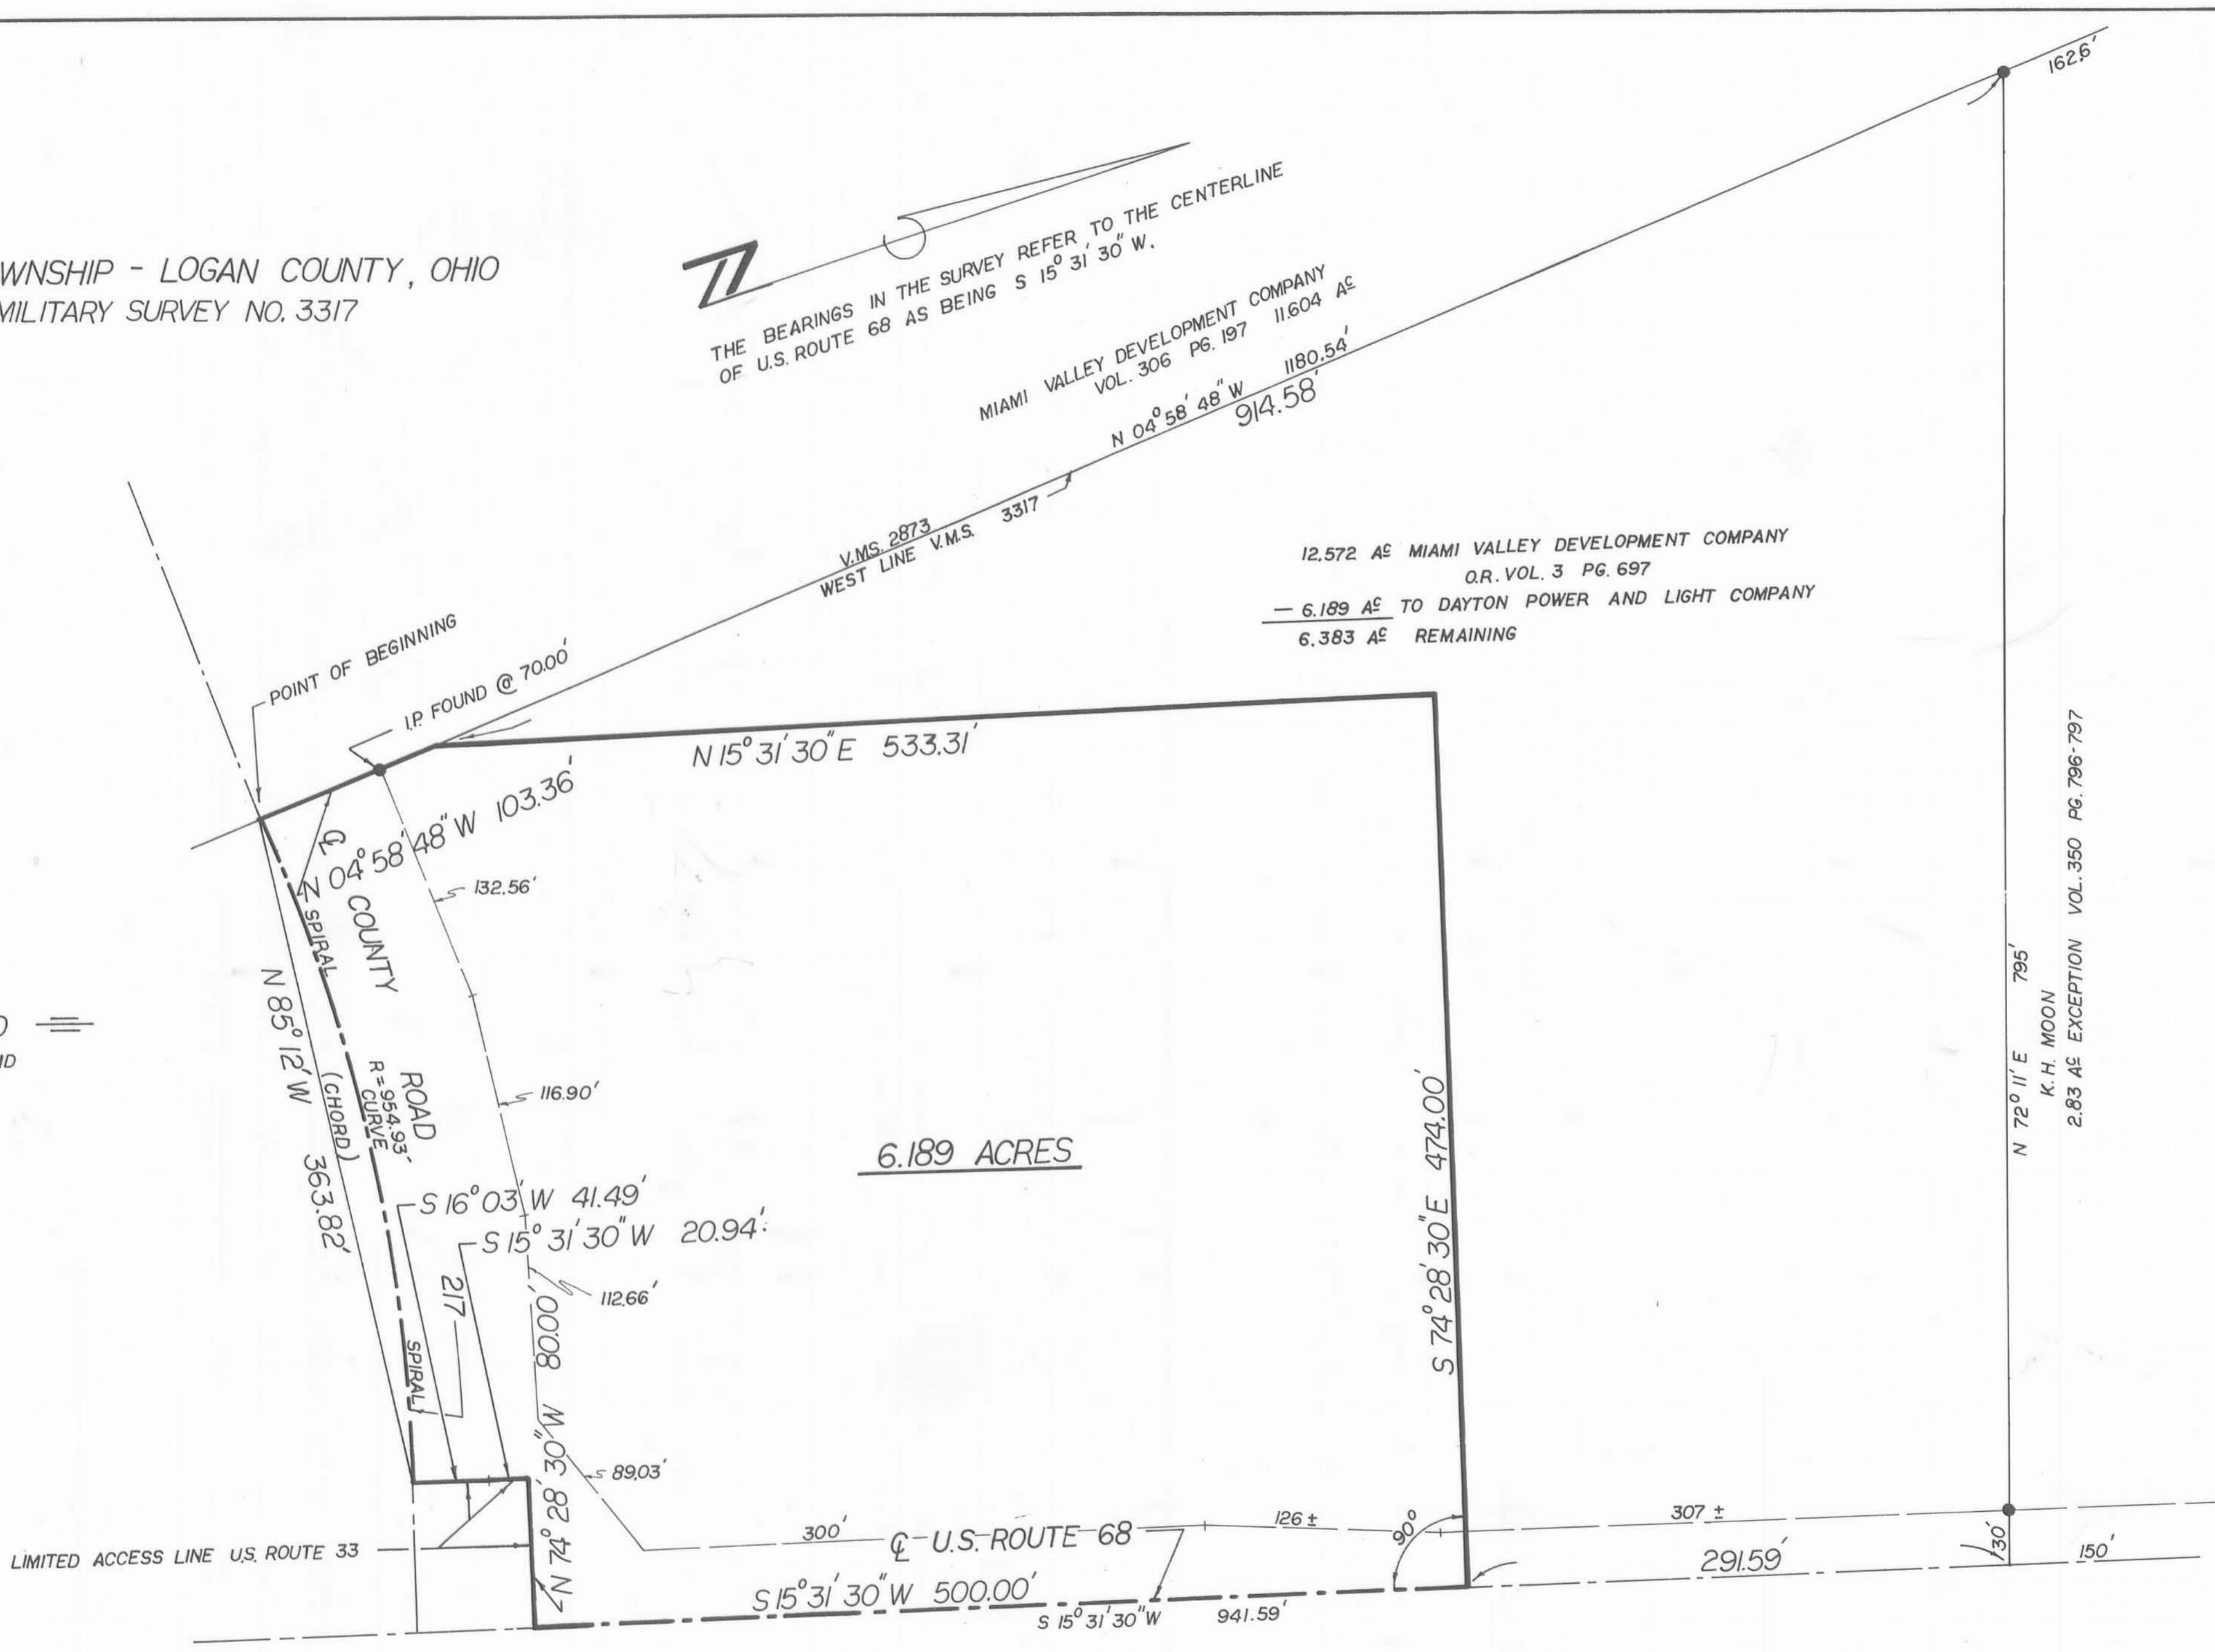

BY RICHARD W. ANDERS, A PROFESSIONAL SURVEYOR NO. 5850
ON AUGUST 7, 1985, AND IS BASED ON A SURVEY OF A
15.402 ACRE TRACT BY THOMAS C. HUBBEL, PROFESSIONAL
SURVEYOR NO. 5044 IN AUGUST 1968.

Richard W. Anders
RICHARD W. ANDERS - PROFESSIONAL SURVEYOR NO. 5850



TITLE		
SURVEY OF 6.189 ACRE PARCEL		
FOR		
DAYTON POWER AND LIGHT COMPANY		
SCALE	PROJECT	MAP SEC.
GRAPHIC	06920	
DRAWN	APPROVED	
YOUNG	8-8-85	
CHECKED	APPROVED	
R. W. A.	8-13-85	
ENGINEER	APPROVED	



SHEET OF SHEETS