


Reference Deed:
 Donald W. Campbell et al
 O. R. No. 347 P. 698 (12-27-1997).

- SYMBOLS:
- - P K. Nail Fd.
 - - R. R. Spike Fd.
 - ⊕ - 3/4" Iron Pipes Fd.
 - ⊖ - 5/8" Rebars Fd.
 - - 5/8 x 30 Rebars Set.

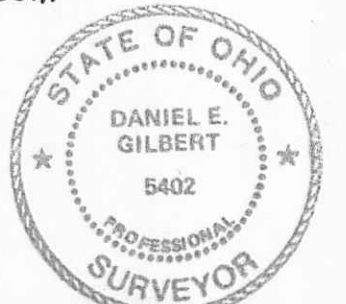

Donald W. Campbell Surveys - V.M.S. No. 3683,
 Jefferson-Lake Townships, Logan County, Ohio.

SCALE: 1" = 100'	APPROVED BY:	DRAWN BY DEG
DATE: 11-19-2004		REVISED
Daniel E. Gilbert, P.S. Daniel E. Gilbert, P.S. Reg. Sur. No. 5402		DRAWING NUMBER 2004-033

INDEXED ON MAP
 6267
 S-371