


Vacated
16.50 Foot Alley

Lot 406 pt.
Ova Real Estate, Inc.
O. R. No. 528 P 927 (10-29-2001)
17-091-11-14-004.000

Lot 405 pt.
Thomas R. Smith et al
O. R. No. 585 P 393 (8-19-2002)
17-091-11-14-005.000

Lot 404 pt.
Clara B. Brown
O. R. No. 350 P 488 (1-28-1998)
17-091-11-14-006.000

West Sandusky Avenue - 70'
S. R. No. 47
Plan L-51 Sheets 17-18

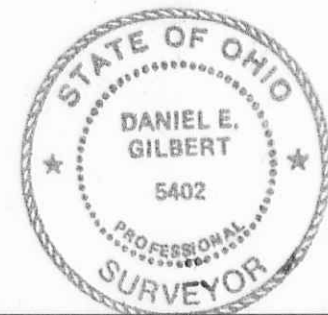

Scale: 1" = 20'

- SYMBOLS:
- - 5/8" Rebar Fd.
 - - 1" Iron Pipes Fd.
 - - 5/8 x 30" Rebars Set.

Reference:
WESTERN BELLEFONTAINE EXTENDED.
Plat Cab. A Slide 3 (4-10-1851)

Survey of Lot No. 405, Western Bellefontaine Extended,
City of Bellefontaine, Lake Township,
Logan County, Ohio.

SCALE: 1" = 20'	APPROVED BY:	DRAWN BY DEG
DATE: 4-3-2004		REVISED

Daniel E. Gilbert
Daniel E. Gilbert, P.S.
Reg. Sur. No. 5402

DRAWING NUMBER
2004-011

INDEXED ON MAP
2214

S-385