


MIAMI AVE. - 30'

AIKEN ST. - 30'

CENTER AVE. - 30'

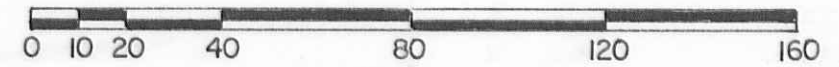


Scale: 1" = 20'

SYMBOLS:

- - 1 1/2" Round Iron Bar Fd.
- ⊗ - 1 1/2" Iron Pipe Fd.
- - 5/8" x 30" Rebars Set.

REFERENCE:

Morning Site Addition (7-19-1926)
Plat Cabinet A Slide 237.

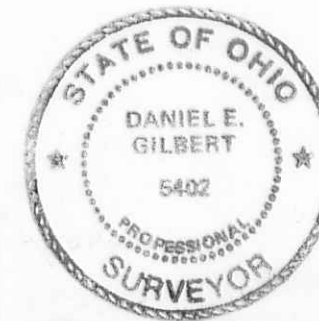

Andrea M. Fernandez Survey - Lots No. 990, 991 & 992,
Village of Russells Point, Washington Township,
Logan County, Ohio.

SCALE: 1" = 20'	APPROVED BY:	DRAWN BY DEG
DATE: 8-3-2002		REVISED

Daniel E. Gilbert, P.S.

Daniel E. Gilbert, P.S.
Reg. Sur. No. 5402

DRAWING NUMBER
2002-014

INDEXED ON MAP
7496

S-417