
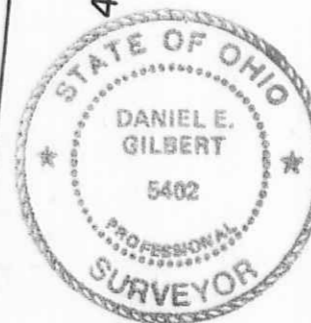


PEPPERBUSH DRIVE - 60'

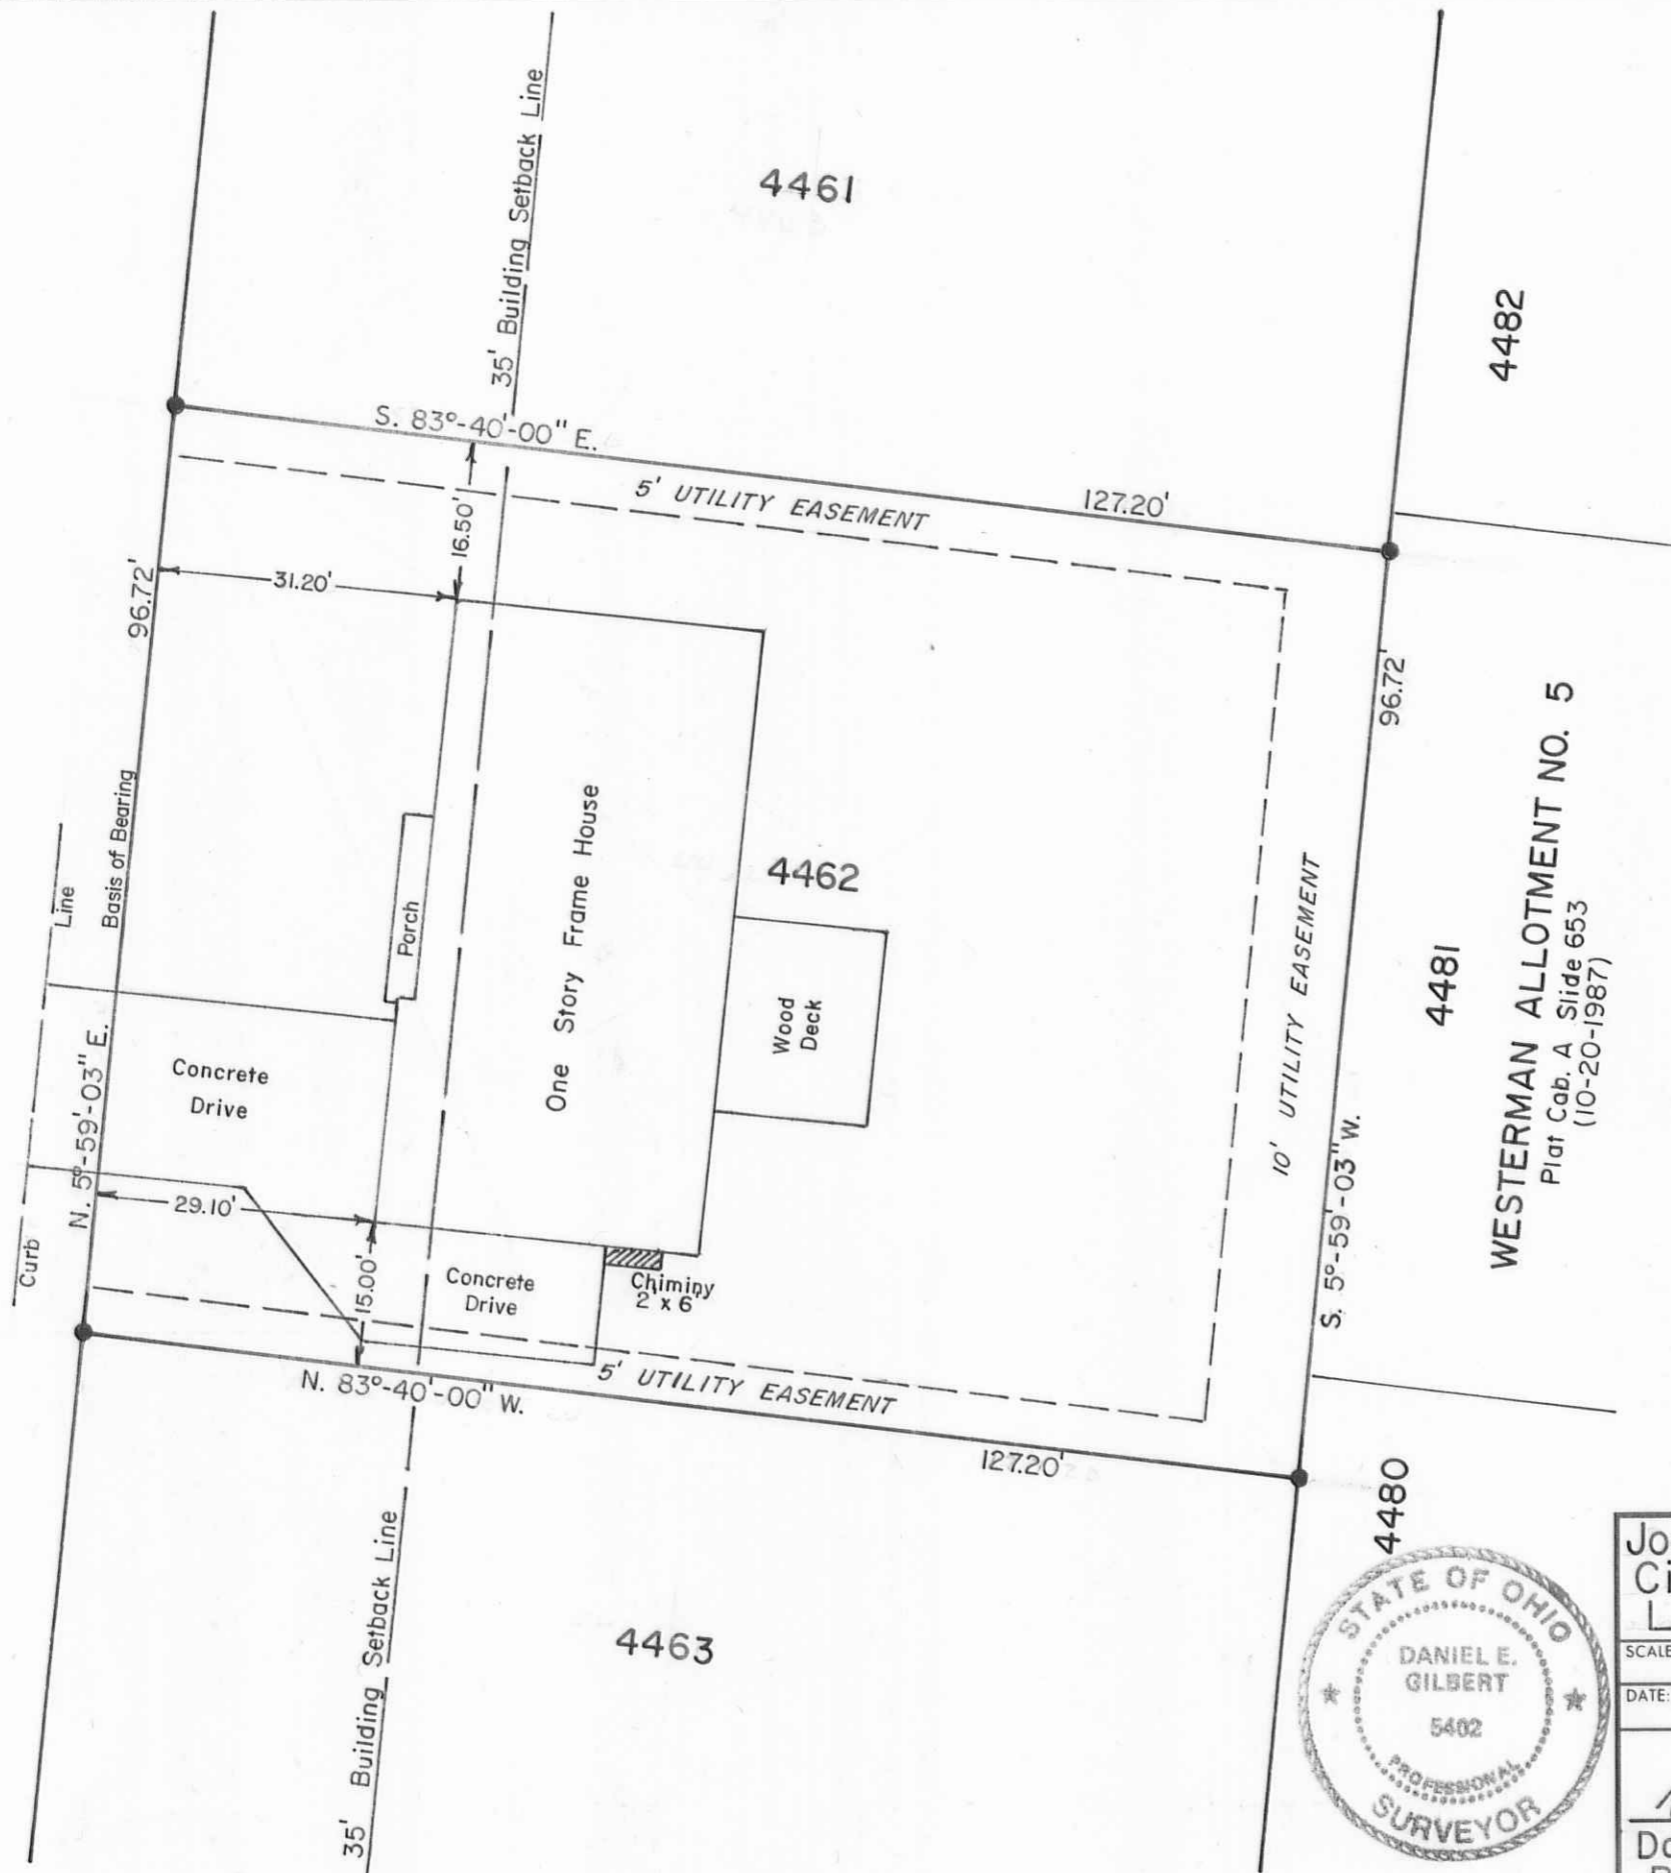


Jonathan D. Bull Survey - Lot No. 4462
 City of Bellefontaine, Lake Township,
 Logan County, Ohio

SCALE: 1" = 20'	APPROVED BY:	DRAWN BY DEG
DATE: 9-27-2001		REVISED

Daniel E. Gilbert

Daniel E. Gilbert, P.S.
 Reg. Sur. No. 5402

DRAWING NUMBER
 2001-035

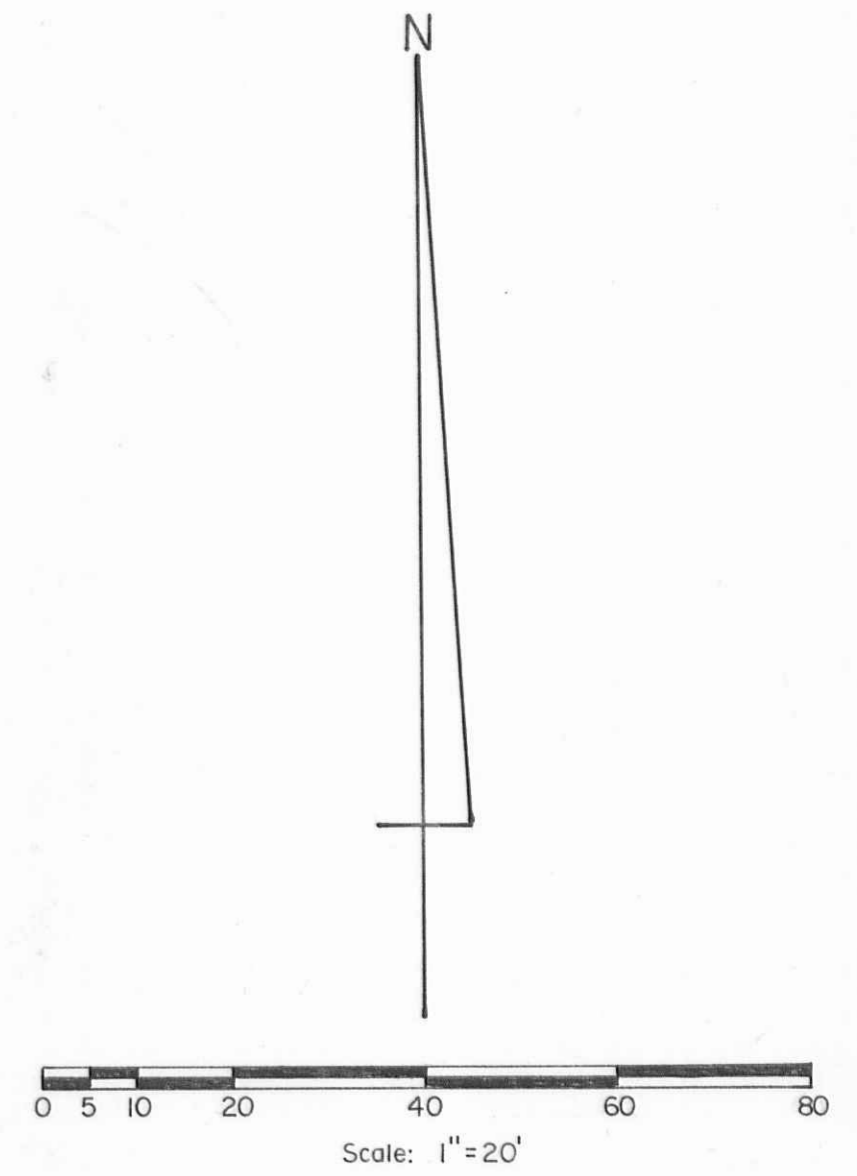

Reference: Westerman Allotment No. 4, Plat Cab. A Slide 631 (12-16-1985).
 SYMBOL: ● - 5/8" Rebars Fd.
 Jonathan D. Bull et al
 O. R. No. 520 Page 554 (9-13-2001).

INDEXED ON MAP
 7458

S-433