

LAWRENCE ST. - 45'

S. 3°-00'-00" W. Basis of Bearing

Lawrence Addition No. 2
Plat Cab. A, Slide 13 (7-24-1897)

Lots No. 962, 963, 964, 965, 966, 967 Part

Ethel M. Hassel
O. R. No. 200 P. 638 (8-31-1993)
17-091-11-04-001.000
Part of Lot No. 967
David L. Helman et ux
O. R. No. 44 P. 514 (6-1-1987)
Part of Tract I
17-091-11-04-002.000

David L. Helman et ux
O. R. No. 44 P. 514 (6-1-1987)
17-091-11-04-002.000

Part of Tract I
Lot No. 962

Lot No. 961
James E. Ziegler et al
O. R. No. 366 P. 981 (6-4-1998)
17-091-11-04-004.000

1/2" Rebar Fd.
N. 3°-00'-00" E.

Tract No. III
0.24 Acres

Robert Crockett
D. Vol. No. 342 P. 212 (7-31-1972)
1" Round Iron
Bar Fd.

Old Walker
17-091-11-04-011.000

0.33 Acres
Tract No. II

David L. Helman et ux
O. R. No. 44 P. 514 (6-11-1987)
17-091-11-04-003.000

Part of Tract I
0.700 Acres

1 1/2" Round Iron Bar Fd.

Switch Track (Track Removed)

S. 86°-42'-00" E.
54.00'

N. 4°-58'-00" E.
6.45'

S. 86°-55'-00" E.

David L. Helman et ux
O. R. No. 44 P. 514 (6-11-1987)
17-091-11-04-020.000

Tract II
2.603 Acres

Mildred I. McArthur
O. R. No. 479 P. 968 (1-15-2001)
17-091-11-04-019.000

0.22 Acres

W. HIGH AVE.
- 40'

2" Iron Pipe Fd.

505.60'

WALKER ST. - 30'

Note: 5/8" x 30" Rebar set at 16.00', because
of obstruction at 15.00'

N. 3°-11'-00" E.

WALKER ST.

1" Rebar in Mon. Box Fd.
(No Cover)

15.00'

W. BROWN AVE.
- 50'

35.00'

15.00'

35.00'

Survey of South Line of David L. Helman Property,
Section No. 35, T.4, R.14, BMRS, City of Bellefontaine,
Lake Township, Logan County, Ohio.

SCALE: 1" = 40'

APPROVED BY:

DRAWN BY DEG

DATE: 4-25-2001

REVISED

Daniel E. Gilbert

Daniel E. Gilbert, P.S.
Reg. Sur. No. 5402



DRAWING NUMBER

2001-008

INDEXED ON MAP

1203

S-449

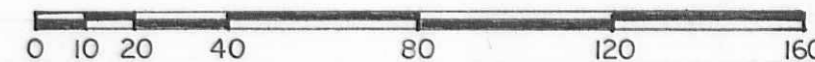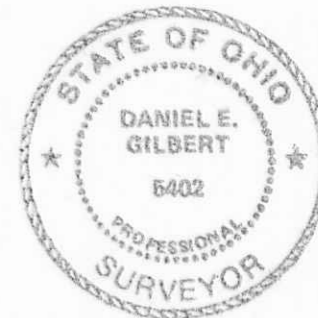

Scale: 1" = 40'

● - 5/8" x 30" Rebars Set.