


Reference:
 Avondale Park Allotment No. 3 (8-2-1928).
 Plat Cabinet A Slide 241.

- SYMBOLS:**
- ⊙ - 1/2" Iron Pipe Fd.
 - - 5/8" Rebars Fd.
 - - 5/8" x 30' Rebar Set.

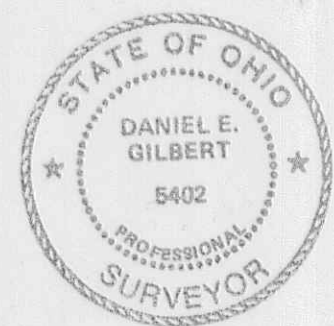

Survey of a part of Lot No. 357
 Avondale Park Allotment No. 3, V.M.S. No. 12276,
 Stokes Townships, Logan County, Ohio.

SCALE: 1" = 20'	APPROVED BY:	DRAWN BY DEG
DATE: 12-2-1997		REVISED

Daniel E. Gilbert
 Daniel E. Gilbert, P.S.
 Reg. Sur. No. 5402

DRAWING NUMBER
 097-045

INDEXED ON MAP
 4742

S-501