


Lowell D. Hill et ux  
 Vol. No. 349 P. 692 (10-13-1973)  
 34-102-00-00-003.000  
 65.55 Acres

Sta. No. 77+60  
 F.B. No. 516 P. 66  
 N. E. Cor. to  
 Taylor tract

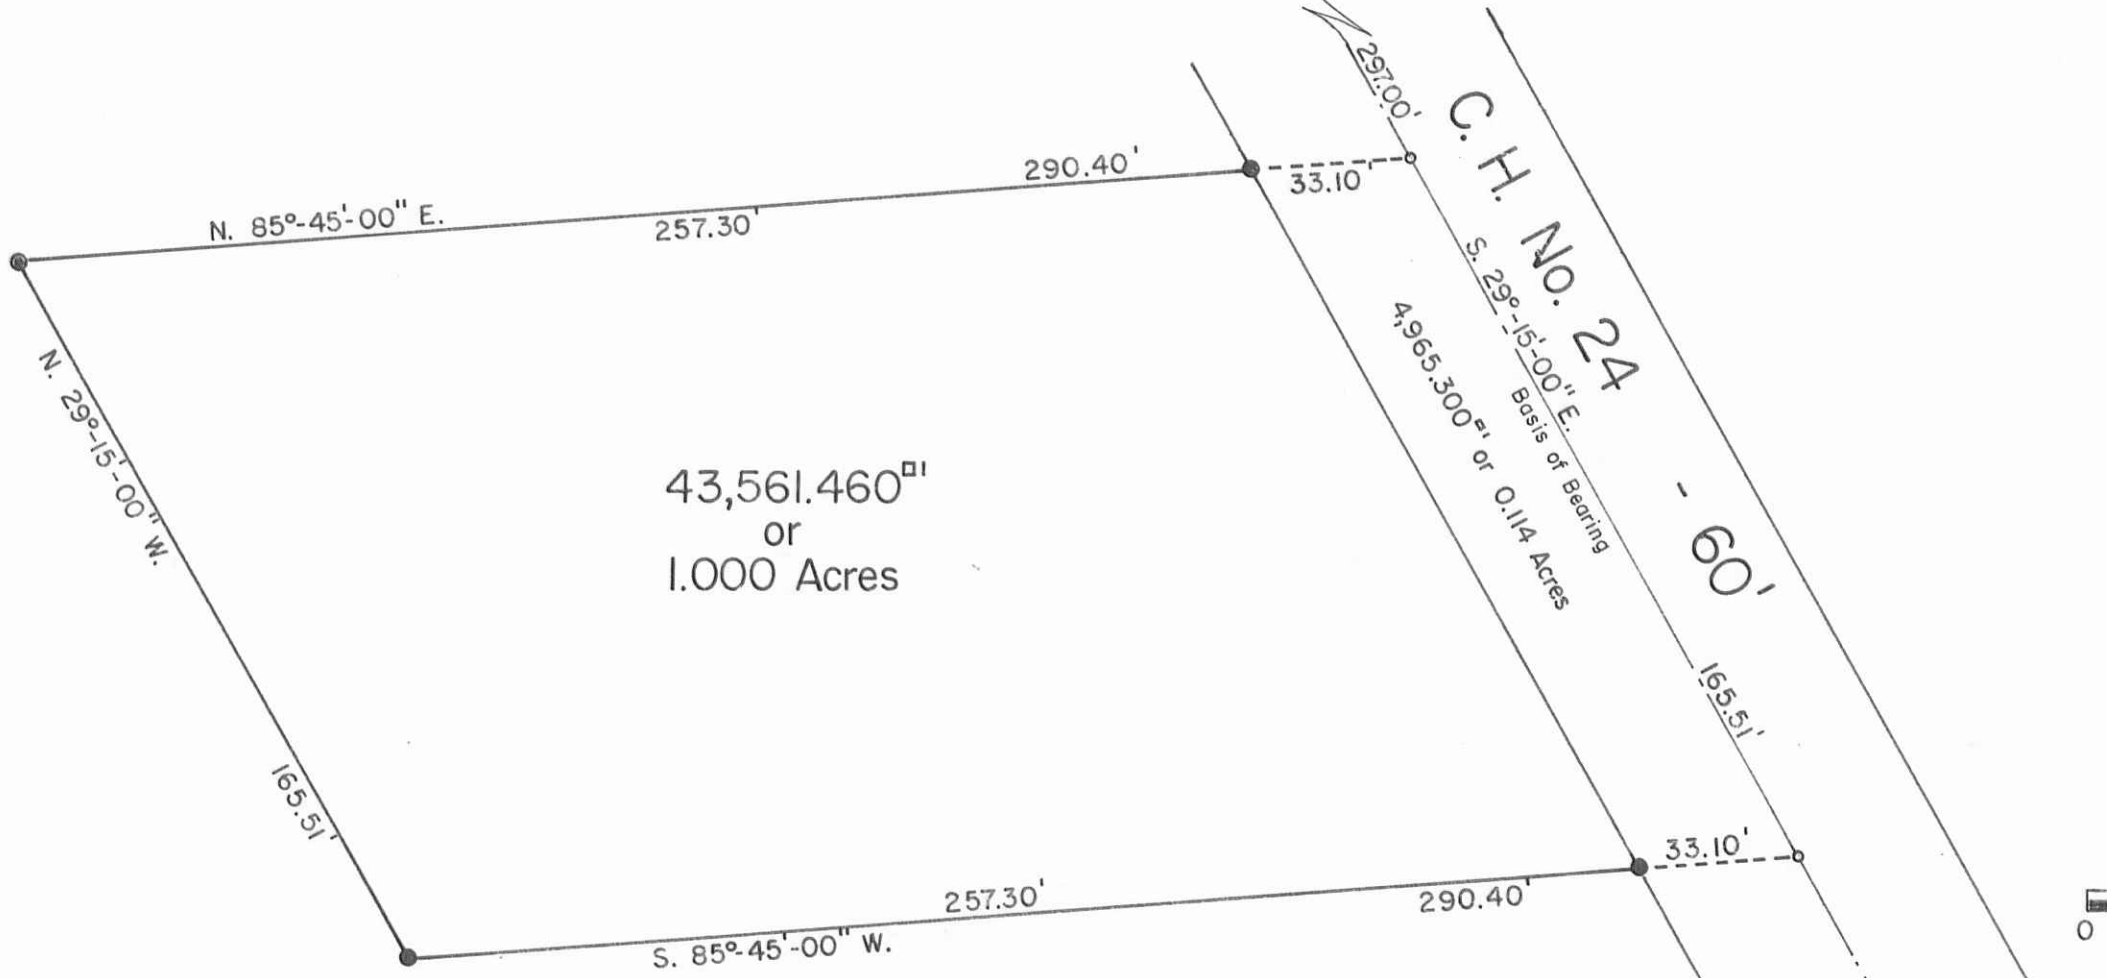

43,561.460<sup>sq</sup>  
 or  
 1.000 Acres

Roger F. Taylor et ux  
 Vol. No. 204 P. 517 (5-17-1952)  
 34-102-00-00-014.000

21.00 Acres

C. H. No. 24  
 S. 29°-15'-00\"/>

4,965.300<sup>sq</sup> or 0.114 Acres  
 Basis of Bearing



Scale: 1" = 40'

SYMBOLS:

- - R. R. Spikes Set.
- - 5/8" x 30" Rebars Set.



AGNES L. TAYLOR SURVEY  
 Section No. 8 Town 2 Range 14, B.M.R.S.  
 Pleasant Township, Logan County, Ohio.

SCALE: 1" = 40'	APPROVED BY:	DRAWN BY: DEG
DATE: 3-27-1997		REVISED:

*Daniel E. Gilbert*  
 Daniel E. Gilbert, P.S.  
 Reg. Sur. No. 5402

DRAWING NUMBER  
 097-010

INDEXED ON MAP  
 9121

S-550