


EAGLE PATH - 35'

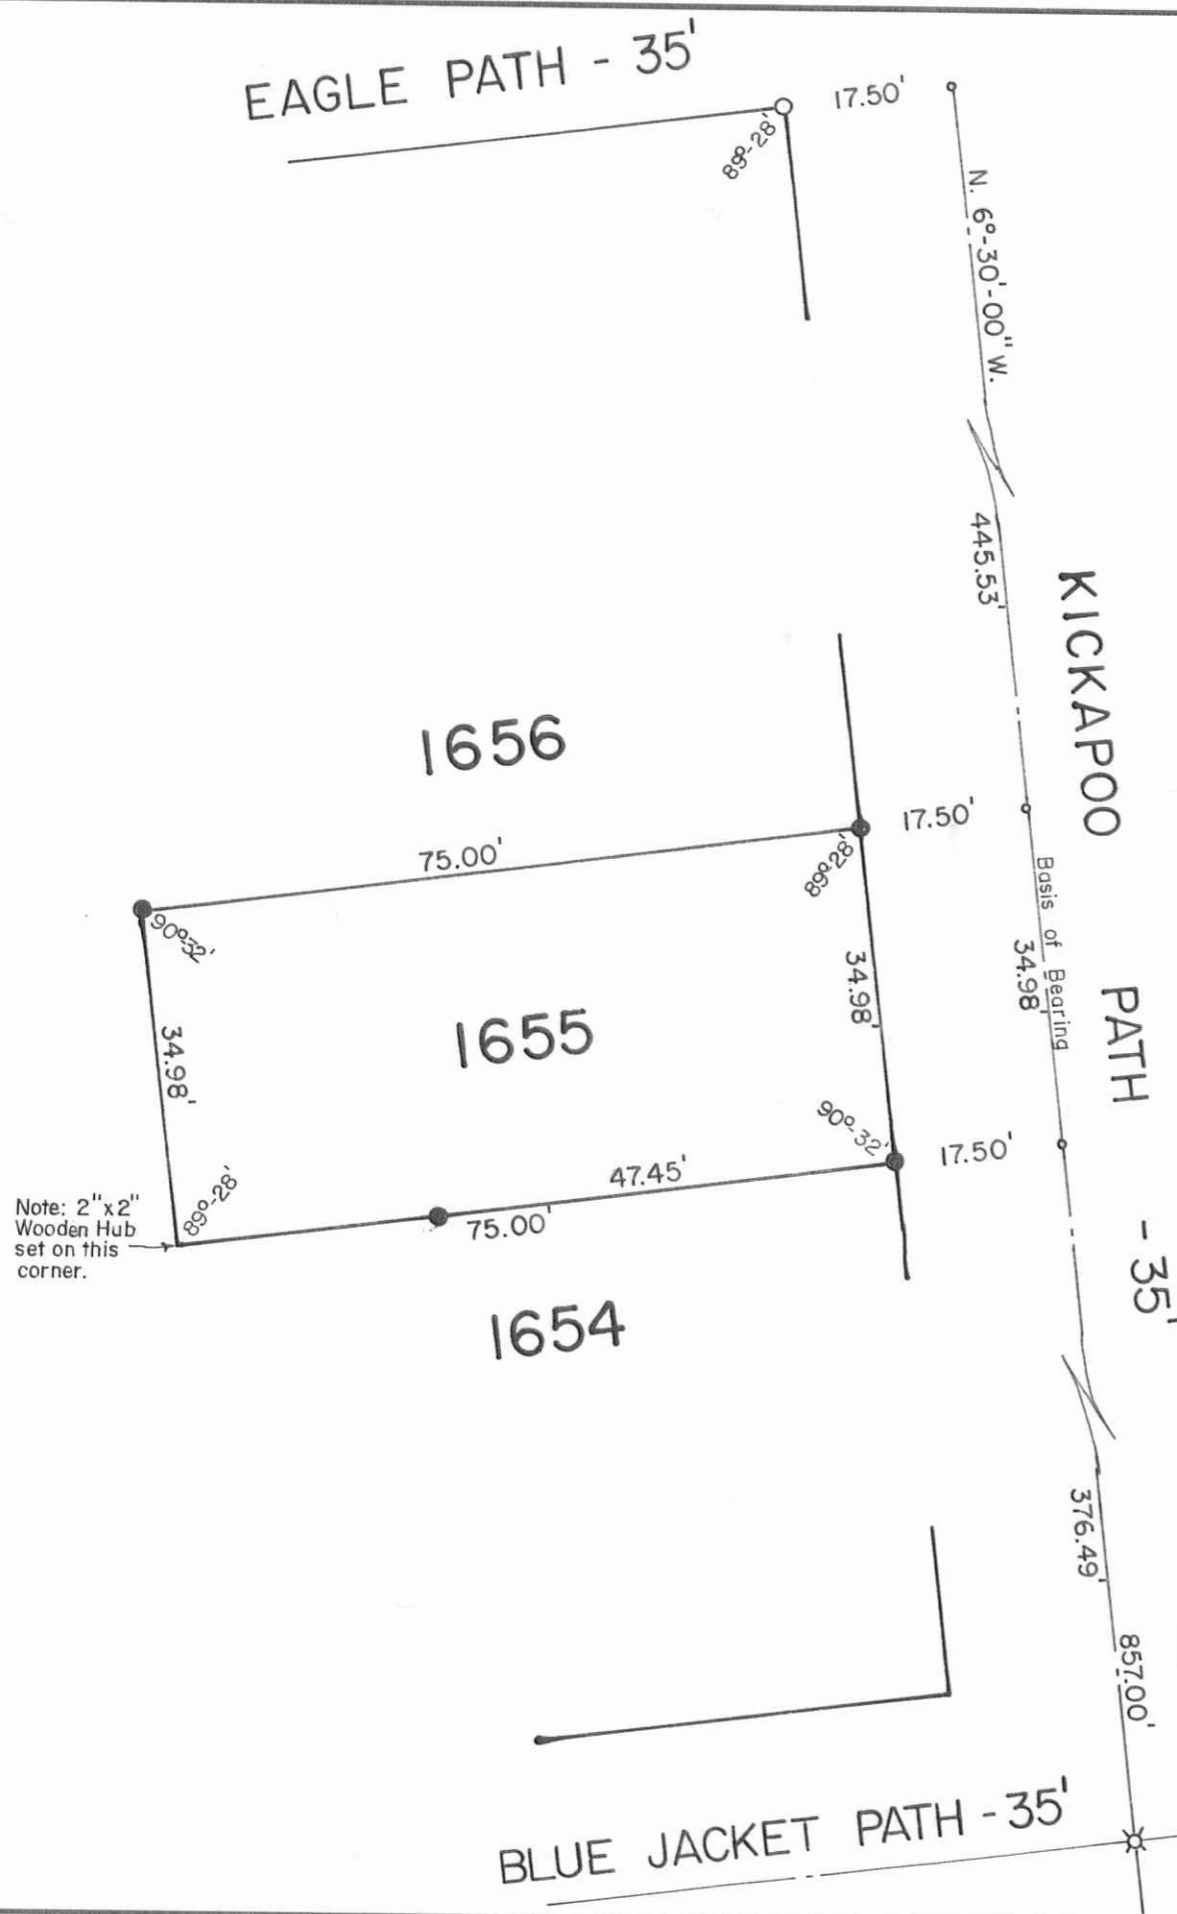

Note: 2" x 2" Wooden Hub set on this corner.

N



Scale: 1" = 20'

Symbols:

- - P. K. Nails Set.
- ⊗ - R. R. Spike Fd.
- - 5/8" Rebar Fd.
- - 5/8" x 30" Rebars Set.



Newt Stanley Survey - Lot No. 1655,
Chippewa Park No. 3, Stokes Township,
Logan County, Ohio.

SCALE: 1" = 20'	APPROVED BY:	DRAWN BY DEG
DATE: 7-2-1997		REVISED

Daniel E. Gilbert
Daniel E. Gilbert, P.S.
Reg. Sur. No. 5402

DRAWING NUMBER
097-023

INDEXED ON MAP
9156

S-557