


Reference:  
 Indian Lake Shores Allotment No. 1.  
 Plat Cab. A Slide 399 (5-15-1962).

Symbols:  
 ○ - 5/8" Rebars Fd.  
 ✕ - 3/4" Iron Pipe Fd.  
 ● - 5/8" x 30" Rebars Set.

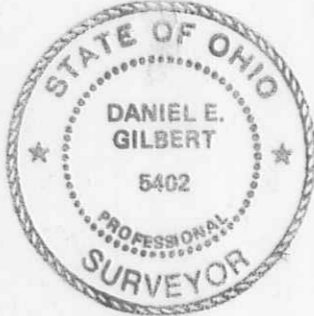

Survey of Lots No. 83, 84, 85, 86 & 87.  
 Indian Lake Shores Allotment No. 1.  
 Richland Township, Logan County, Ohio.

SCALE: 1" = 50'	APPROVED BY:	DRAWN BY DEG
DATE: 10-2-1997		REVISED
<i>Daniel E. Gilbert</i> Daniel E. Gilbert, P.S. Reg. Sur. No. 5402		DRAWING NUMBER 097-039

S-506