


INDEXED ON MAP
4006

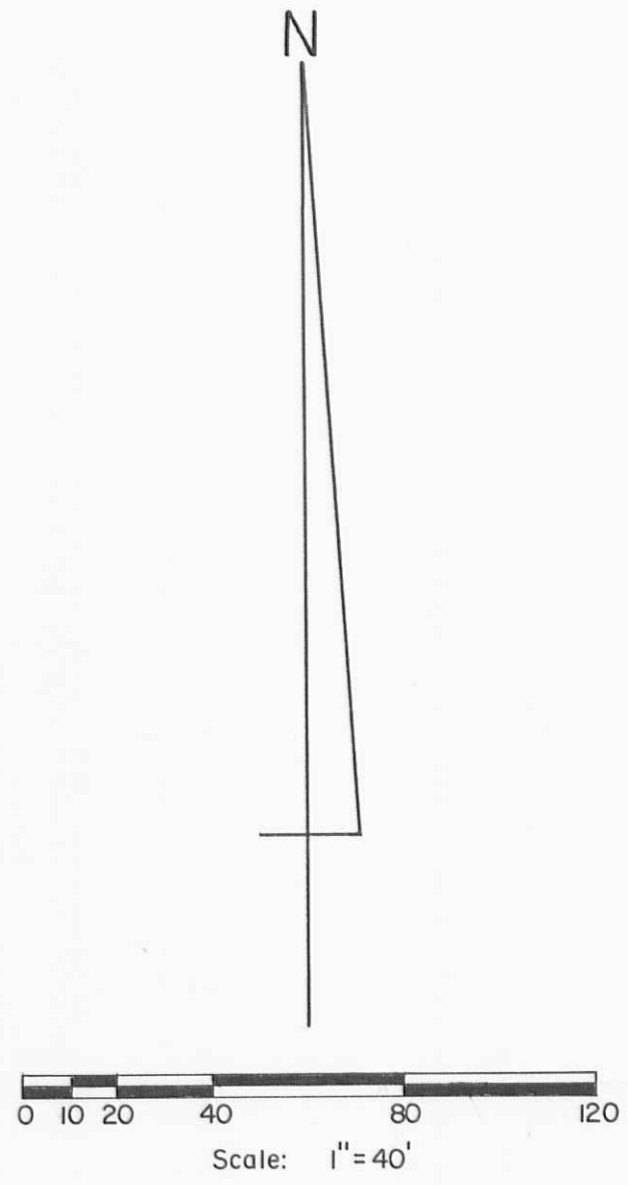

- Reference: Iron City Heights Plat Cab. A Slide 55.
- Symbols:
- ⊙ - 2" Iron Pipe Fd.
 - - 1/2" Iron Pipe Fd. (10" Deep).
 - - 1" Iron Bar Fd. (8" Deep).
 - - 5/8" x 30" Rebars Set.

Survey of Lots No. 2650-2651, Iron City Heights, City of Bellefontaine, Lake Township, Logan County, Ohio.		
SCALE: 1" = 40'	APPROVED BY:	DRAWN BY DEG
DATE: 5-2-1996		REVISED
<i>Daniel E. Gilbert</i> Daniel E. Gilbert, P.S. Reg. Sur. No. 5402		DRAWING NUMBER 096-026

S-600