


S. R. No. 366
Plan L-8 Page 7




N

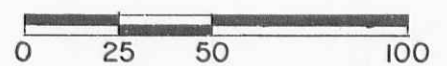

Scale: 1" = 50'

- SYMBOLS:
- - 1/2" Iron Pipes Fd.
 - ⊗ - 3/4" Iron Pipe Fd.
 - - 5/8" Rebars Fd.
 - ⊙ - 2" Steel Post in Concrete Fd.

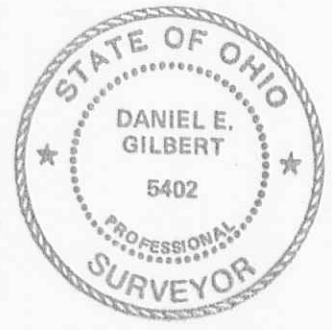

INDEXED ON MAP
6318

MAXINE GILLETTE RESURVEY Section No. 35, Town 6 South, Range 8 East Stokes Township, Logan County, Ohio.		
SCALE: 1" = 50'	APPROVED BY:	DRAWN BY DEG
DATE: 2-7-1996		REVISED
 Daniel E. Gilbert, P.S. Reg. Sur. No. 5402		DRAWING NUMBER 096-015

S-605