


BUCKEYE ST. - 30'

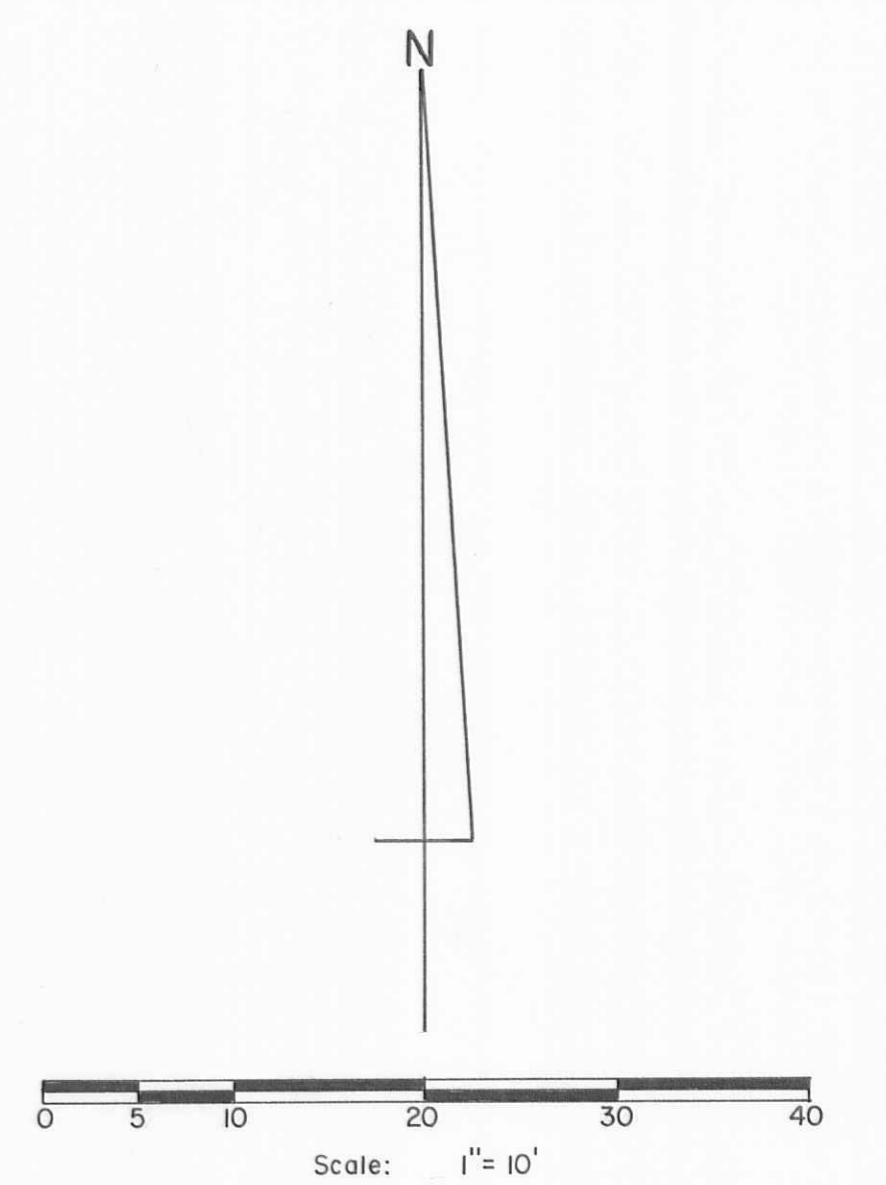

● - 5/8" x 30" Rebars Fd.

To Whom It May Concern:

I, Daniel E. Gilbert, P.S., Reg. Sur. No. 5402, do hereby certify that on September 13, 1995, I personally did locate the above shown improvements and that I did not find any physical encroachments except for the fire hydrant.

INDEXED ON MAP
9049

Daniel E. Gilbert
 Daniel E. Gilbert, P.S.
 Reg. Sur. No. 5402
 400 N. Park St.
 Bellefontaine, Ohio 43311
 Phone: 1(513) 593-1428



Mortgage Inspection Survey - 422 Buckeye Street, Lots No. 864 pt.-865, Village of Russells Point, Washington Township, Logan County, Ohio.		
SCALE: 1" = 10'	APPROVED BY:	DRAWN BY DEG
DATE: 9-13-1995		REVISED
<i>Daniel E. Gilbert</i> Daniel E. Gilbert, P.S. Reg. Sur. No. 5402		DRAWING NUMBER 094-072 A

S-641