


CHASE AVE. - 35'

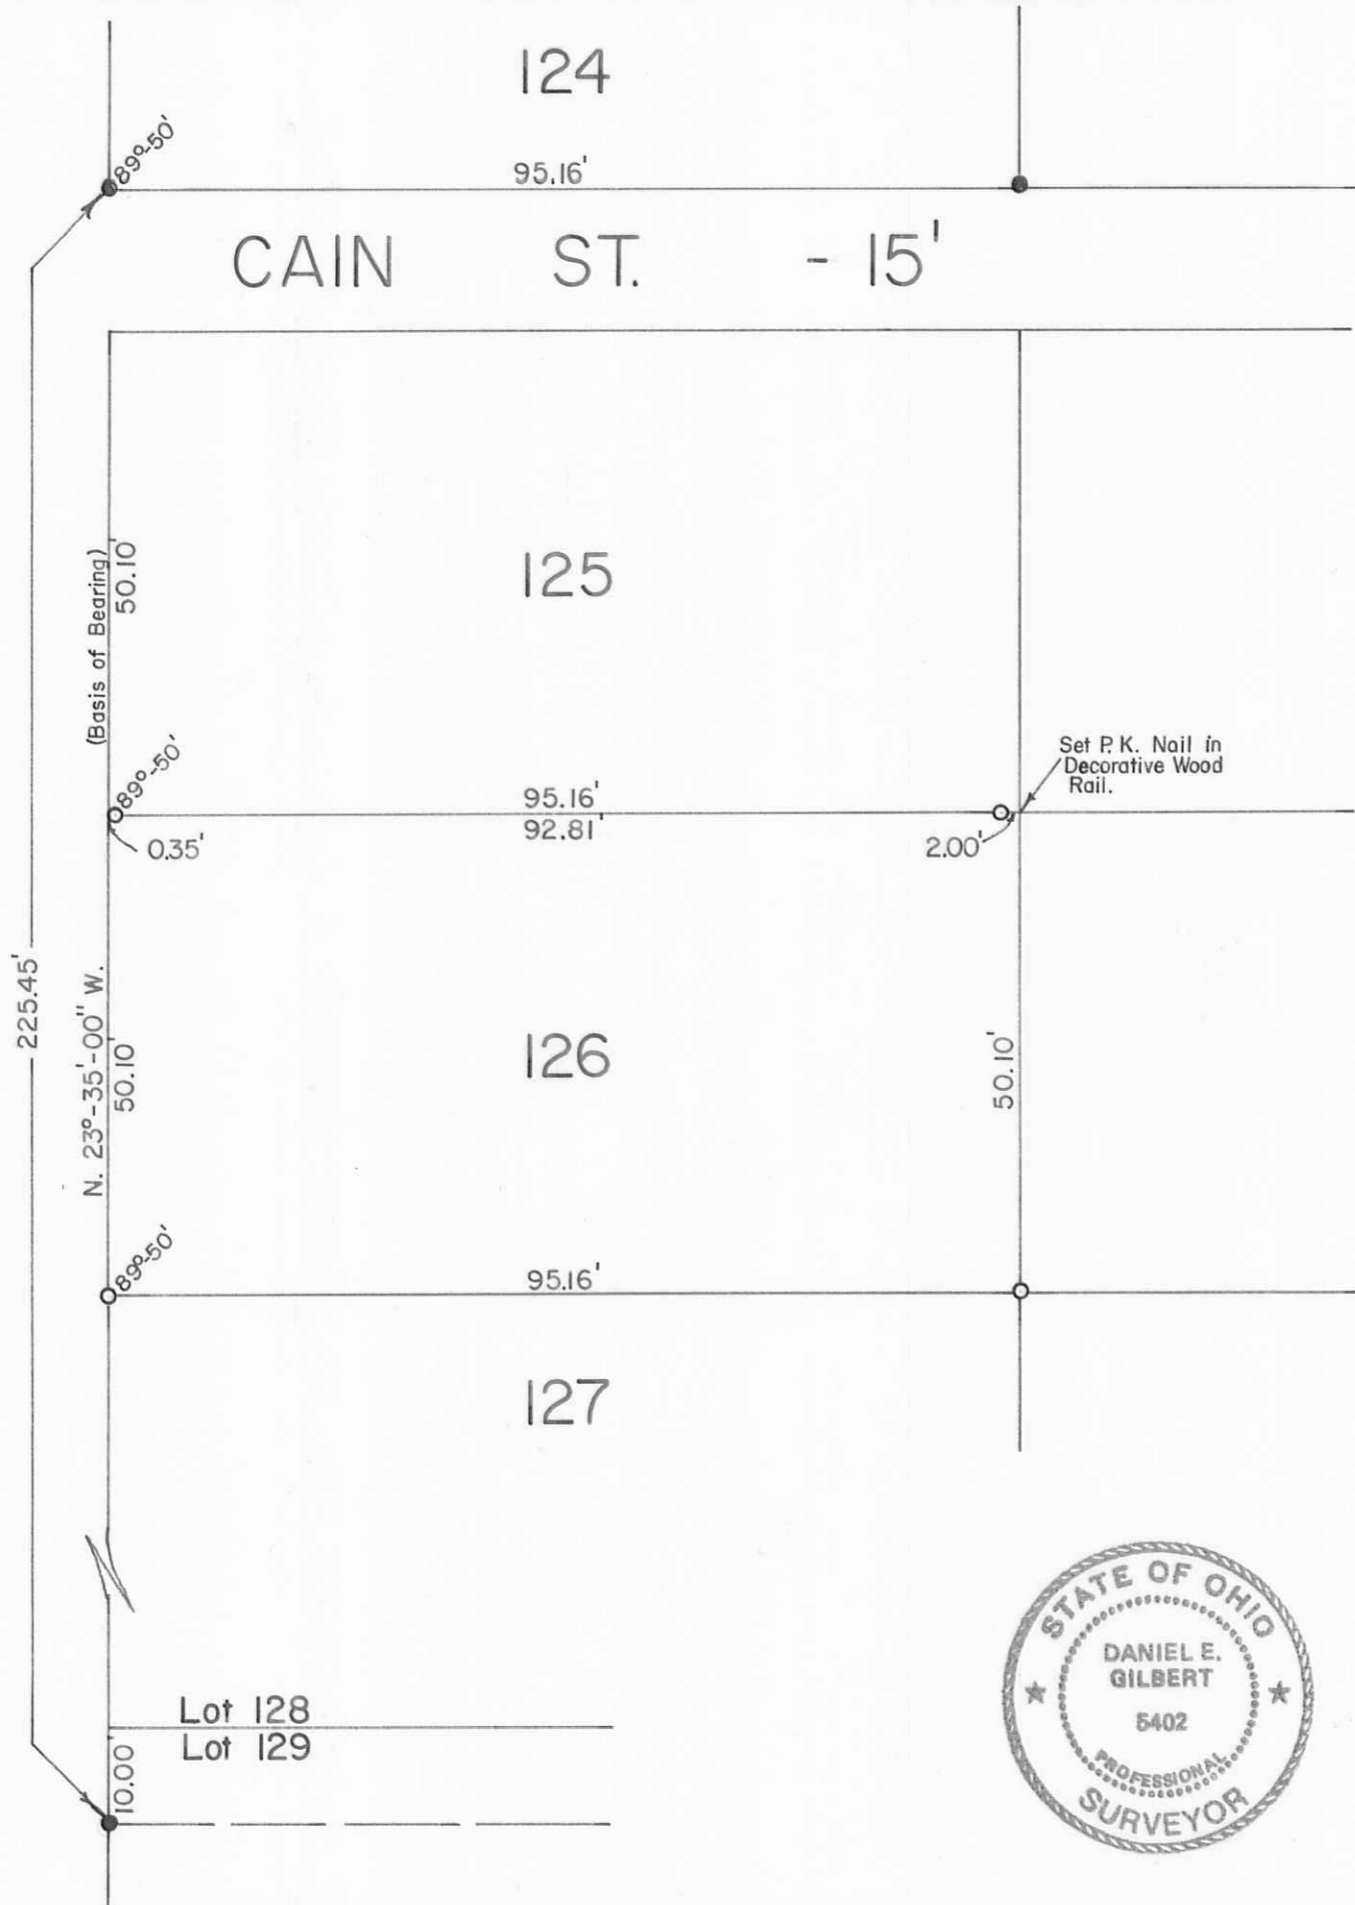

(Basis of Bearing)
N. 23°-35'-00\" W.
50.10'

89°-50'
0.35'

89°-50'

10.00'

Lot 128
Lot 129

124

95.16'

CAIN ST. - 15'

125

95.16'
92.81'

2.00'

50.10'


126

95.16'

127

Set P.K. Nail in
Decorative Wood
Rail.

INDEXED ON MAP
7593

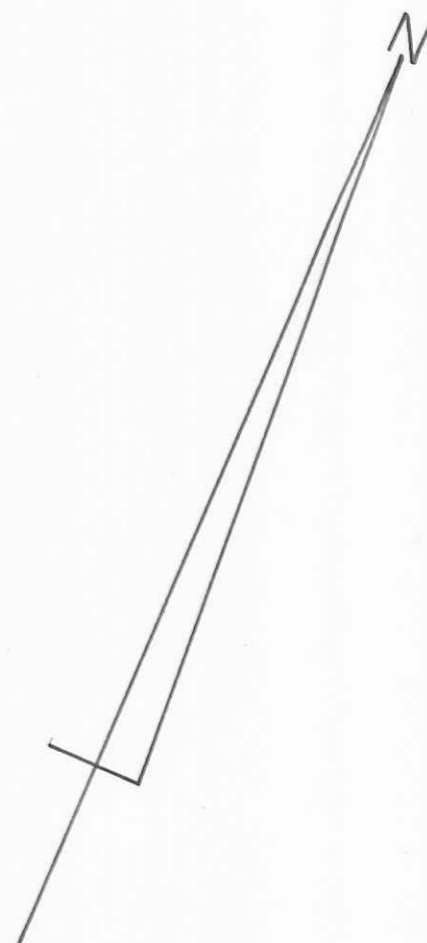

Scale: 1" = 20'

SYMBOLS:
 ● - 5/8" Rebars Fd.
 ○ - 5/8" x 30" Rebars Set.

Survey of Lot No. 126 Village of Russells Point, Washington Township, Logan County, Ohio.		
SCALE: 1" = 20'	APPROVED BY:	DRAWN BY DEG
DATE: 4-19-1995		REVISED
<i>Daniel E. Gilbert</i> Daniel E. Gilbert, P.S. Reg. Sur. No. 5402		
		DRAWING NUMBER 095-017

S-643