


1" Iron Bar in Monument Box Fd. W. Sandusky Ave.

1" Iron Bar in Monument Box Fd. Basis of Bearing

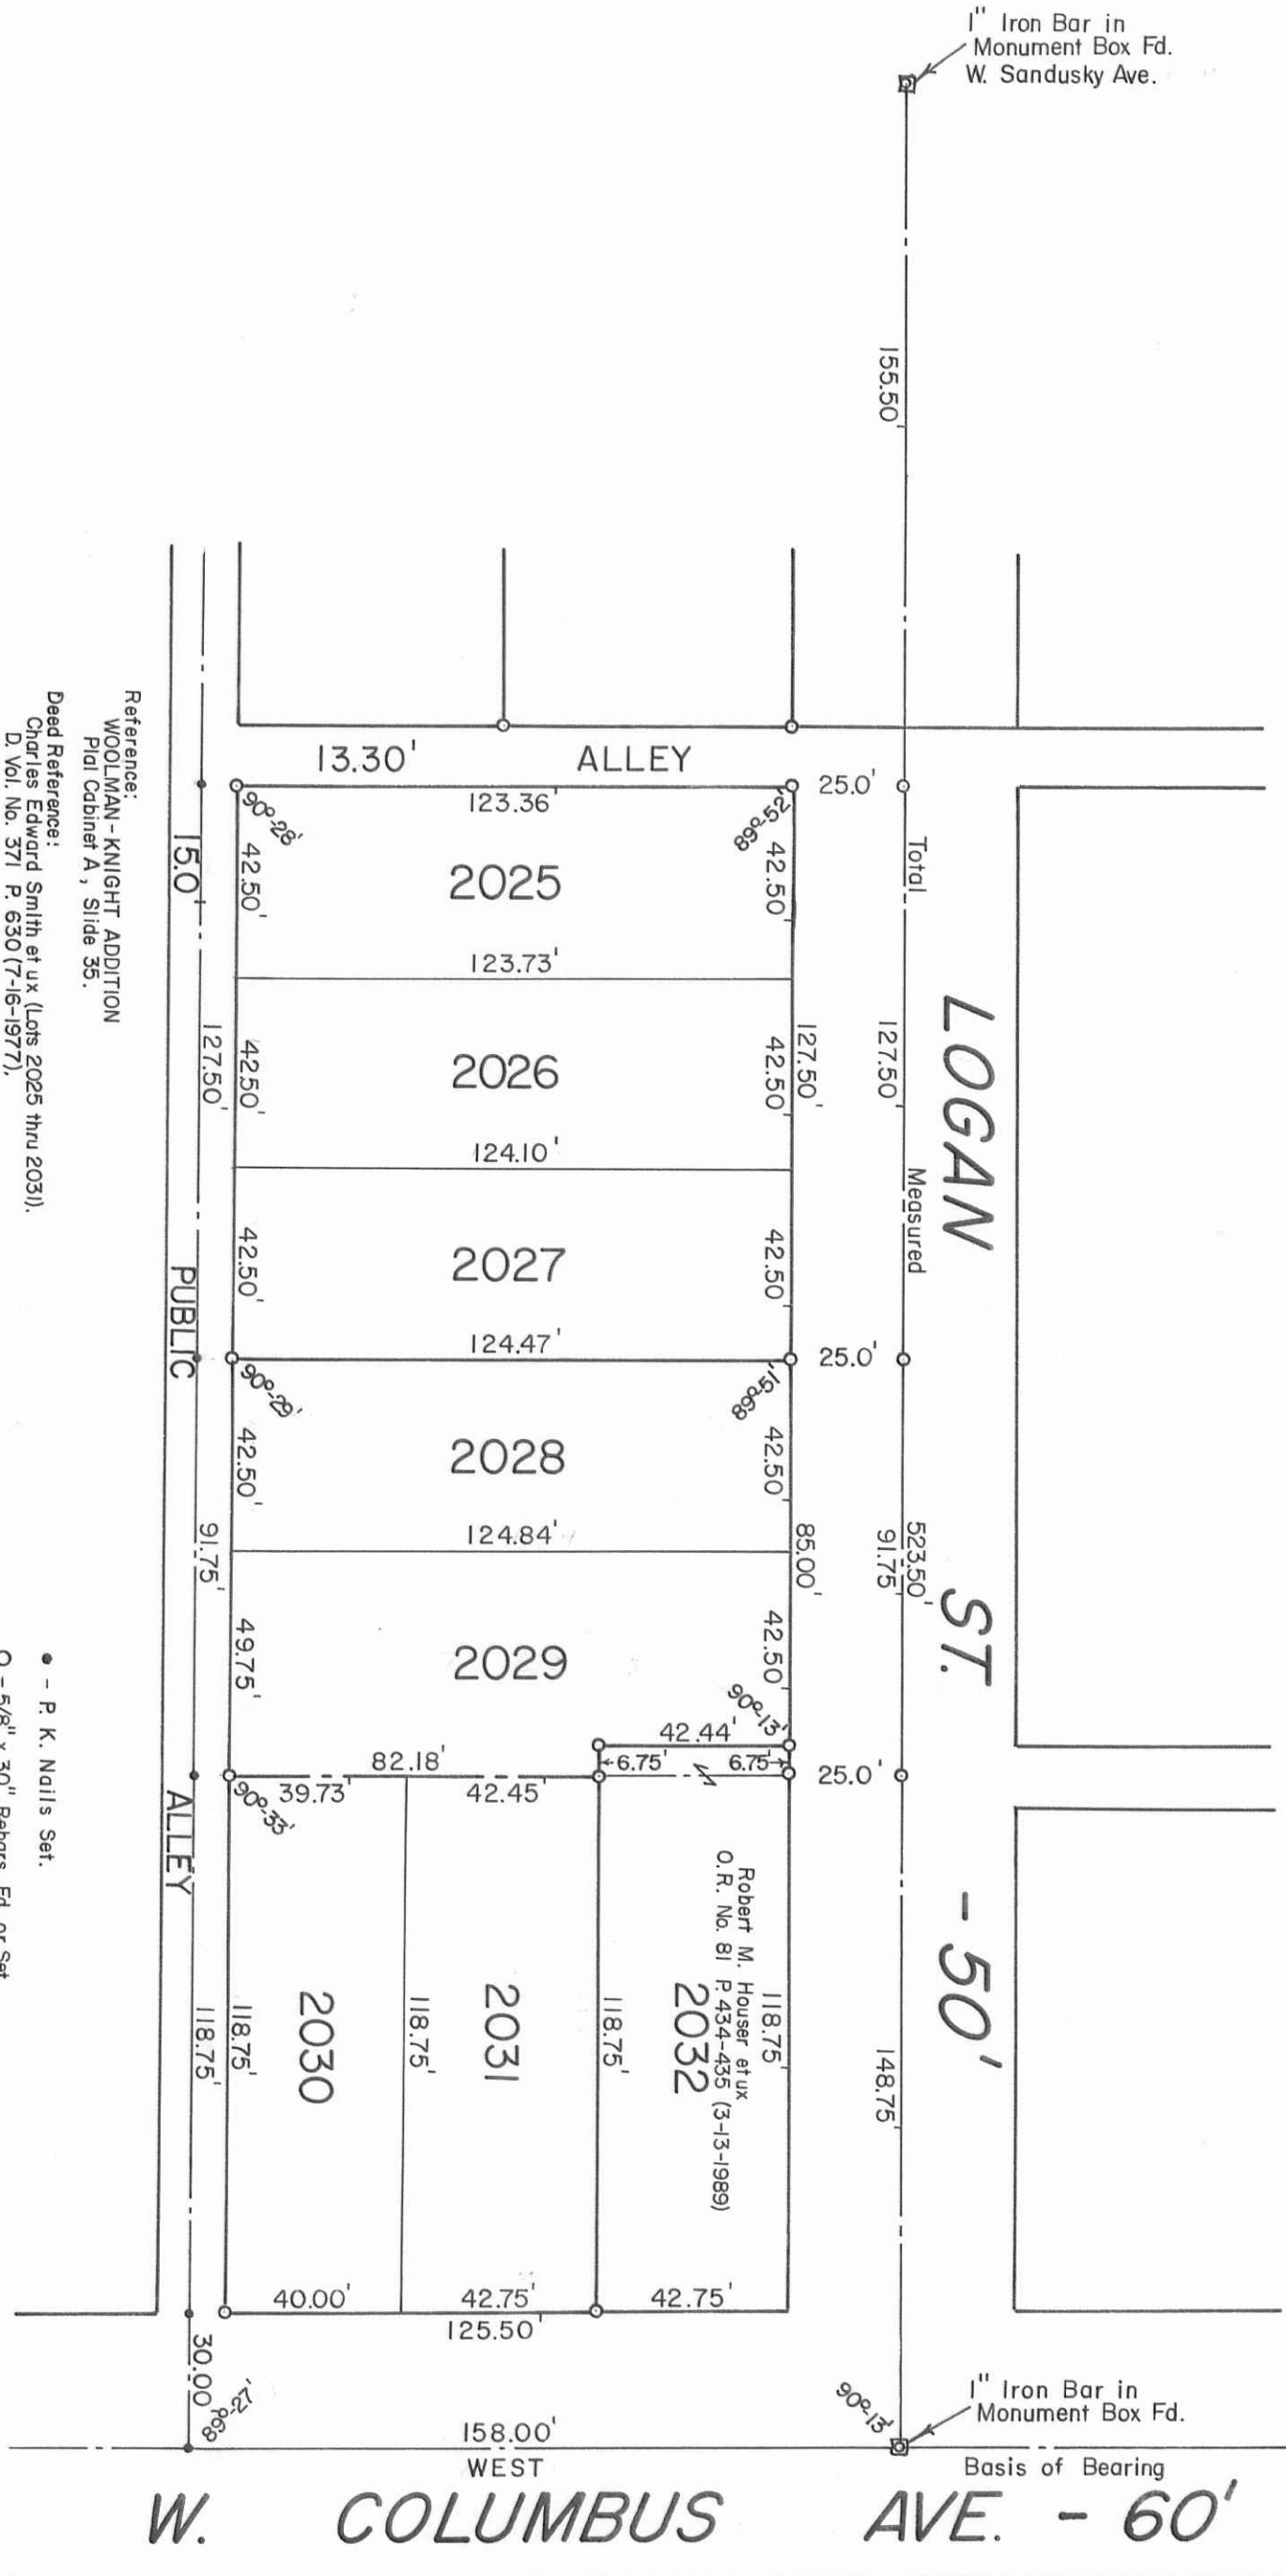

Reference:  
WOOLMAN - KNIGHT ADDITION  
Plat Cabinet A, Slide 35.  
Deed Reference:  
Charles Edward Smith et ux (Lots 2025 thru 2031).  
D. Vol. No. 371 P. 630 (7-16-1977).  
Alley Vacation - Ord. 3105  
D. Vol. No. 310 P. 429 (11-26-1965).

• - P. K. Nails Set.  
O - 5/8" x 30" Rebars Fd. or Set.

Survey of Lots No. 2025 thru 2031  
City of Bellefontaine, Harrison Township,  
Logan County, Ohio.

SCALE: 1" = 40'  
DATE: 9-6-1989  
APPROVED BY: *Daniel E. Gilbert*  
DRAWN BY: DEG  
REVISIONS:

Daniel E. Gilbert, P.S.  
Reg. Sur. No. 5402  
DRAWING NUMBER  
089-053



INDEXED ON MAP  
7944

S-660