


Marvin W. Rathfelder et ux
 Vol. 395 P. 218 (2-14-1982)
 55-092-00-00-017.000
 21,961 Acres

Reference Deed:
 Edward W. & A. Louise Campbell
 Vol. 164 P. 501-502 (10-28-1944)

Symbols:
 • - P.K. Nails Fd. in pavement.
 ○ - 3/4" Iron Pipes Fd.
 ○ - 1/2" Iron Bars Fd.
 ✖ - 5/8" Rebars Fd.
 All other points identified,

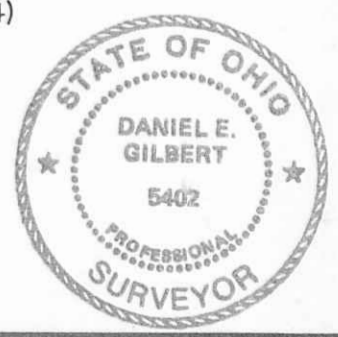

Edward W. Campbell Property
 V.M.S. No. 3683, Jefferson - Lake Townships,
 Logan County, Ohio.

| | | |
|---|-------------|---------------------------|
| SCALE: 1" = 100' | APPROVED BY | DRAWN BY DEG |
| DATE: 9-20-1991 | | Rev. 2-5-1992 |
| <i>Daniel E. Gilbert</i> Daniel E. Gilbert, P.S. Reg. Sur. No. 5402 | | DRAWING NUMBER 091-030 |

INDEXED ON MAP
6267

S-708