


N

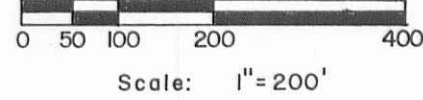

Gordon Farms Inc.
Vol. 311 P. 257 (1-10-1966)
(Tract I)
37-035-00-00-022.000
83.42 Acres

T.R. No. 100 - Brownell Road.
33' Wide.
Comm. Jour. F, Page 514 (3-29-1890).
Road Rec. 3, Pages 74-75 (1890).
T.R. No. 100 - 33'

Area in Road R/W's
52,417.81^{sq} ft or 1.203 Acres.

Richland
McArthur

V.M.S. 9949
V.M.S. 9929

N. 79°-52'-00" E.
2,376.20'

Tract III
2,432,058.170^{sq} ft
or
55.833 Acres

Deed of reference:
Gordon Farms, Inc.
Vol. 311 P. 257 (1-10-1966)
Tract II - 82.88 Acres.

Patricia Heiko et al
O.R. 103 P. 956 (3-27-1990)
23-034-00-00-033.000
21.65 Acres

(C.C.C. & St. L. Ry.)
Plan R-47 142/23
Penn Central
N. 14°-01'-00" E.
(49,763.75^{sq} ft or 1.142 Acres)
987.87'
(Abandoned)
54.80'
65'
50'

N. 84°-38'-26" W. 1,795.15'

Robert J. Milroy et ux
O.R. 81 P. 164 (3-6-1989)
23-035-00-00-028.000
99.248 Acres

Tract I
524,613.445^{sq} ft
or
12.043 Acres
This tract surveyed
July 25, 1991.

S. 12°-27'-00" W. 1,292.46'
S. 77°-33'-00" E. 355.00'
N. 12°-27'-00" E. 390.00'
1.515 Acres
This tract surveyed
April 11, 1988.
(443.39)
357.48'


Charles A. Bennett et ux
O.R. 79 P. 558 (2-10-1989)
23-035-00-00-028.001
85.255 Acres

Tract II
646,384.425^{sq} ft
or
14.839 Acres
This tract surveyed
July 25, 1991.

N. 12°-27'-00" E. 1,092.50'
S. 84°-06'-00" E. 394.00'
N. 12°-27'-00" E. 1,067.50'
N. 12°-27'-00" W. 556.00'
S. 12°-27'-00" W. 370.00'
6" Concrete Post.
6" Concrete Post.
N. 84°-03'-00" W. 798.98'
824.63'

Charles A. Bennett et ux
Vol. 408 P. 963 (4-3-85)
Total - 4.40 Acres
2.61 Acres
1.79 Acres

Ruth Anne Shroyer et al
O.R. 86 P. 54 (5-25-1989)
34-035-00-00-029.000
255.10 Acres

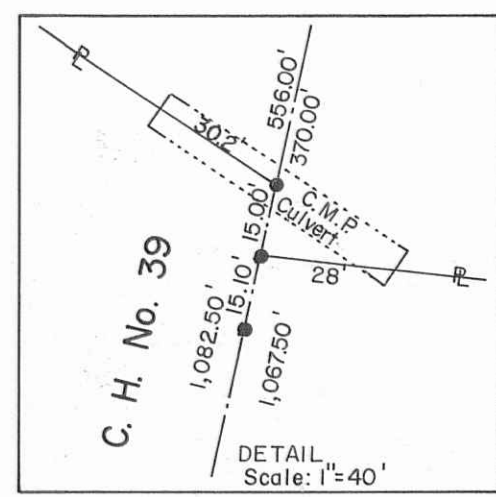

- SYMBOLS:
- - R. R. Spikes Fd.
 - - R. R. Spikes Set.
 - ✕ - 5/8" x 30" Rebars Fd.
 - ✕ - 5/8" x 30" Rebars Set.

Total Area - New Surveys.
Tract I - 12.043 Acres.
Tract II - 14.839 Acres.
Tract III - 55.833 Acres.
82.715 Acres.



Gordon Farms, Inc. Surveys (Tract III).
V.M.S. No. 9929, McArthur Township, Logan County, Ohio.

SCALE: 1" = 200'	APPROVED BY	DRAWN BY DEG
DATE: 10-1-1991		

Daniel E. Gilbert
Daniel E. Gilbert, P.S.
Reg. Sur. No. 5402

DRAWING NUMBER
091-036 A

INDEXED ON MAP
7899

S-739