
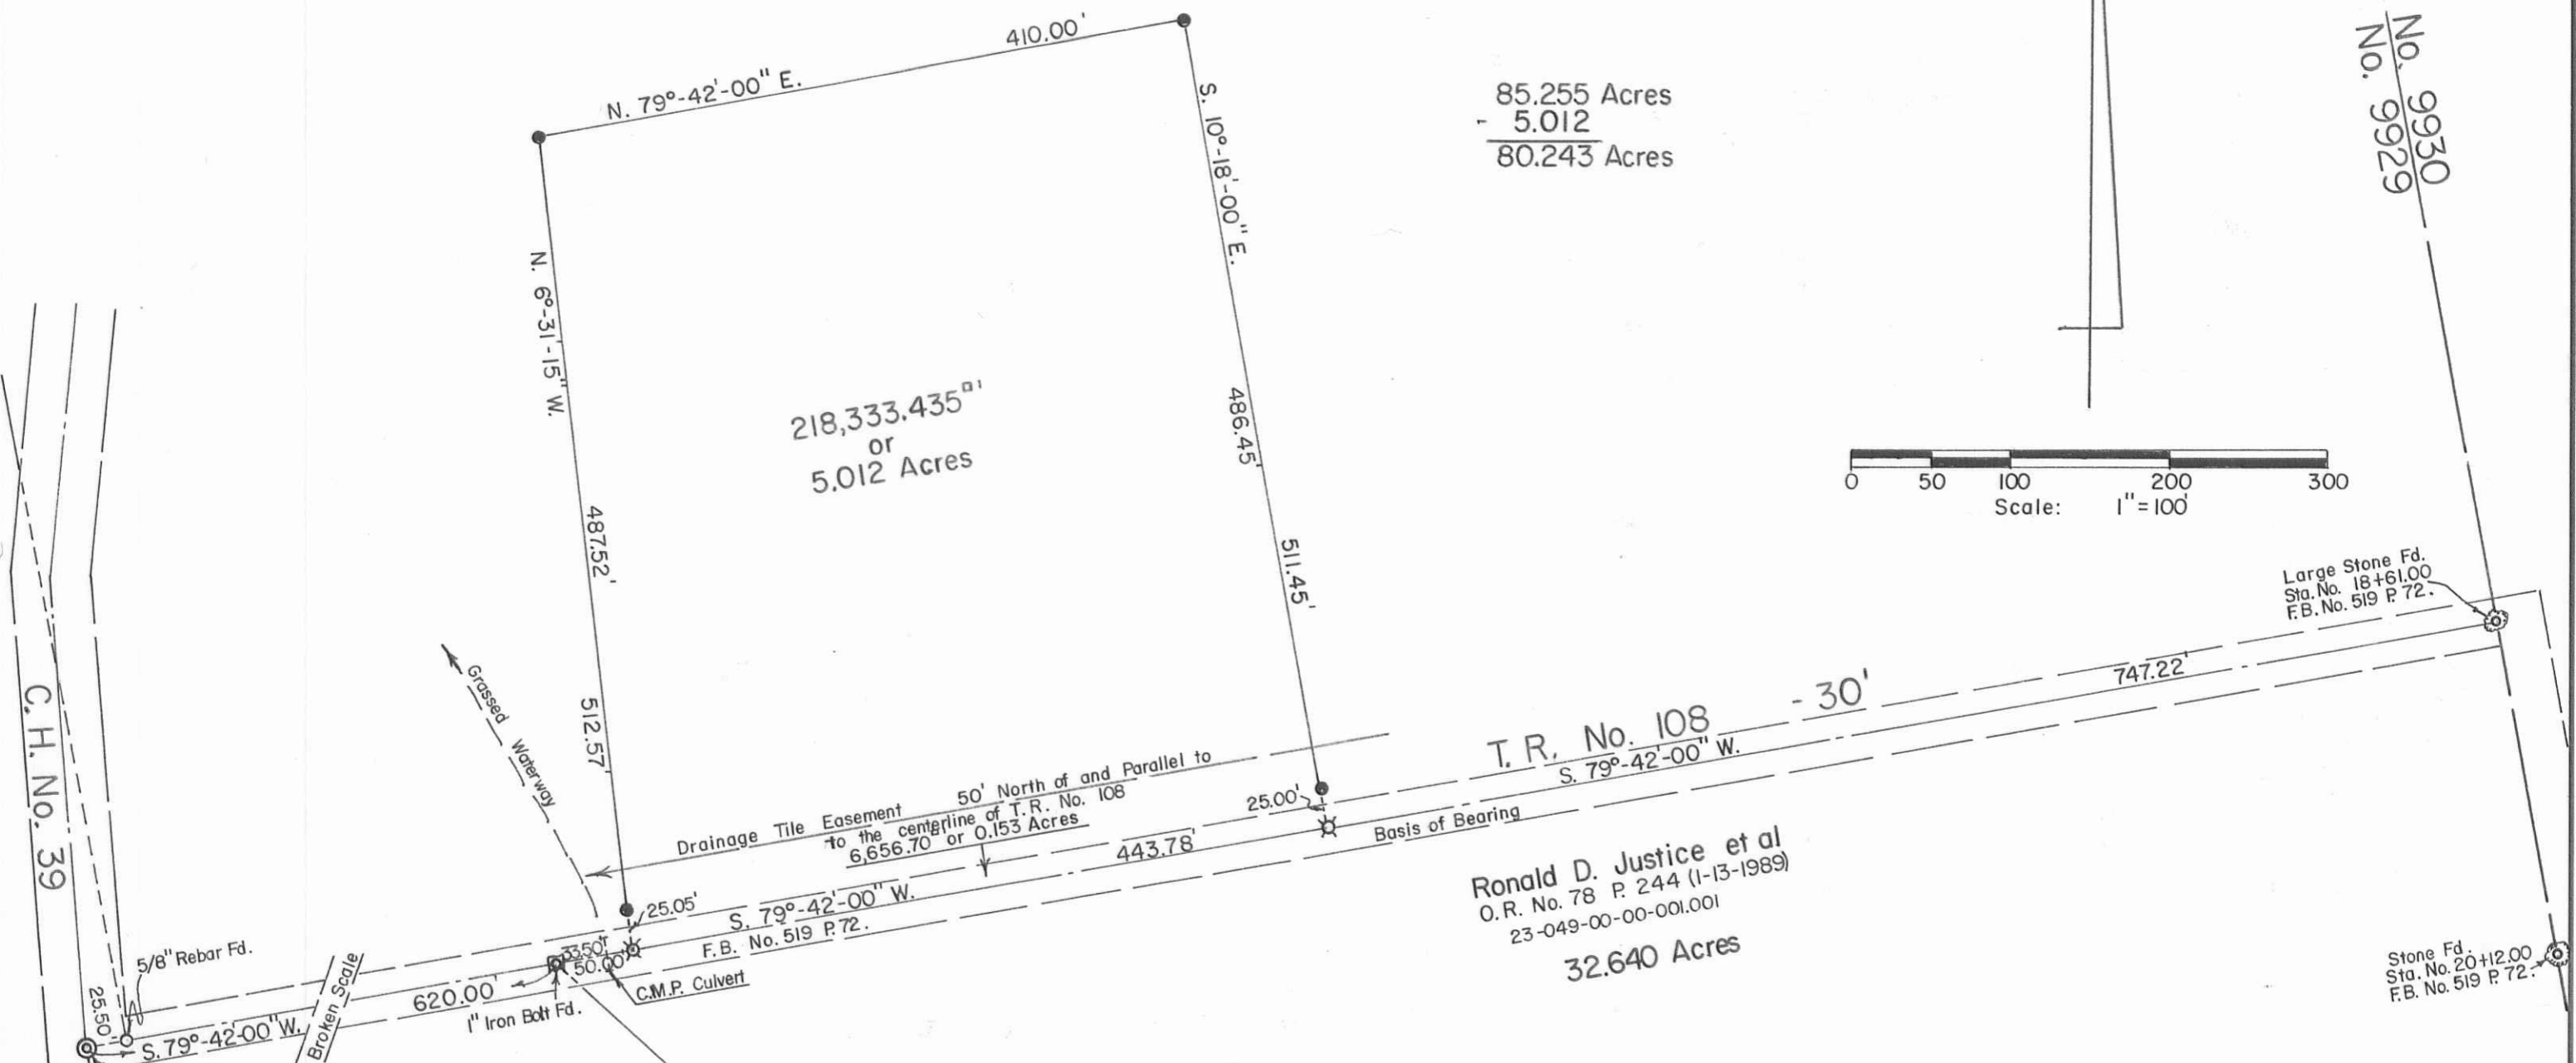


Charles A. Bennett et ux
 O.R. No. 79 P. 558 (2-10-1989)
 23-035-00-00-028.001

85.255 Acres
 - 5.012
 80.243 Acres

V.M.S. No. 9930
 V.M.S. No. 9929

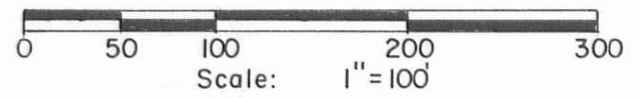

Ronald D. Justice et al
 O.R. No. 78 P. 244 (1-13-1989)
 23-049-00-00-001.001
 32.640 Acres

C.H. No. 39

3/4" Iron Bar Fd.
 Sta. No. 65+42.00 (C.H. No. 39)
 = Sta. No. 0+00.00 (T.R. No. 108)

Daniel E. Gilbert
 DANIEL E. GILBERT, P.S.
 REG. SUR. NO. 5402
 400 N. PARK ST.
 BELLEFONTAINE, OHIO 43311
 TELEPHONE: 1 (513) 593-1428

INDEXED ON MAP
 6172



SYMBOLS:
 ☒ - R.R. Spikes Set.
 ● - 5/8 x 30 Rebars Set.

TOLERANCES (EXCEPT AS NOTED)	REVISIONS			BENNETT SURVEY V.M.S. No. 9929, McArthur Township, Logan County, Ohio.		
	NO.	DATE	BY			
DECIMAL	1			DRAWN BY DEG	SCALE 1" = 100'	MATERIAL As Noted
±	2					
FRACTIONAL	3			CHK'D DEG	DATE 4-5-1993	DRAWING NO. 093-013
±	4					
ANGULAR	5			TRACED DEG	APP'D	
±						