

Mill Street - 60'

N. 13°-30' E.

N. 13°-30' E.

Basis of Bearing

Chisel Point in Sidewalk

N. 88°-53' W.

Point A

Chisel Point in Sidewalk

Race Street - 40'

Lot 107


Lot 106

Ronald E. and Pamela S. Pope  
Vol. 365 P. 673 (8-5-1976)

Kevin G. and Janet E. S. Smith  
O.R. No. 36 P. 122-123 (1-31-1987)

Lot 105

Lot 104

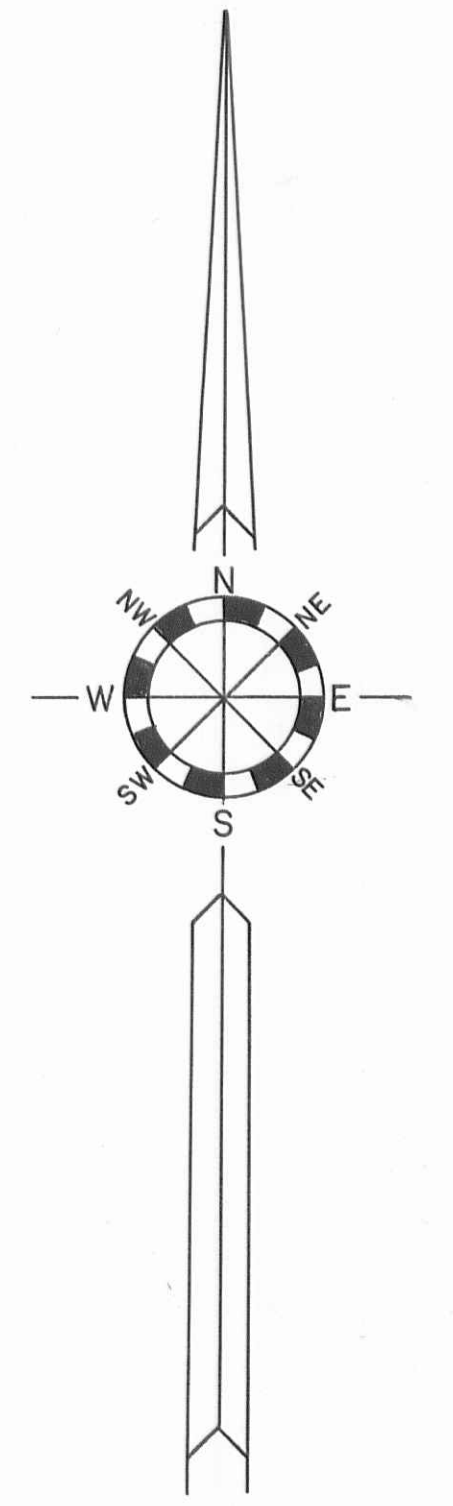

Point A - 2" Iron Pipe found.  
Point B - 1/2" Iron Bar found.  
● - 5/8" x 30" Rebars.

Reference:  
Bogg's Addition.  
Plat Cabinet A, Slide 81.



To whom it may concern:  
On July 27, 1988, at the request of Kevin Smith, I attempted to locate an old fence line or planting row between the properties of Ronald Pope and Kevin Smith as was shown in photographs of the 1938 era. The only planting found that was identifiable in the photographs was the 24 inch Maple tree (it was probably a 2 or 3 inch sappling in 1938).  
I found Point A (2 inch Iron Pipe) and Point B (1/2 inch Iron Bar), but no old fence posts or wire. What relationship Point A and Point B have to each other, I cannot determine.  
I therefor found it impossible to re-establish the old fence line or planting row.

Daniel E. Gilbert, P.S.

Line between Pope and Smith, Lot No. 105, Village of DeGraff, Miami Township, Logan County, Ohio.		APPROVED BY:	
SCALE: 1" = 20'	DATE: 7-27-1988	DRAWN BY DEG	
		REVISED	
Daniel E. Gilbert, P.S. Reg. Sur. No. 5402		DRAWING NUMBER 088-052	

INDEXED ON MAP  
744B

9-757