

Per. Par. No. 36-019-10-01-041.000
 Lot No. 42
 Jong S. Kindle
 O. R. No. 159 P. 730 (6-1-1992).


SYMBOLS:
 ⊙ - 1" Iron Pipe Fd.
 ○ - 5/8" x 30" Rebars Fd.
 ● - 5/8" x 30" Rebars Set.

Total Tract - 7,135.905^{sq ft} or 0.164 Acres.
KINDLE SURVEY - Lot No. 42 and Extension Thereto,
 Fernwood Subdivision No. 1- Long Island, V.M.S. No. 13393,
 Richland Township, Logan County, Ohio.

SCALE: 1" = 20'	APPROVED BY:	DRAWN BY DEG
DATE: 12-2-1994		REVISED

Daniel E. Gilbert, P.S.
 Daniel E. Gilbert, P.S.
 Reg. Sur. No. 5402

DRAWING NUMBER
 094-068

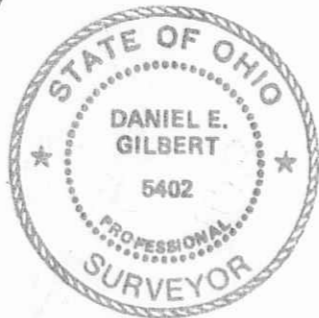

Reference:
 Fernwood Subdivision No. 1 (7-II-1923).
 Plat Cab. A Slide 179.

INDEXED ON MAP
 8896

S-790