




John F. Marmon et ux
 Vol. 329 P. 833 (4-17-1970)
 Per. Par. No. 40-064-00-00-069

30.718 Acres

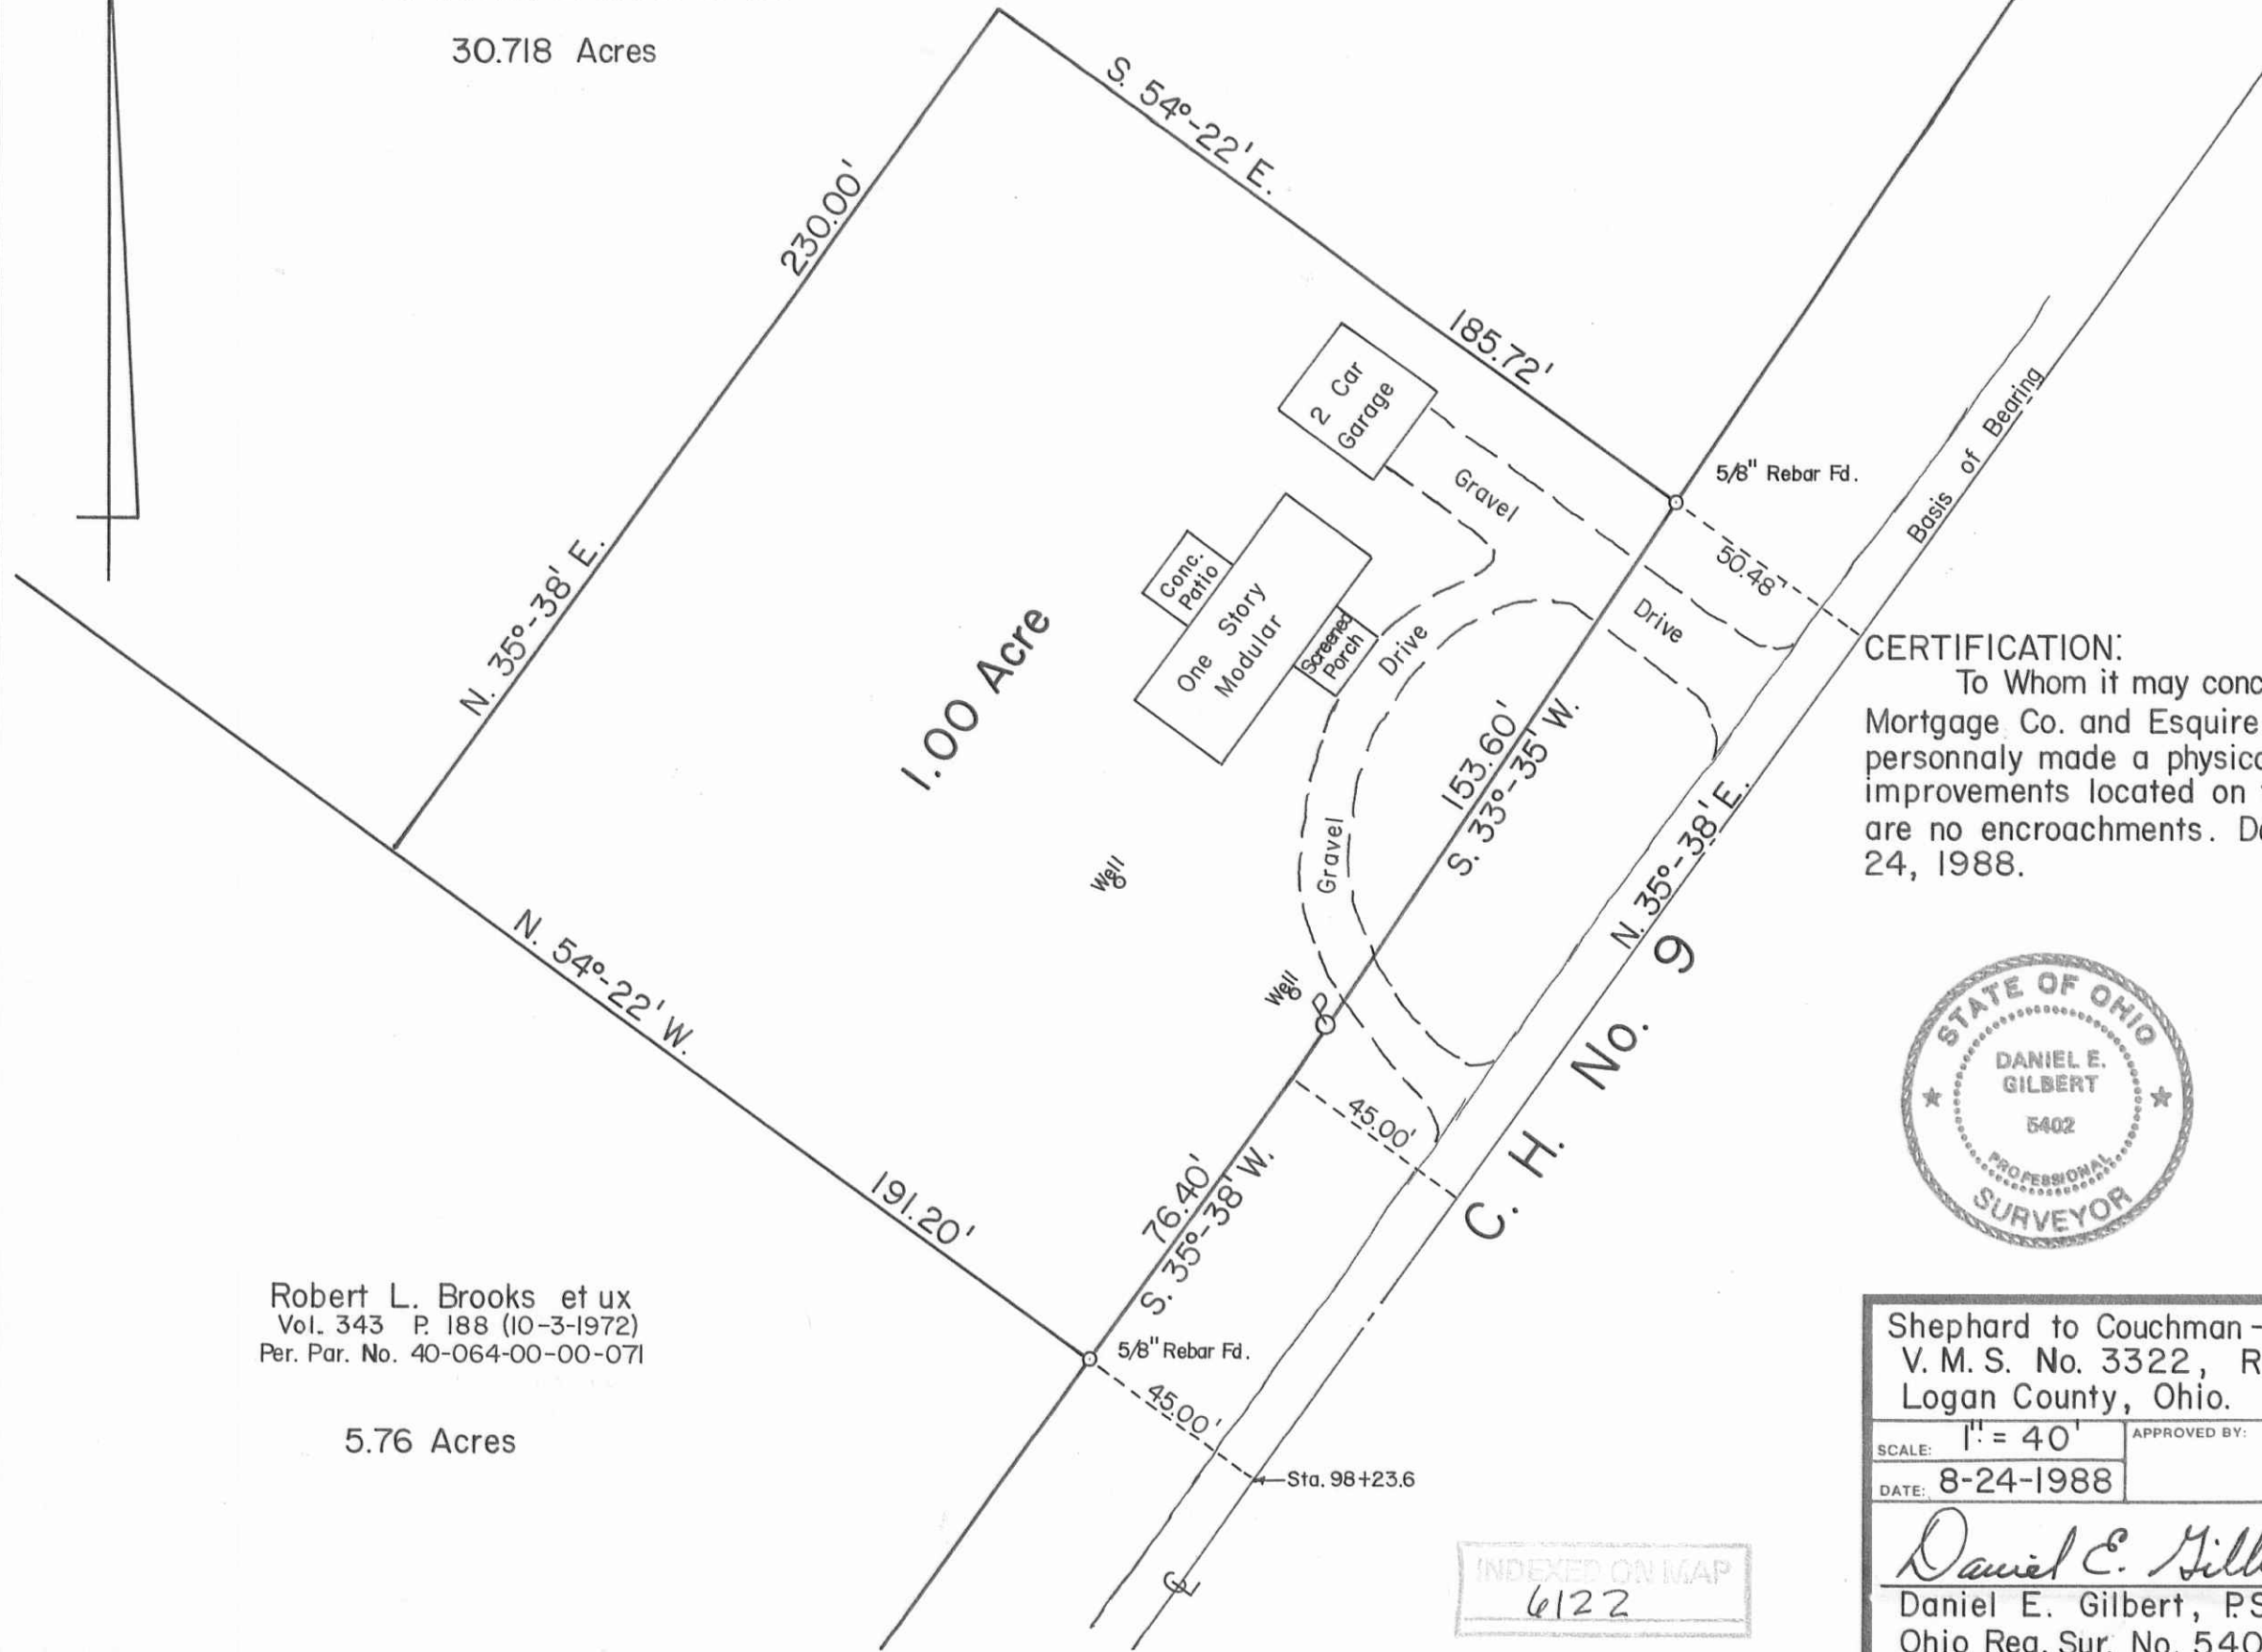

Robert L. Brooks et ux
 Vol. 343 P. 188 (10-3-1972)
 Per. Par. No. 40-064-00-00-071

5.76 Acres

CERTIFICATION:

To Whom it may concern, I hereby certify to Home Buyer Mortgage Co. and Esquire Title Services, Inc., that I have personally made a physical inspection and location of the improvements located on the shown premises, and that there are no encroachments. Date of the inspection was August 24, 1988.



Daniel E. Gilbert

Daniel E. Gilbert, P.S.
 Ohio Reg. Sur. No. 5402
 400 North Park Street
 Bellefontaine, Ohio 43311
 Phone: 1 (513) 593-1428

Shepard to Couchman - Per. Par. No. 40-064-00-00-070
 V. M. S. No. 3322, Rushcreek Township,
 Logan County, Ohio.

SCALE: 1" = 40'	APPROVED BY:	DRAWN BY DEG
DATE: 8-24-1988		REVISED

Daniel E. Gilbert
 Daniel E. Gilbert, P.S.
 Ohio Reg. Sur. No. 5402

DRAWING NUMBER
 088-063

INDEXED ON MAP
 6122

S-824