



# INDIAN LAKE

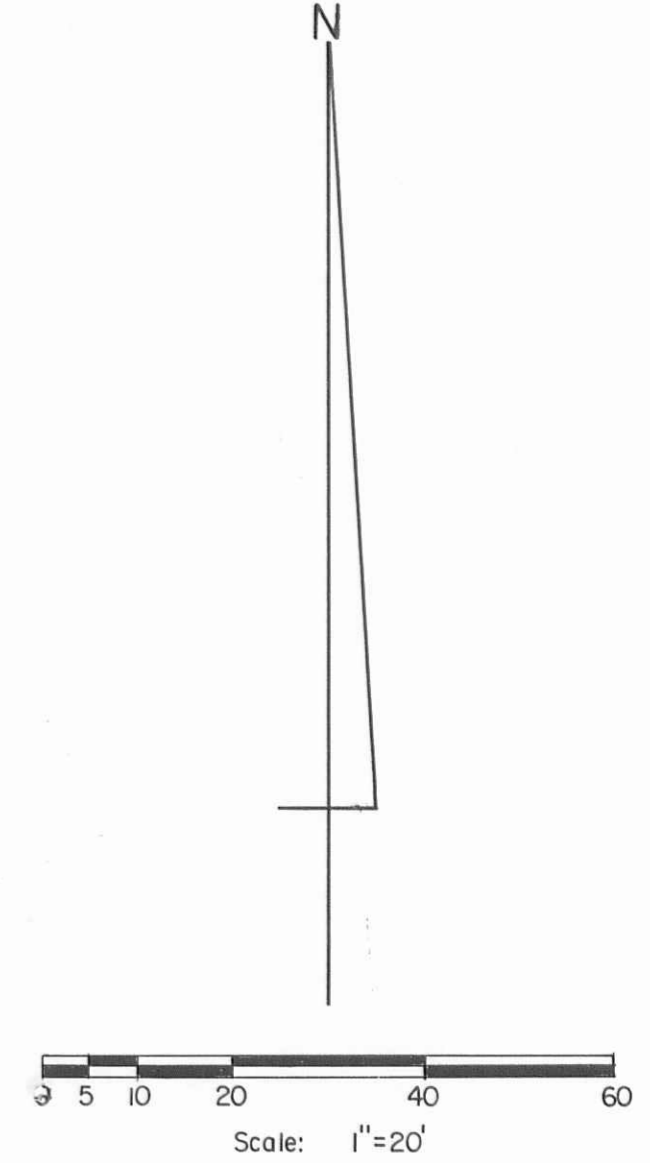

- Symbols:
- - 1/2" Iron Pipes Fd.
  - ⊗ - 5/8" x 30" Rebars Fd.
  - ⊙ - 5/8" x 30" Rebars Set.

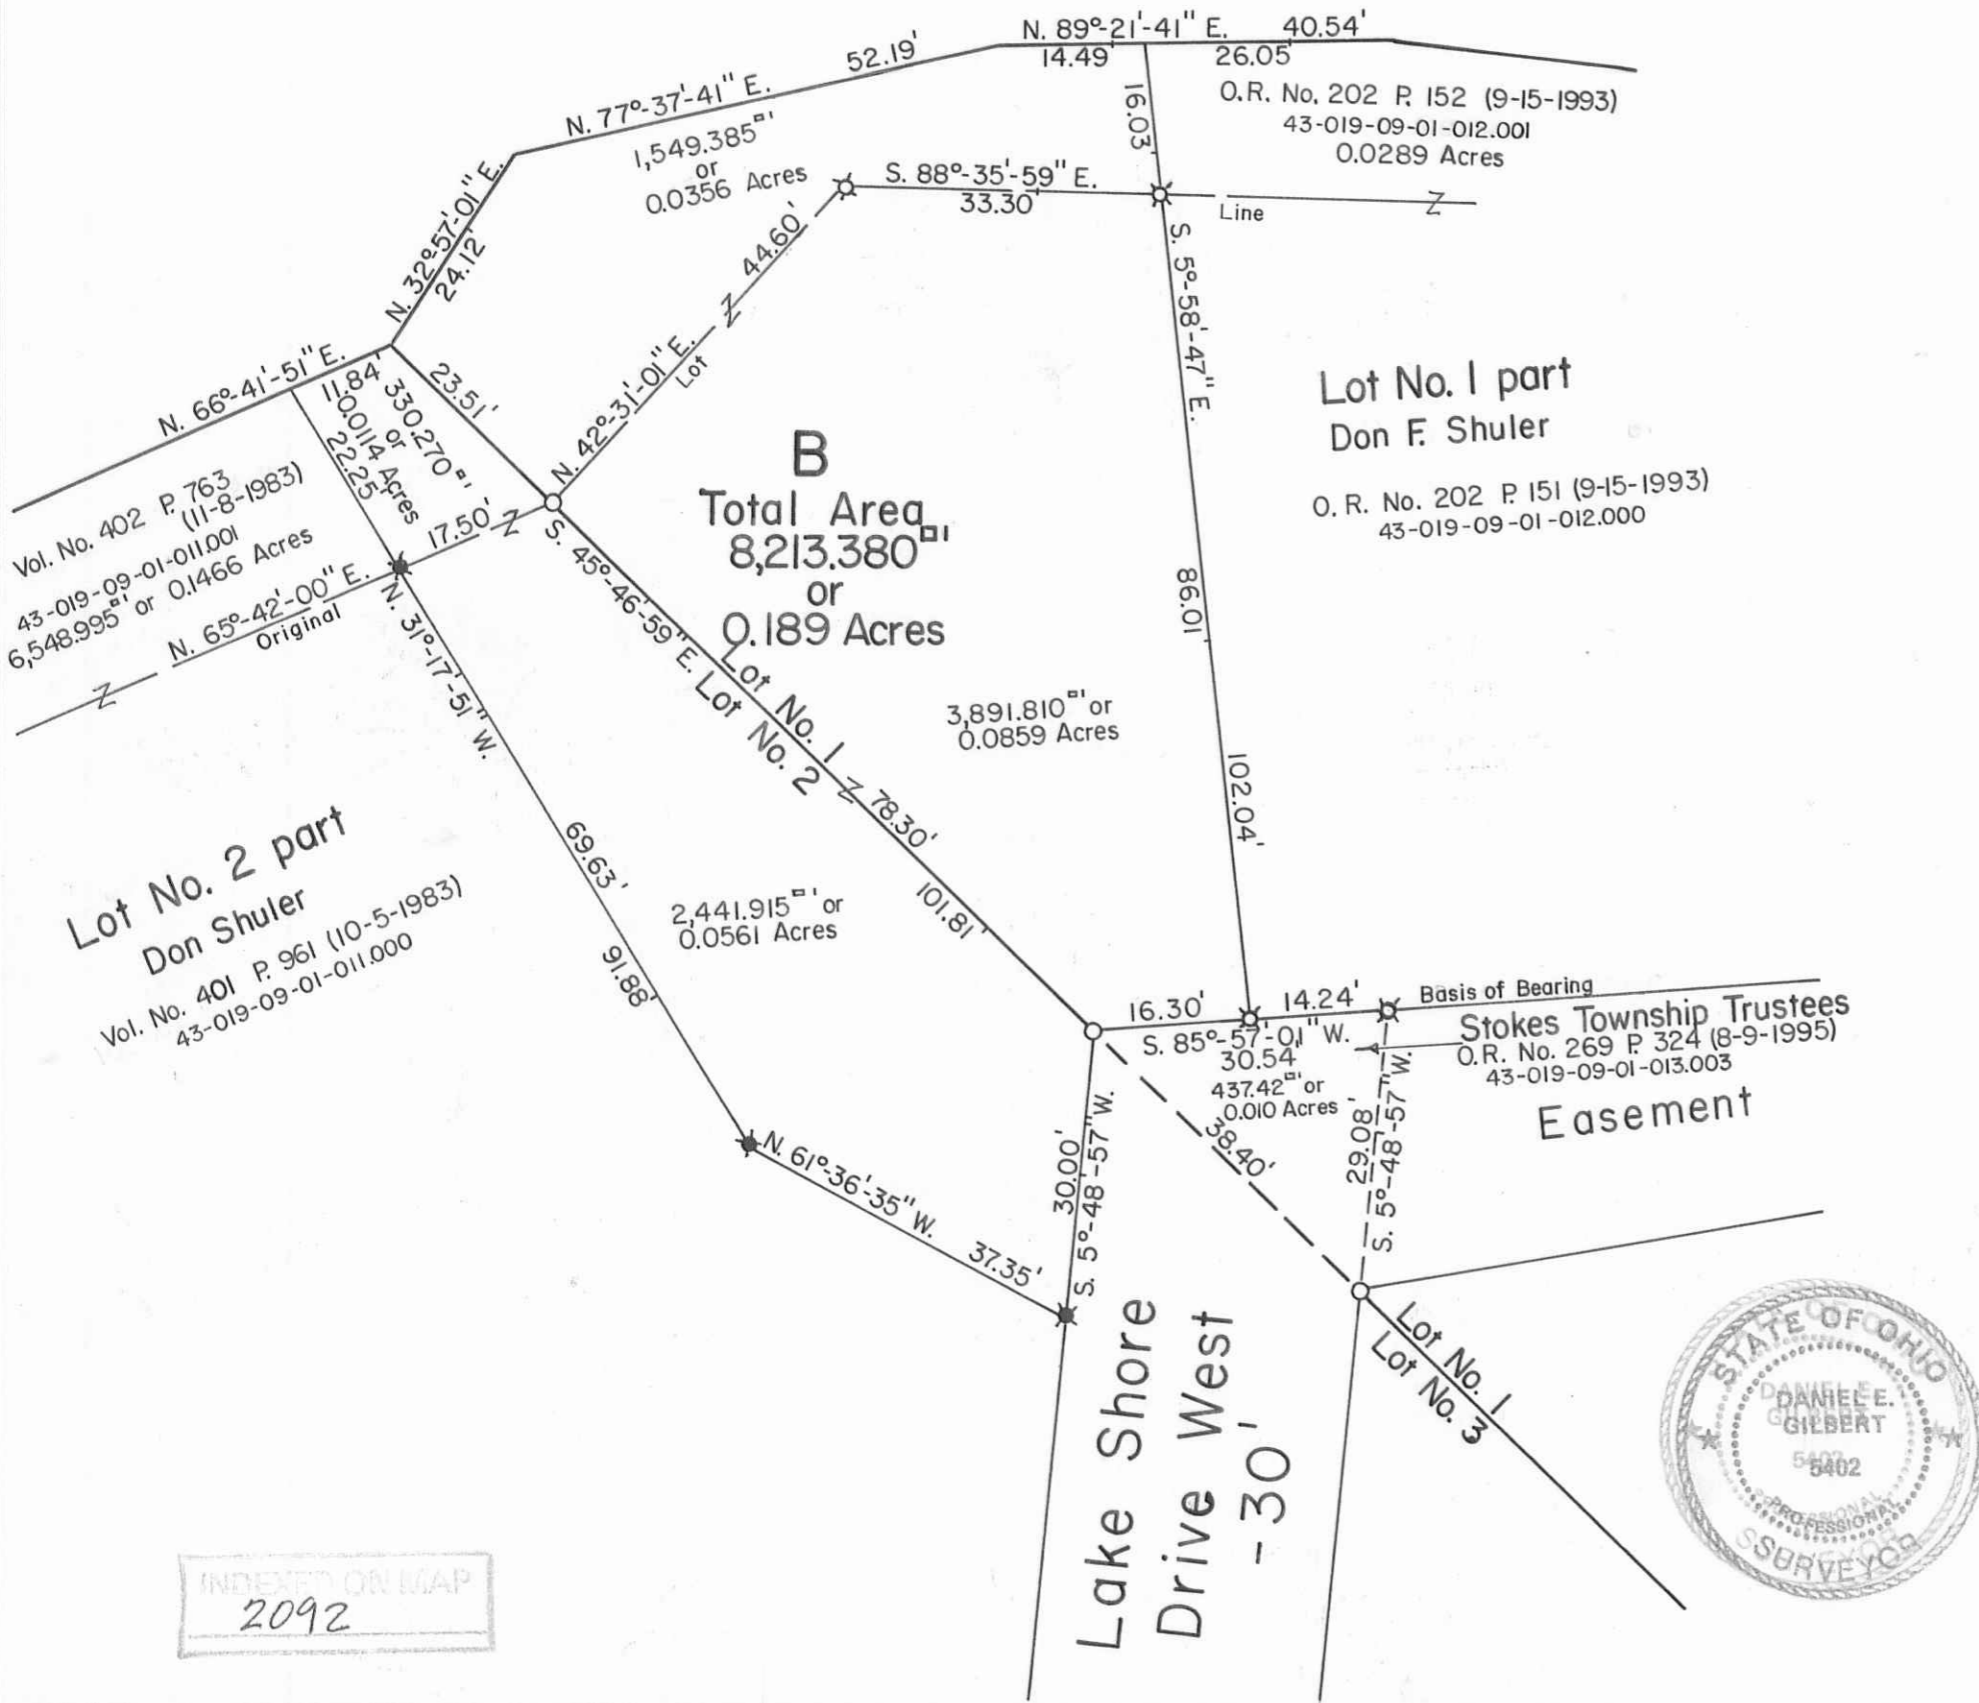

Don F. Shuler Survey-Part of Lot No. 1 and Lot No. 2, V.M.S. No. 12276, Shawnee Island Allotment, Shawnee Island, Stokes Township, Logan County, Ohio.

SCALE: 1" = 20'	APPROVED BY:	DRAWN BY: DEG
DATE: 10-6-1995		REVISED:
<i>Daniel E. Gilbert</i> Daniel E. Gilbert, P.S. Reg. Sur. No. 5402		DRAWING NUMBER: 095-048A

INDEXED ON MAP  
2092

S-031