
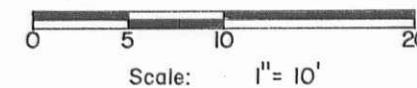


INDIAN LAKE

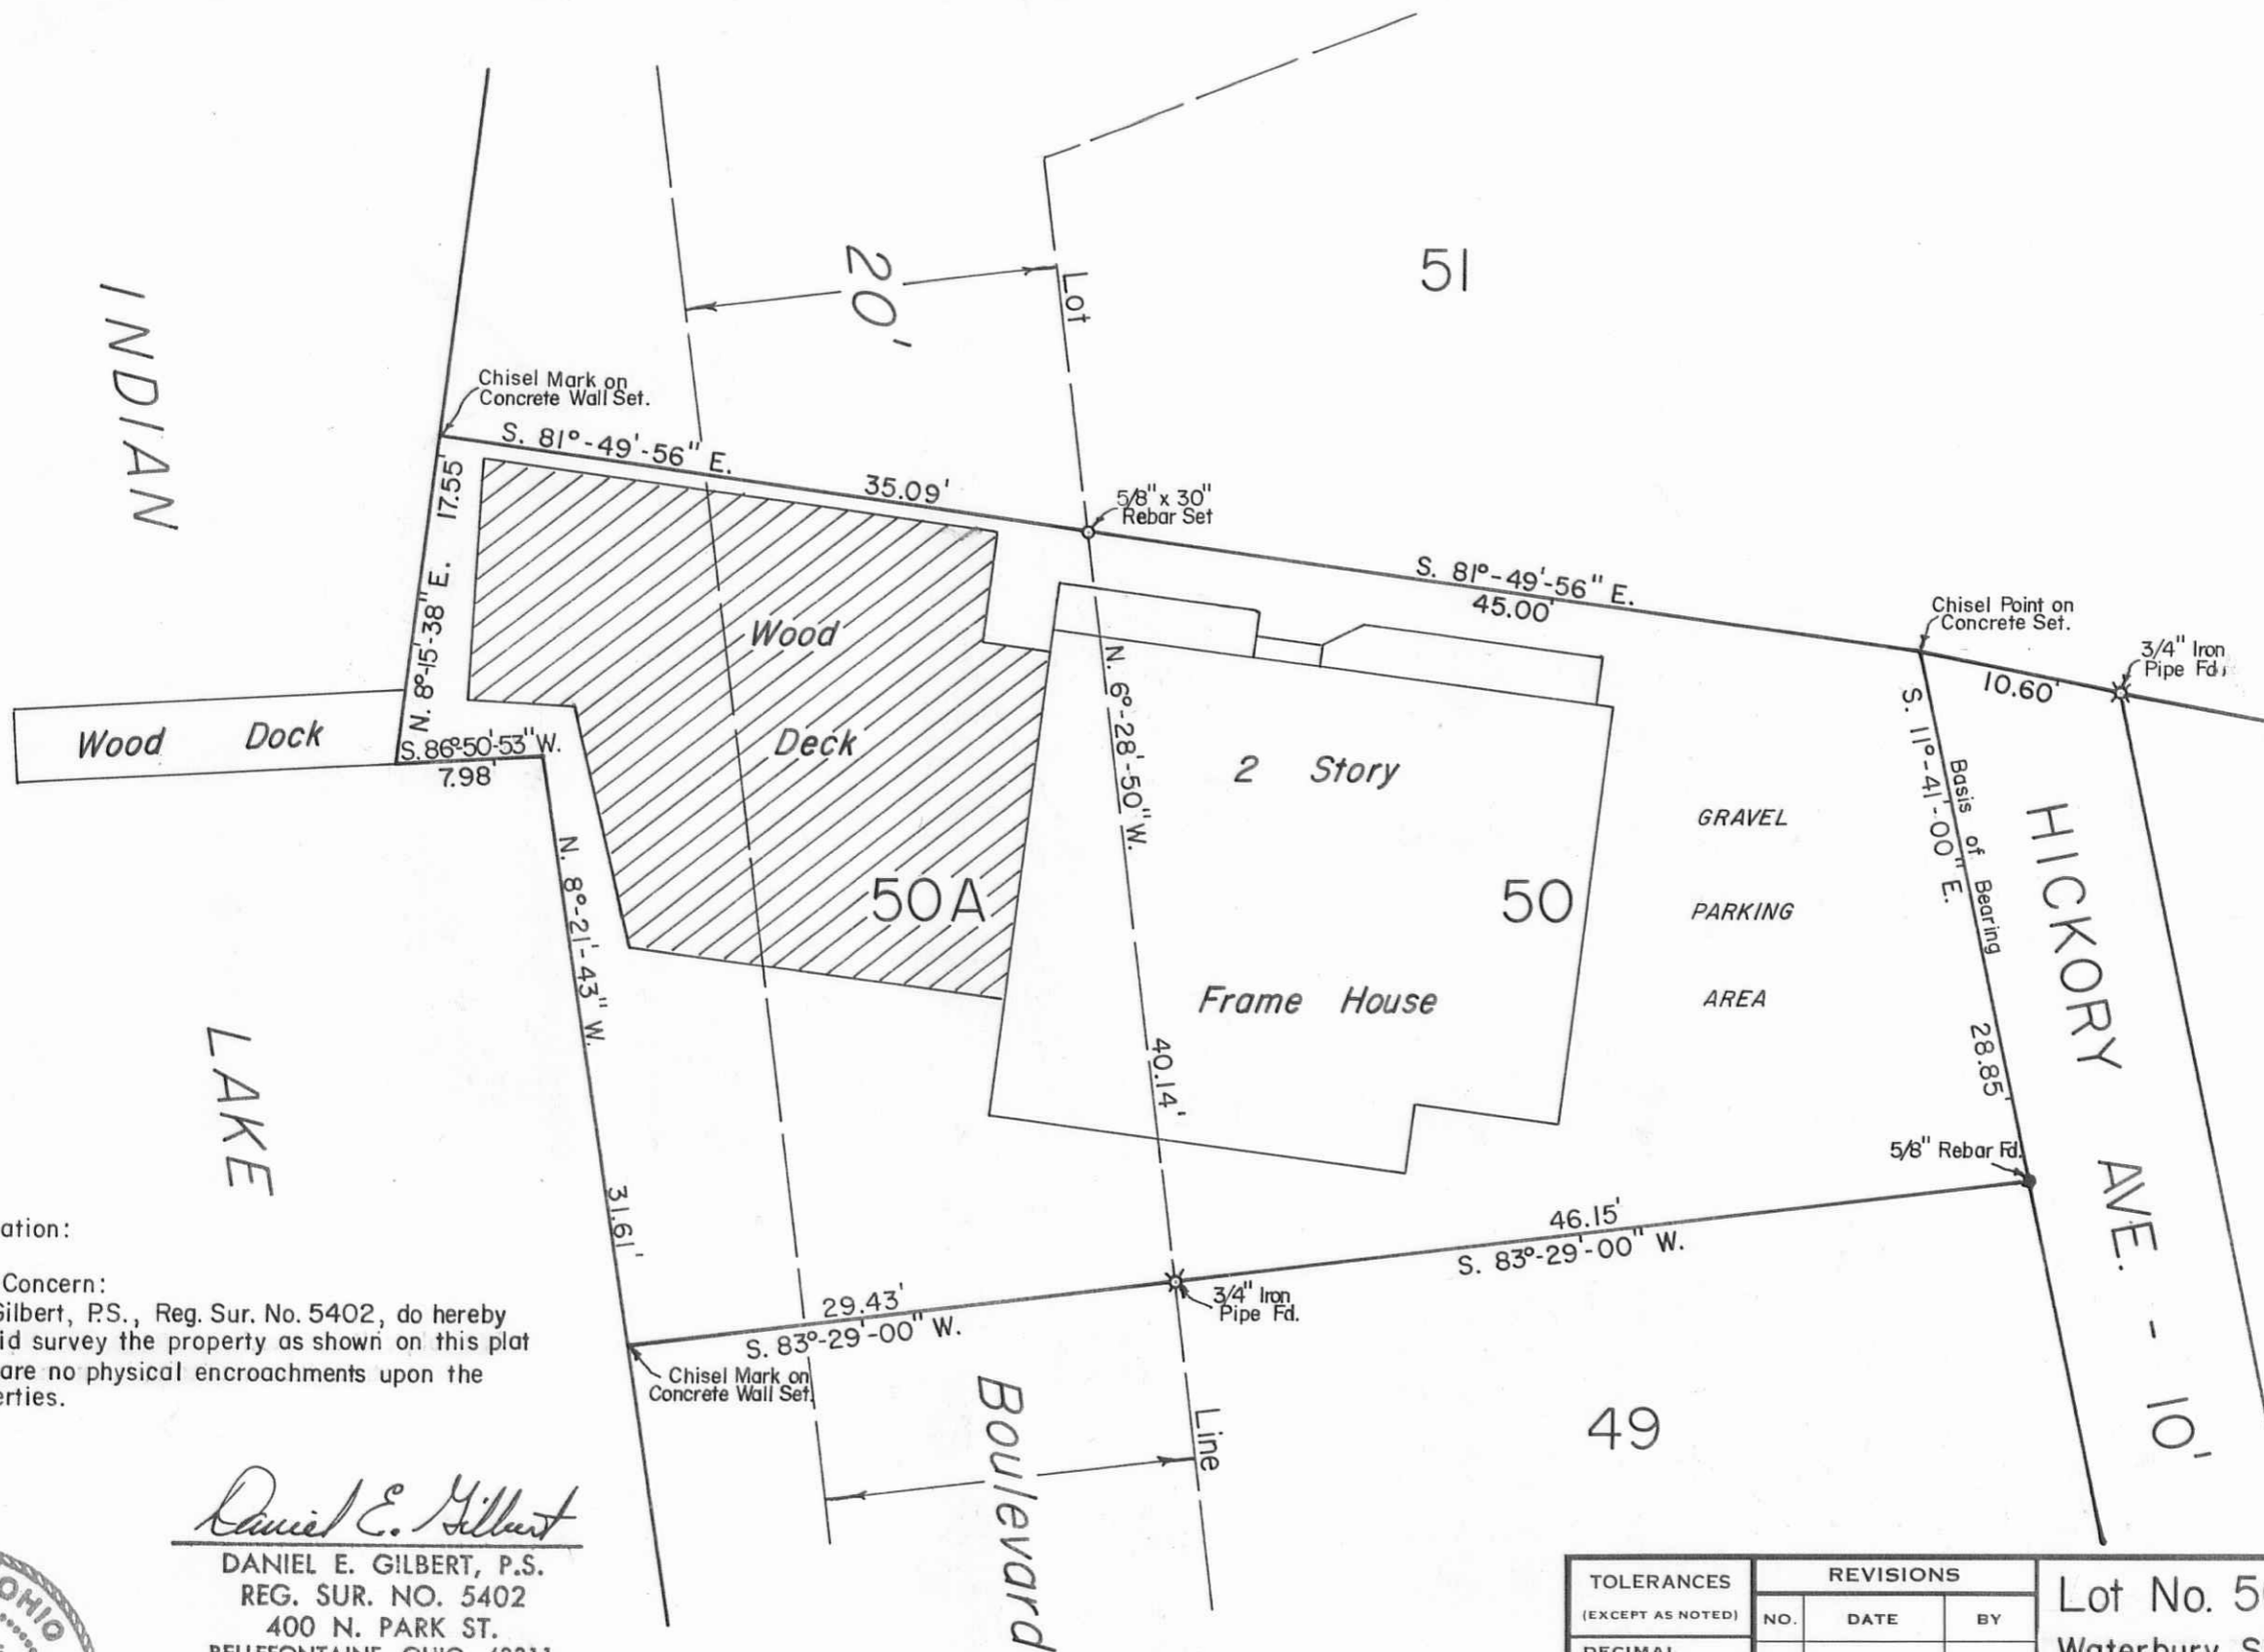

- REFERENCES:
- Waterbury Summer Resort. Plat Cab. A, Slides 223-225.
 - Waterbury Resort. Indian Lake Reservoir Lands. Plat Cab. A, Slides 581-587.
 - Frank Schulte-Hordelhoff et al Lot 50-50A. O. R. No. II P. 433 (II-8-1985).

Surveyors Certification:

To Whom It May Concern:
 I, Daniel E. Gilbert, P.S., Reg. Sur. No. 5402, do hereby certify that I did survey the property as shown on this plat and that there are no physical encroachments upon the adjoining properties.

Daniel E. Gilbert

DANIEL E. GILBERT, P.S.
 REG. SUR. NO. 5402
 400 N. PARK ST.
 BELLEFONTAINE, OHIO 43311
 TELEPHONE: 1 (513) 593-1428



INDEXED ON MAP
 9290

TOLERANCES (EXCEPT AS NOTED)	REVISIONS			Lot No. 50-50A Resurvey Waterbury Summer Resort Washington Township, Logan County, Ohio.
	NO.	DATE	BY	
DECIMAL	1			DRAWN BY DEG SCALE 1"=10' MATERIAL As Noted
±	2			
FRACTIONAL	3			CHK'D DEG DATE 11-22-1991 DRAWING NO. 091-058
±	4			
ANGULAR	5			TRACED DEG APP'D
±				

S-897