

SURVEYOR'S CERTIFICATE


I, DANIEL E. GILBERT, P.S., Ohio Reg. Sur. No. 5402, do hereby CERTIFY TO CHICAGO TITLE INSURANCE CO. AND BANK ONE, COLUMBUS, N. A., THAT I HAVE LOCATED THE IMPROVEMENTS ON THE PROPERTY OF CARTER STEEL AND FABRICATING CO. AS SHOWN ON THIS PLAT.

THERE IS AN ENCROACHMENT AT THE SOUTHWEST END OF CARLISLE AVENUE AS SHOWN BY THE SHADED AREA. NO FLOOD PLAIN DATA AVAILABLE FOR THIS AREA.

ALL BUILDINGS ARE LOCATED WITHIN PROPERTY LINES.

ALL RIGHT OF WAYS AND EASEMENTS ARE NOTED.

Daniel E. Gilbert
 DANIEL E. GILBERT, P.S.
 REG. SUR. NO. 5402
 400 N. PARK ST.
 BELLEFONTAINE, OHIO
 43311

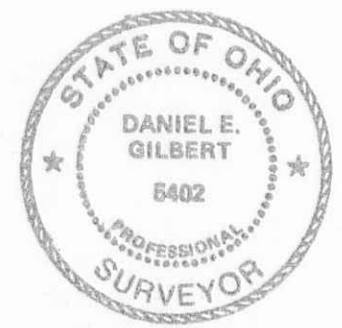

CARTER STEEL AND FABRICATING CO.
 AS BUILT SURVEY
 SECTION No 33 T. 4 R. 14 BMRS
 CITY OF BELLEFONTAINE
 LAKE TOWNSHIP
 LOGAN COUNTY, OHIO
 APRIL 1989

SCALE: 1"=40'

INDEX ON MAP
 4544