





SEE SHEET 27

MAIN

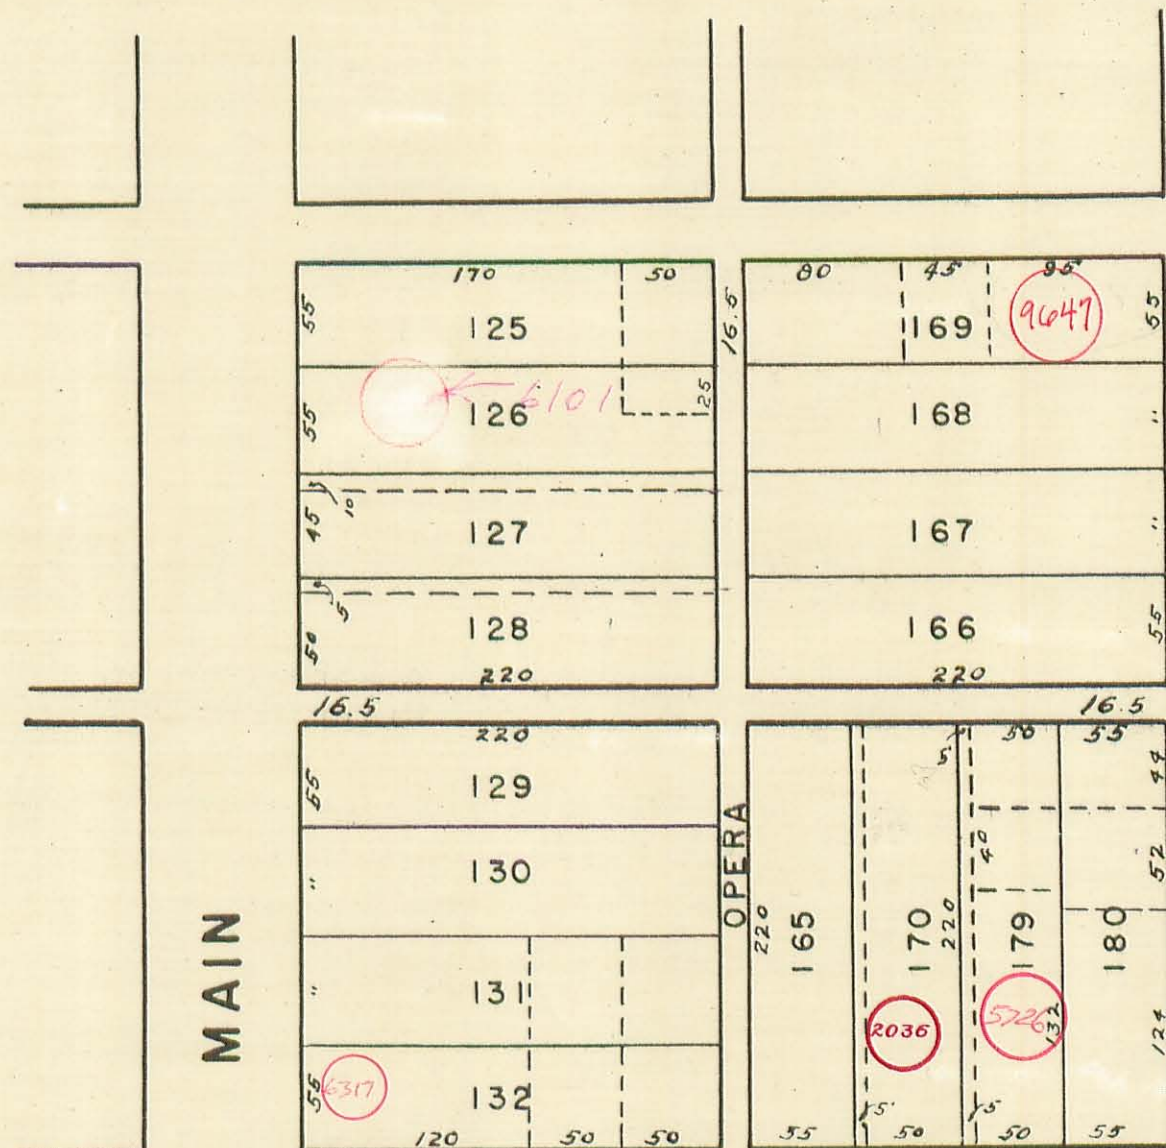

BROWN

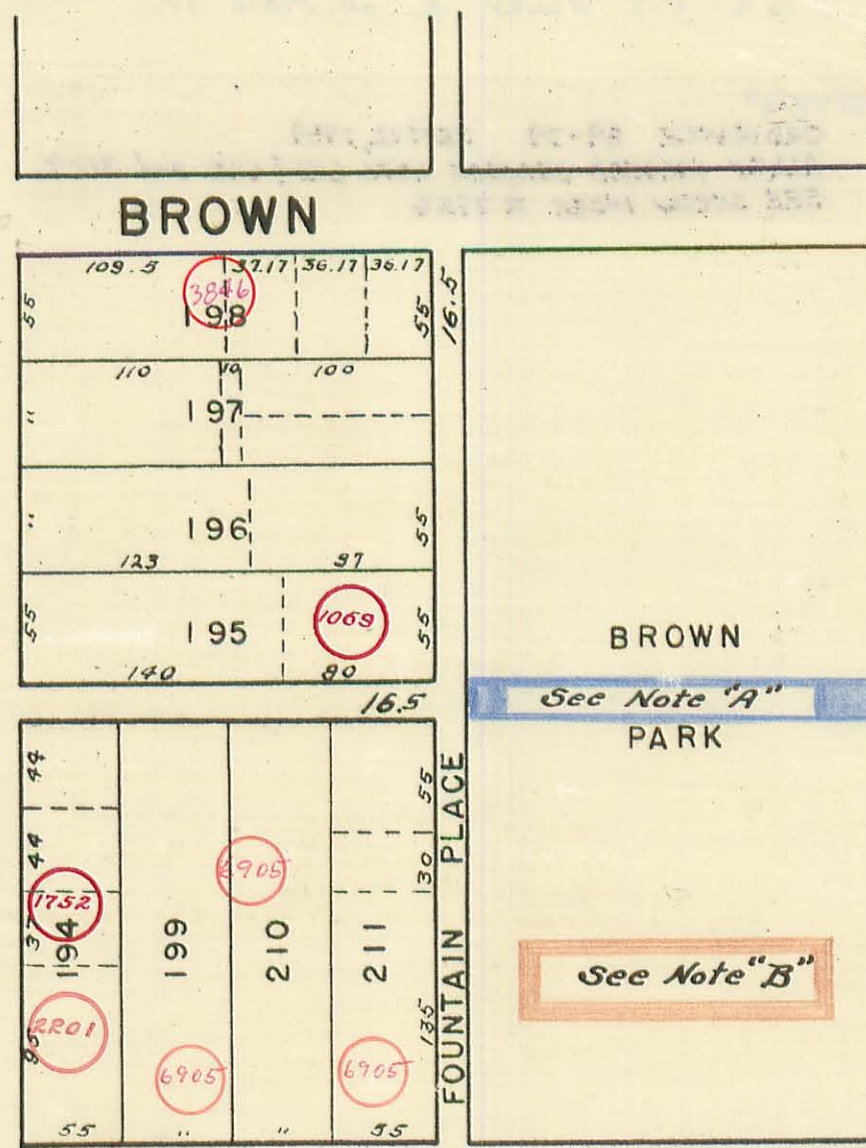

BROWN

BROWN



See Note "A"
PARK

See Note "B"

PARK

MADRIVER

SANDUSKY

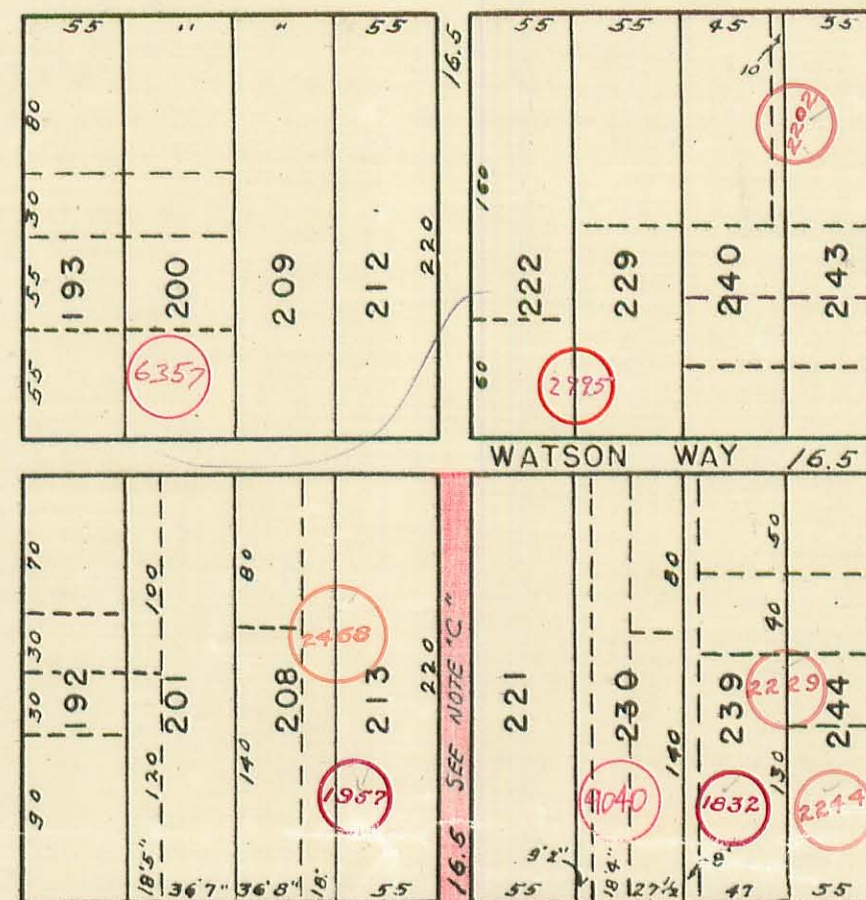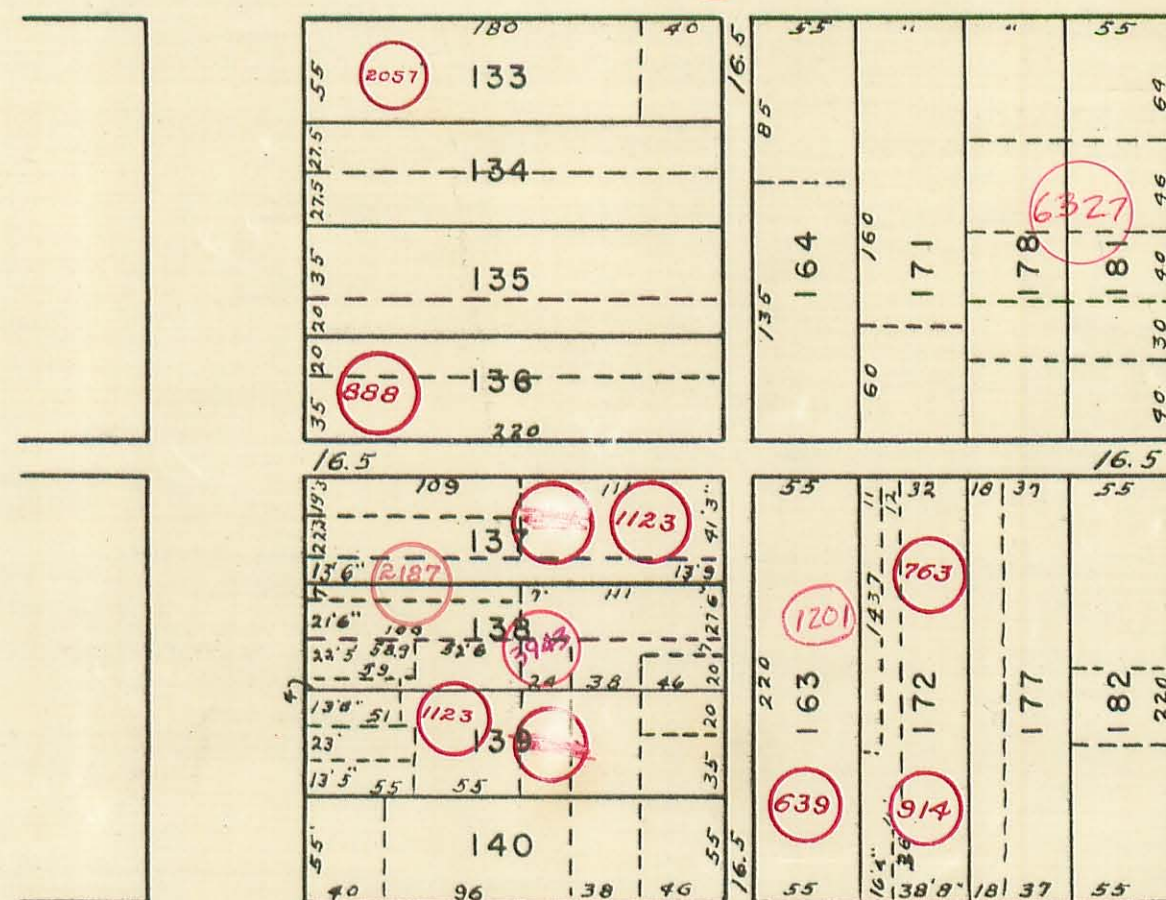

48

SEE SHEET