


BROWN

SEE PAGE 69

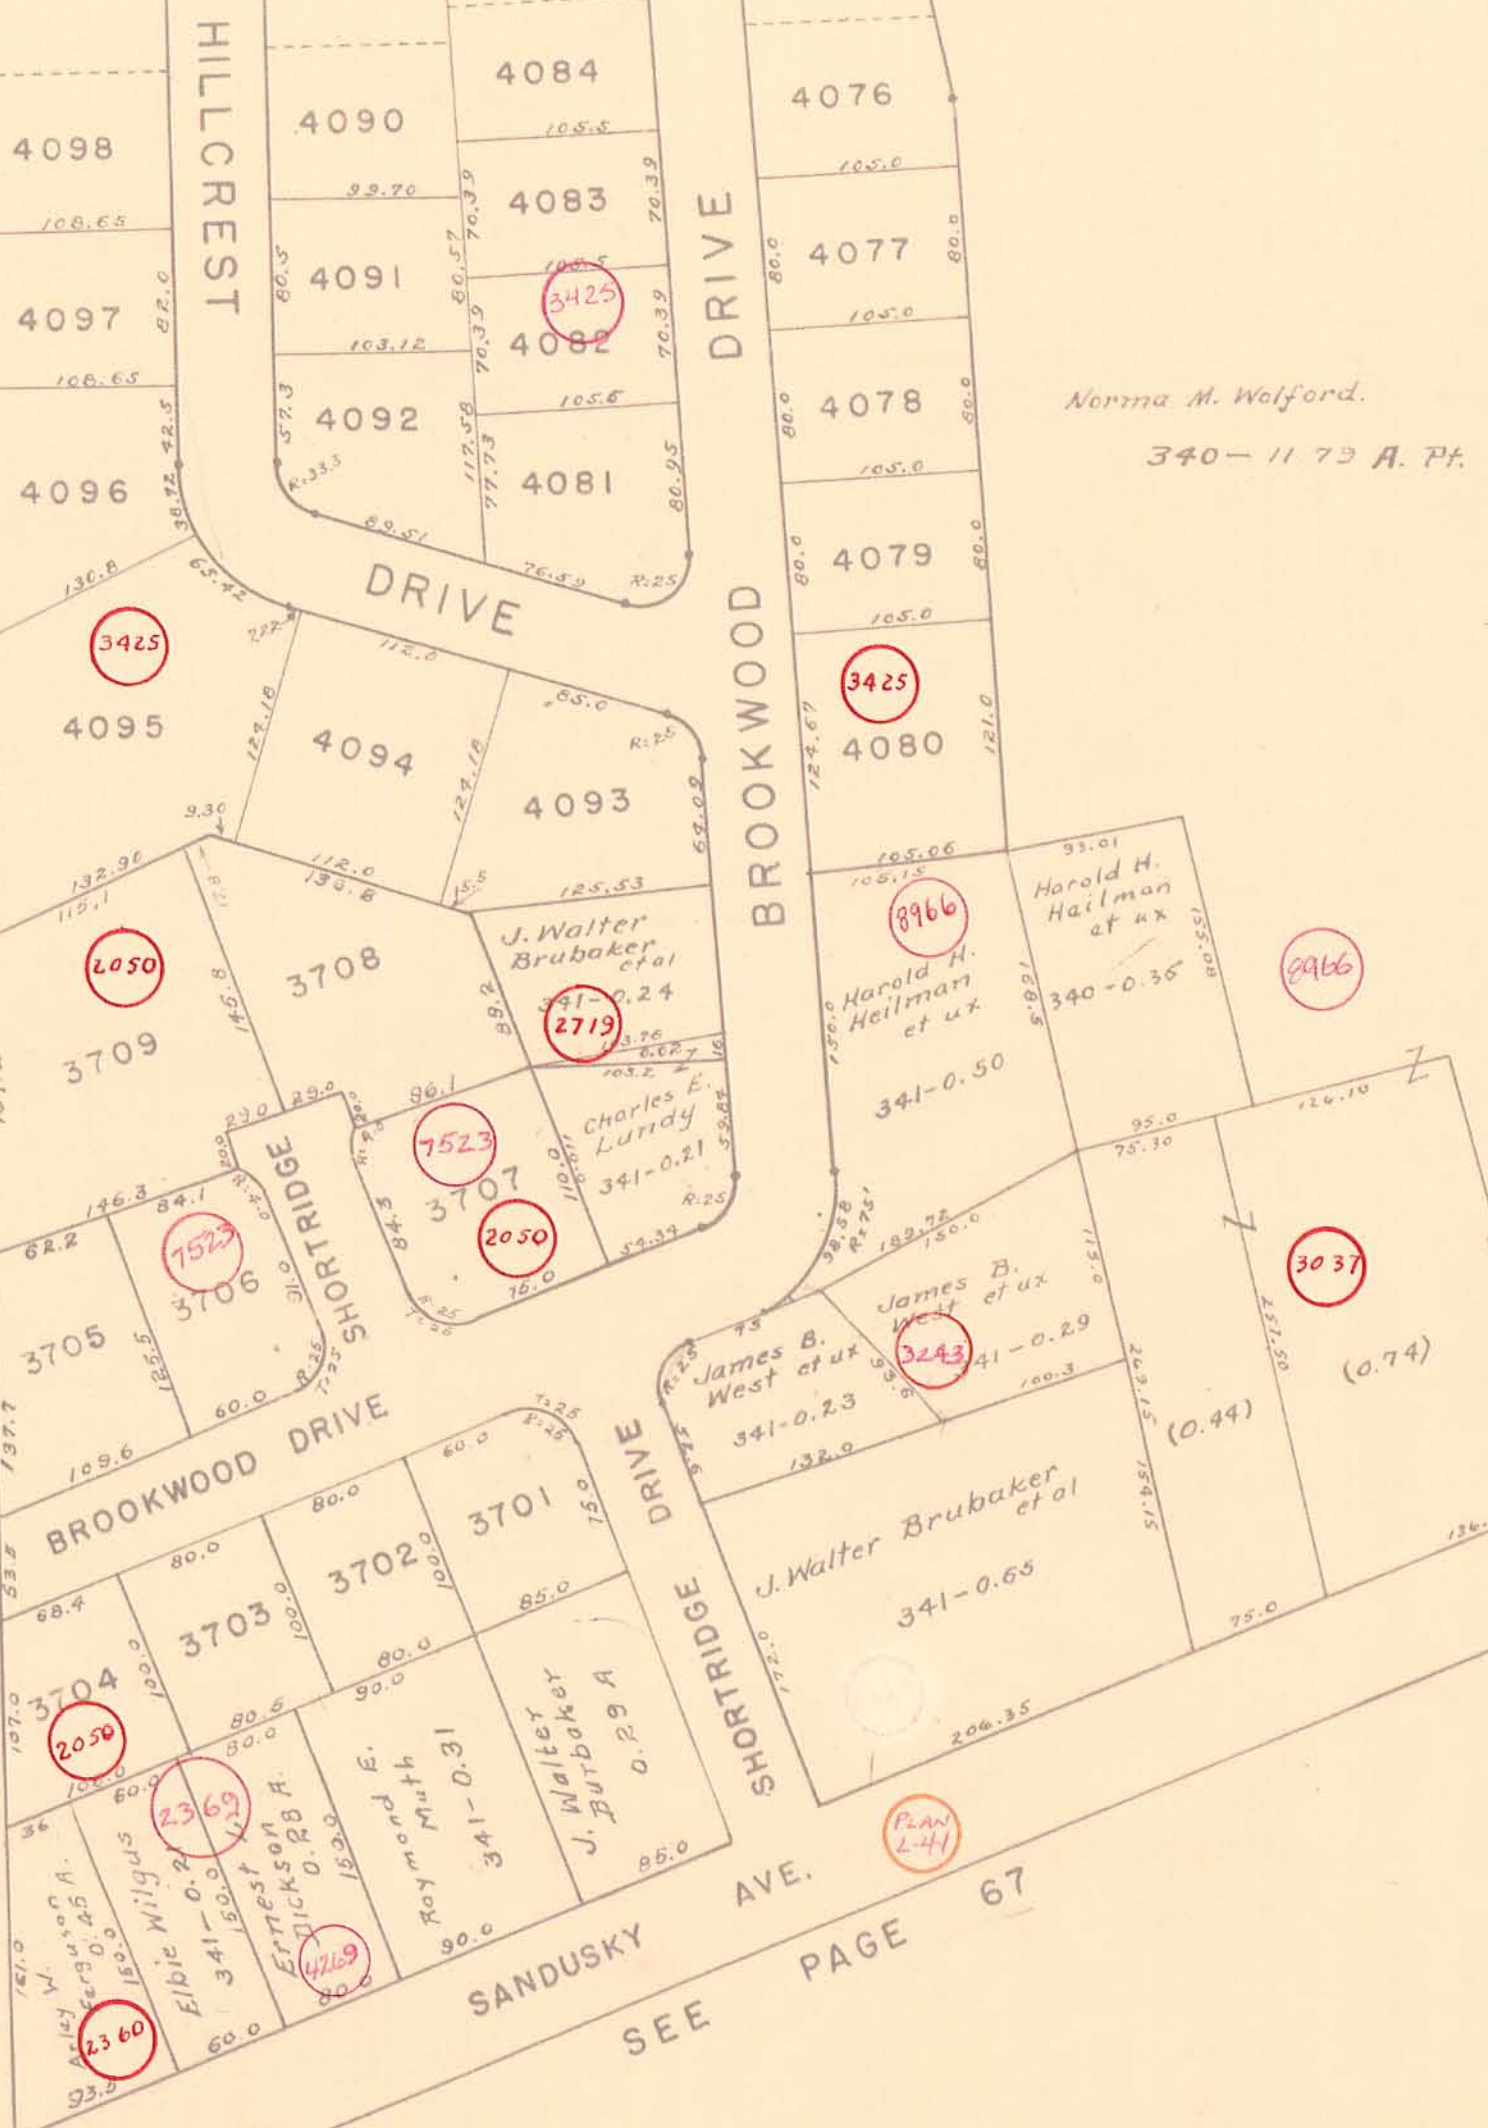

Norma M. Wolford.  
340-11.75 A. P.

CORPORATION LINE

6046  
Brookwood #7

6999

8966

3037

PLAN 2-41

SEE PAGE 61

SEE PAGE 67