


JEFFERSON TOWNSHIP

VIRGINIA MILITARY SURVEY 3439

SCALE: 1"=10 CHAINS=660'

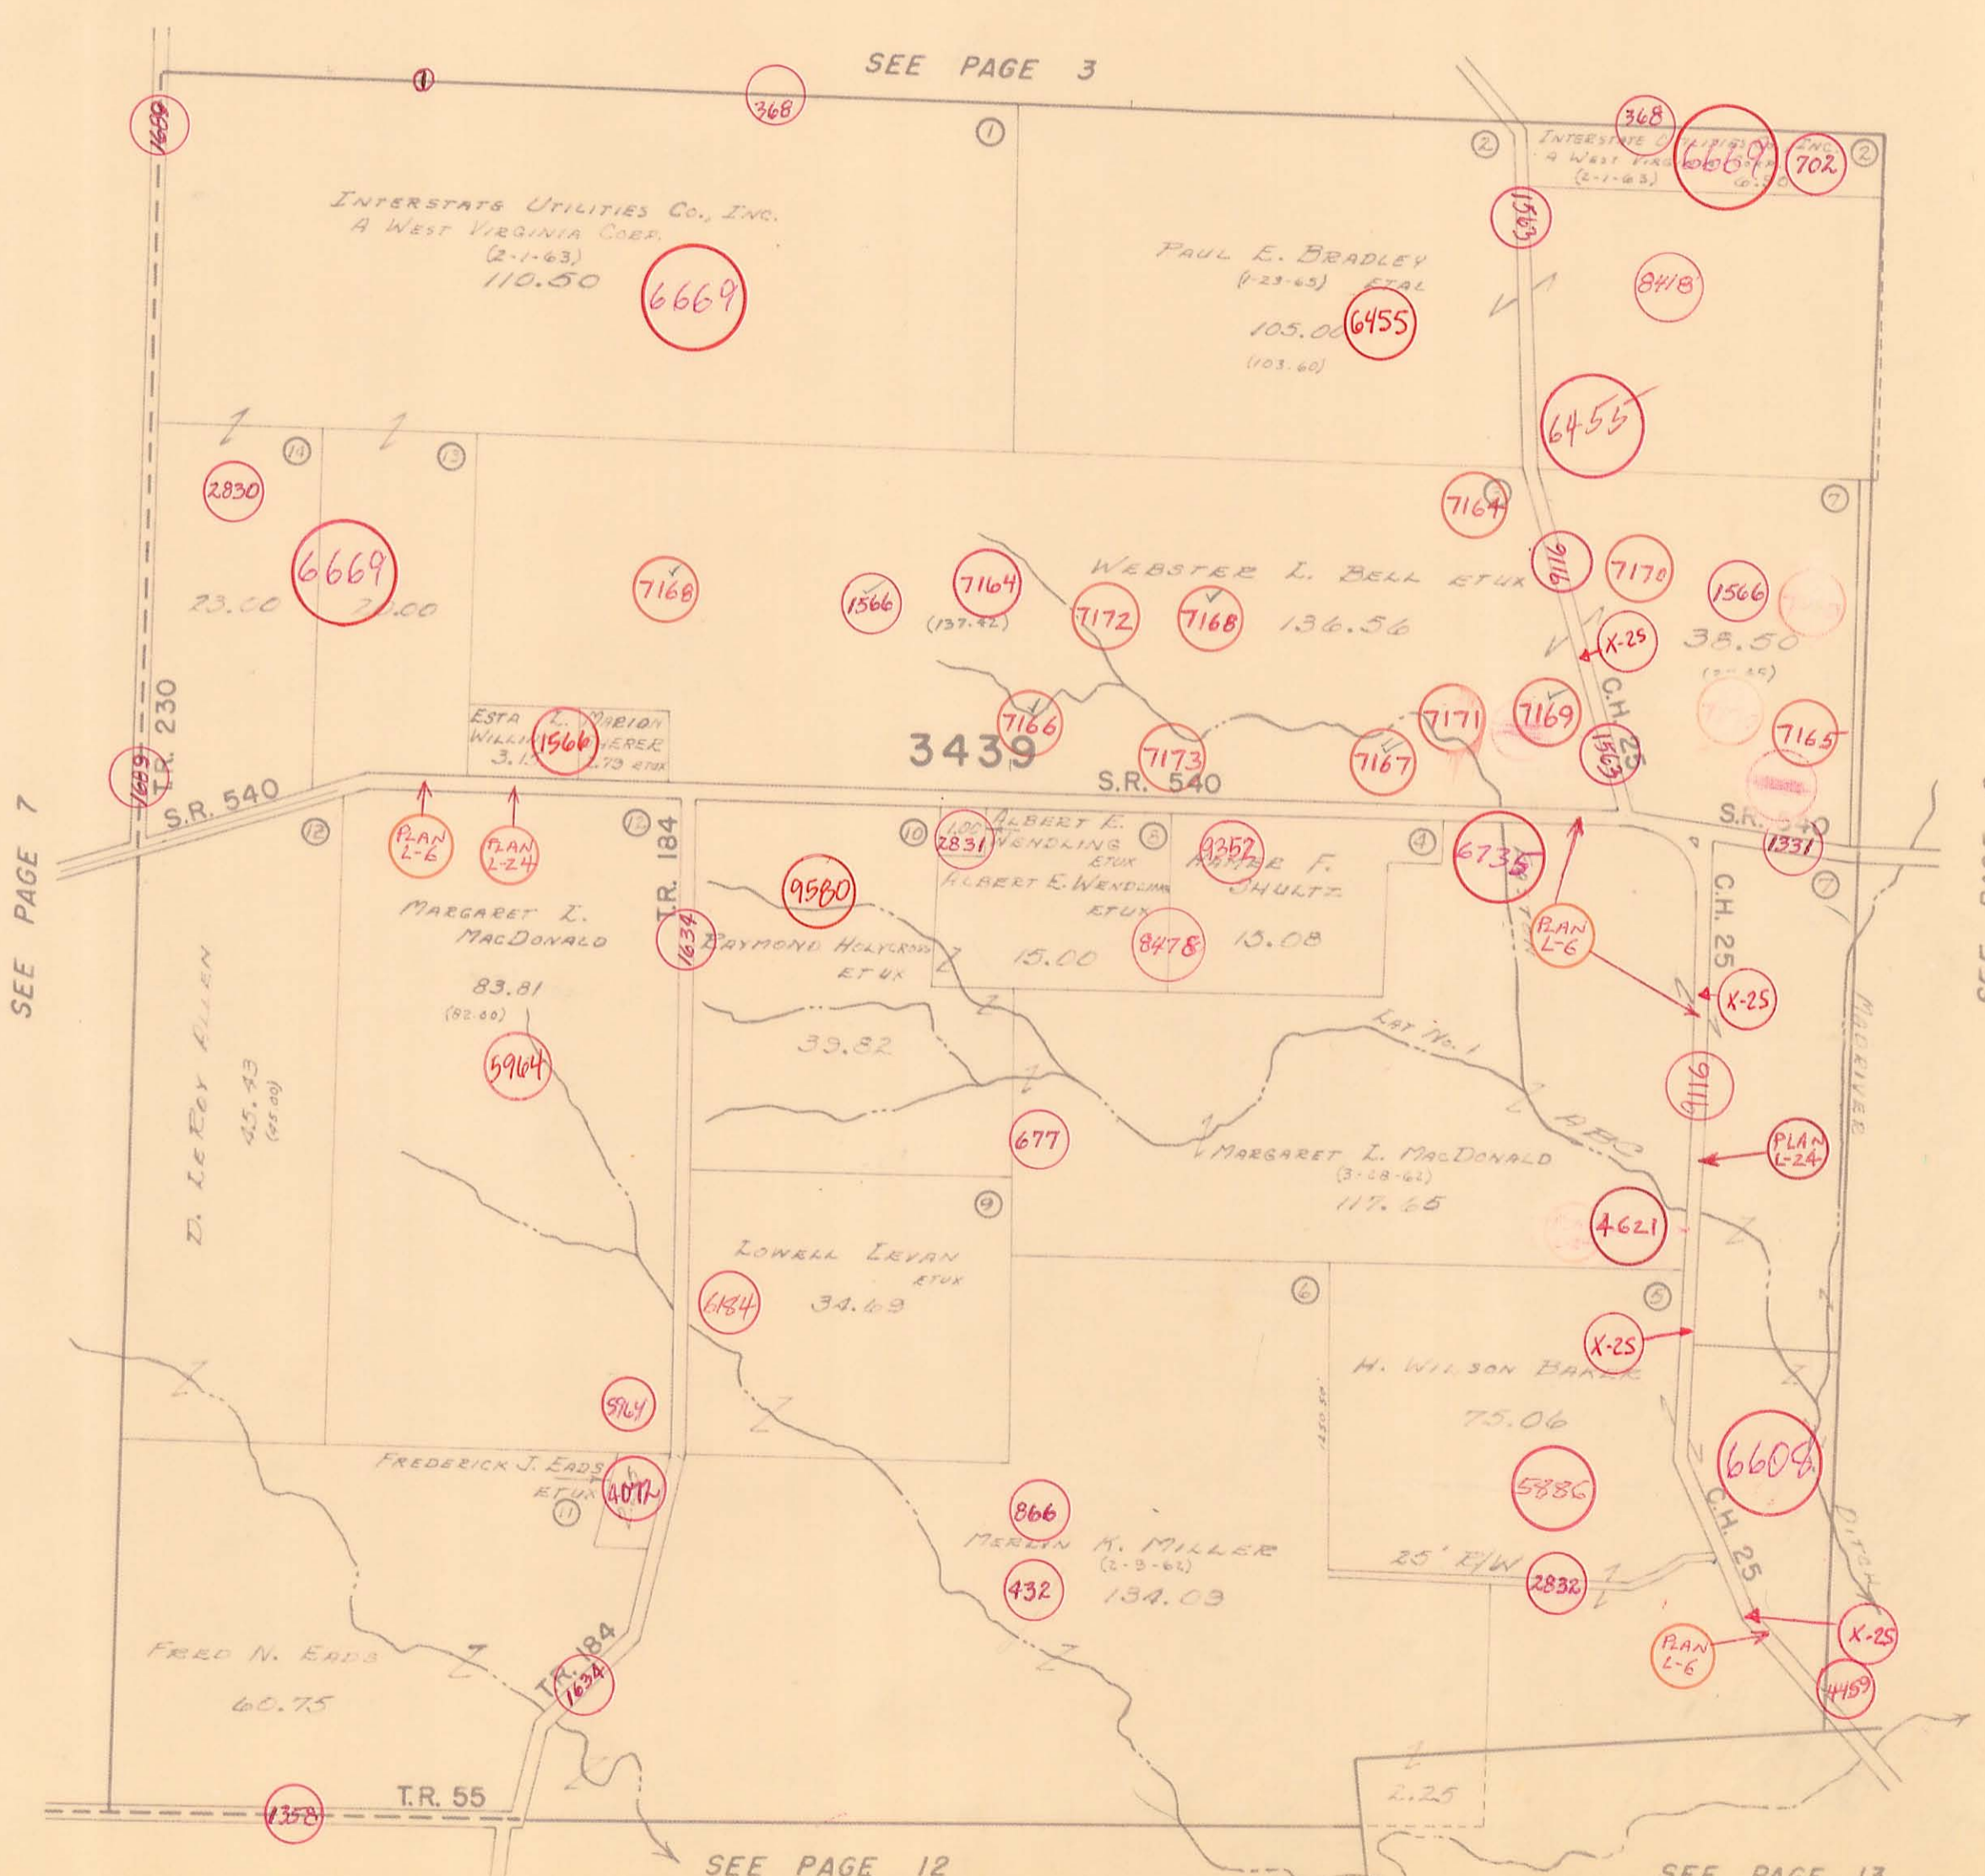

DRAWN AUGUST 2, 1962
BY D.E.G.
FROM AERIAL PHOTO