


JEFFERSON TOWNSHIP
VIRGINIA MILITARY SURVEY 6450

SCALE: 1" = 10 CHAINS = 660'

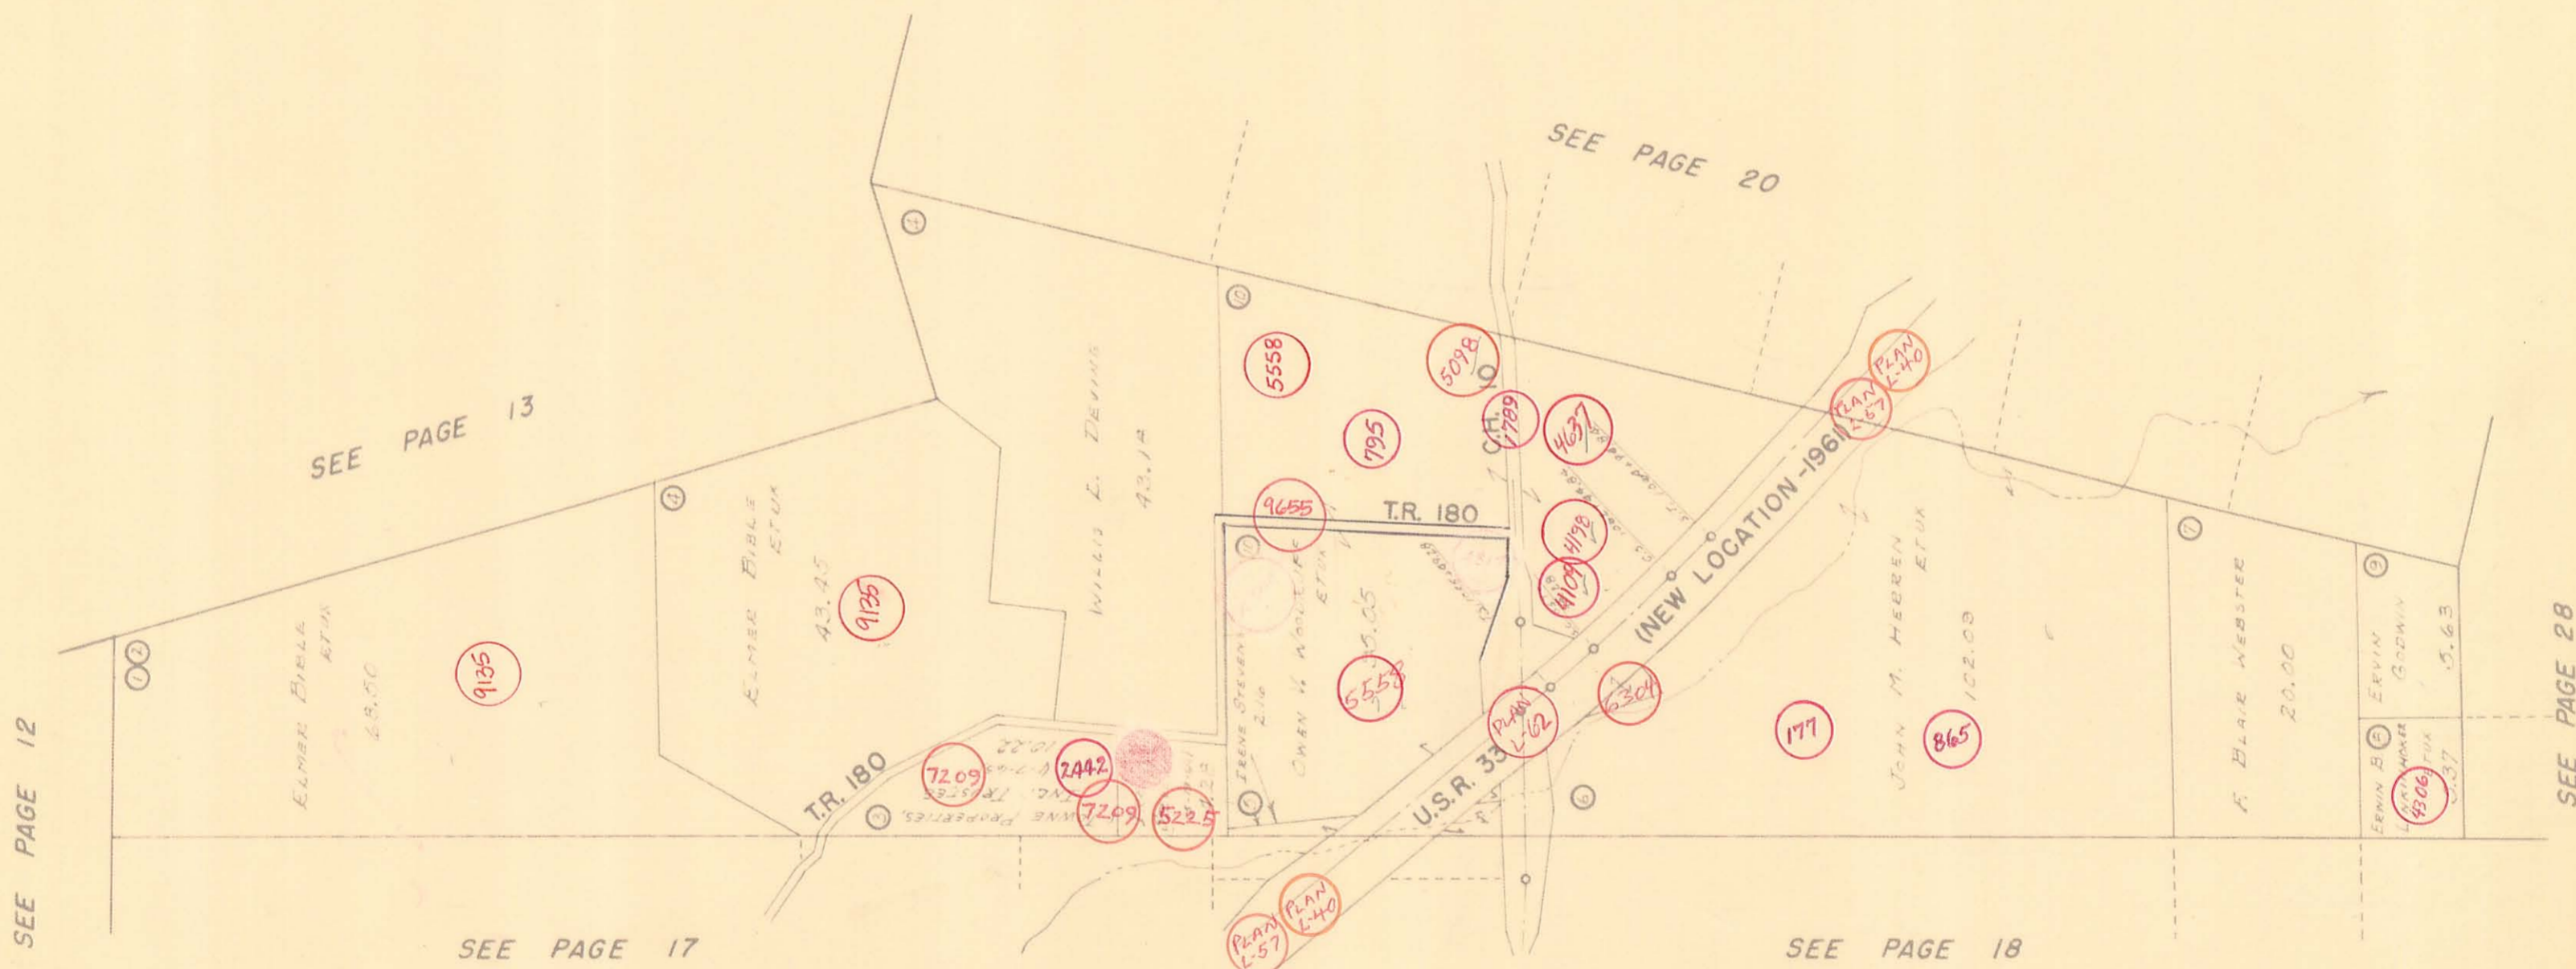

DRAWN NOVEMBER 2, 1962
BY D.E.G.
FROM AERIAL PHOTO