


LAKE TOWNSHIP  
 VIRGINIA MILITARY SURVEYS

3683  
 4399  
 4990 PT.  
 5245

SCALE 10 CHAINS = 1 INCH

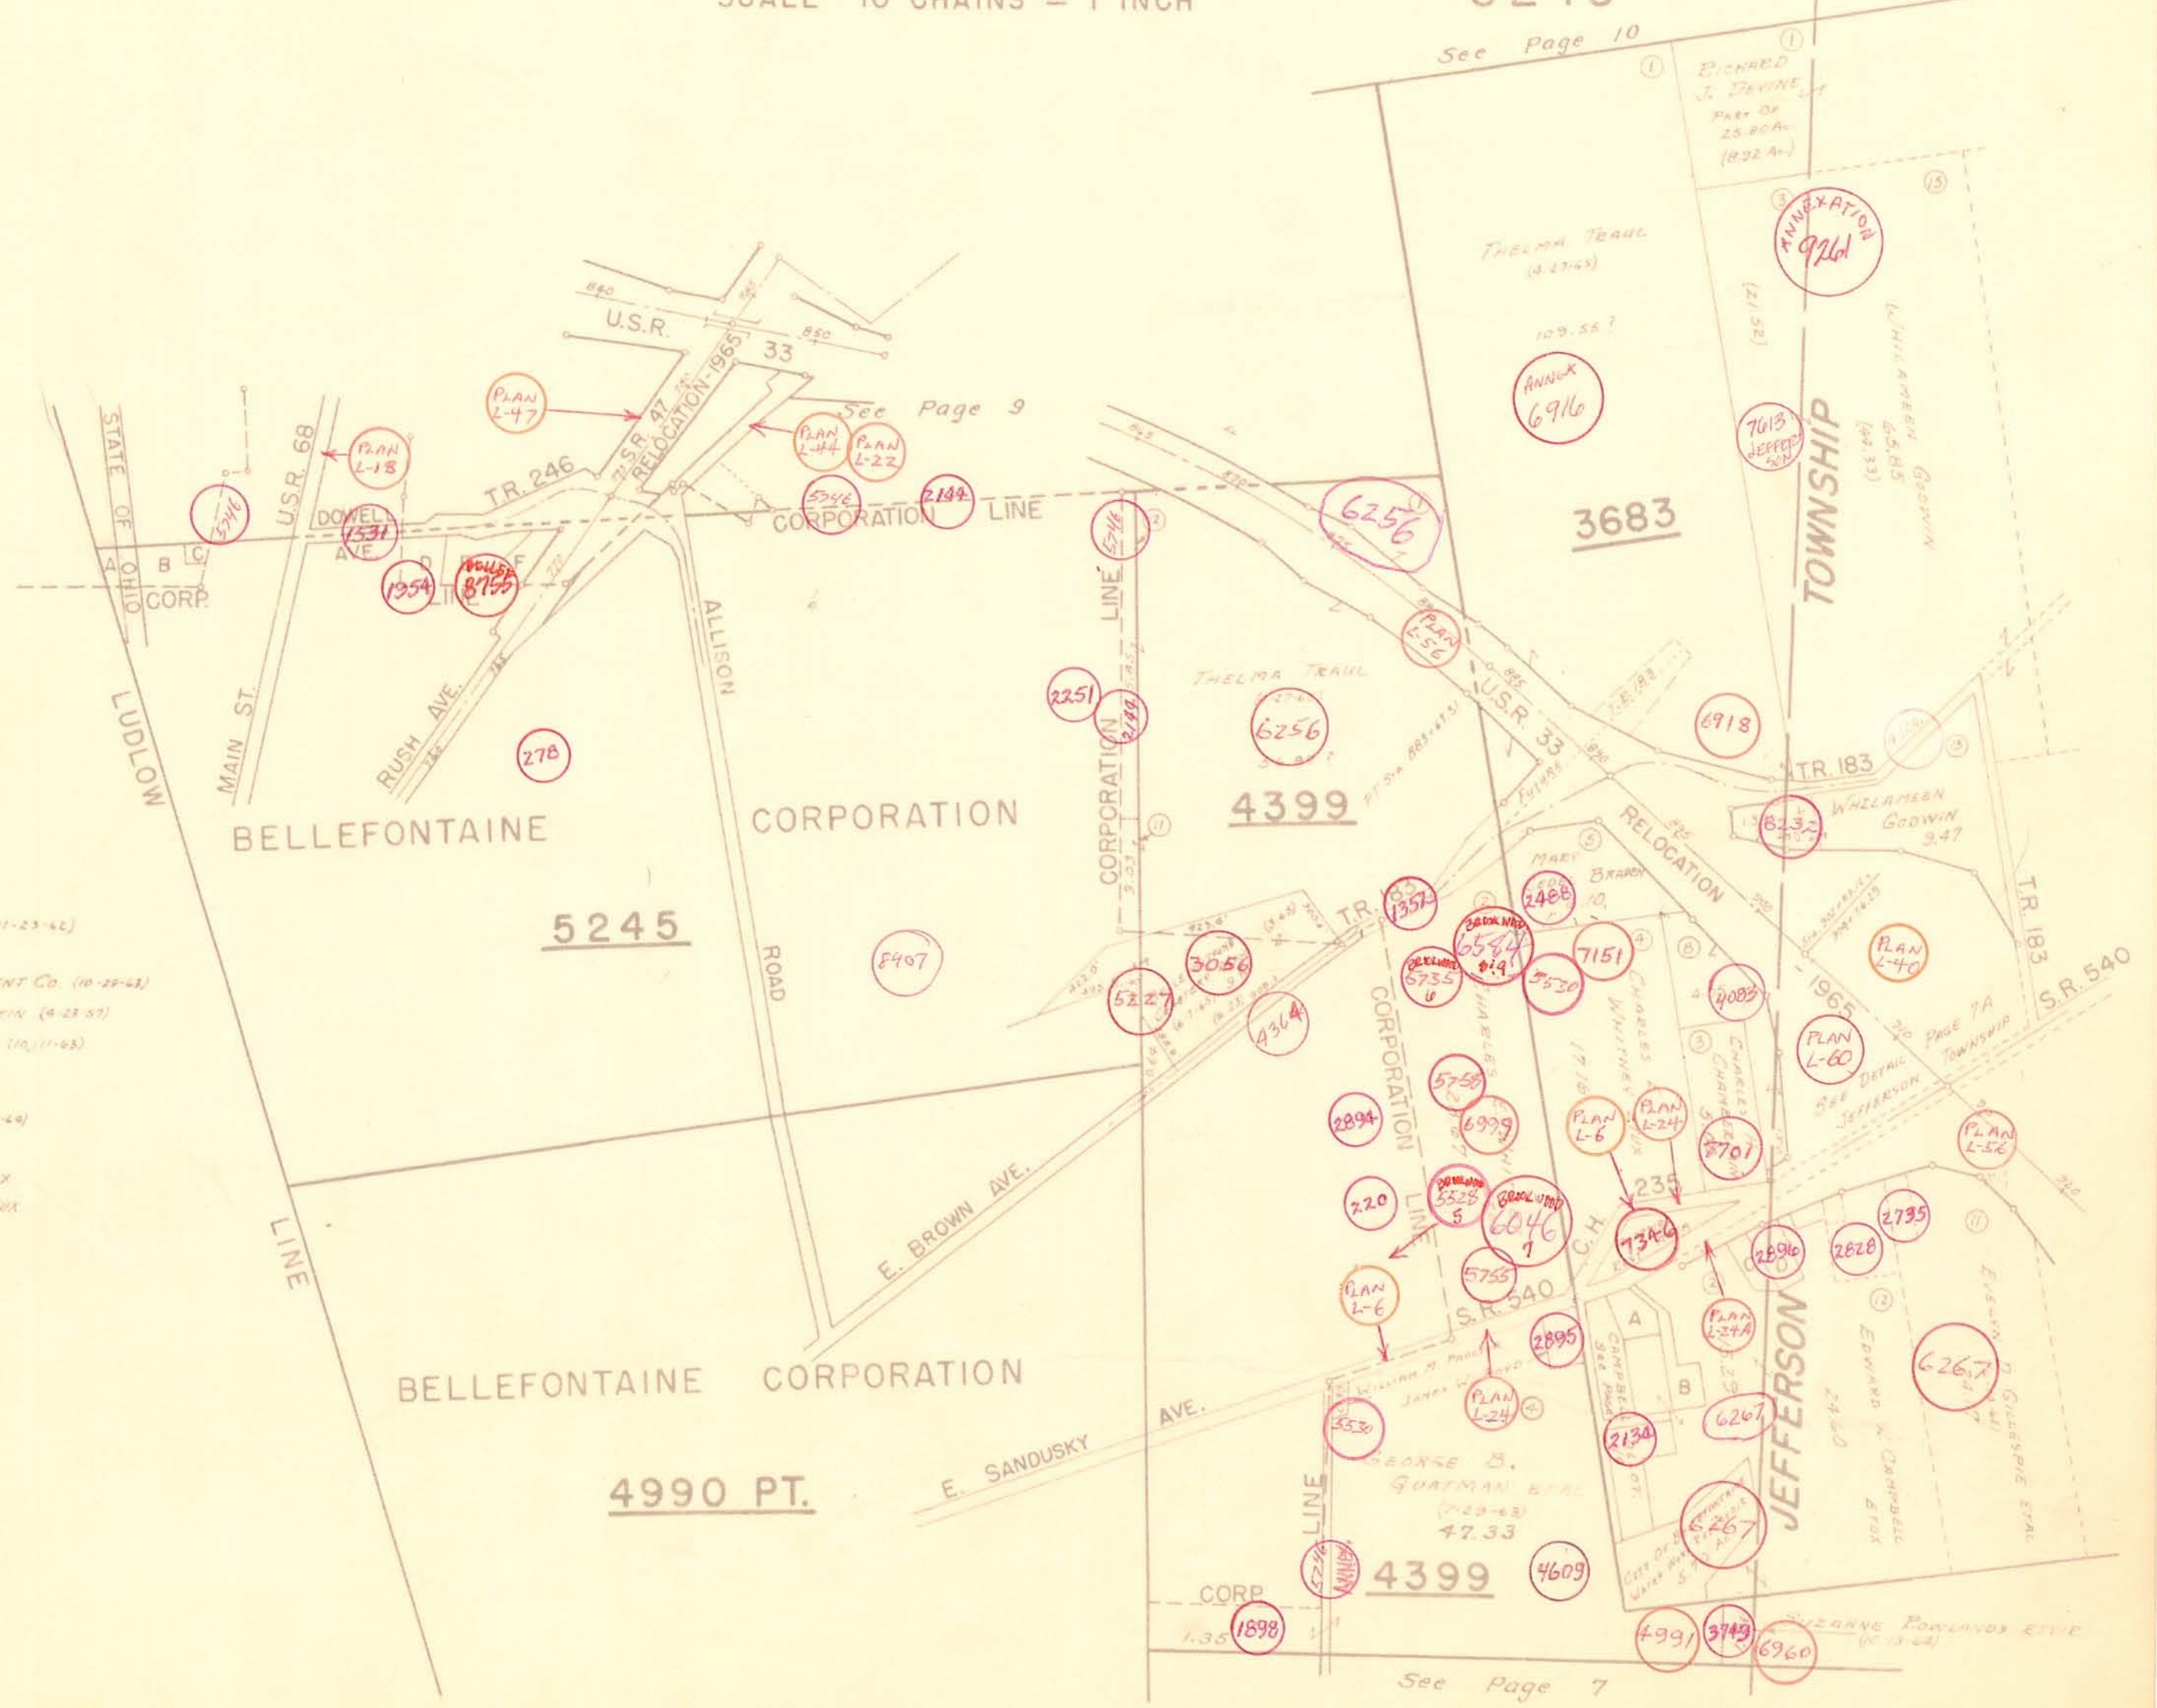

- V.M.S. 5245
- A. - 0.81 PT.
  - B. - 0.84 - JESSIE M. SICKLES (11-23-42)
  - C. - 0.12 - MARY J. JACOBS
  - D. - 1.08 - BELLE AIR DEVELOPMENT CO. (10-28-41)
  - E. - 1.53 - CLIFFORD H. HERTENSTEIN (4-21-57)
  - F. - 1.13 - ROBERT L. BRACKNEY (10-11-43)
- V.M.S. 3683
- A. - 0.90 - TROY LEATH ETUX (4-21-49)
  - B. - 1.20 - PAUL T. CHILES
  - C. - 0.88 - LEE C. HAMMOND ETUX
  - D. - 1.32 - JAMES G. KENNEDY ETUX

Nov. 3, 1960  
 N.S.D.

See Page 7