


MIAMI TOWNSHIP  
SECTION 11 TOWN 3 RANGE 13

SCALE 10 CHAINS TO THE INCH

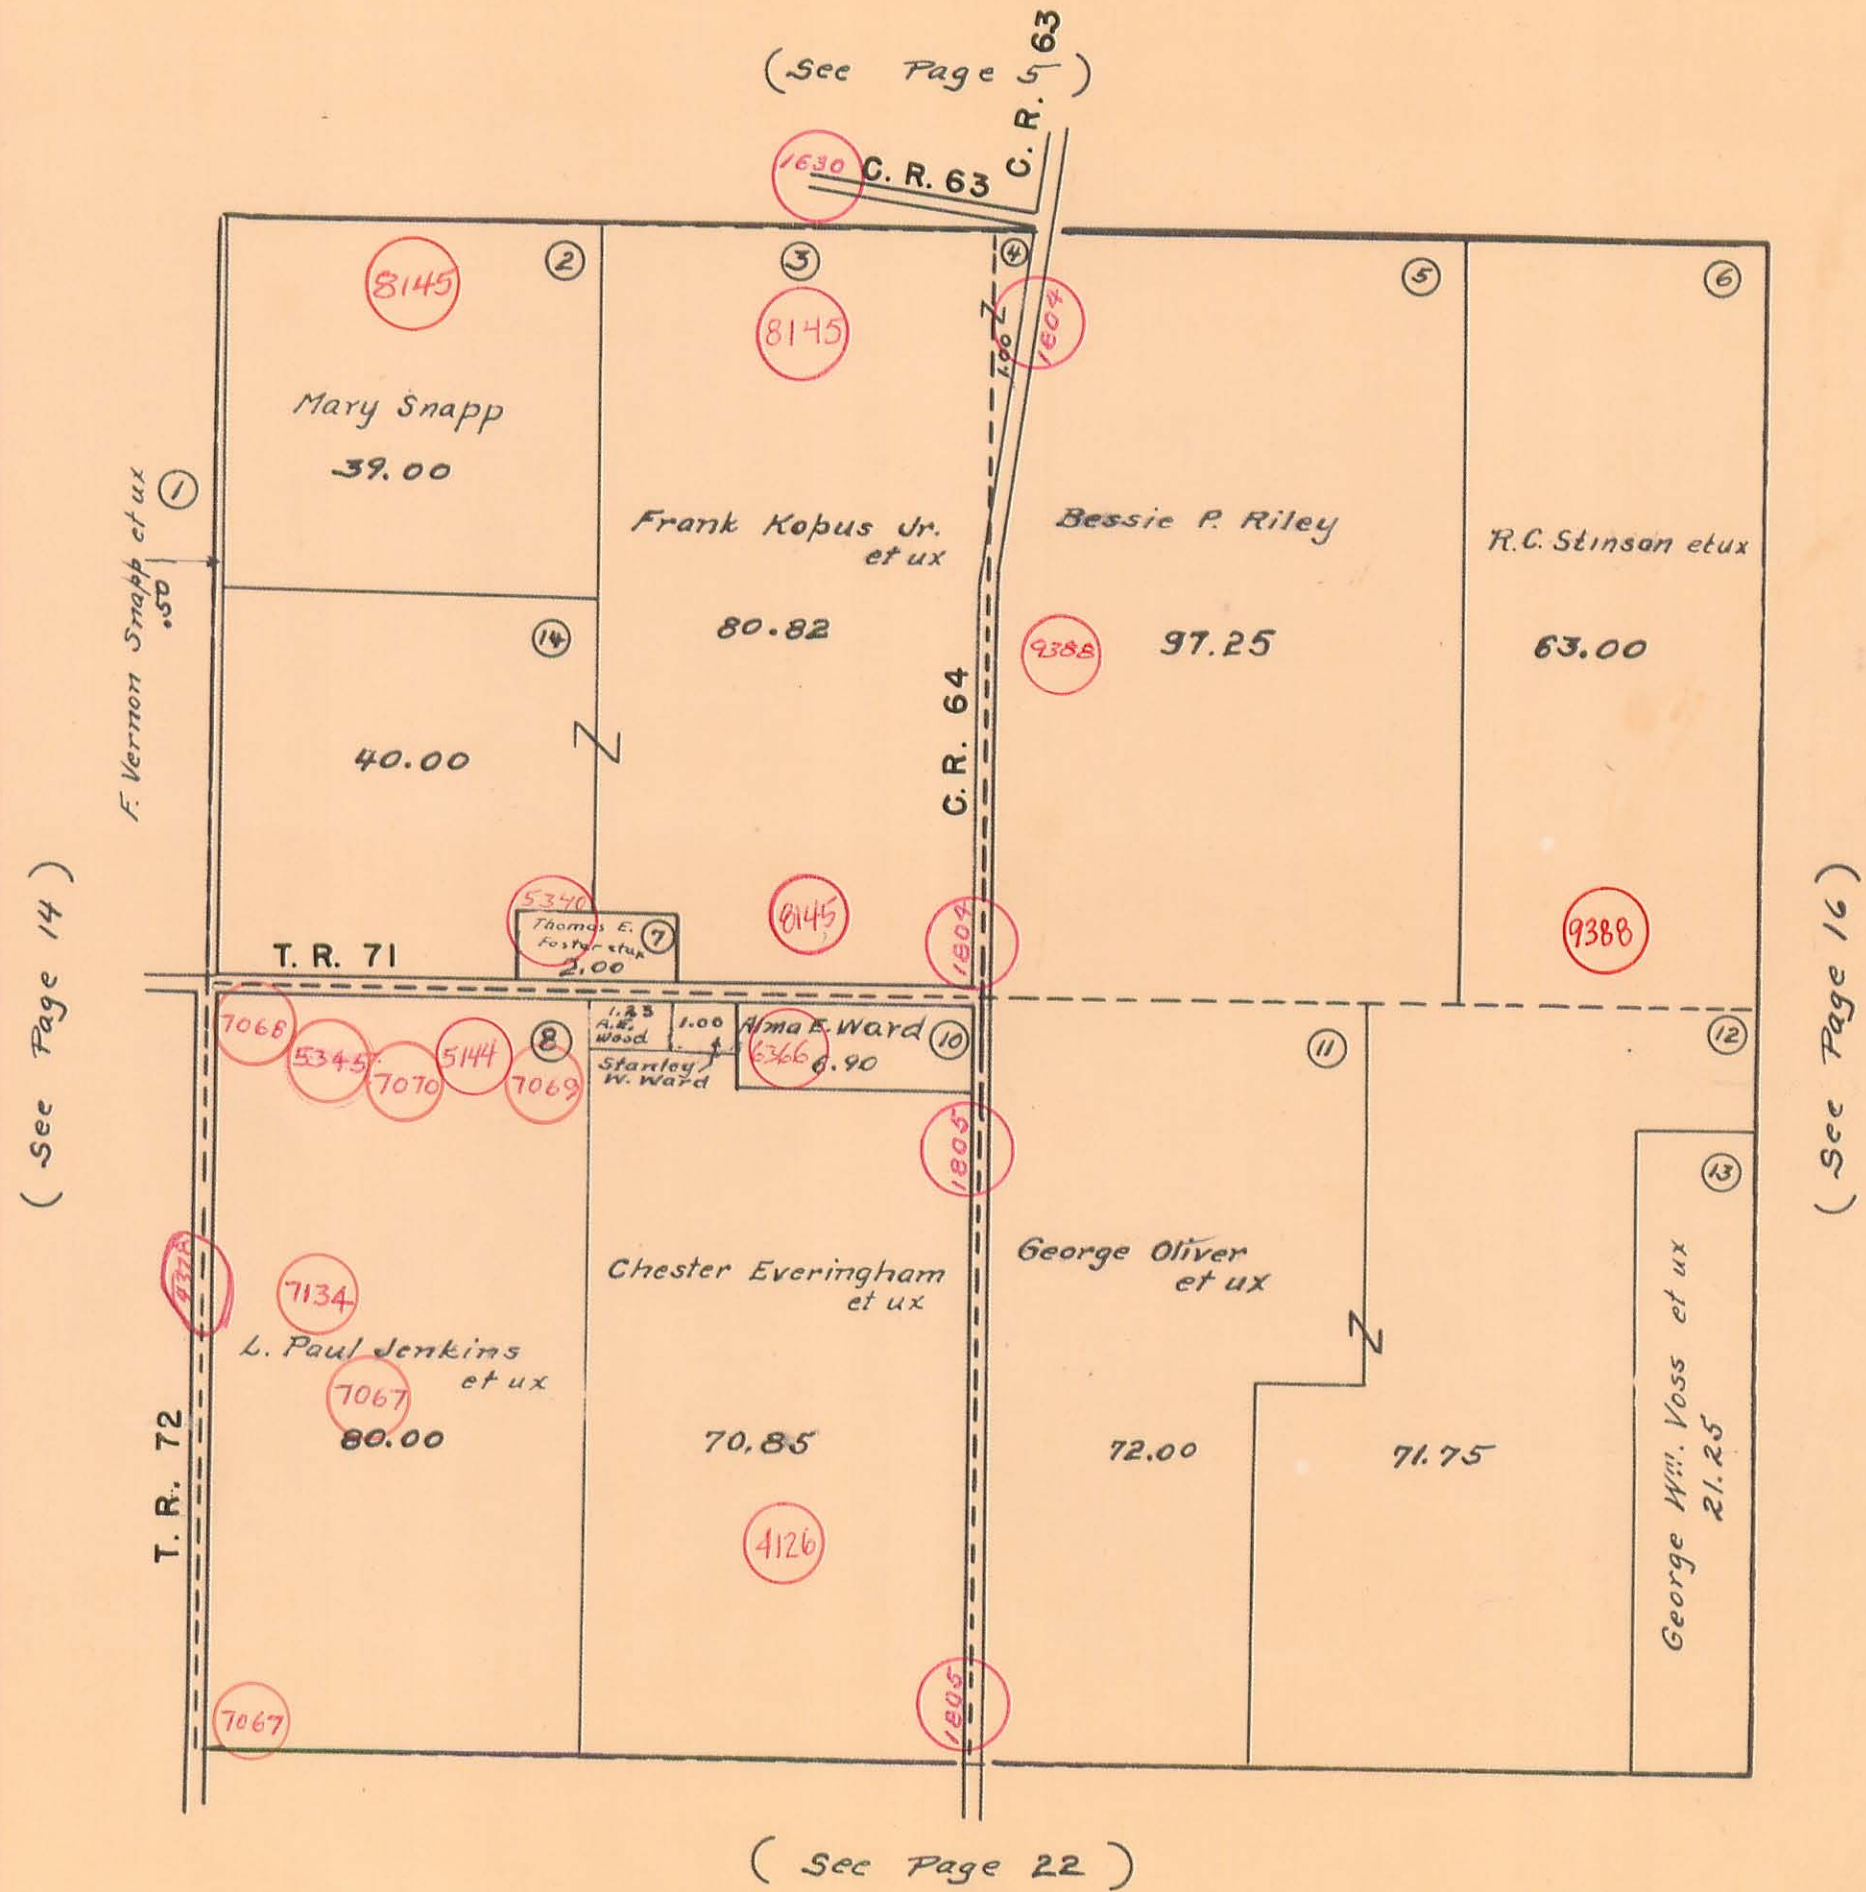

R.F.W.  
1932  
G.W.V.  
1932