


MIAMI TOWNSHIP
 DE GRAFF CORPORATION
 SEC. 7 T. 2 R. 14
 SCALE: 1" = 200'

3413

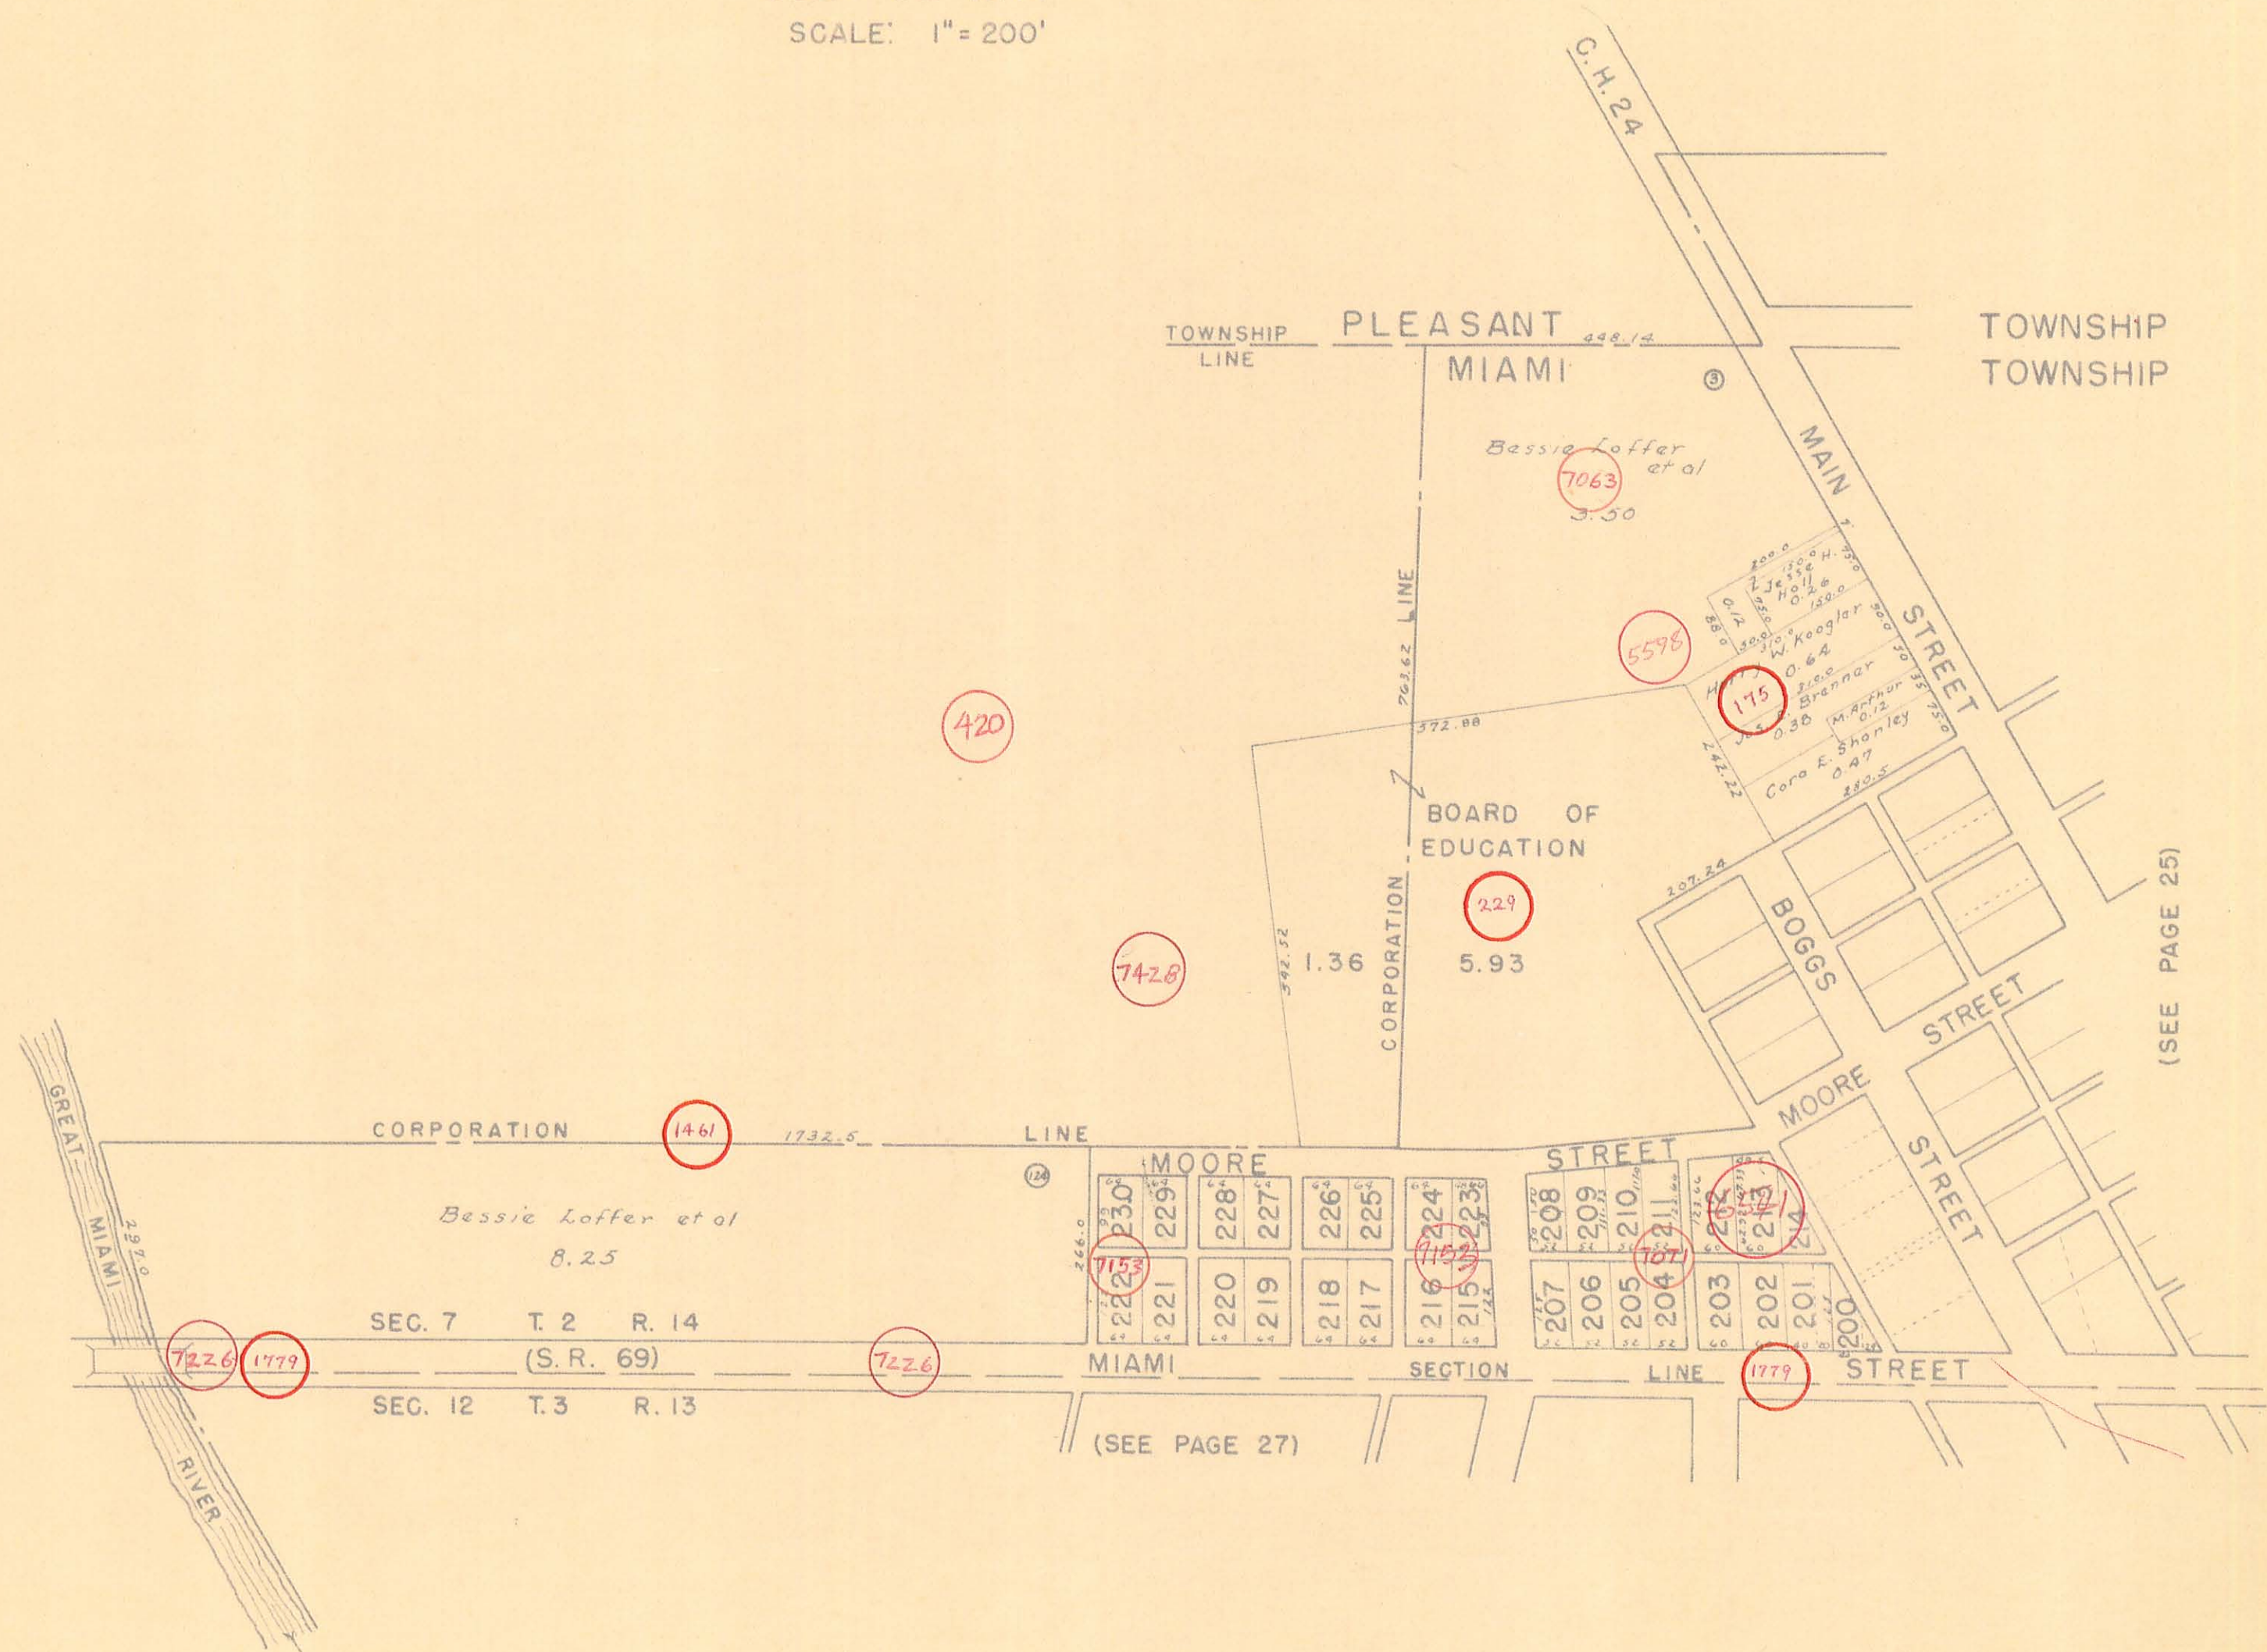

(SEE PAGE 25)

(SEE PAGE 27)

LOTS 200 TO 214 - LIPPINCOTTS ADDITION NO. 1
 LOTS 215 TO 230 - LIPPINCOTTS ADDITION NO. 2