

VIRGINIA MILITARY SURVEY 4810


SCALE 10 CHAINS TO THE INCH

See Page 19

See Page 10

See Page 23

See Page 22

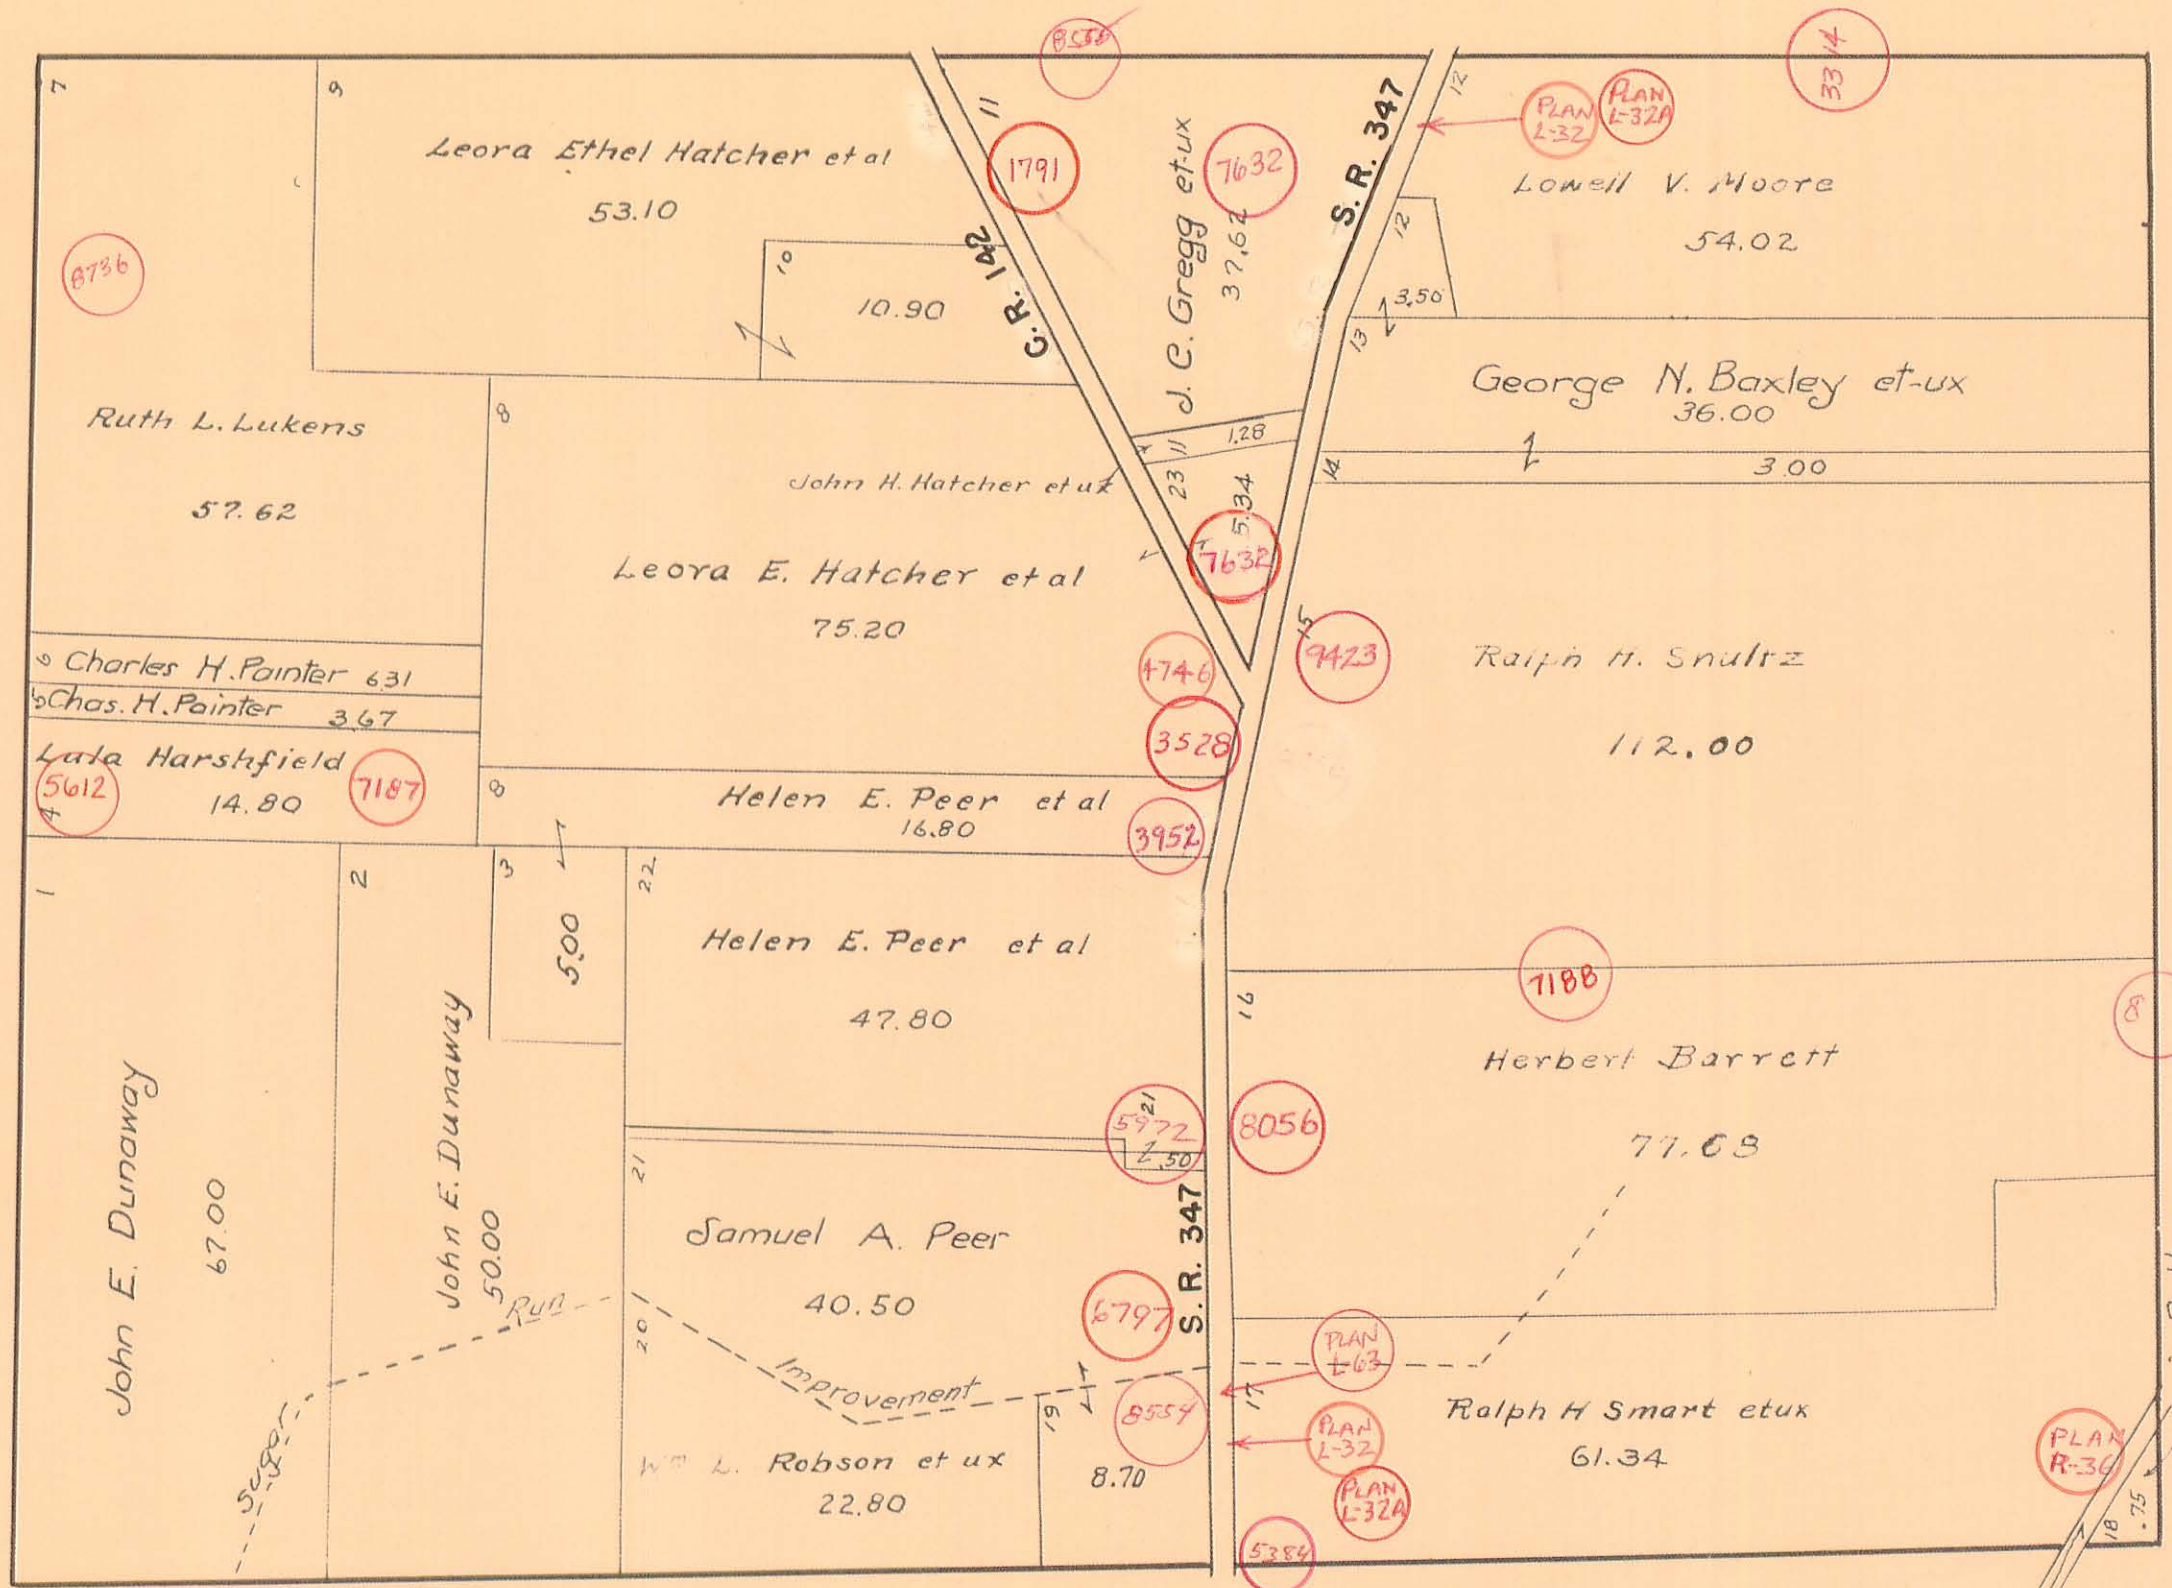

See Page 17

