


PLEASANT TOWNSHIP
SECTION 1 TOWN 2 RANGE 14
DE GRAFF CORPORATION

SCALE: 1 INCH = 200 FEET

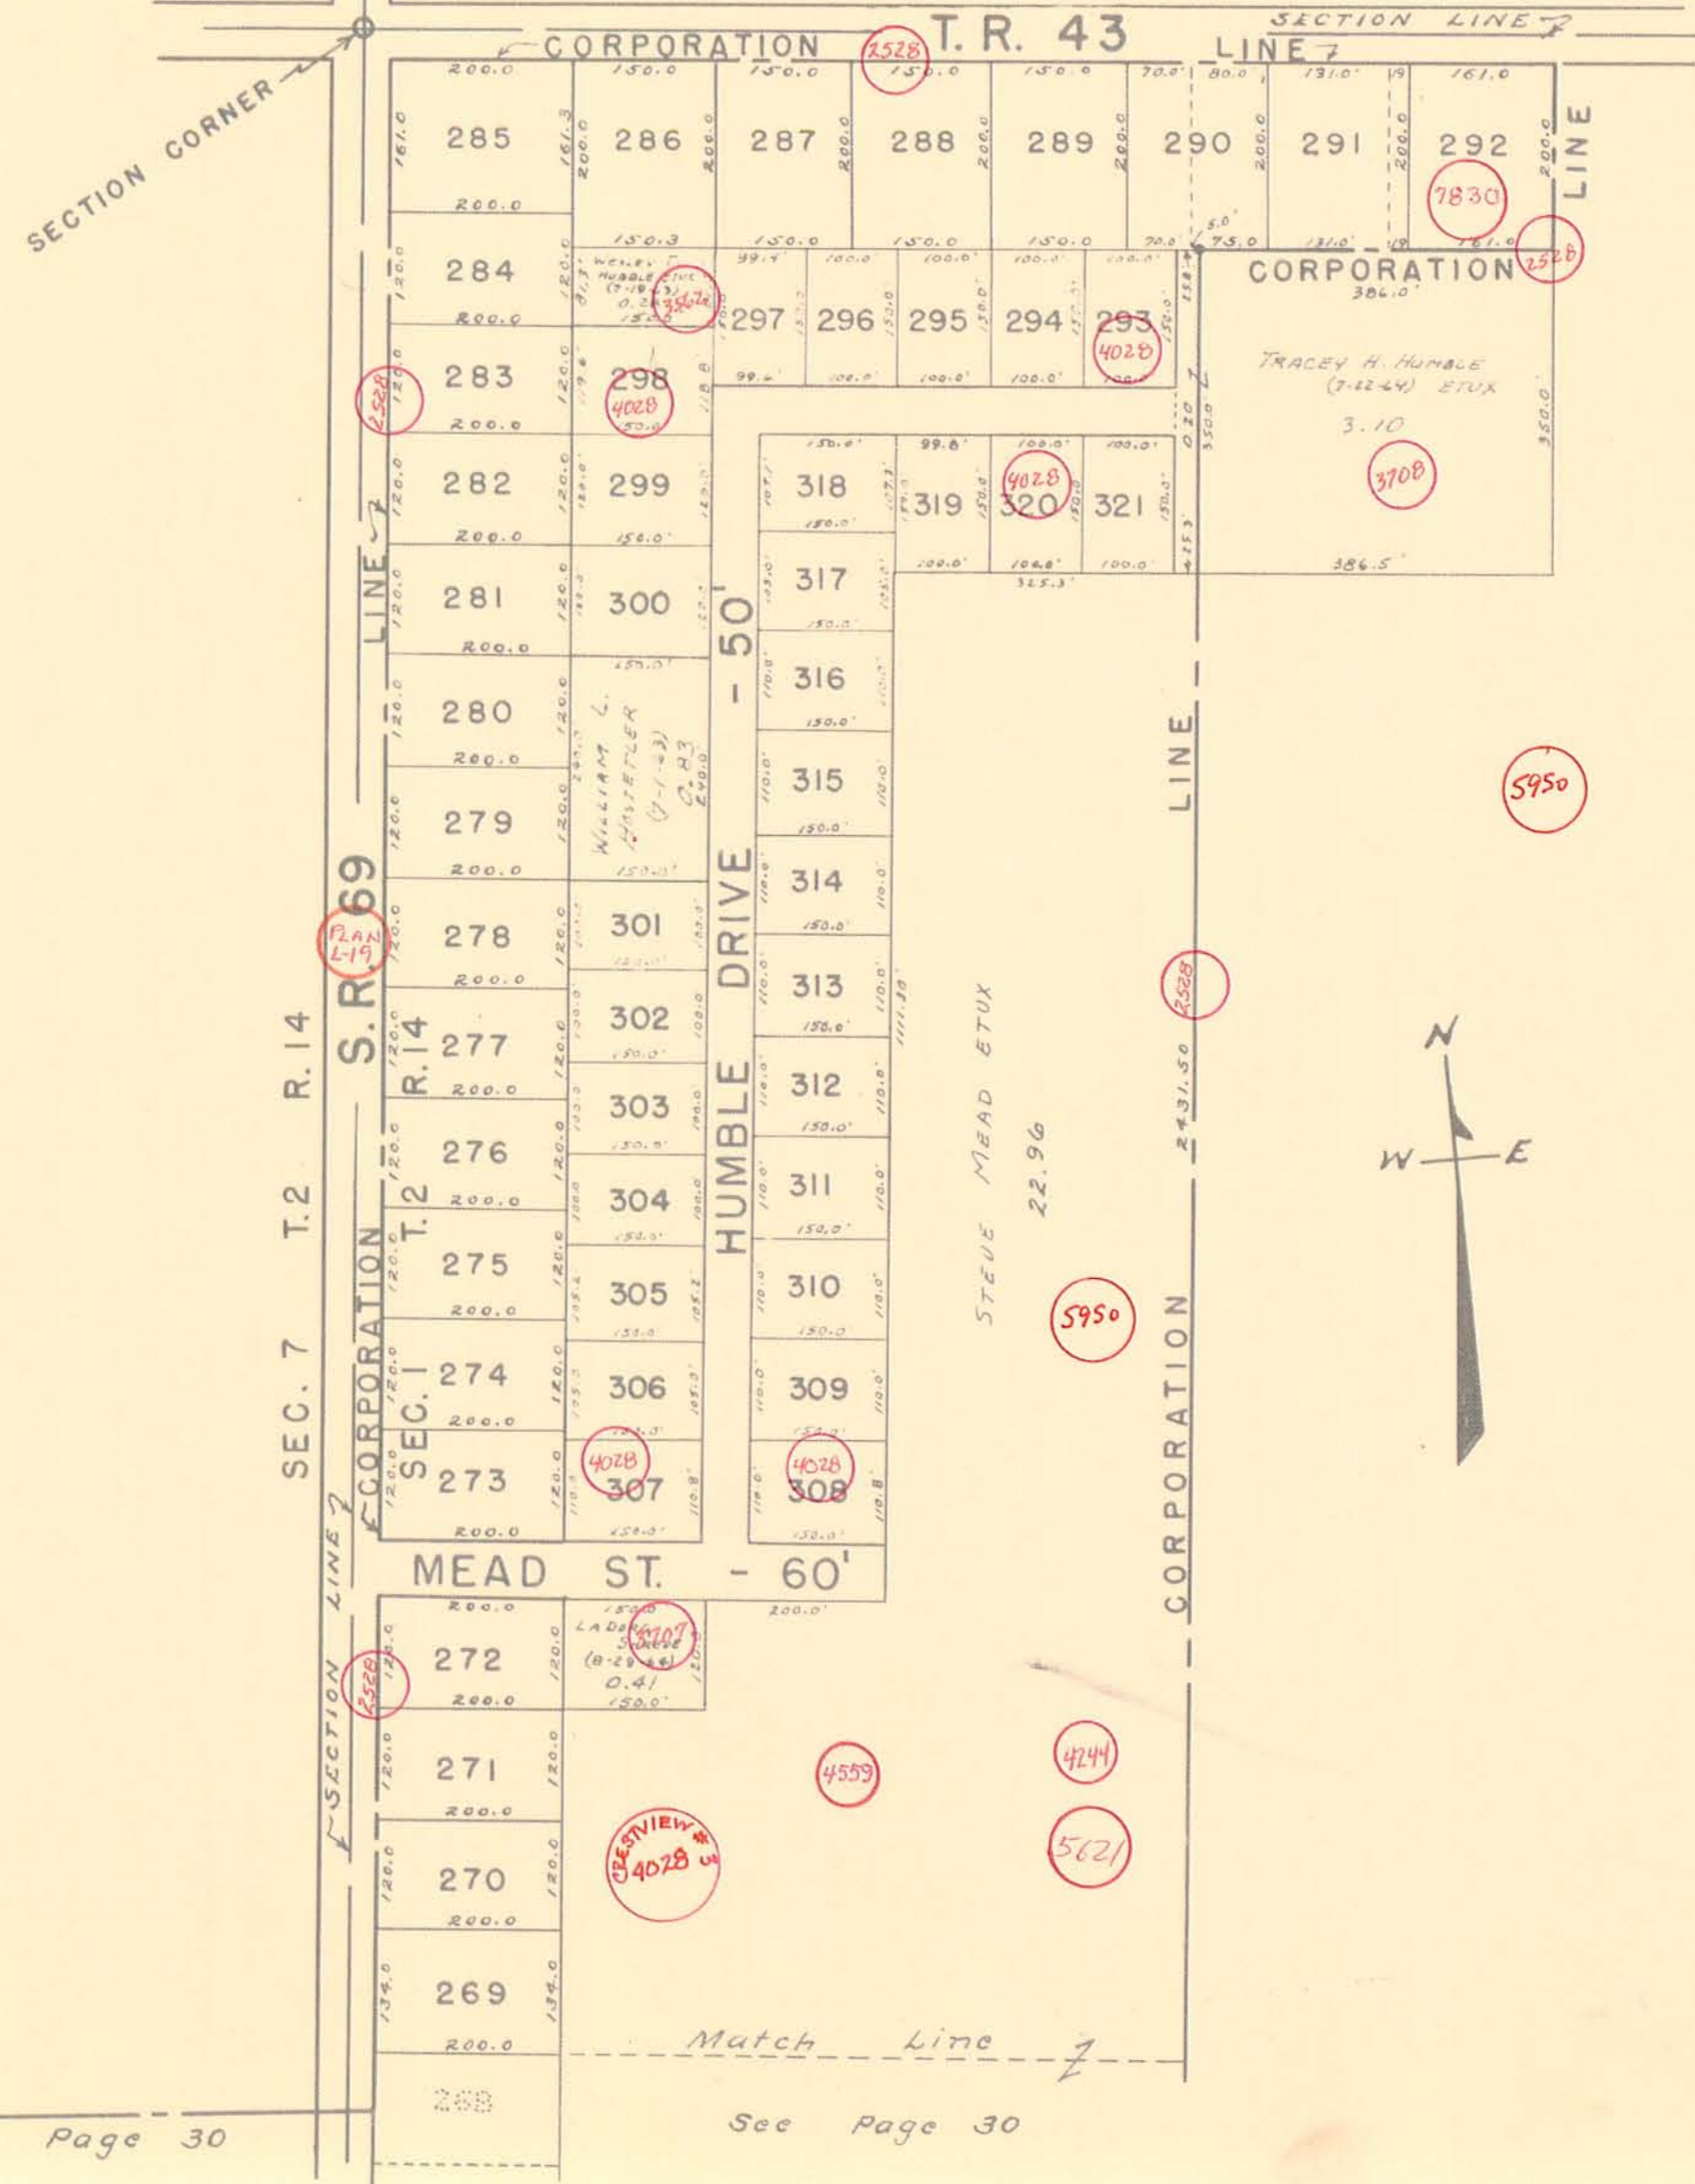

DRAWN, June 24, 1960

See Page 30

See Page 30