


SPORT POINT

SCALE 100 FEET TO THE INCH

INDIAN LAKE

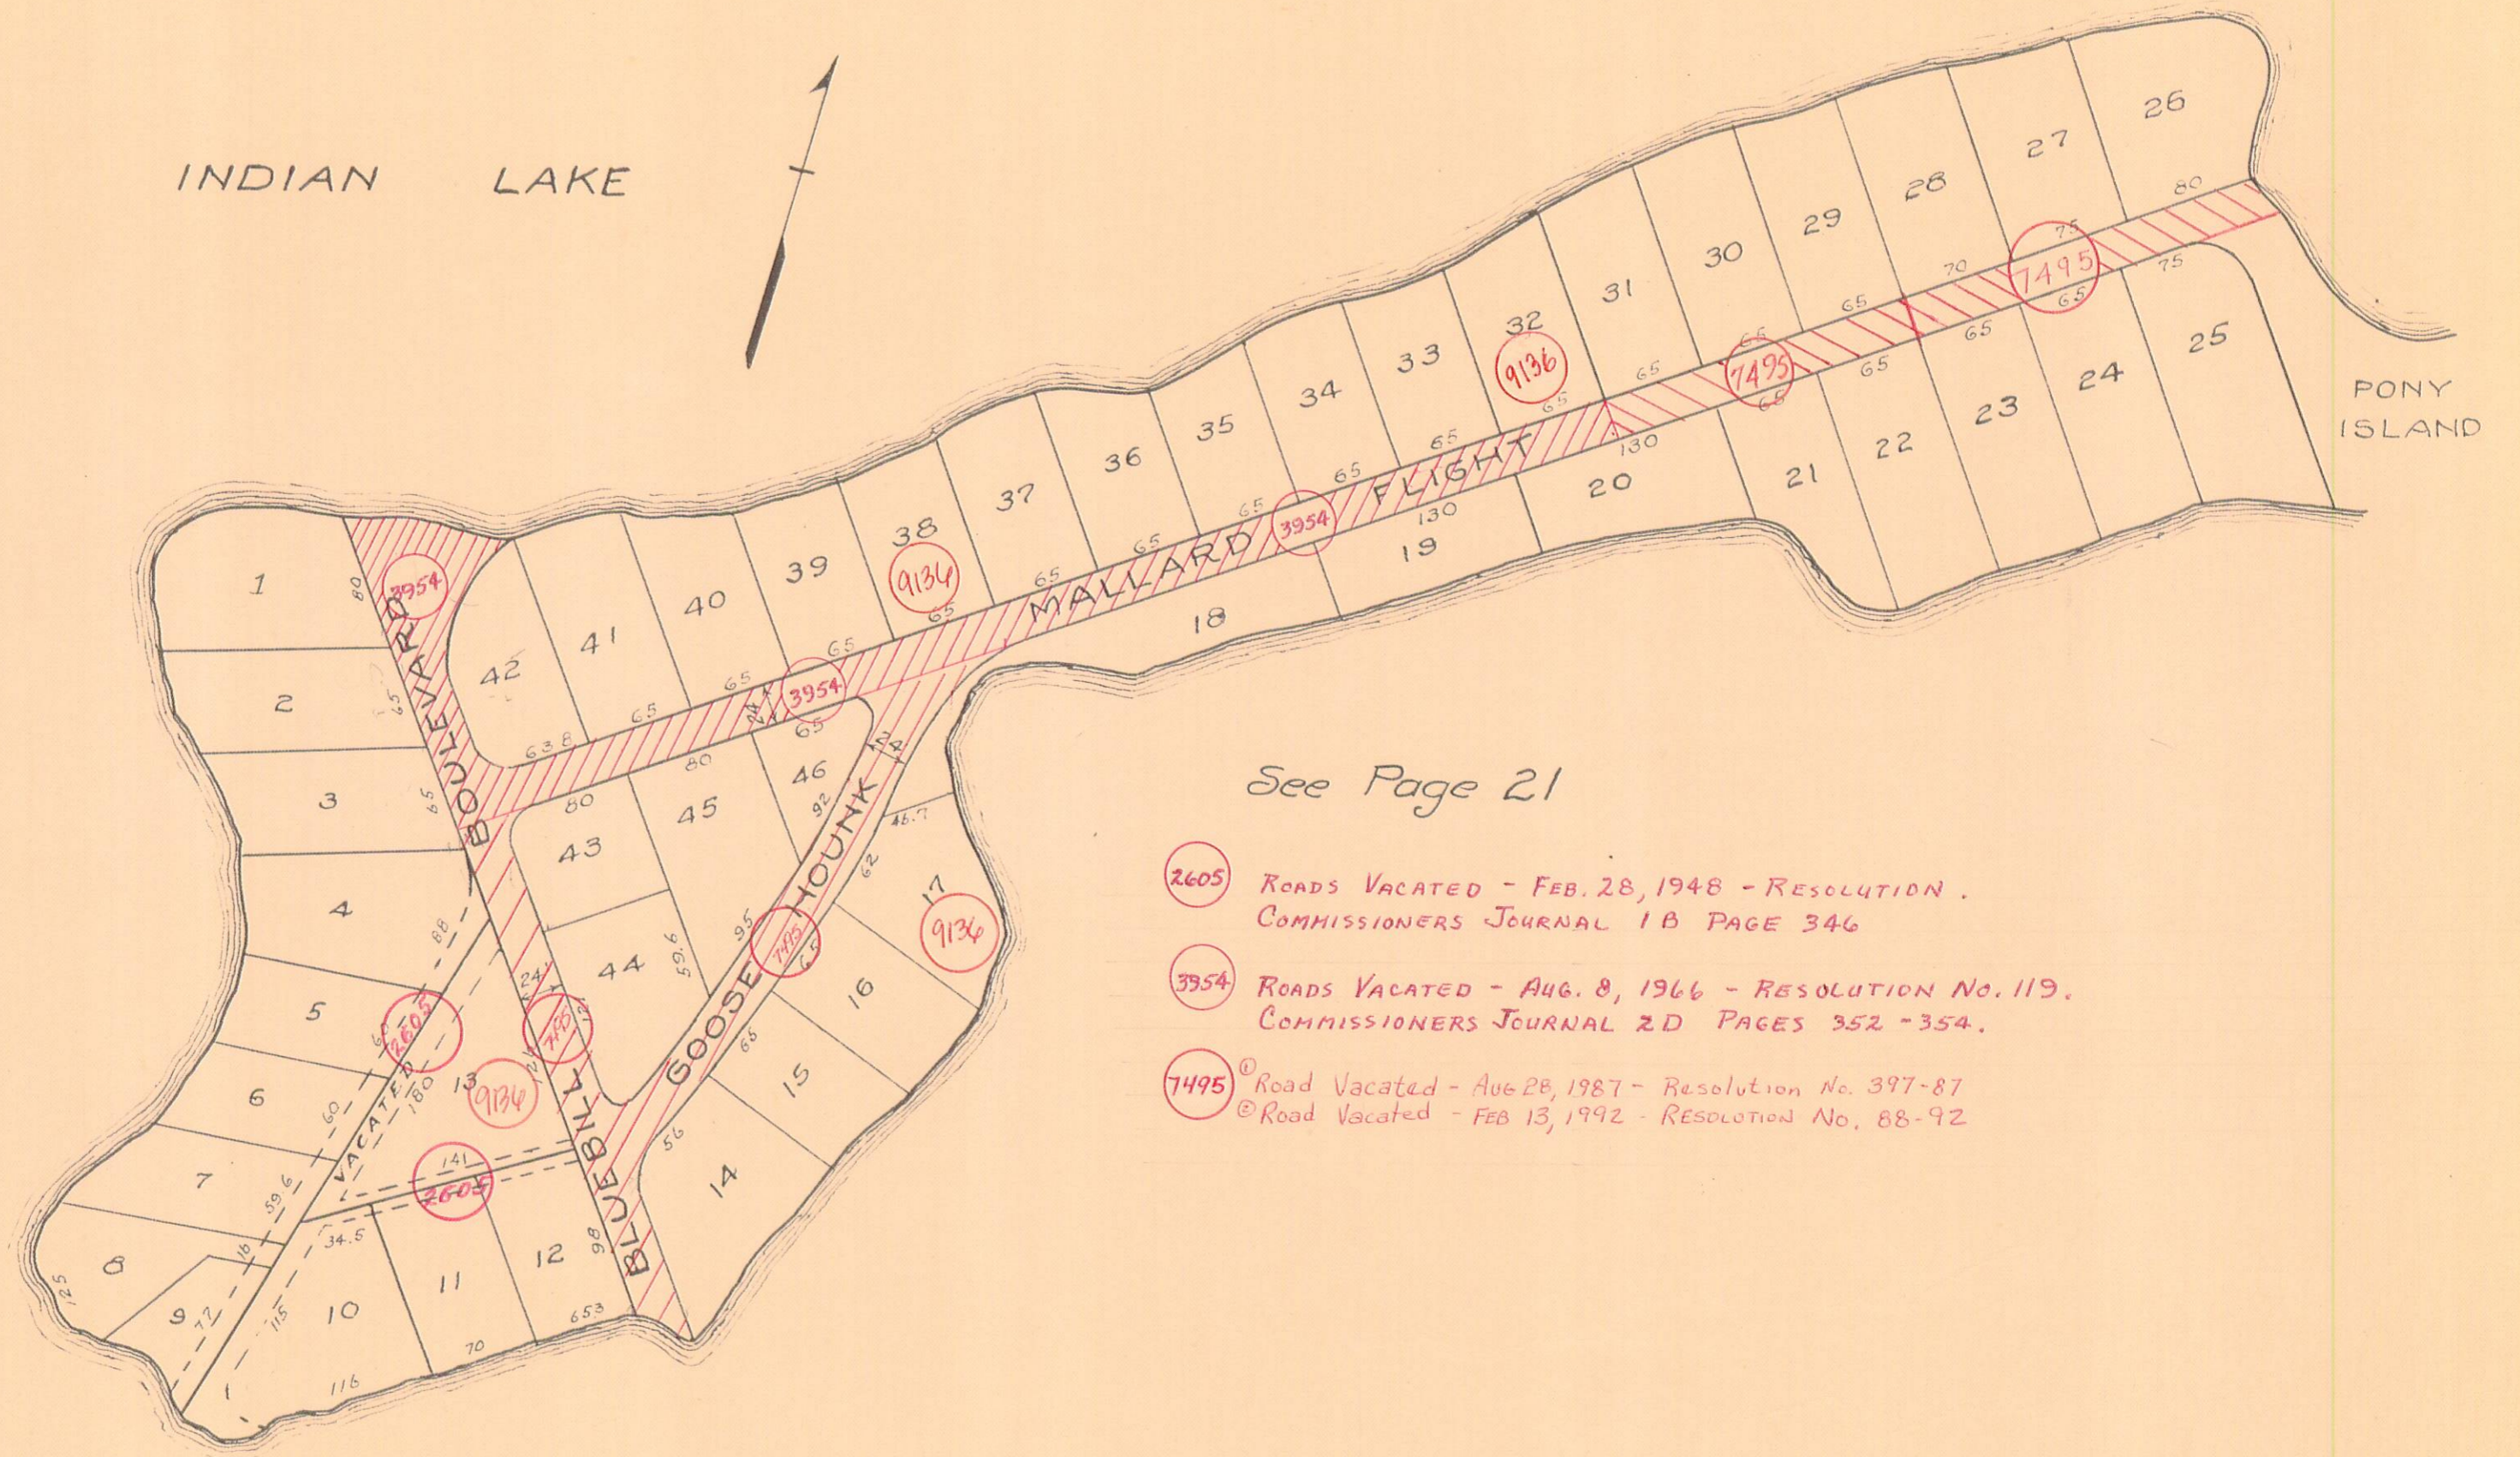

See Page 21

- 2605 Roads Vacated - FEB. 28, 1948 - RESOLUTION .
COMMISSIONERS JOURNAL 1 B PAGE 346
- 3954 Roads Vacated - AUG. 8, 1966 - RESOLUTION No. 119.
COMMISSIONERS JOURNAL 2 D PAGES 352 - 354.
- 7495 Road Vacated - AUG 28, 1987 - Resolution No. 397-87
Road Vacated - FEB 13, 1992 - RESOLUTION No. 88-92