


STOKES TOWNSHIP
 VIRGINIA MILITARY SURVEY 12276

SCALE 100 FEET TO THE INCH

TURKEY FOOT (PART)

INDIAN LAKE

INDIAN LAKE

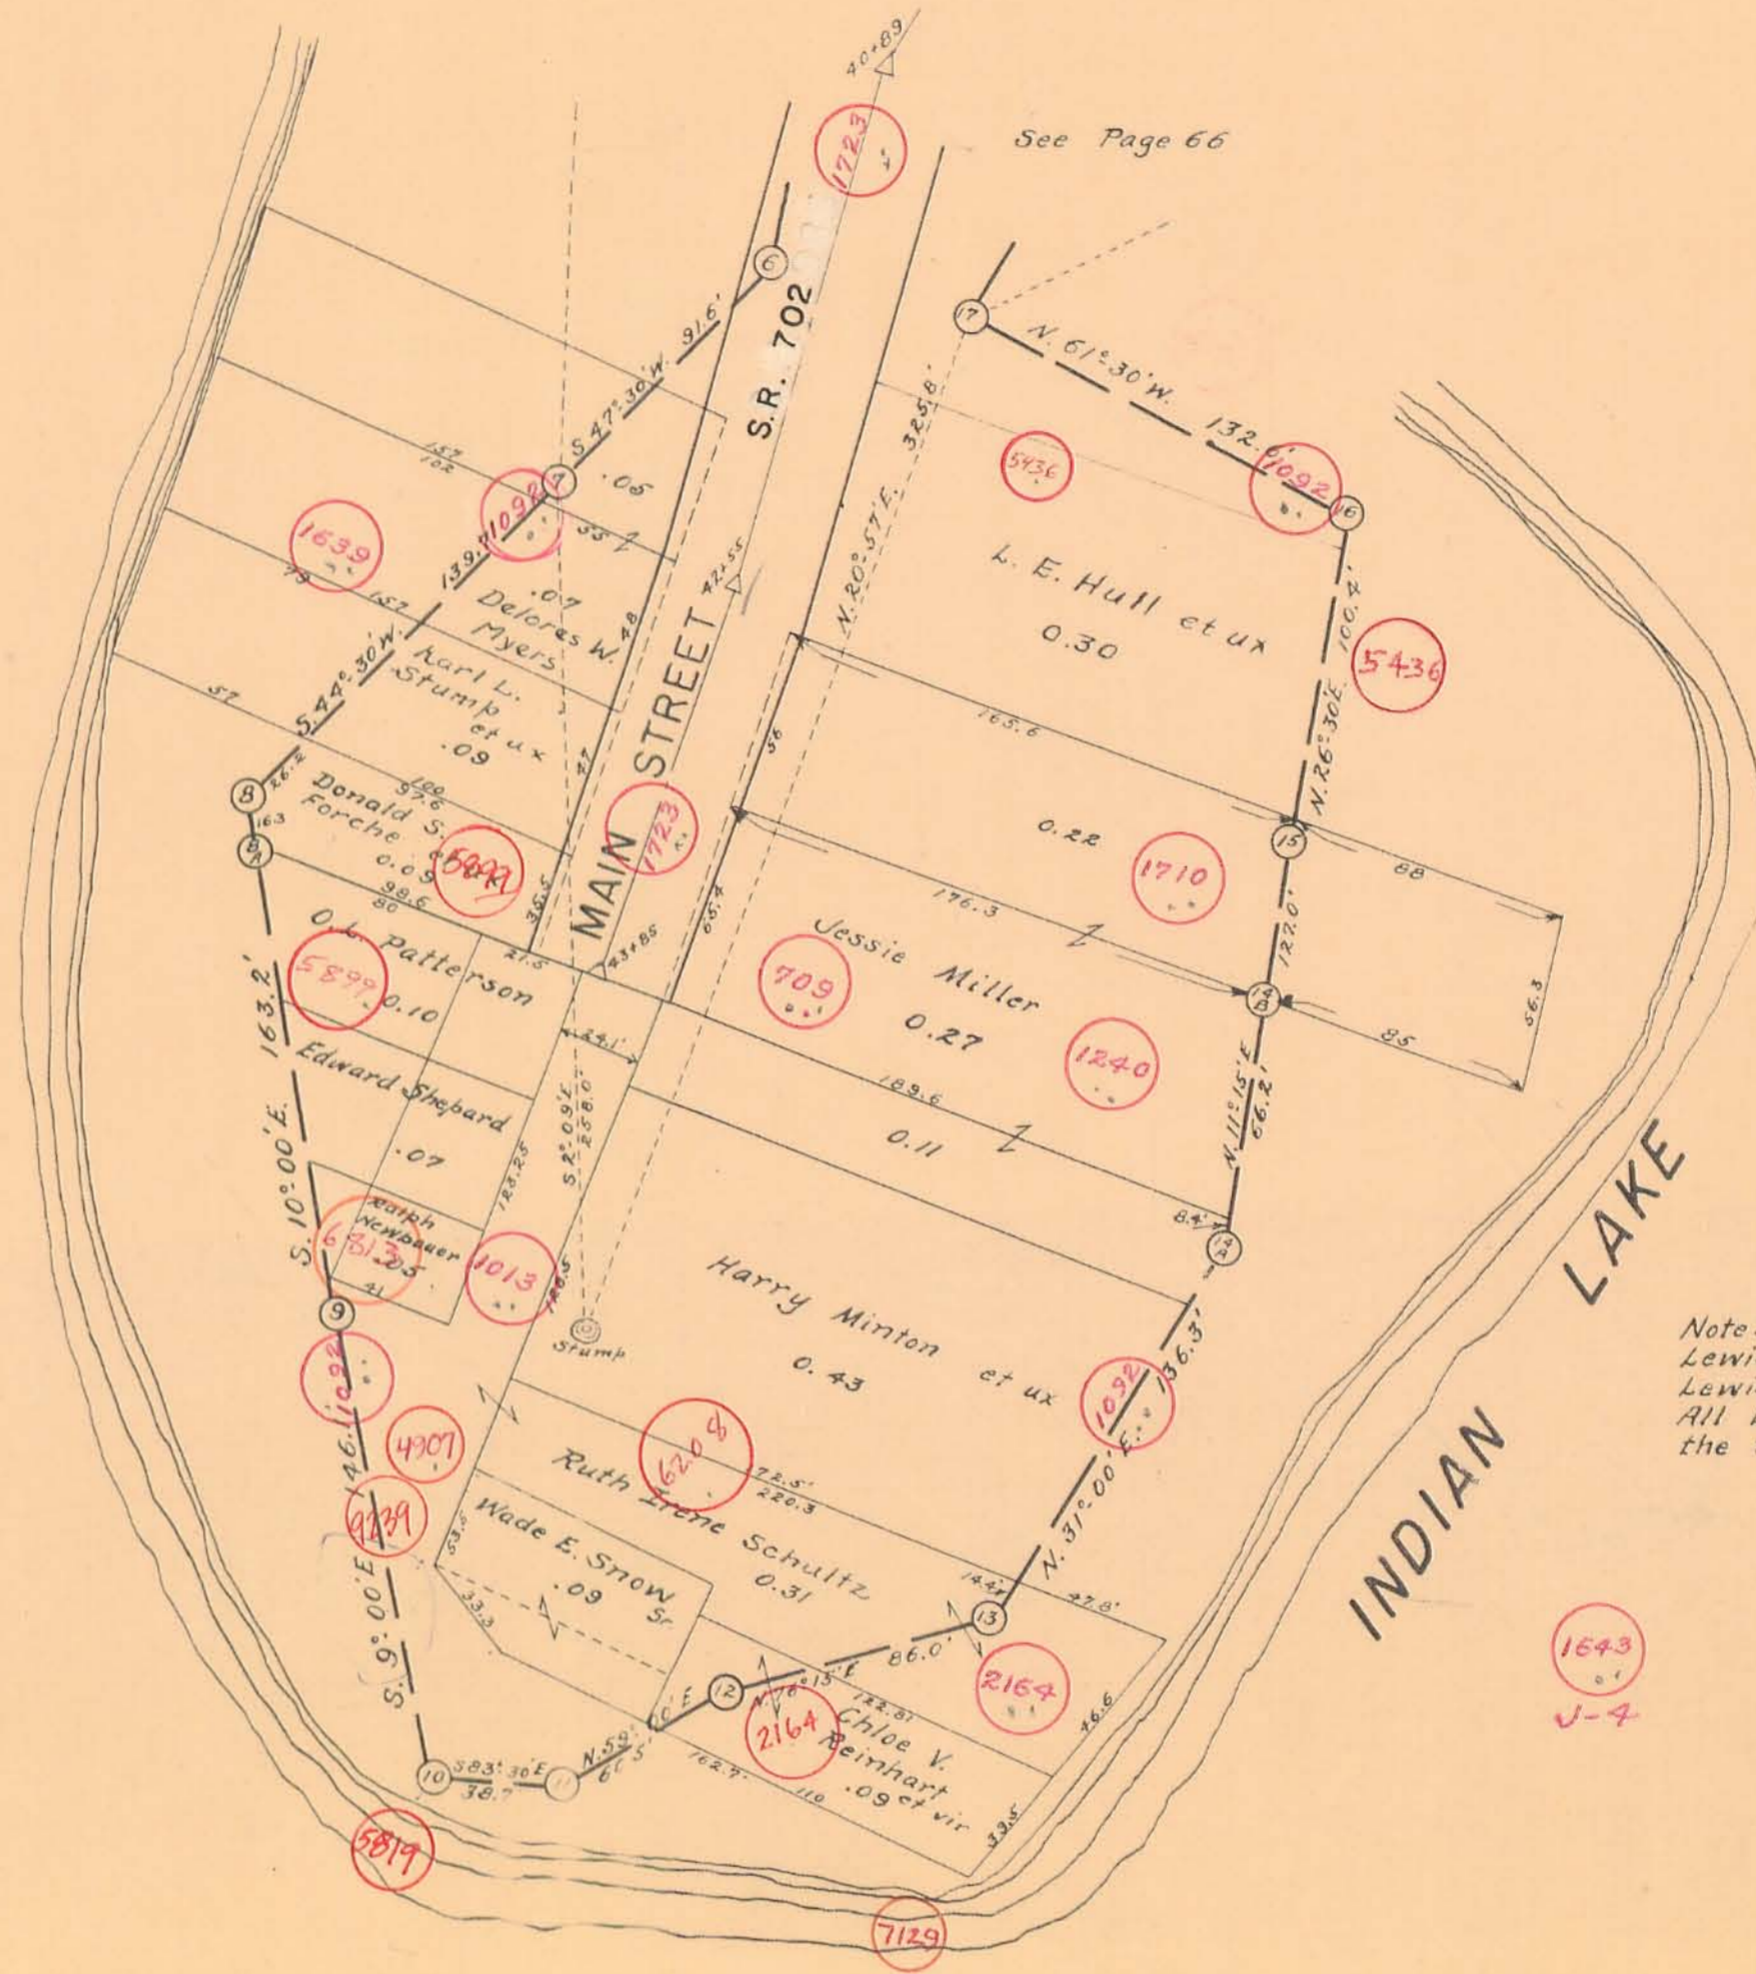

See Page 66

3183
 See Descr
 from Draw
 R.R.

Note: Auditors Duplicate Jan. 1st 1961
 Lewis E. Hull et al, V.M.S. 12276- C.A. 8.89
 Lewis E. Hull et al, V.M.S. 12277- A. 5.80
 All Land not otherwise shown is in
 the name of Lewis E. Hull et al.

1643
 J-4