


STOKES TOWNSHIP  
SECTION 34 TOWN 6 S. RANGE 8 E.

SCALE 100 FEET TO THE INCH

LAKEVIEW (PART)

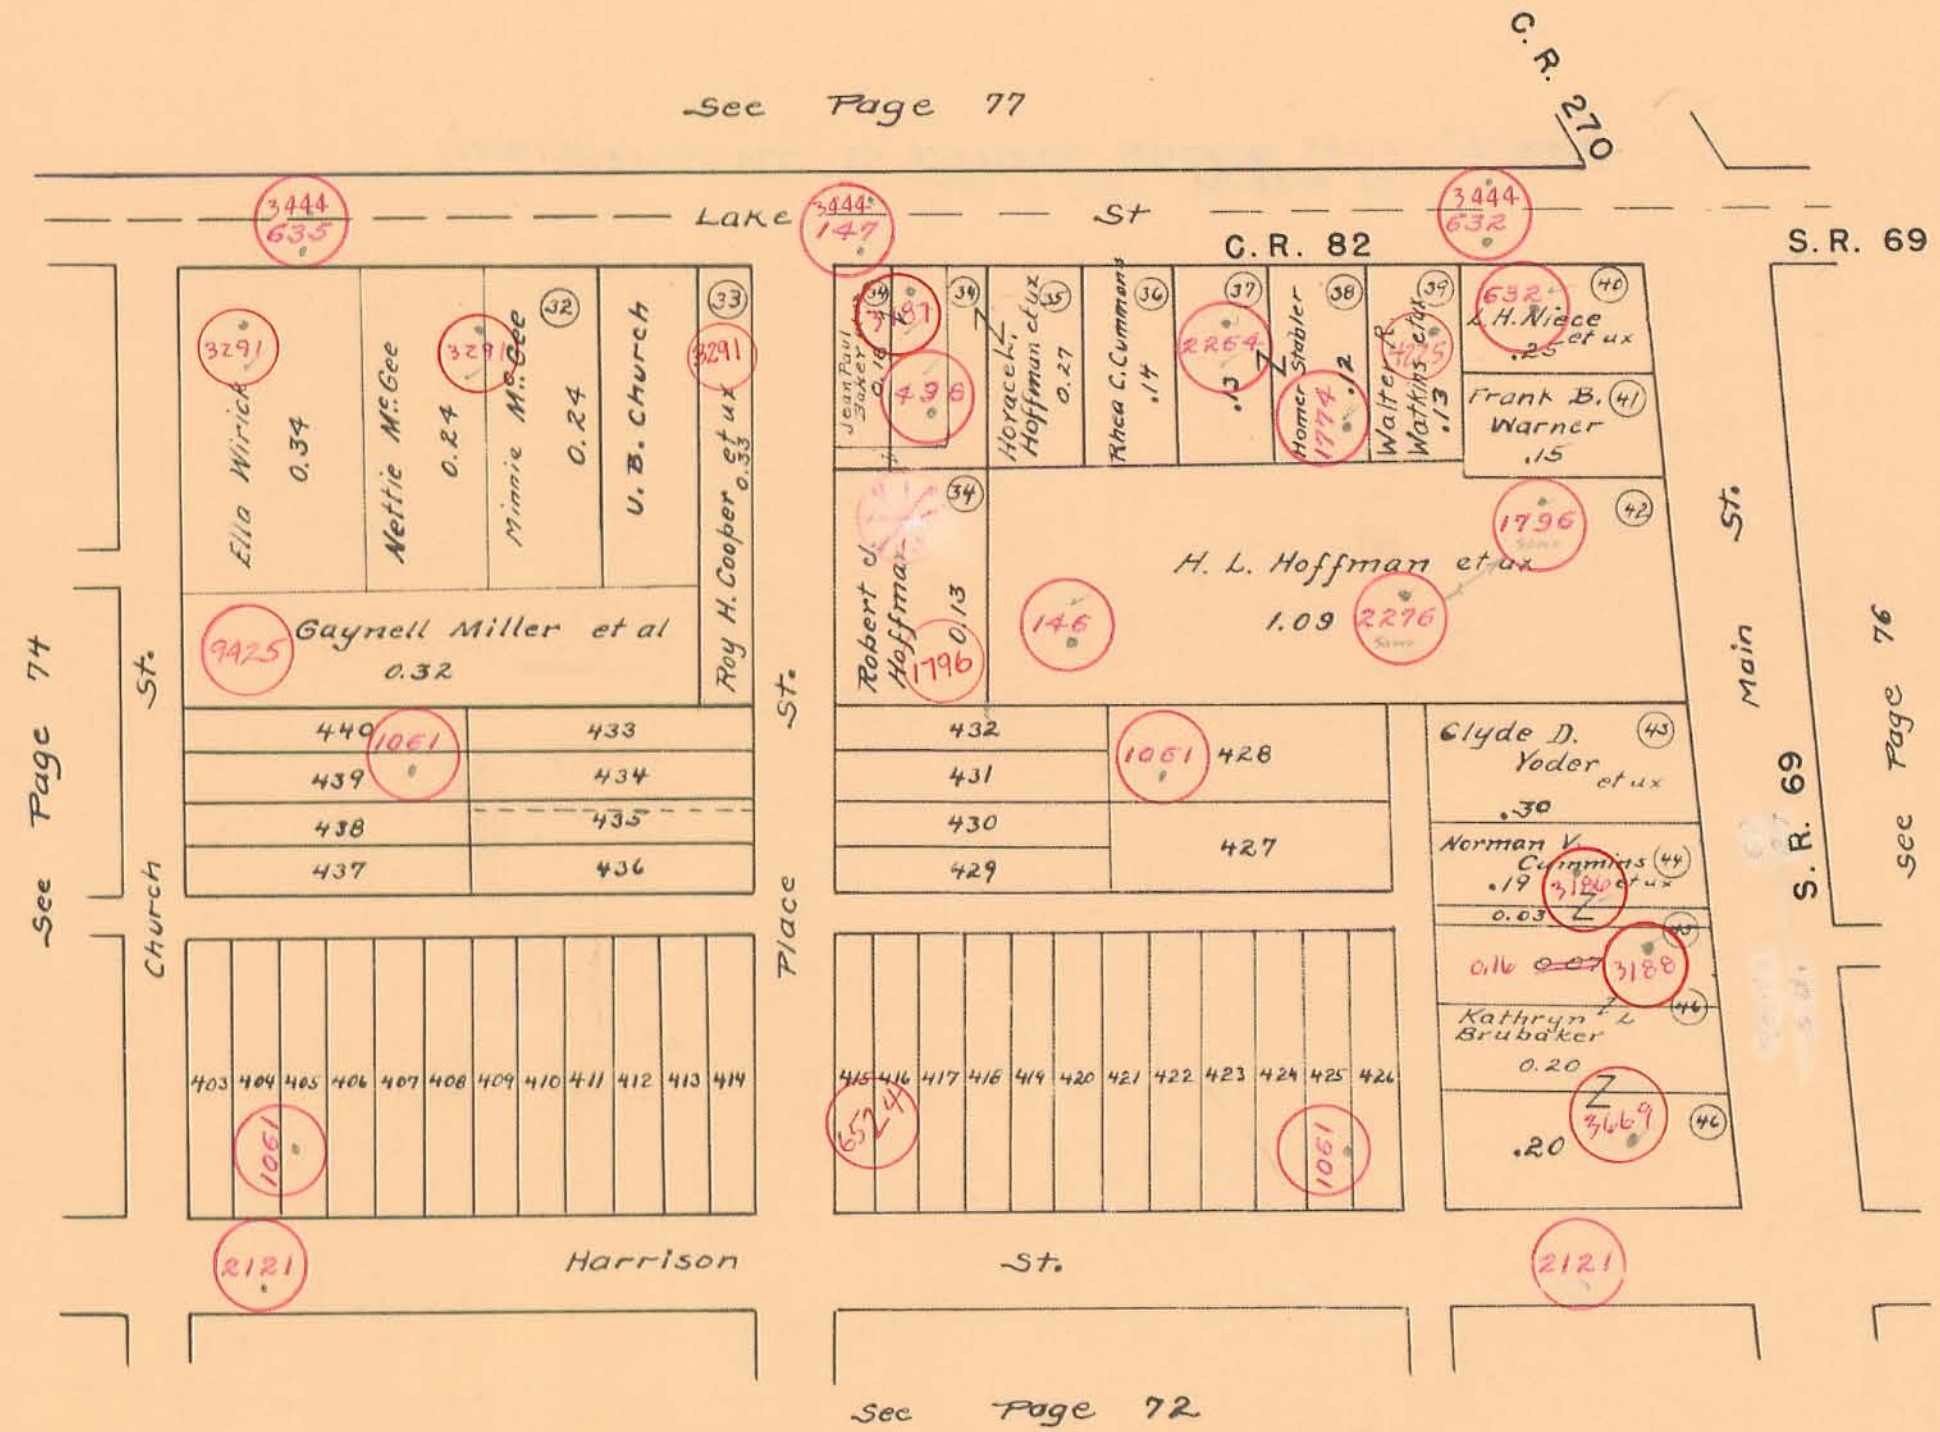

LOTS 403 TO 440 SANDERS