


WASHINGTON TOWNSHIP  
RUSSELLS POINT CORPORATION

64C

SEC. 1 T. 7S R. 8E

SCALE: 1"=100'  
PAGE

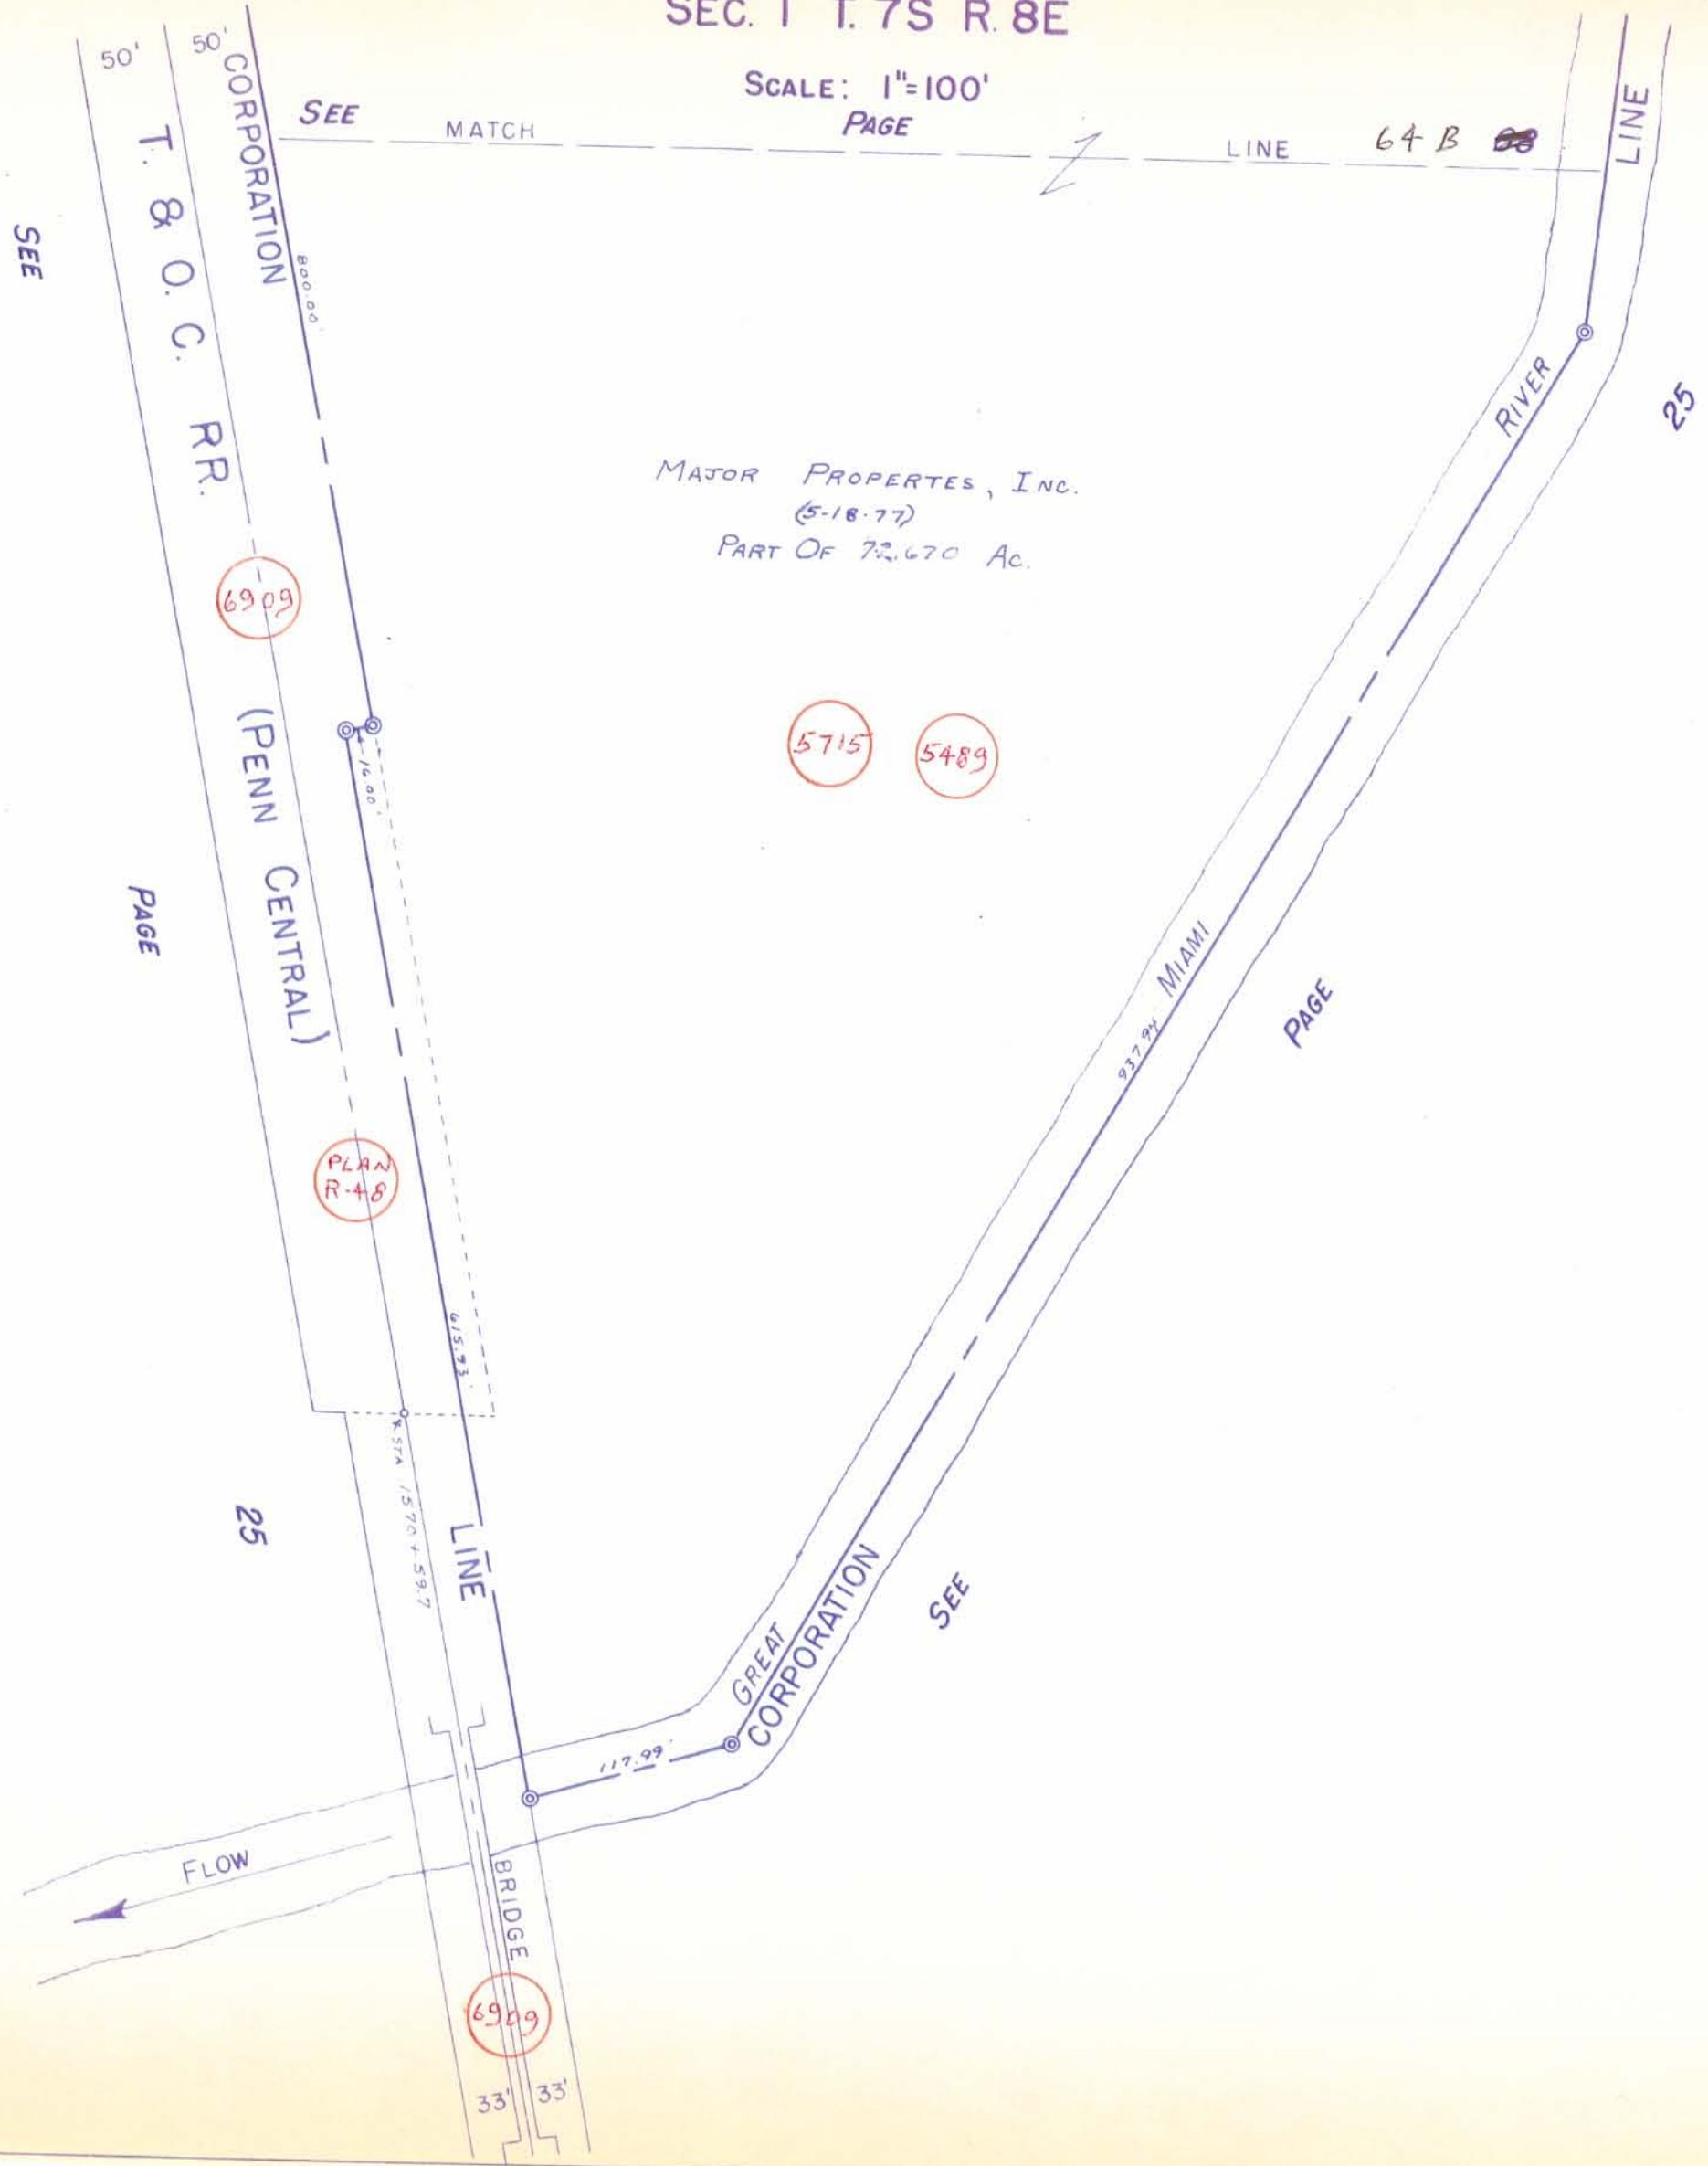

MAJOR PROPERTIES, INC.  
(5-18-77)  
PART OF 72,670 AC.