
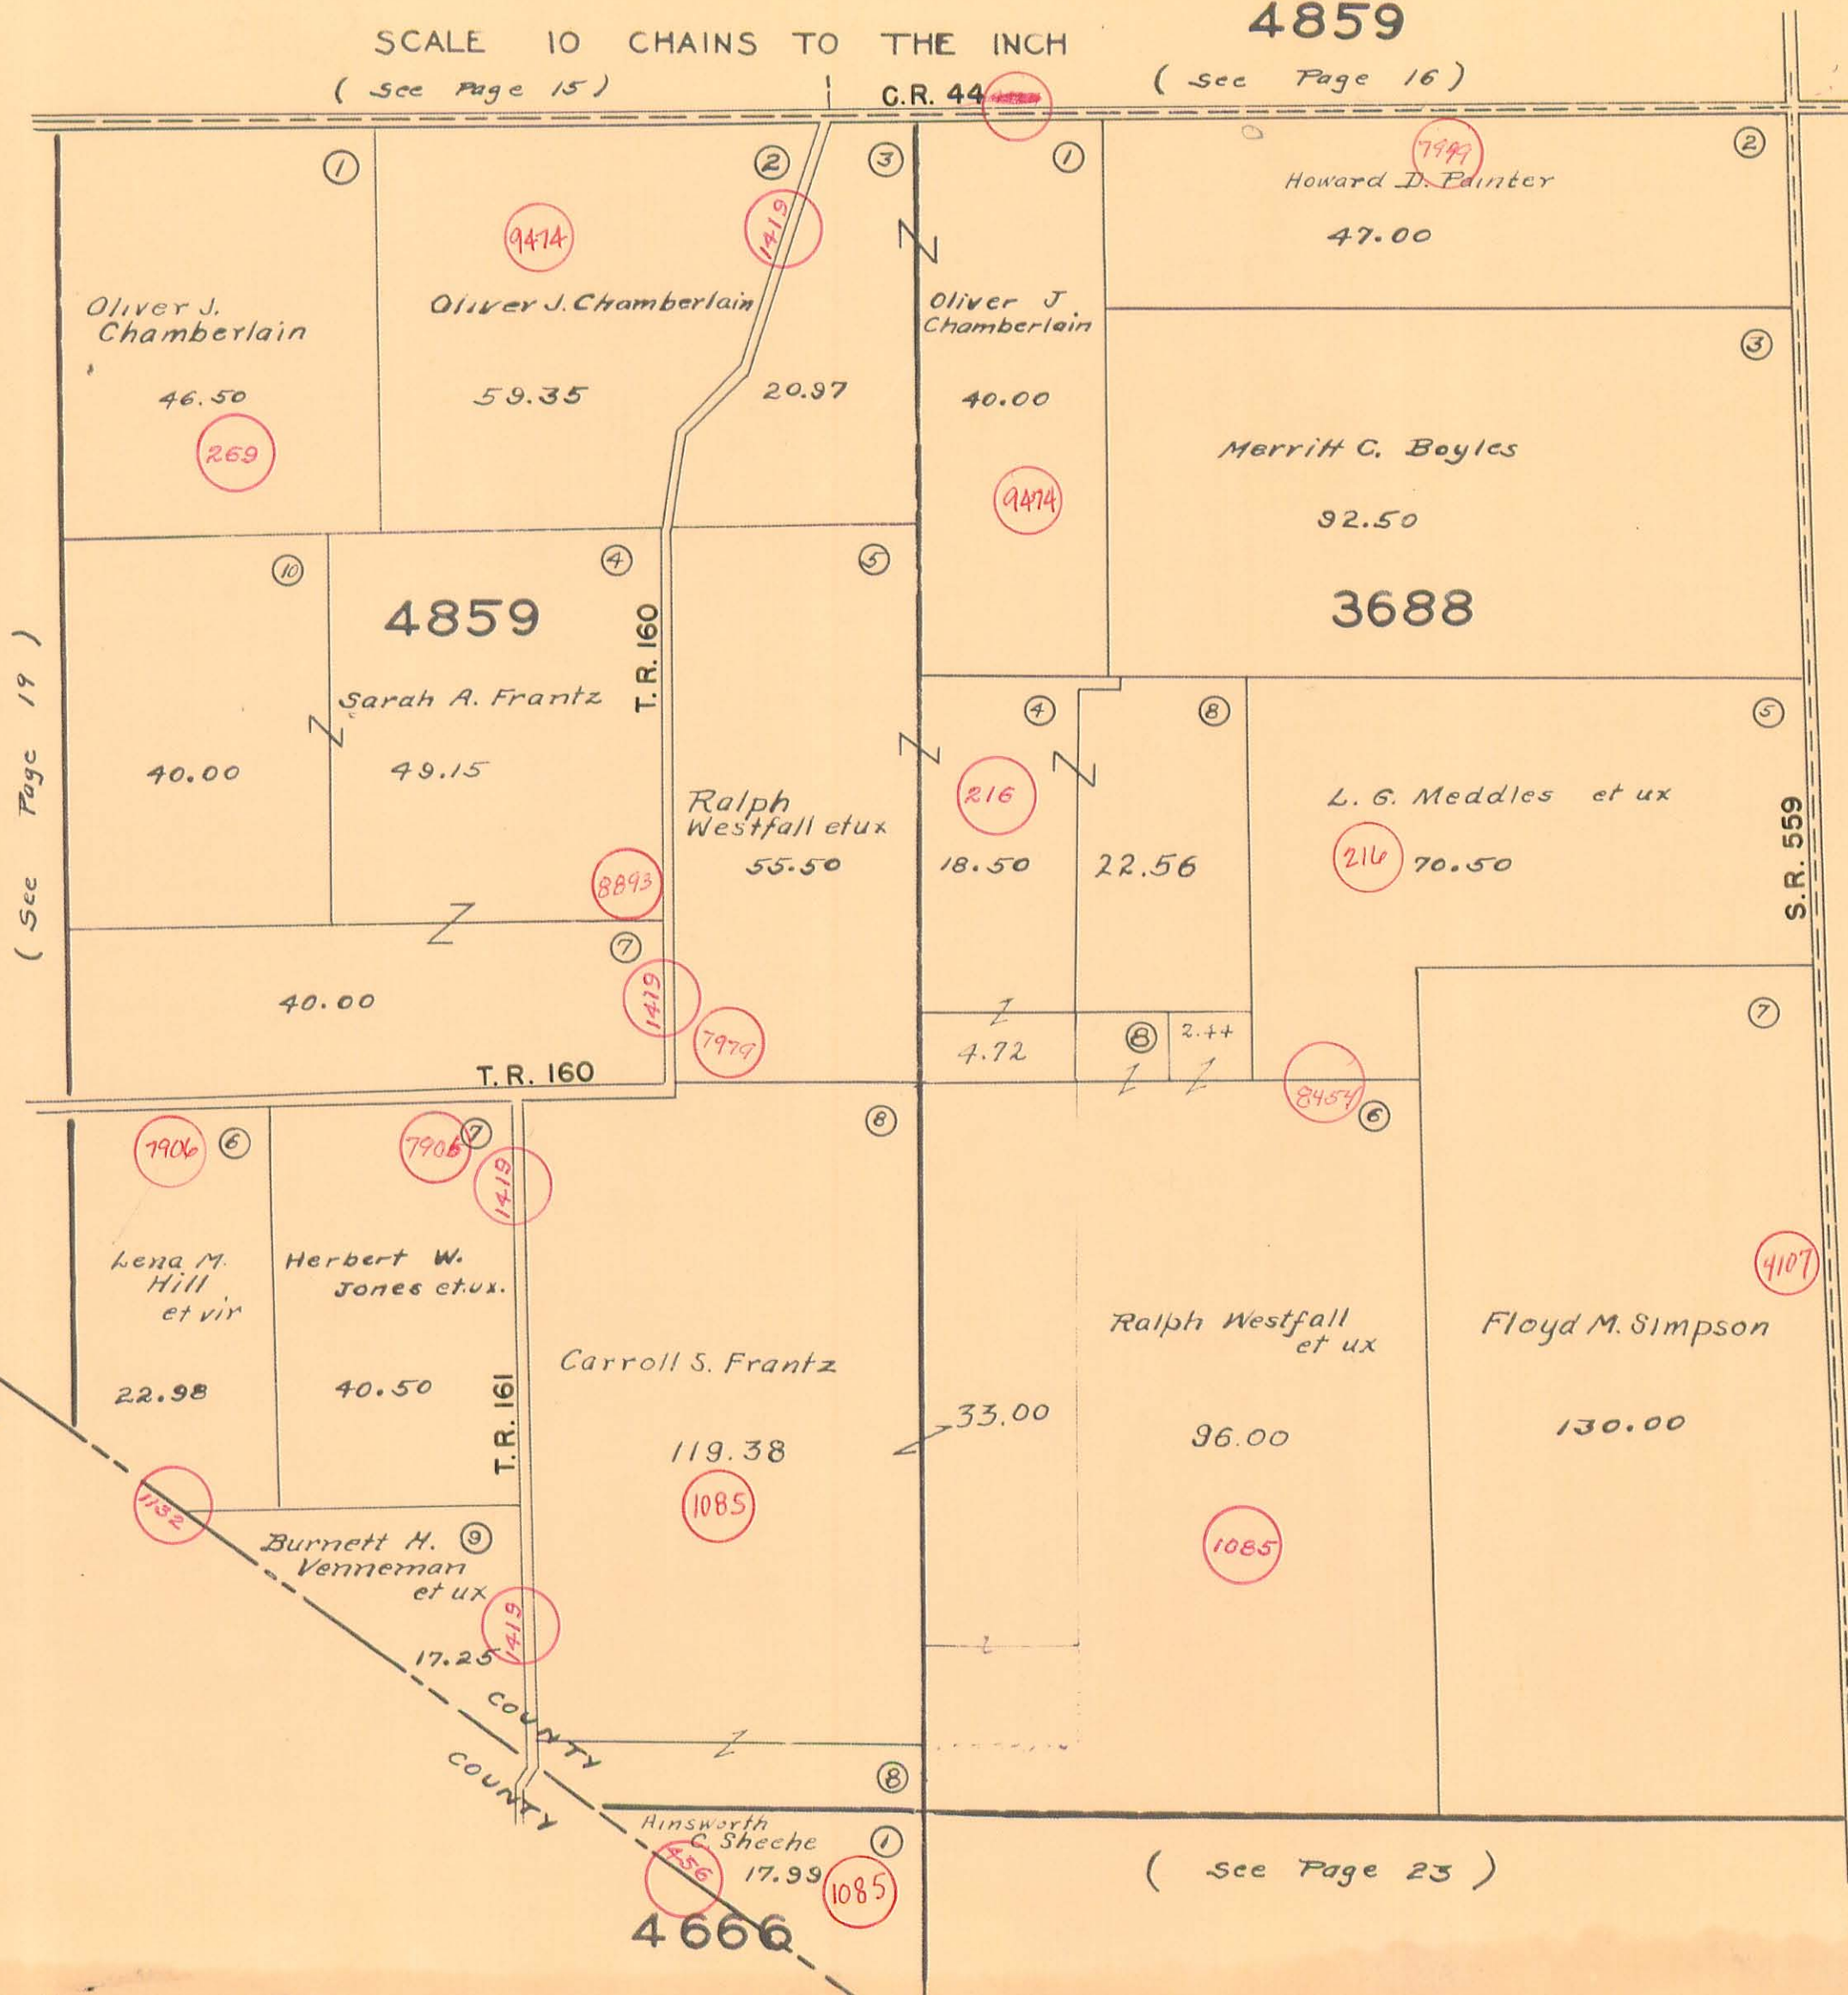


ZANE TOWNSHIP  
VIRGINIA MILITARY SURVEYS

3688  
4666  
4859

SCALE 10 CHAINS TO THE INCH  
( See Page 15 )

C.R. 44 ( See Page 16 )

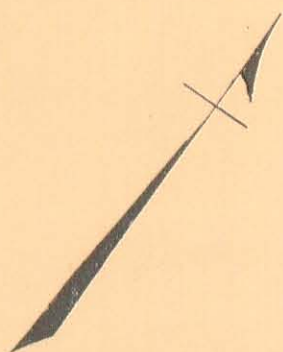

( See Page 19 )

( See Page 21 )

( See Page 23 )

4666