


Field Notes in Logan County Surveyors Book 567

1932



1365

INDEXED ON MAP X-18

Note:-  
 No survey was made of  
 road 216. However it apparently  
 is right in Harrison Township.

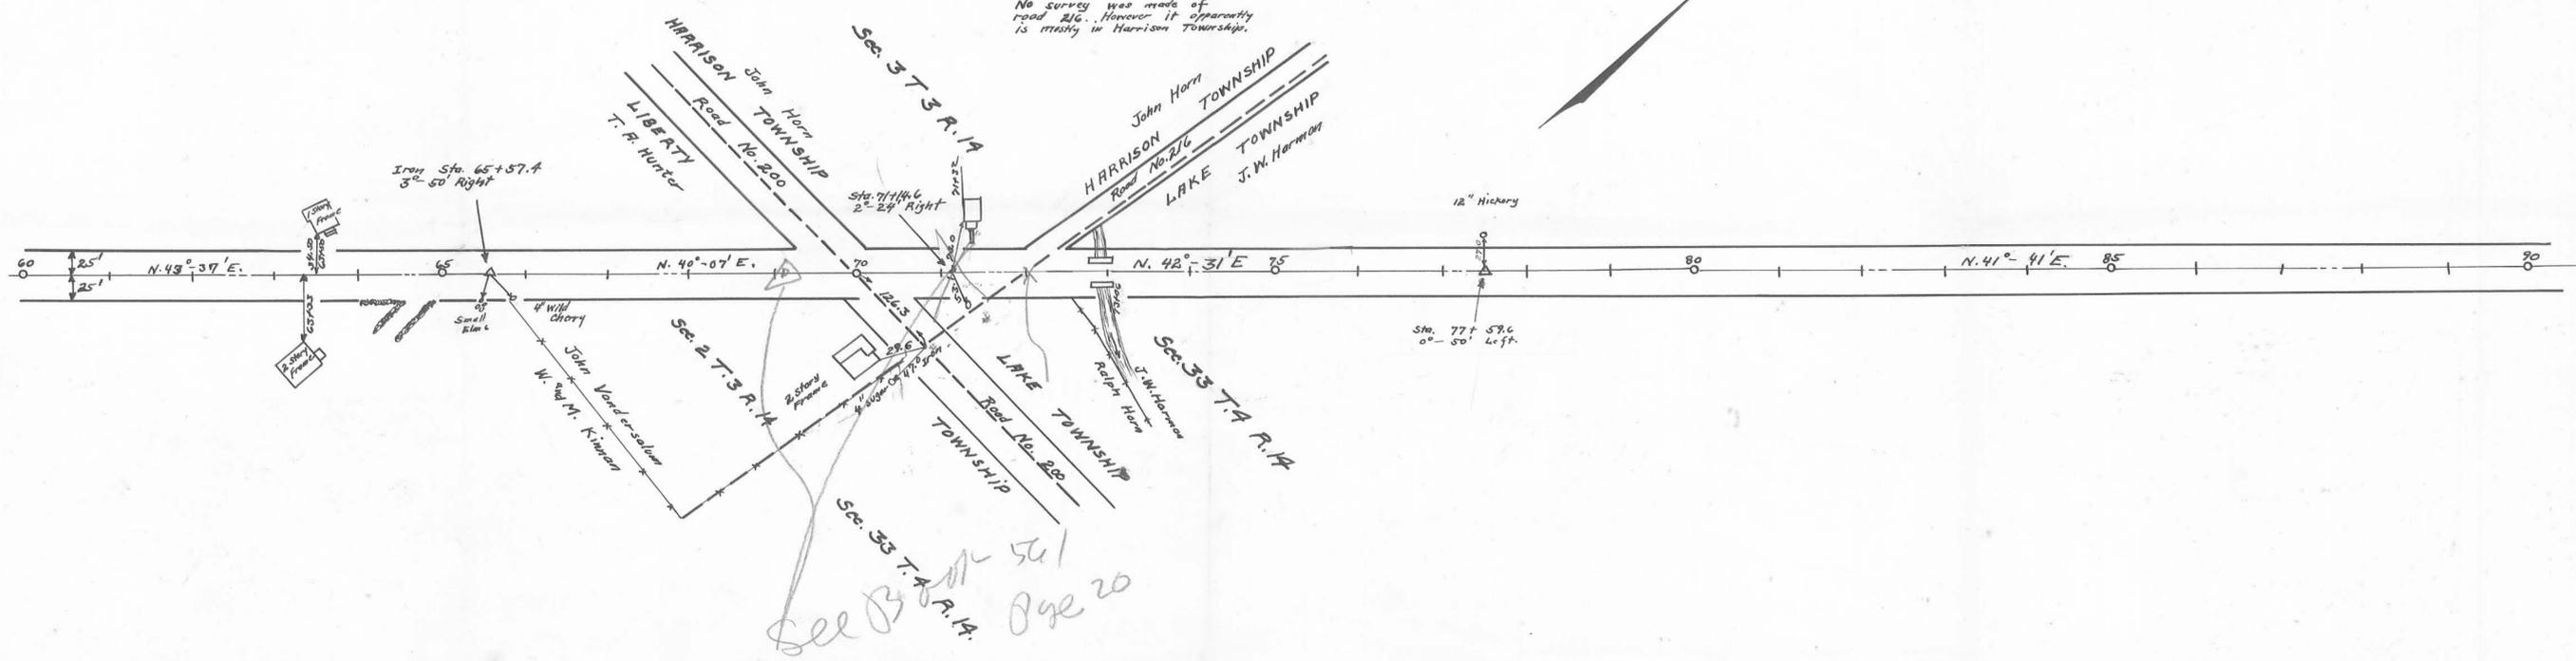

See 35 501  
 092 20

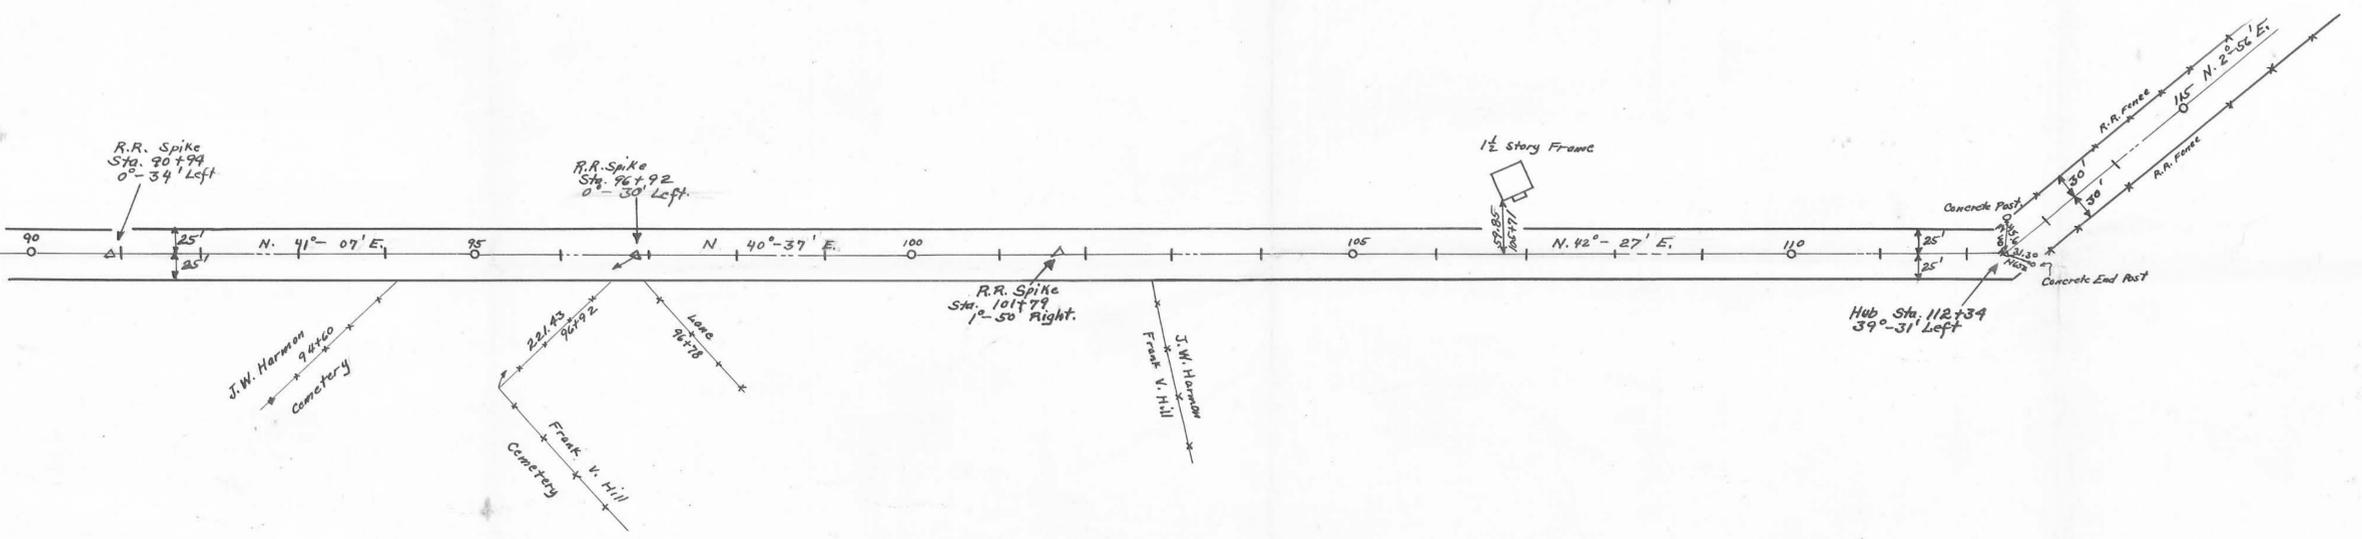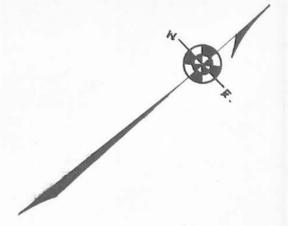

Field Notes in Logan County  
 Surveyor Book No. 561


1932

1365  
 INDEXES ON MAP

ROAD NO. 52  
 UNION - LIBERTY TOWNSHIPS  
 HARRISON - LAKE  
 LOGAN COUNTY  
 1932

3  
 3

Length 13151 Feet  
 Length 2.49 Miles

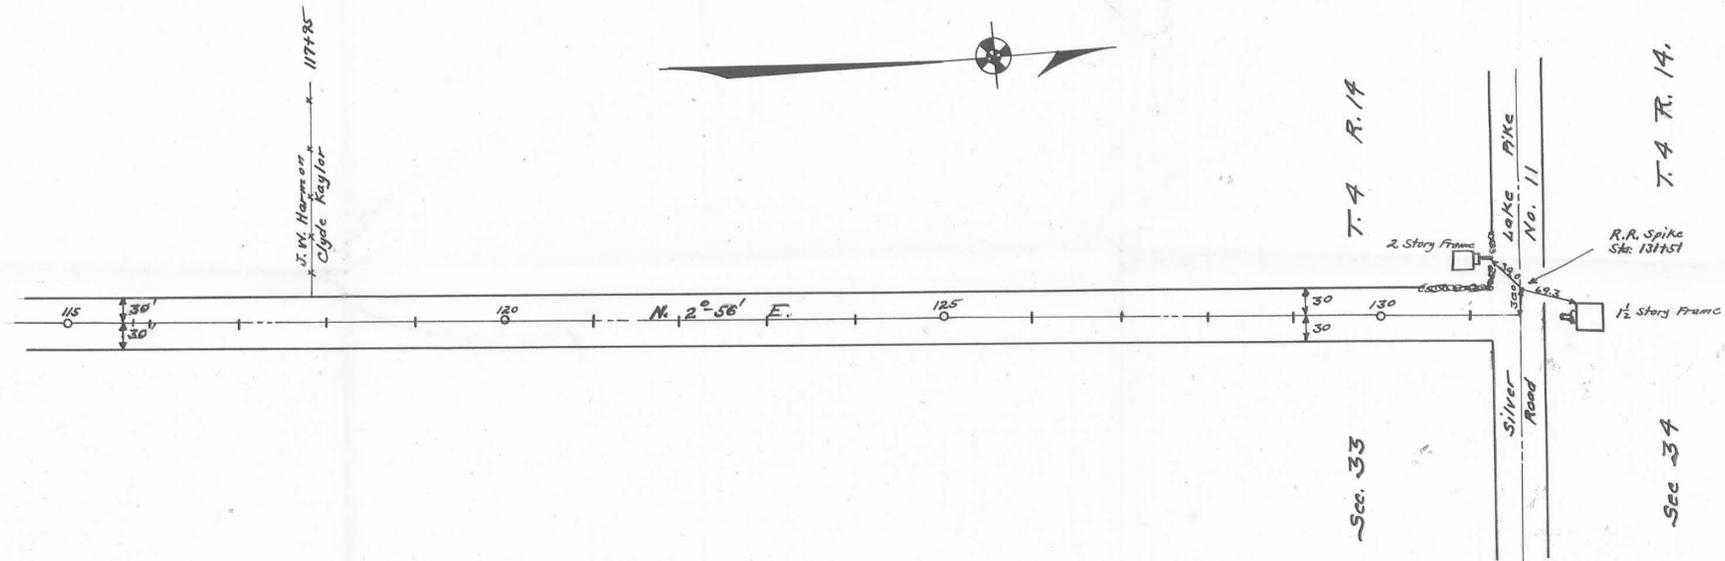

J. M. Harmon  
 + Clyde Kaylor  
 117785

Field Notes in Logan County  
 Surveyors Book No. 561

J. M. Knight  
 1932

INDEXED ON MAP