


ROAD 19

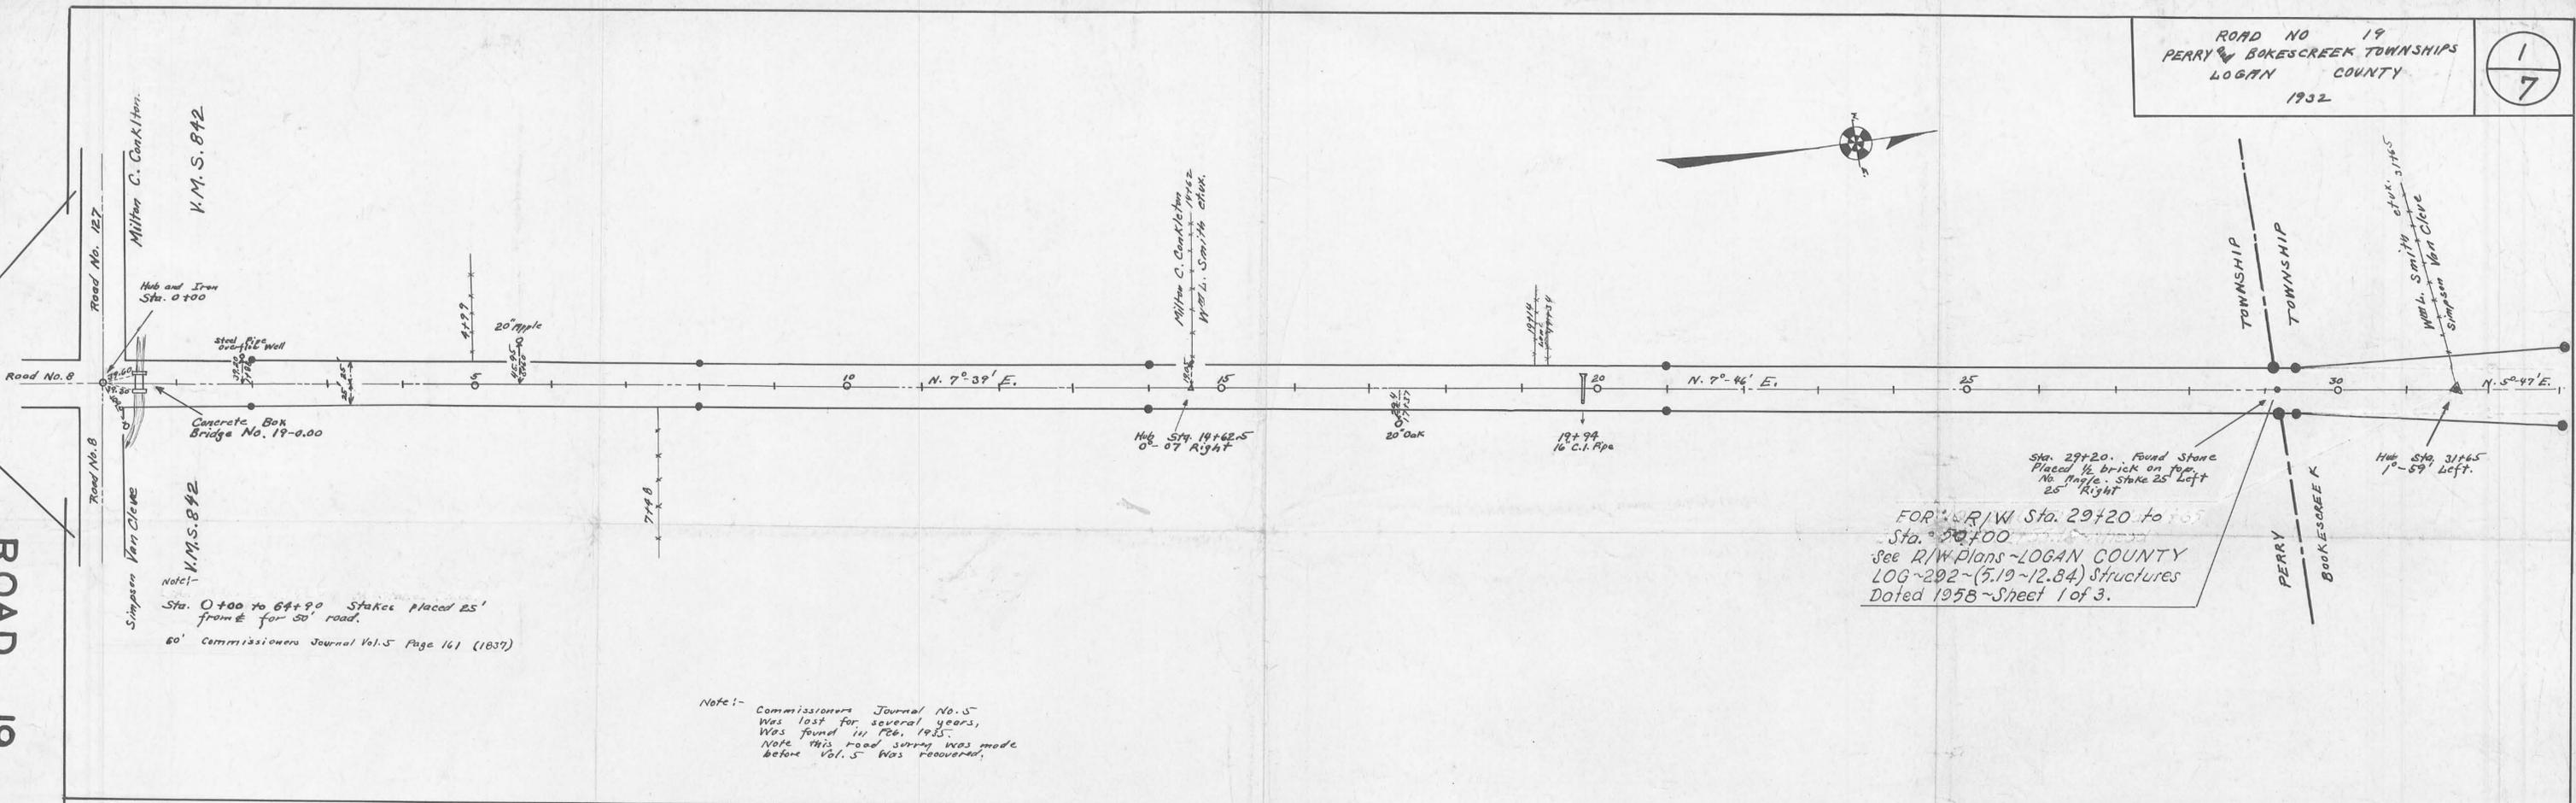


FOR R/W Sta. 29+20 to 30+00
 Sta. 0+00
 See R/W Plans - LOGAN COUNTY
 LOG-202 - (5.19-12.84) Structures
 Dated 1958 - Sheet 1 of 3.

Note: - Commissioners Journal No. 5
 Was lost for several years,
 Was found in Feb. 1935.
 Note this road survey was made
 before Vol. 5 was recovered.

Note: -
 Sta. 0+00 to 6+90 Stakes placed 25'
 from E for 50' road.
 60' Commissioners Journal Vol. 5 Page 161 (1837)

For R/W Plans of S.R. LOG-292 &
 S.R. LOG-47 See R/W Plans
 LOGAN COUNTY - SH 236 - SEC. E (Pt), C, S
 WEST MANSFIELD (Pt) - Date 1947
 Sheet 1 of 3
 Length 6490 feet 1.229 Miles

HARRY L. VAN CLEVE, ET AL

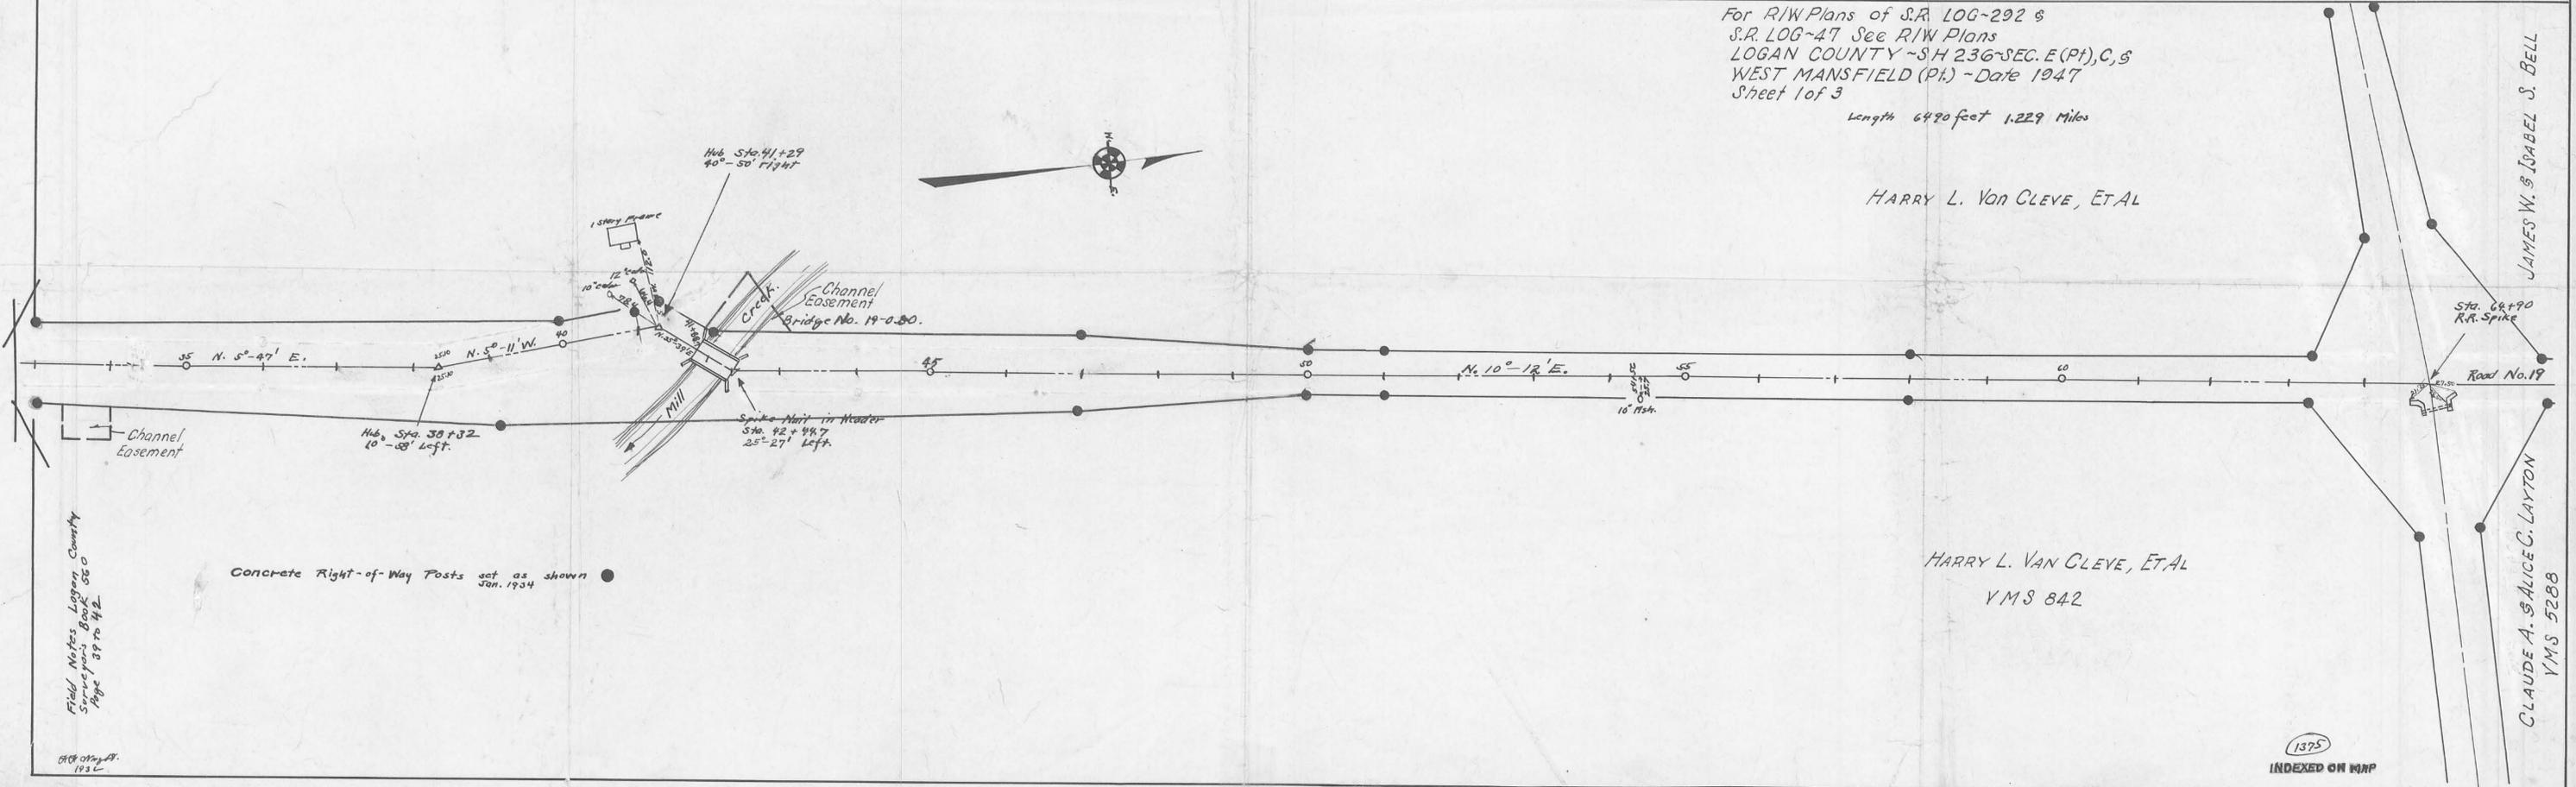



HARRY L. VAN CLEVE, ET AL
 YMS 842

Concrete Right-of-Way Posts set as shown
 Jan. 1934


Field Notes - Logan County
 Survey Book 360
 Page 37 to 42

JAMES W. & ISABEL S. BELL

CLAUDE A. & ALICE C. LAYTON
 YMS 5288

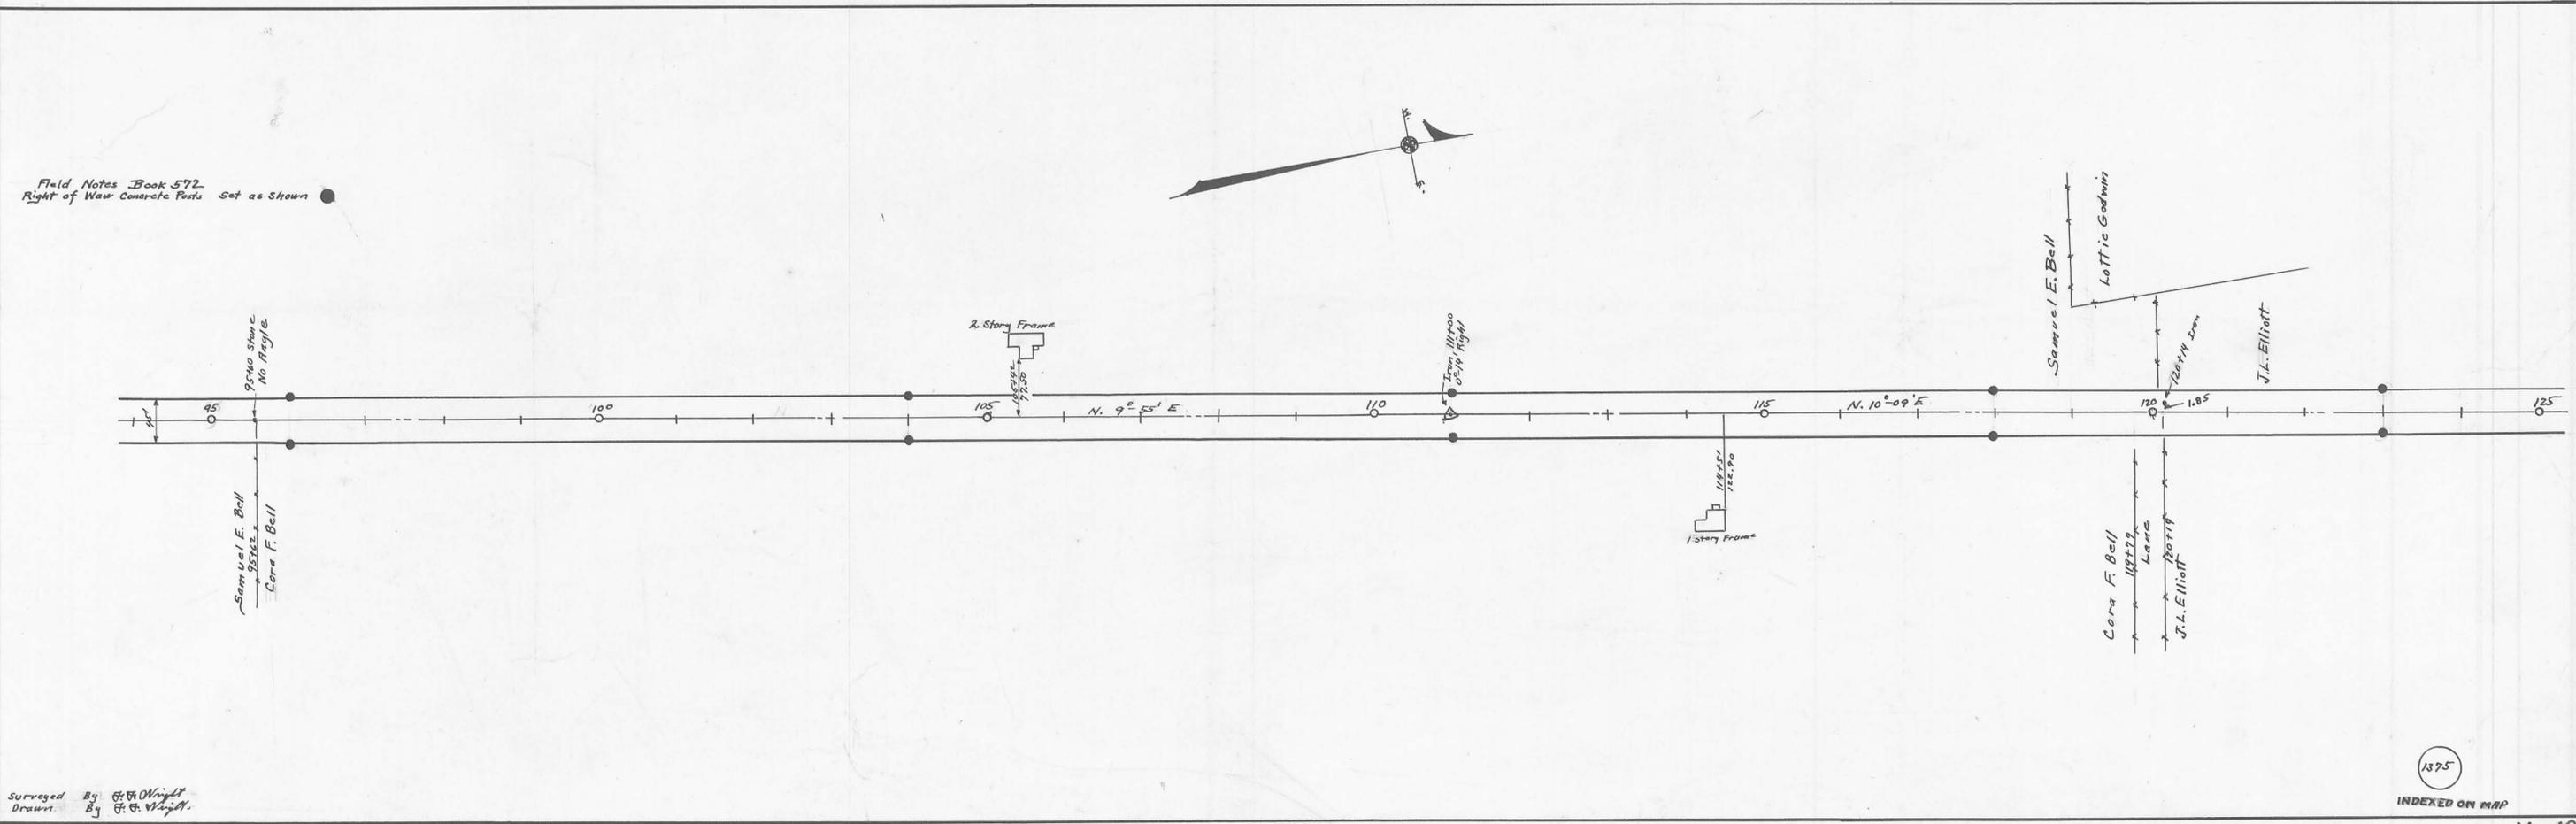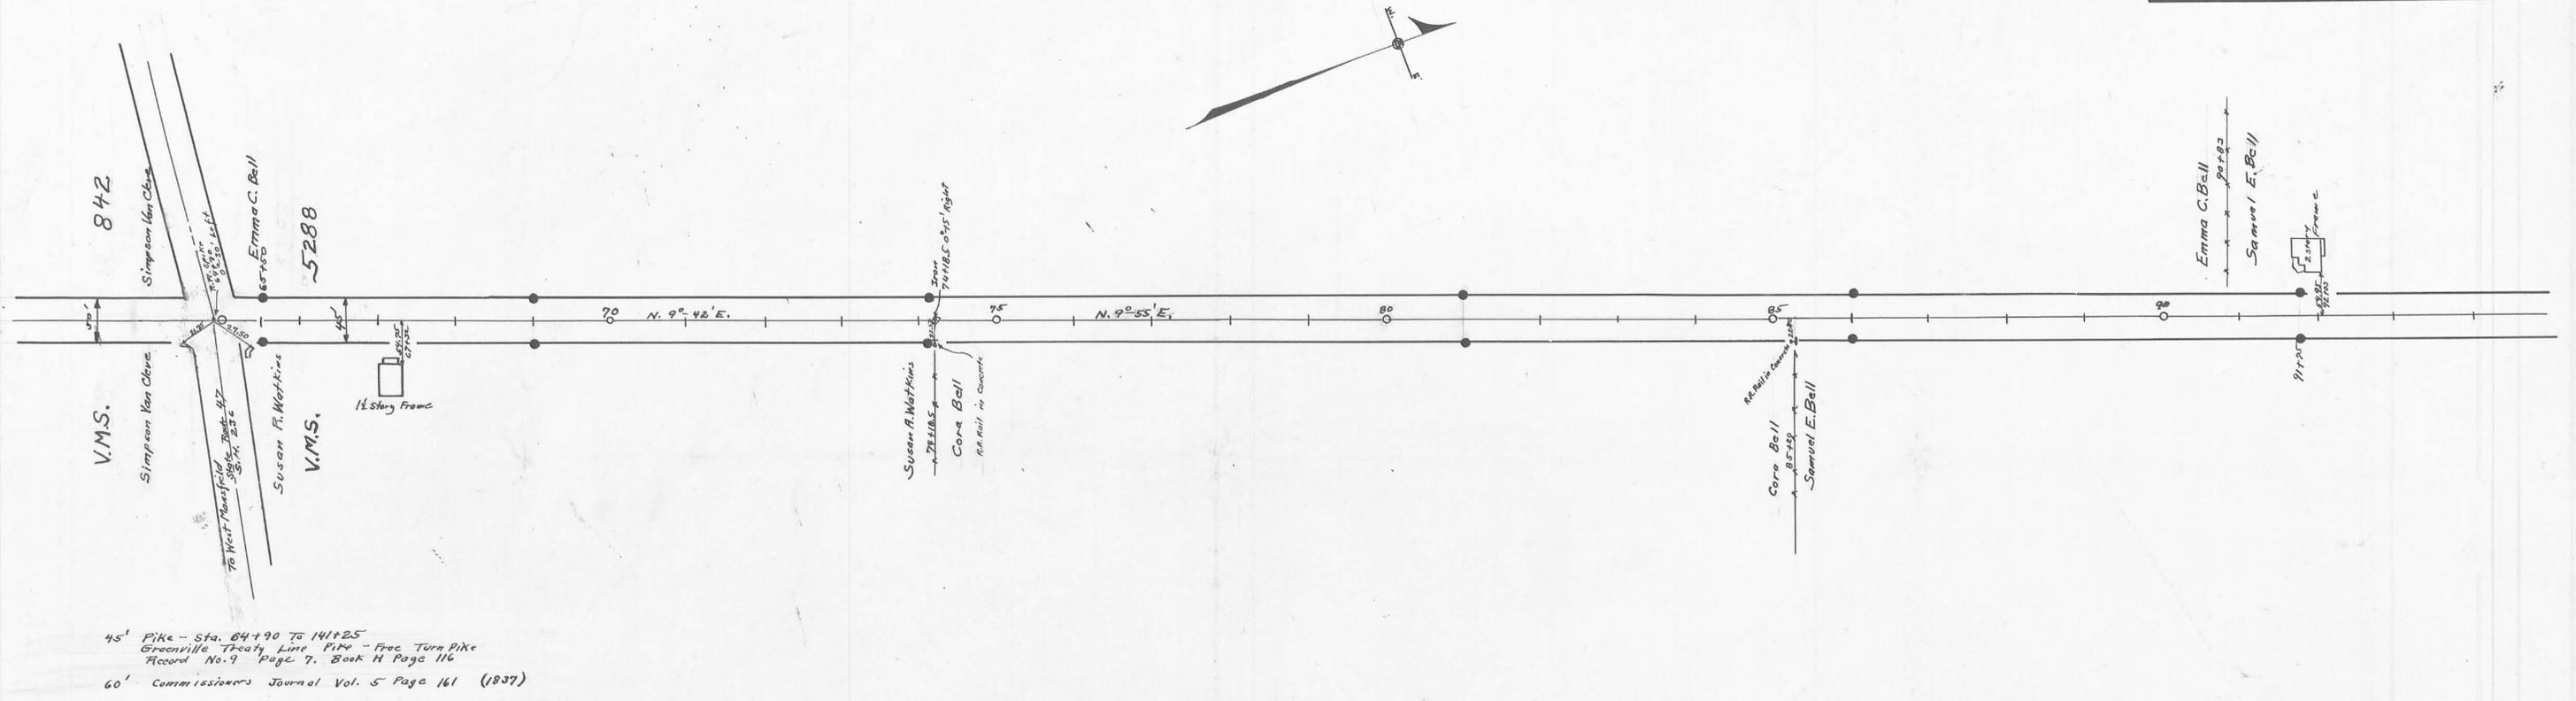


Surveyed By G.F. Wright
 Drawn By G.F. Wright

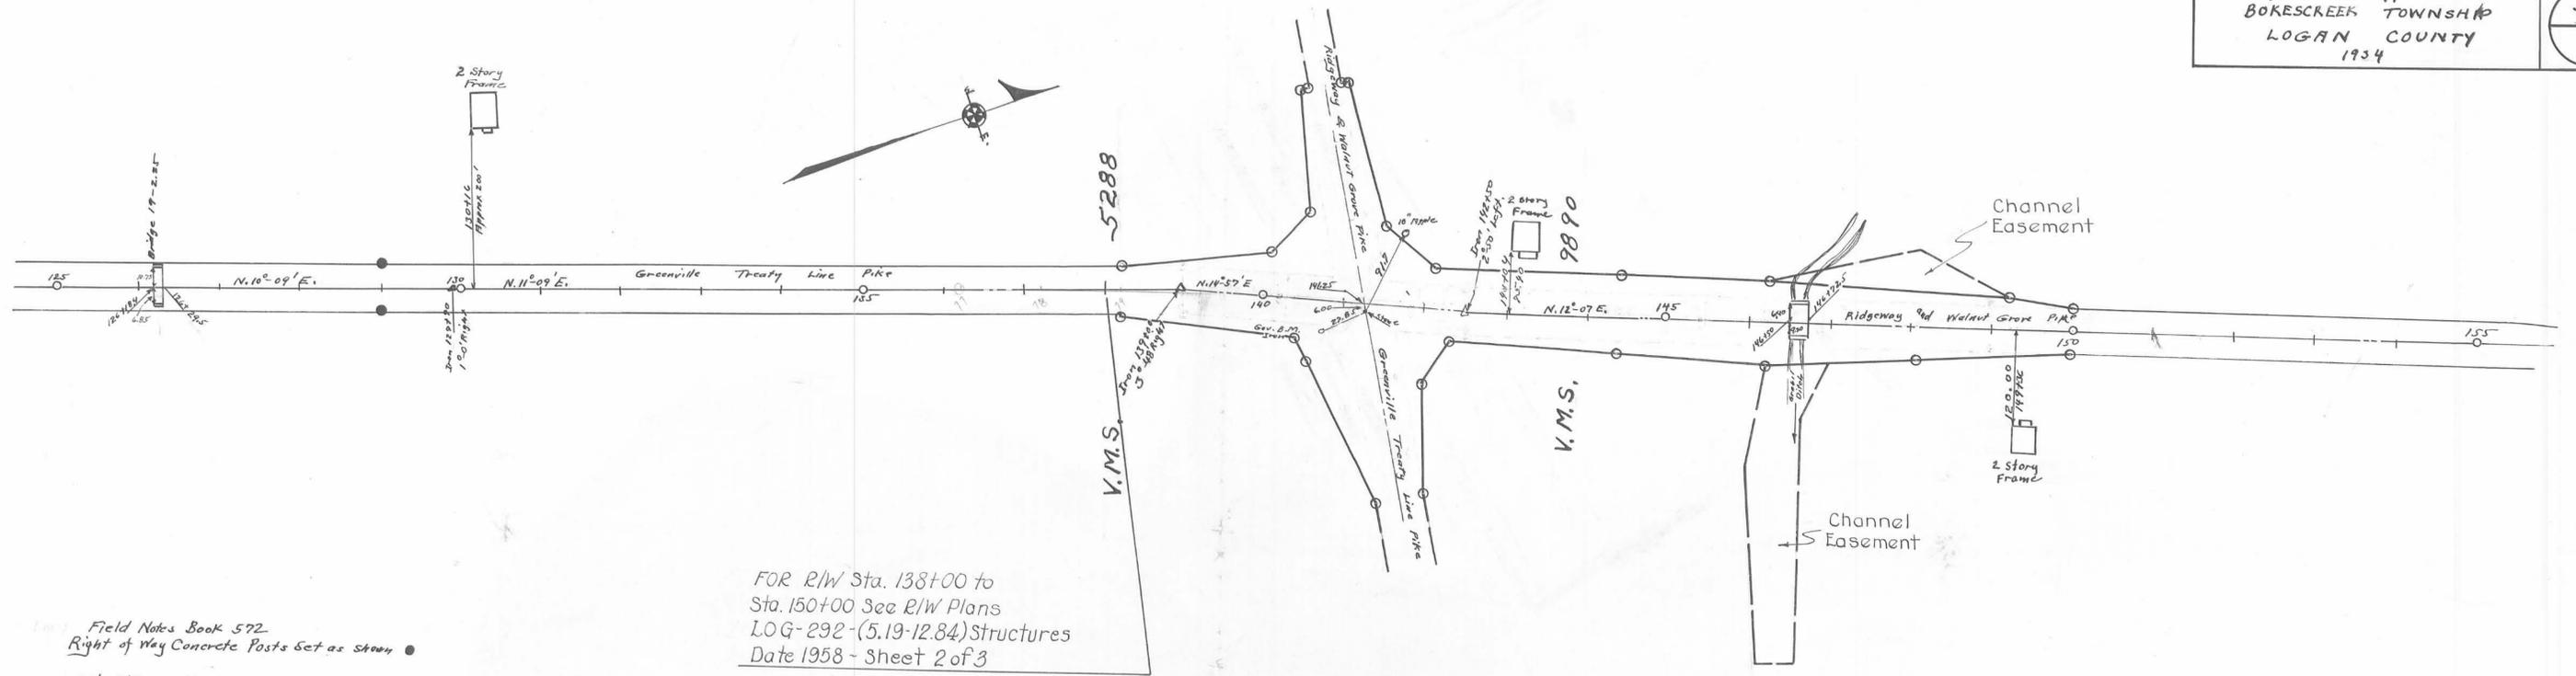


FOR R/W Sta. 138+00 to
 Sta. 150+00 See R/W Plans
 LOG-292-(5.19-12.84) Structures
 Date 1958 - Sheet 2 of 3

Field Notes Book 572
 Right of Way Concrete Posts Set as shown



50' Pike Sta. 141+25 To Sta. 423+79
 Ridgeway and Walnut Grove Pike - Pike Book
 N 750 76 (1876)
 60' Commissioners Journal Vol. 5 Page 161 (1837)

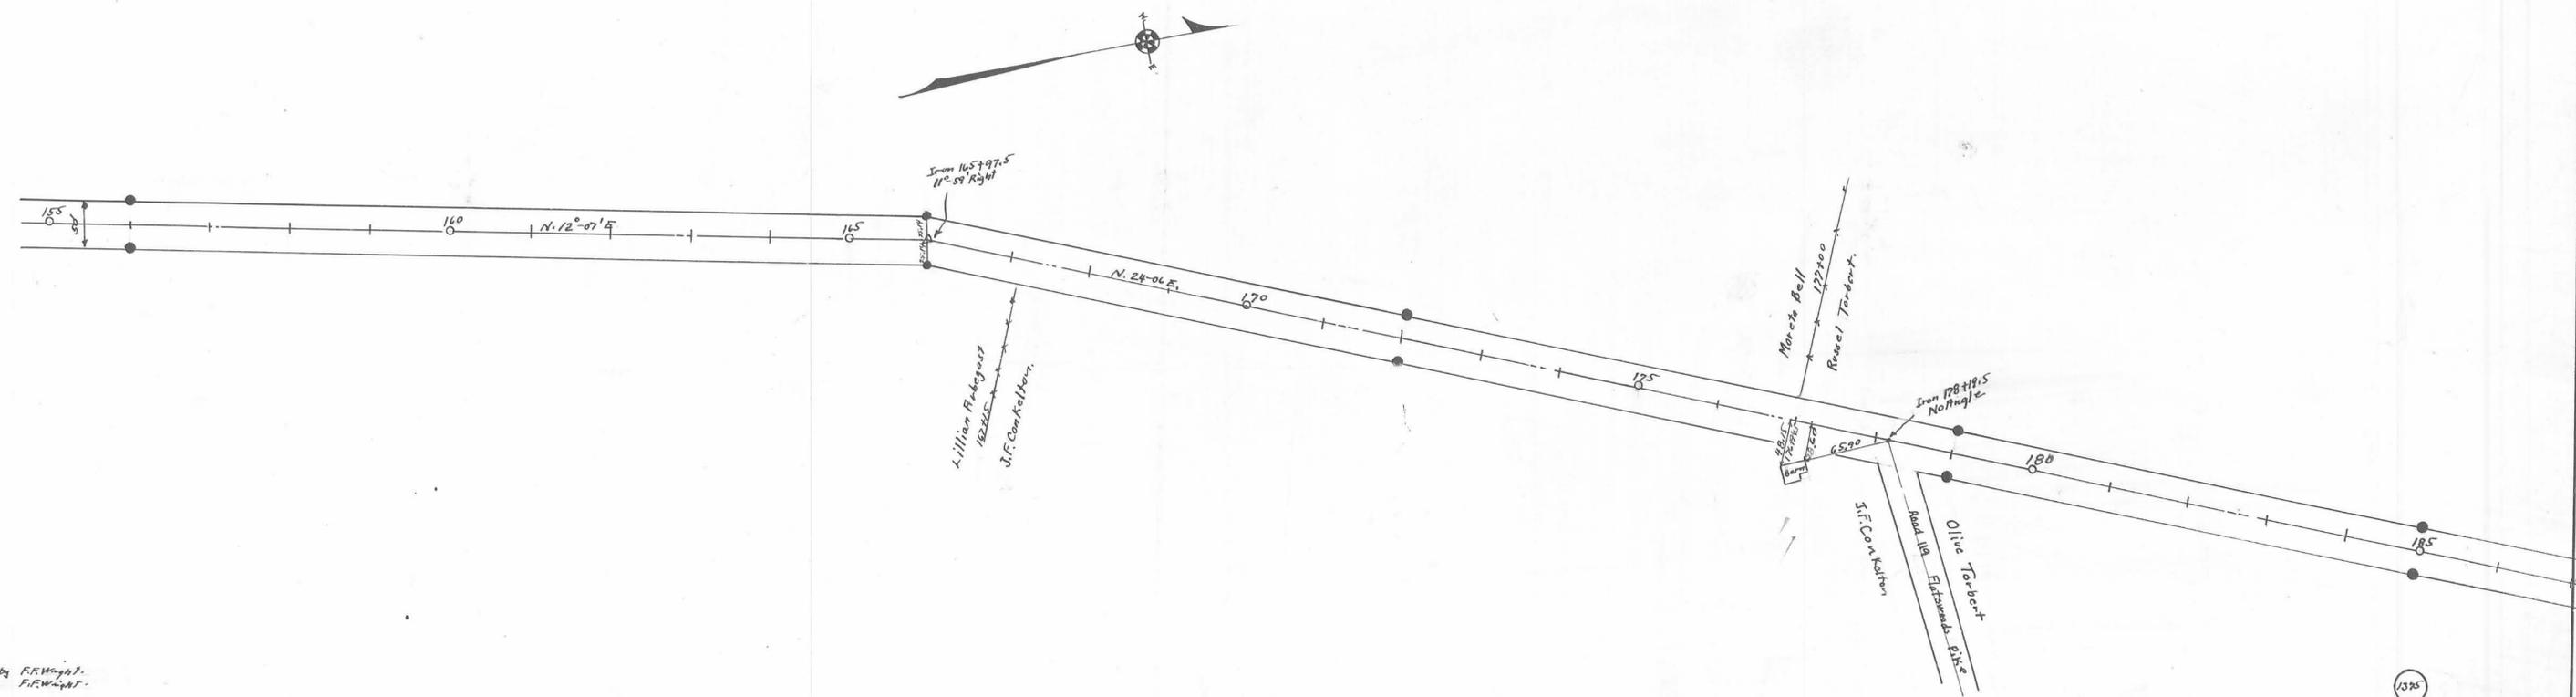

Surveyed by F.F. WAGNER
 Drawn by F.F. WAGNER


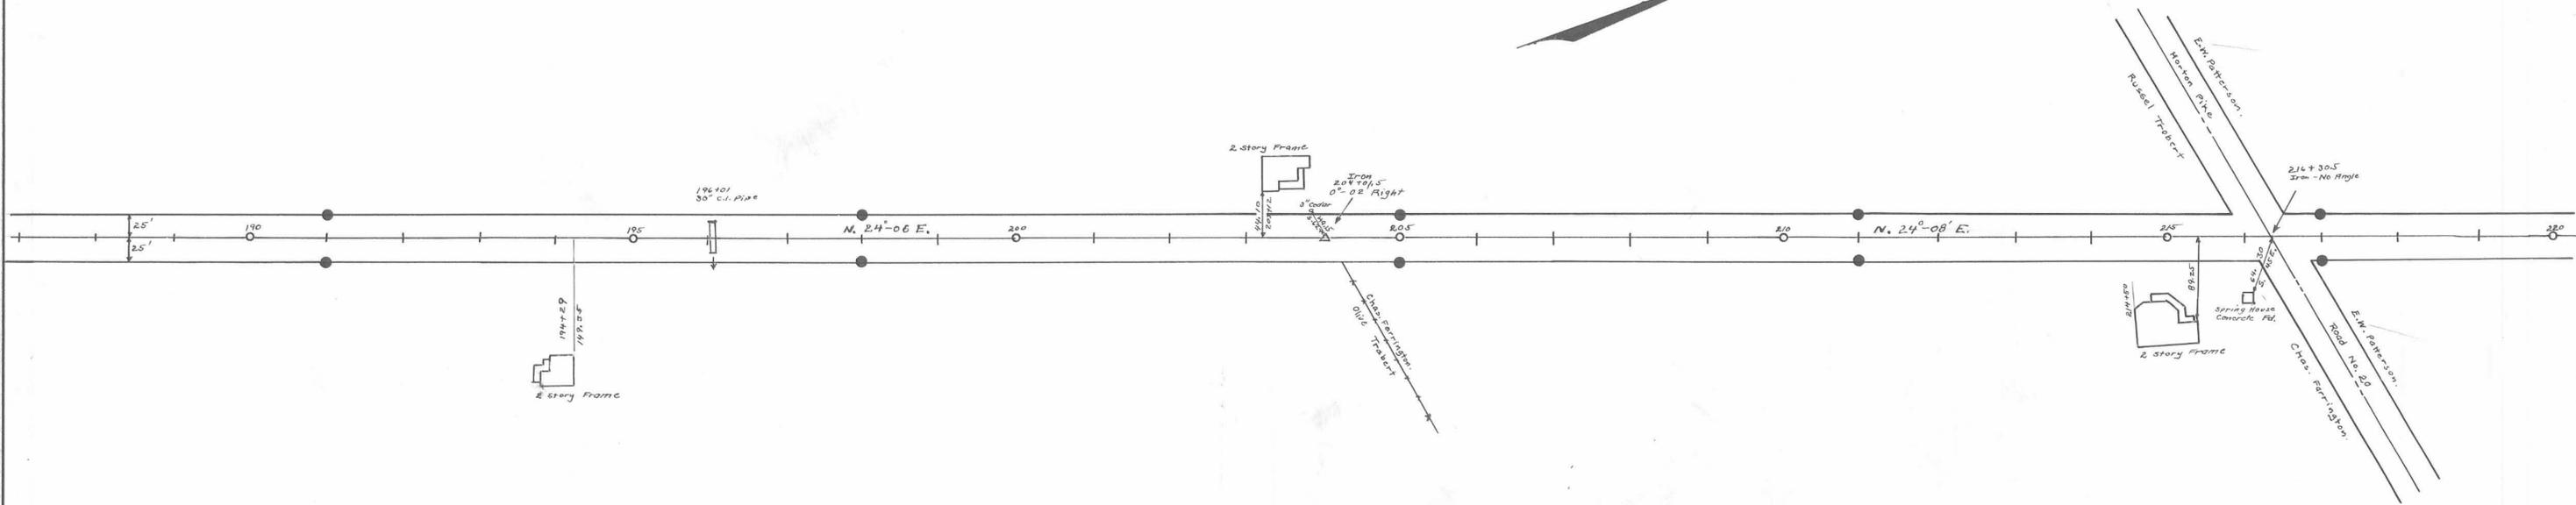


Field Notes Book 572
 Concrete Right of Way Posts Set as shown. ●

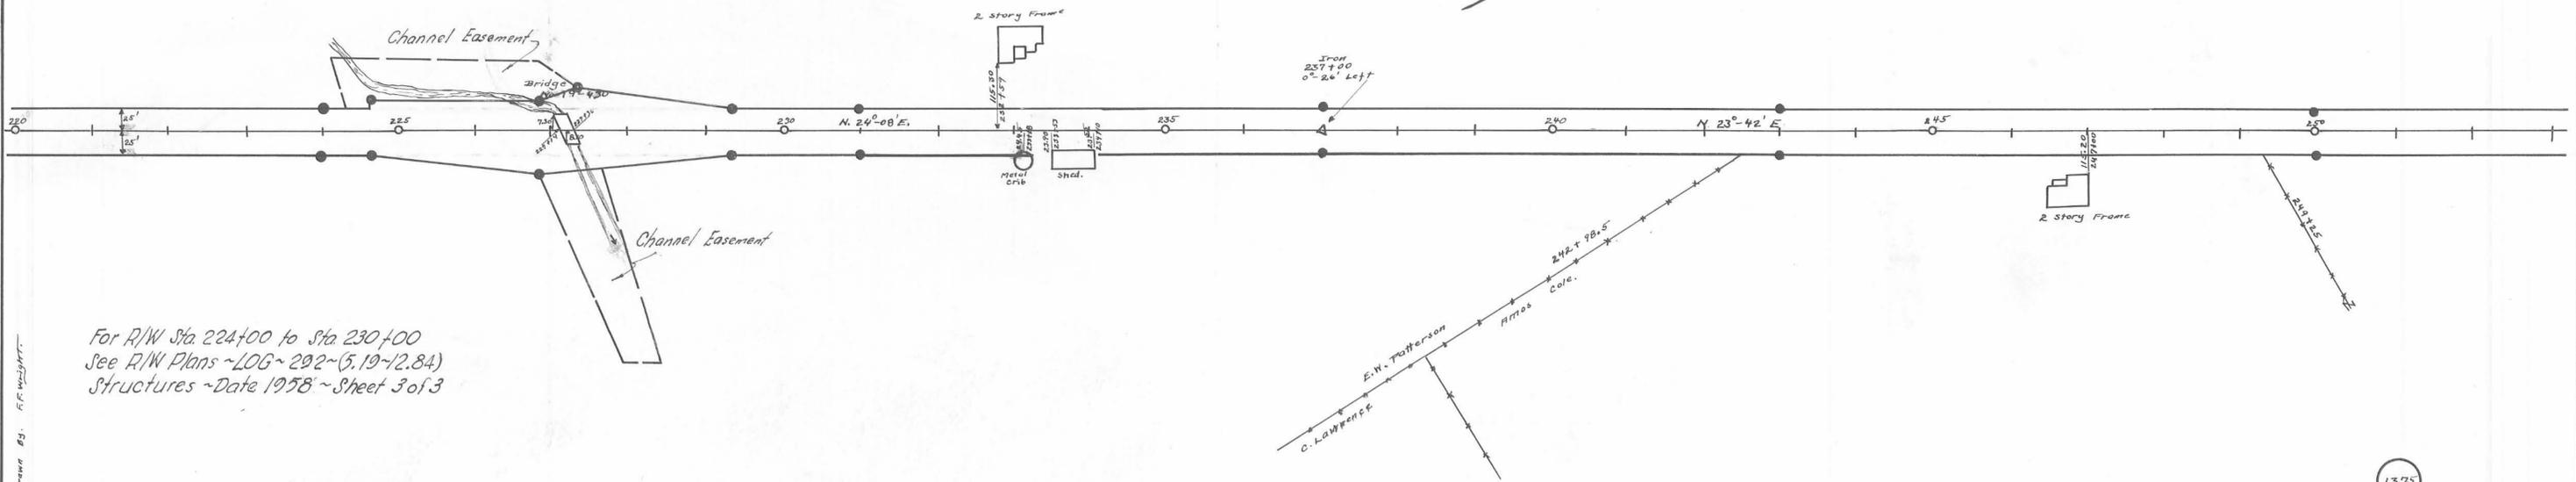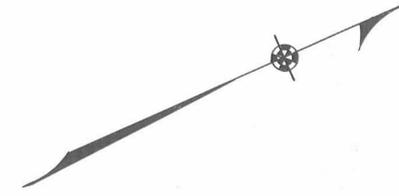

For R/W Sta 224+00 to Sta 230+00
 See R/W Plans ~LOG~292~(5.19-12.84)
 Structures ~Date 1958~Sheet 3 of 3

Drawn by: R. W. MILLER

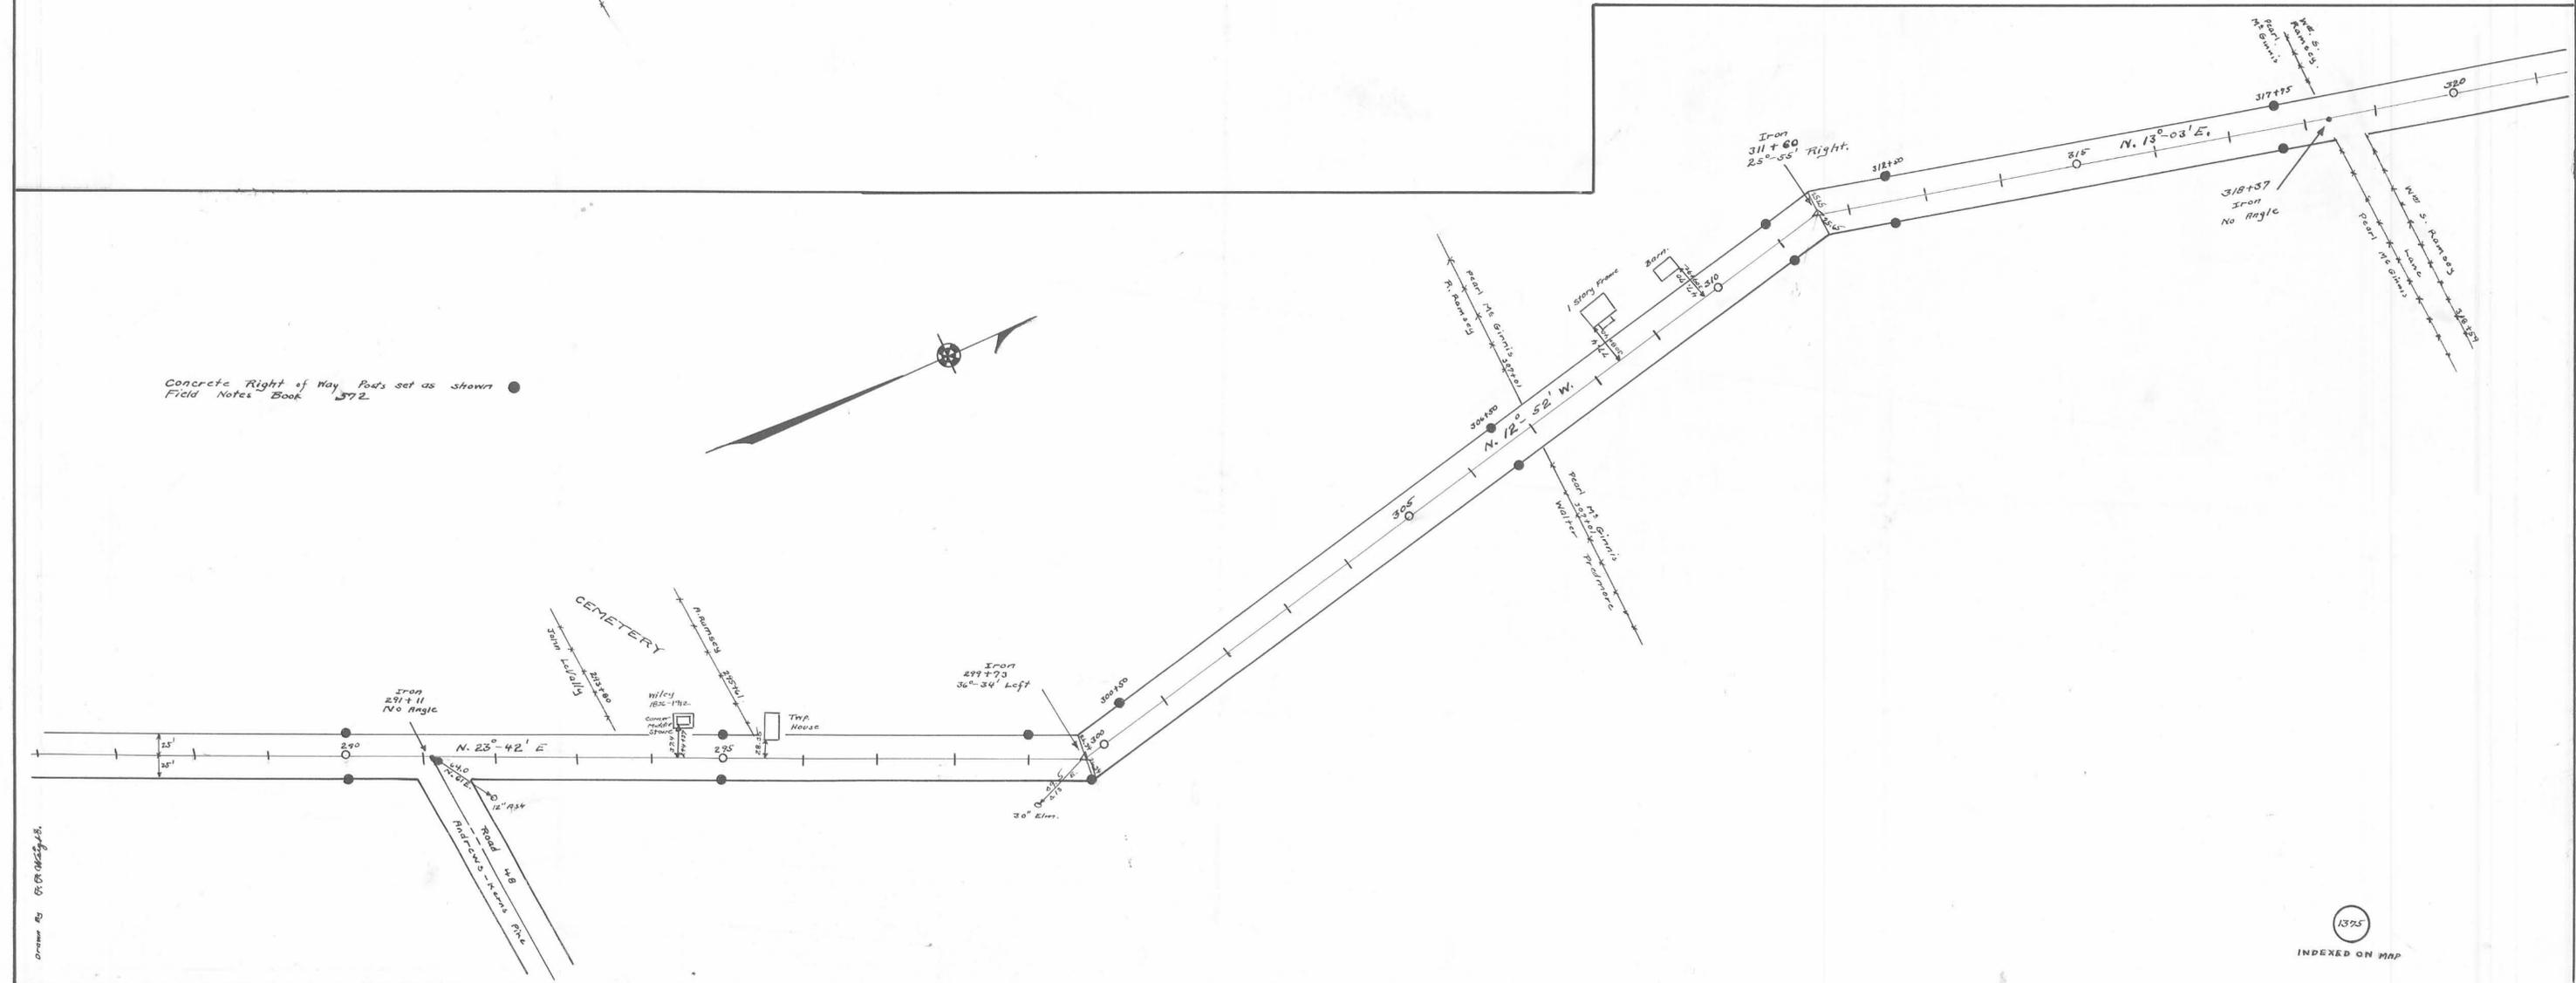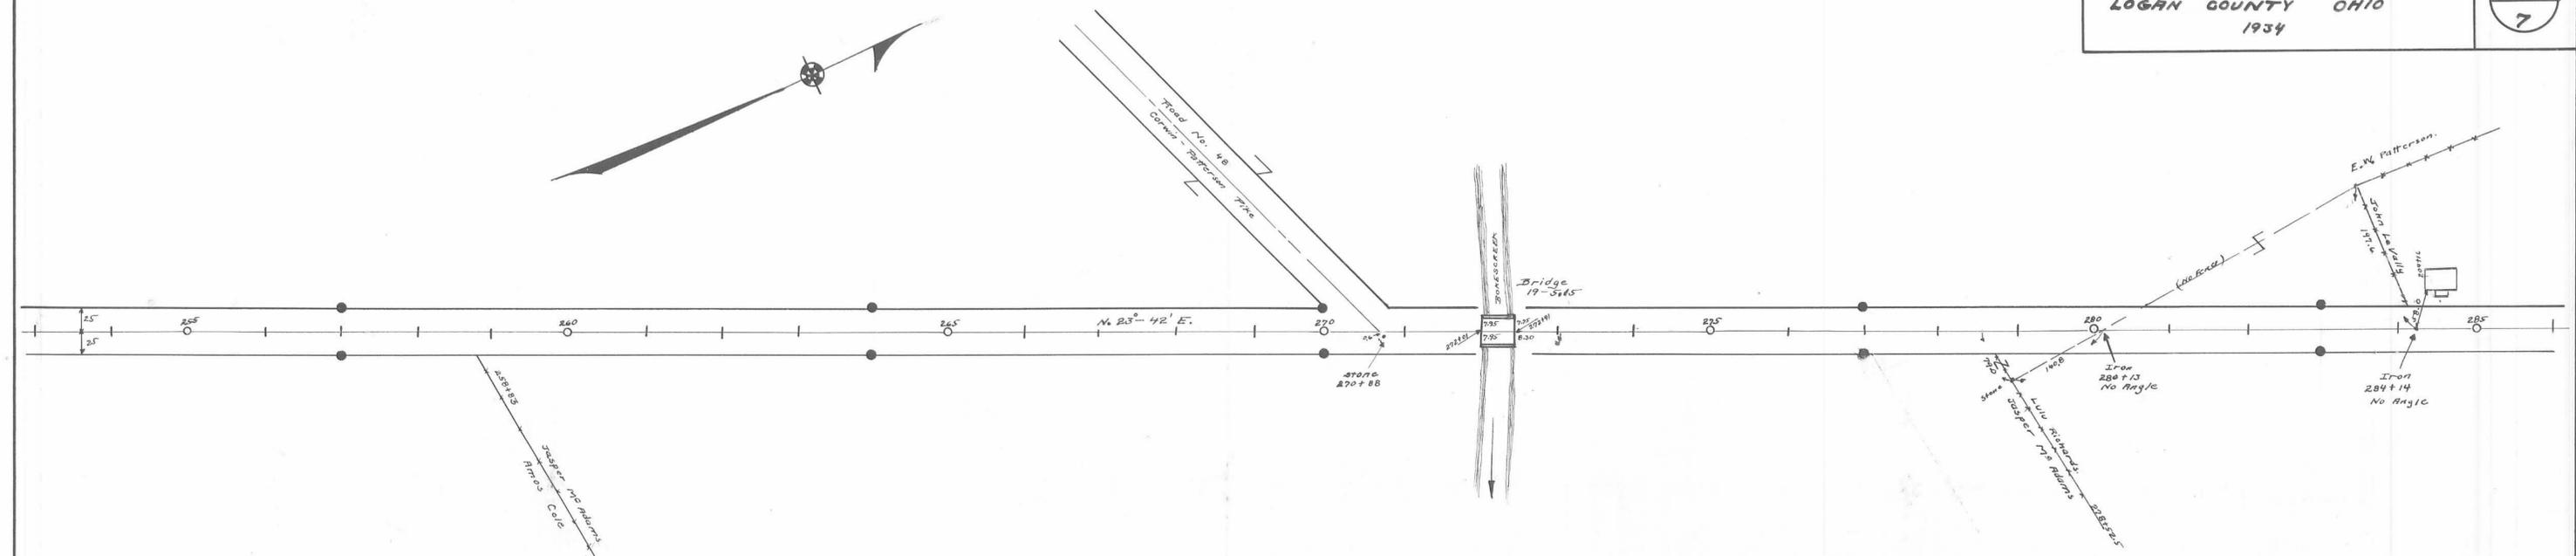

Concrete Right of Way Poles set as shown
 Field Notes Book 372

Drawn by GEORGE W. B. S.

1375
 INDEXED ON MAP

