
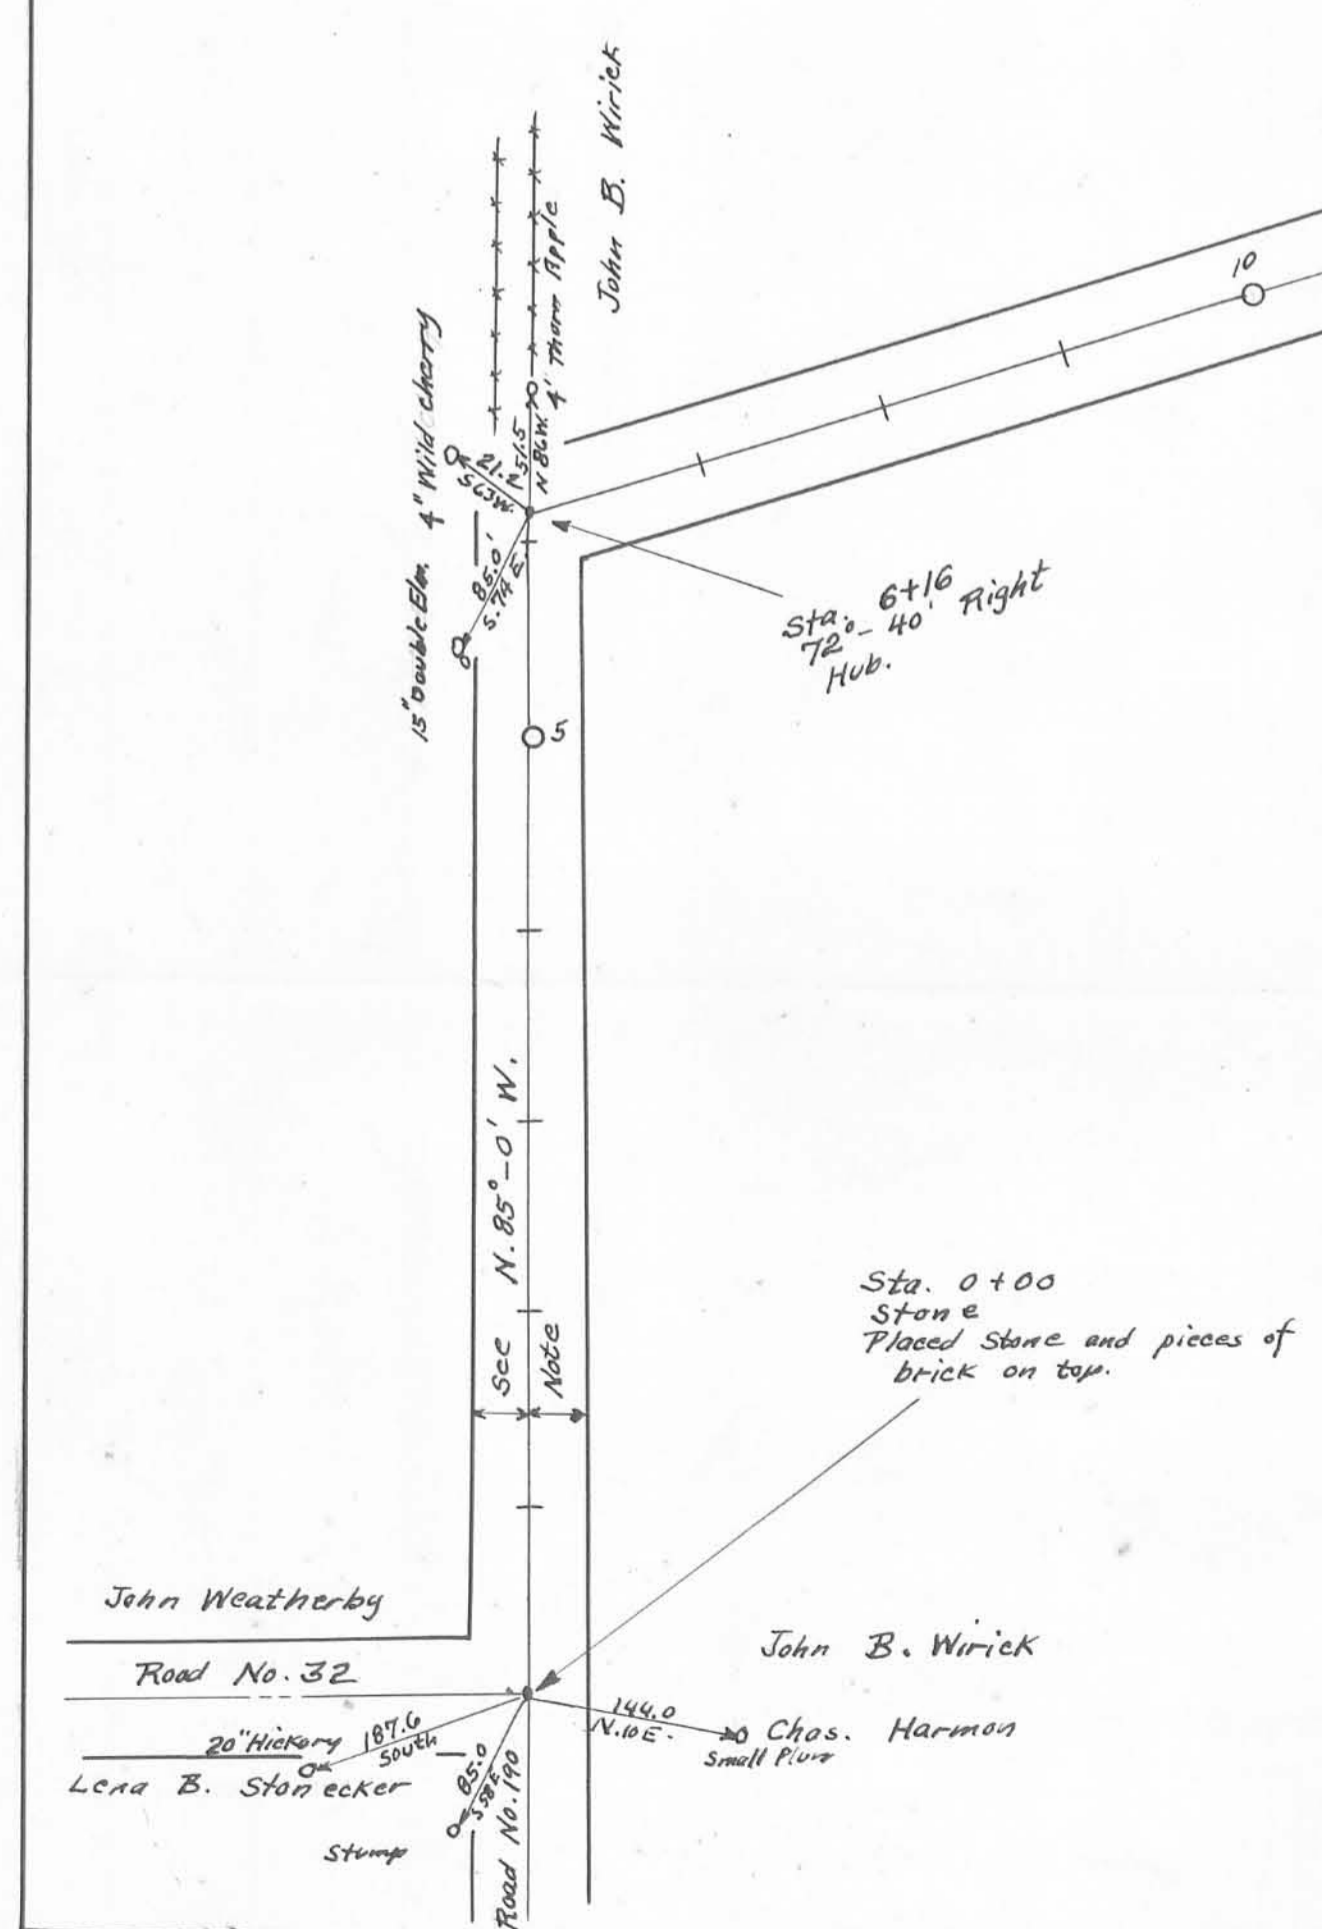
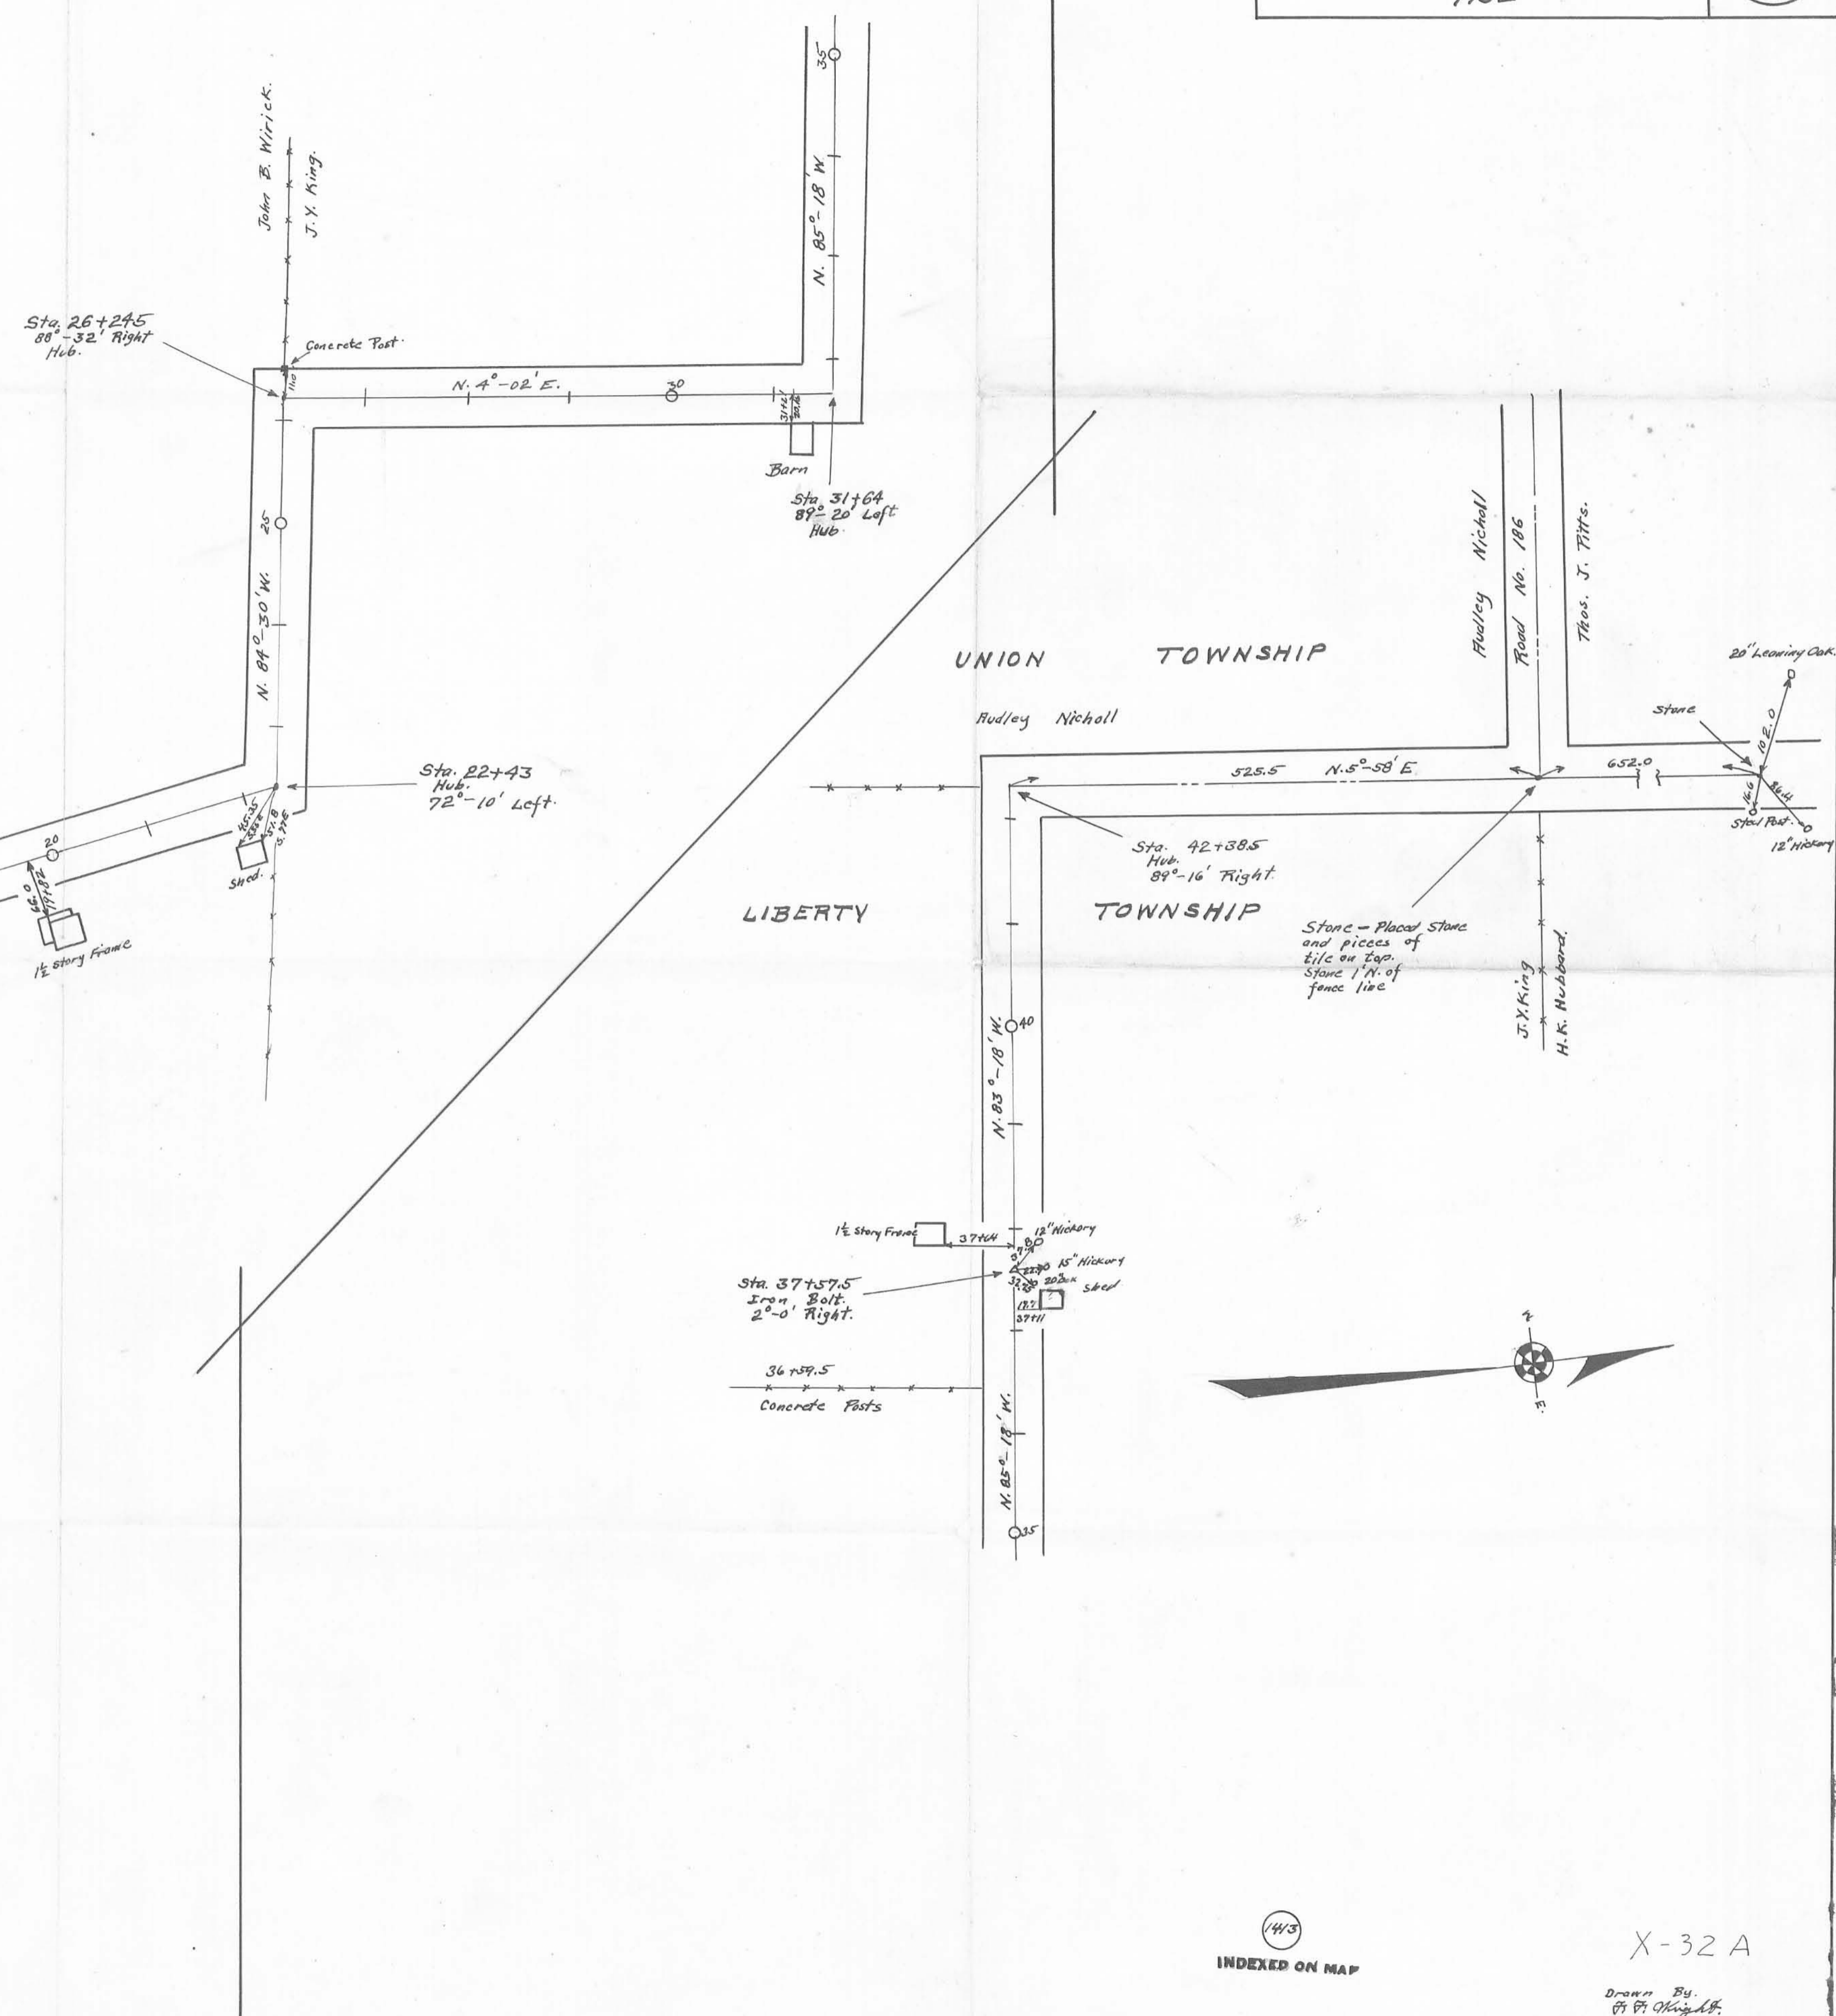


Field Notes in Logan County
Surveyors Book No. 559 Page 57 to 61
Stakes were placed 20' from E for 40' Road.
No road record found.
The Trustees improved the road by grading
between present fences and did not use
stakes on full 40'

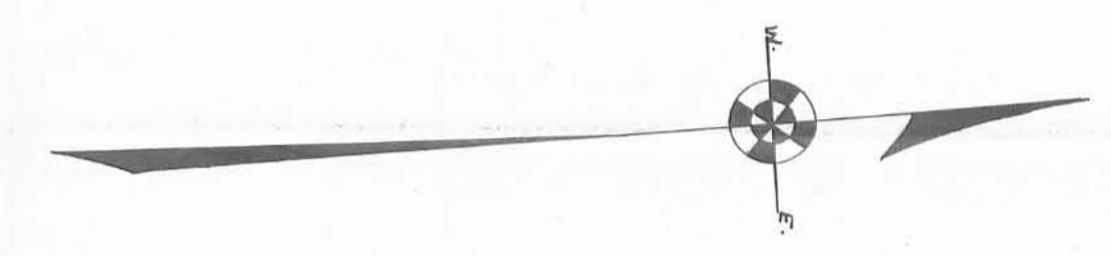

INDEXED ON MAP

X-32 A

Drawn By
G. P. King, A.E.