

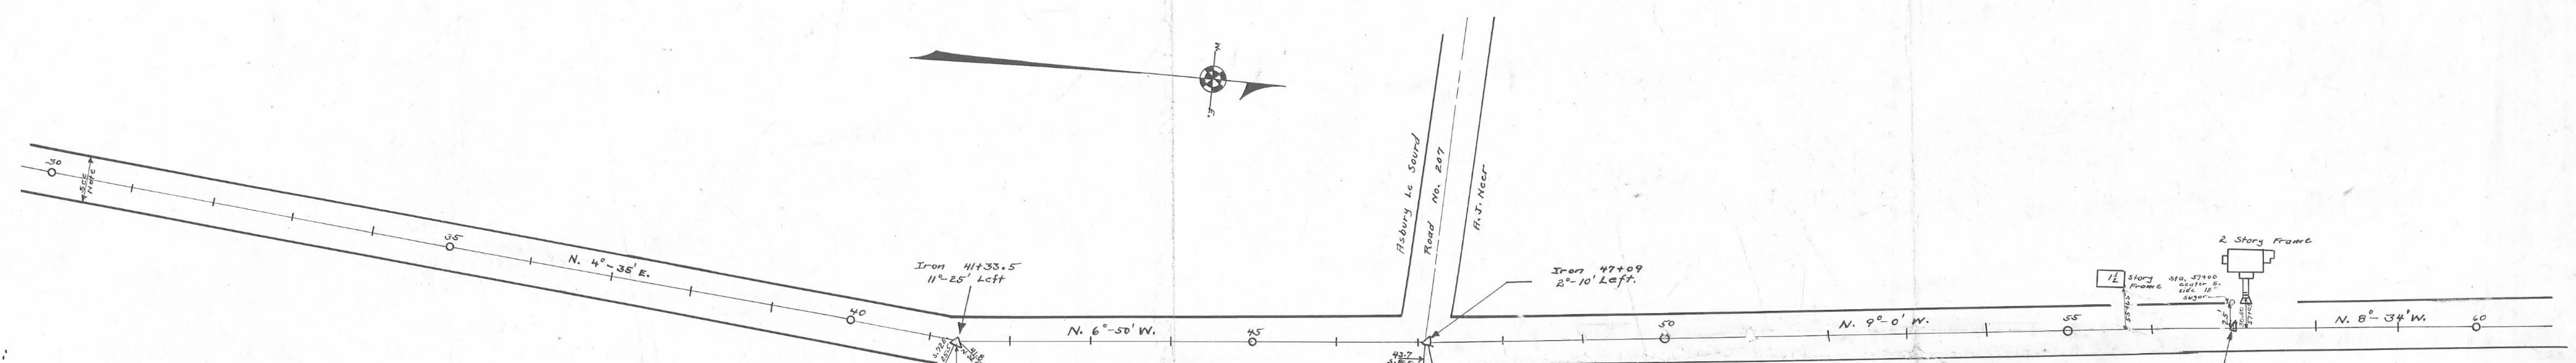


ROAD 33

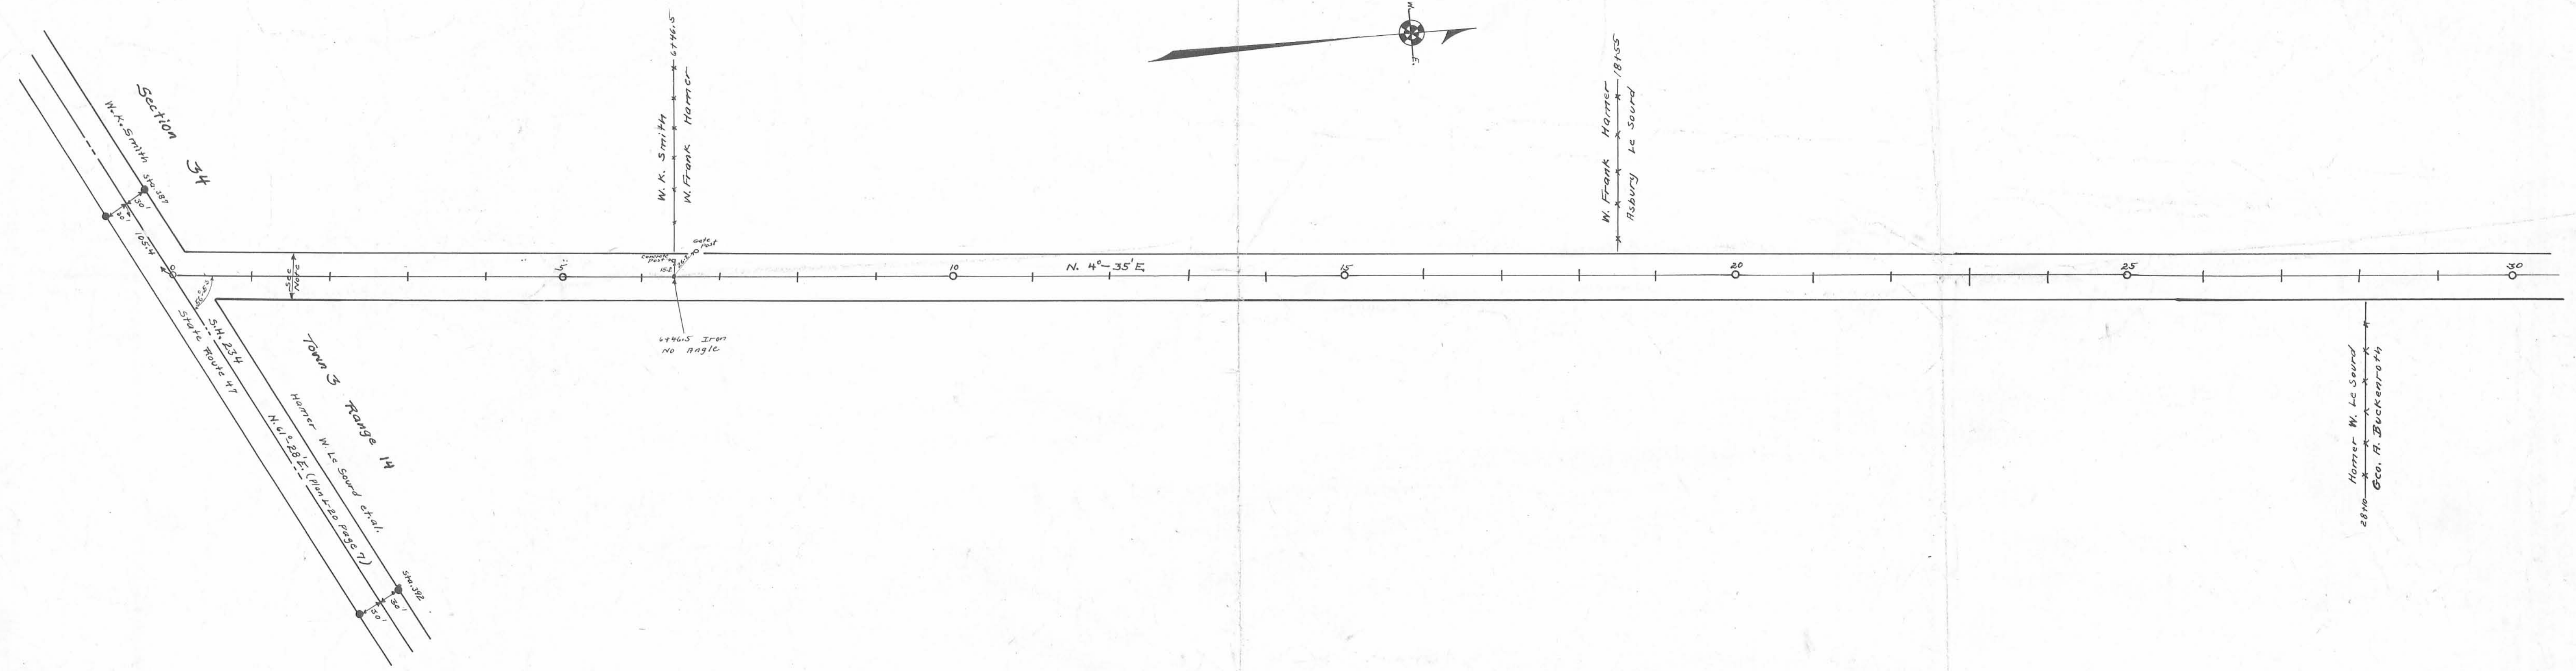



Note:
60' Road Commissioners Journal 4 Page 139 - May 1834
Stakes Placed 25' from & for a 50' Road. (No Legal reduction in width. Only using 50' of the 60')
Field Notes Book 588
Petition for reduction in width of this road was made 1925 Commissioners Journal Y - Page 530
Petition not granted - Width to remain 60' - Commissioners Journal Y Pages 533 and 544

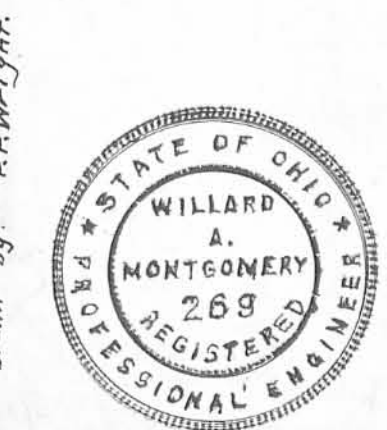

INDEXED ON MAP

X-33

X-33

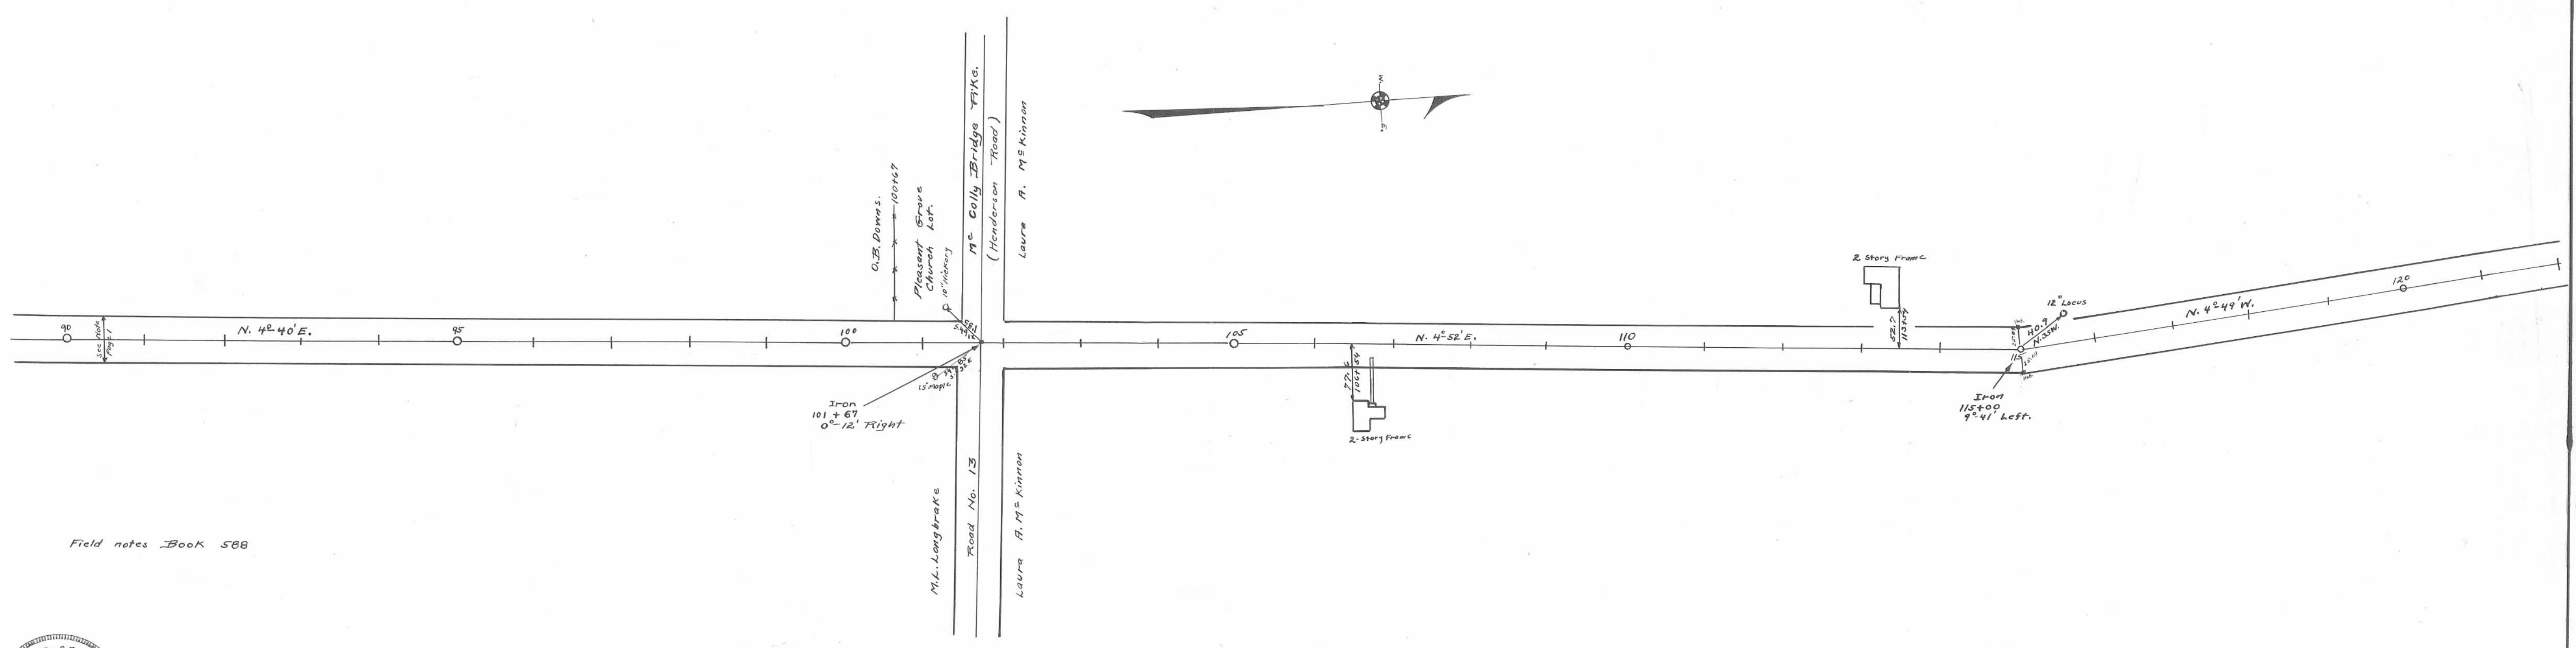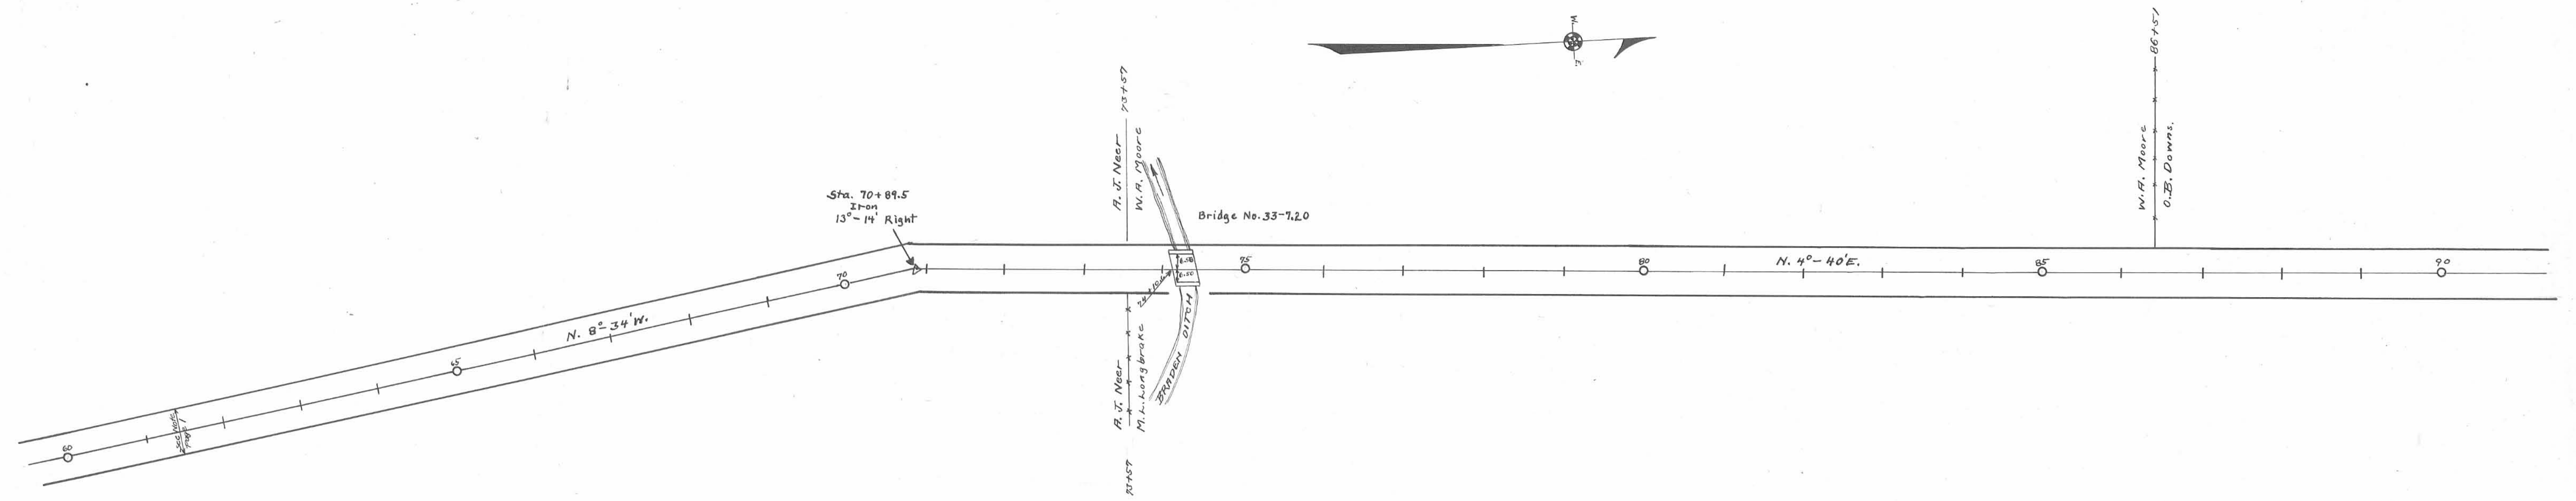

Field notes Book 588

Drawn by [signature]



INDEXED ON MAP

