



1350
INDEXED ON MAP

● Indicates Concrete Right-of-Way posts

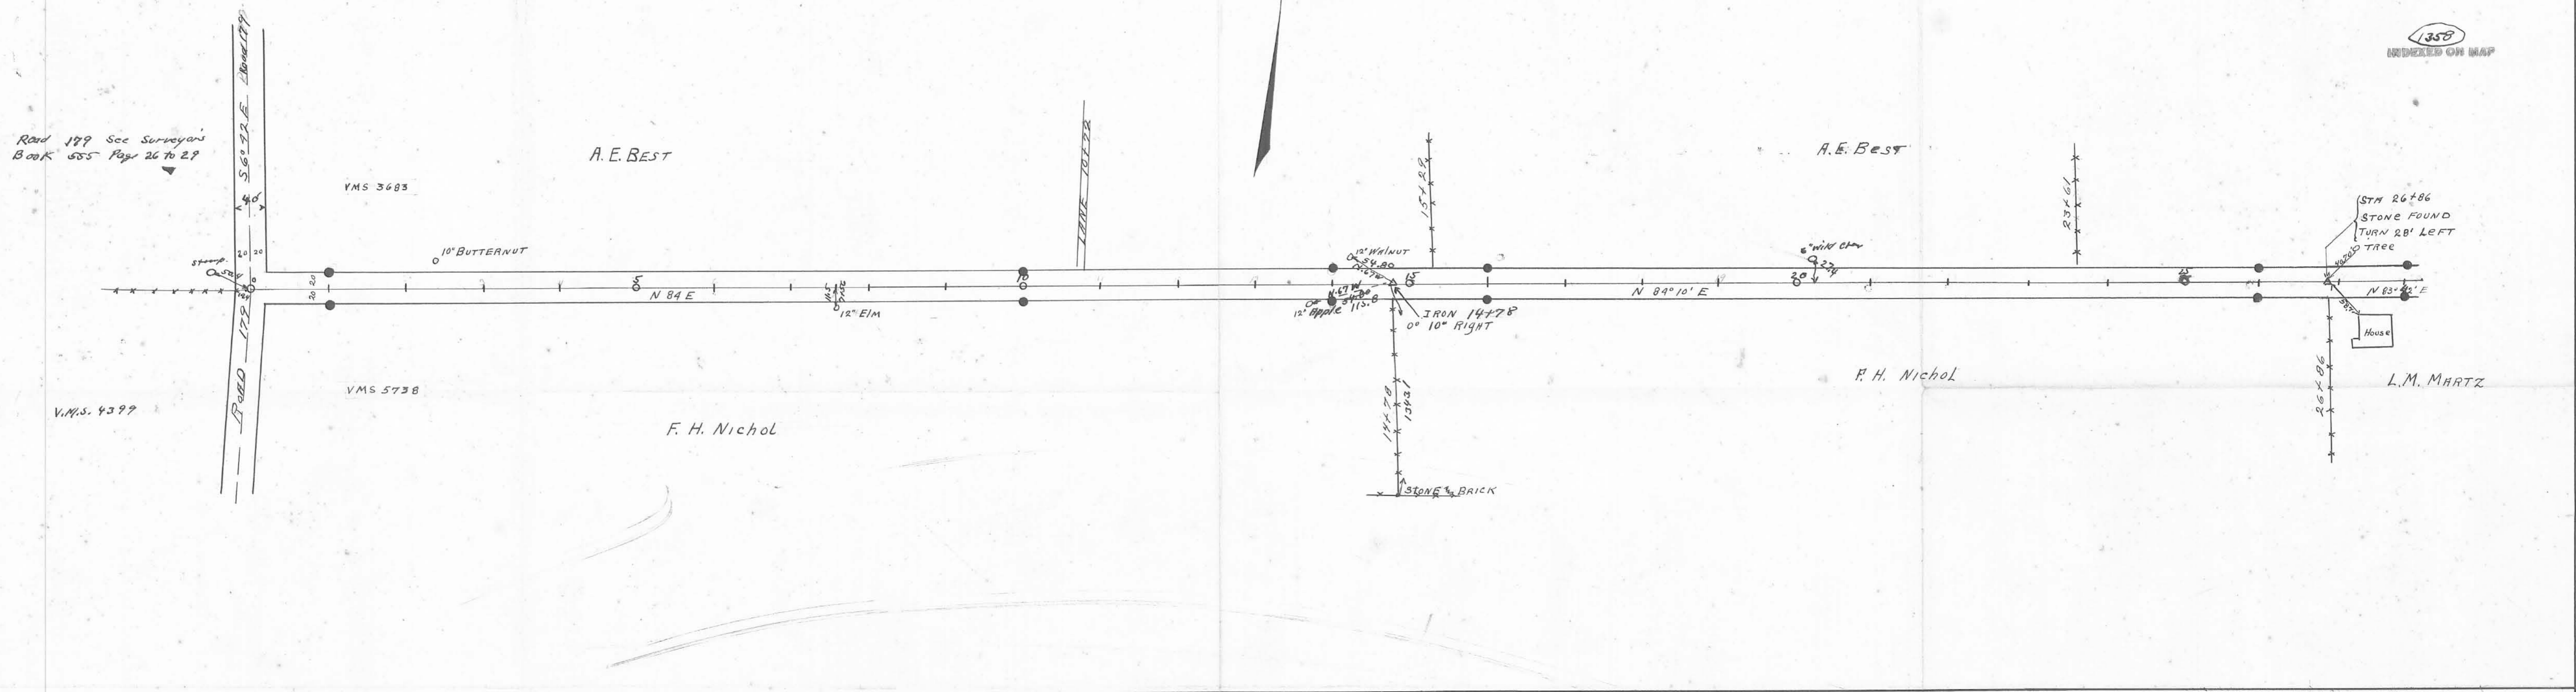

Length 5759 Feet
Length 1.0907 Miles

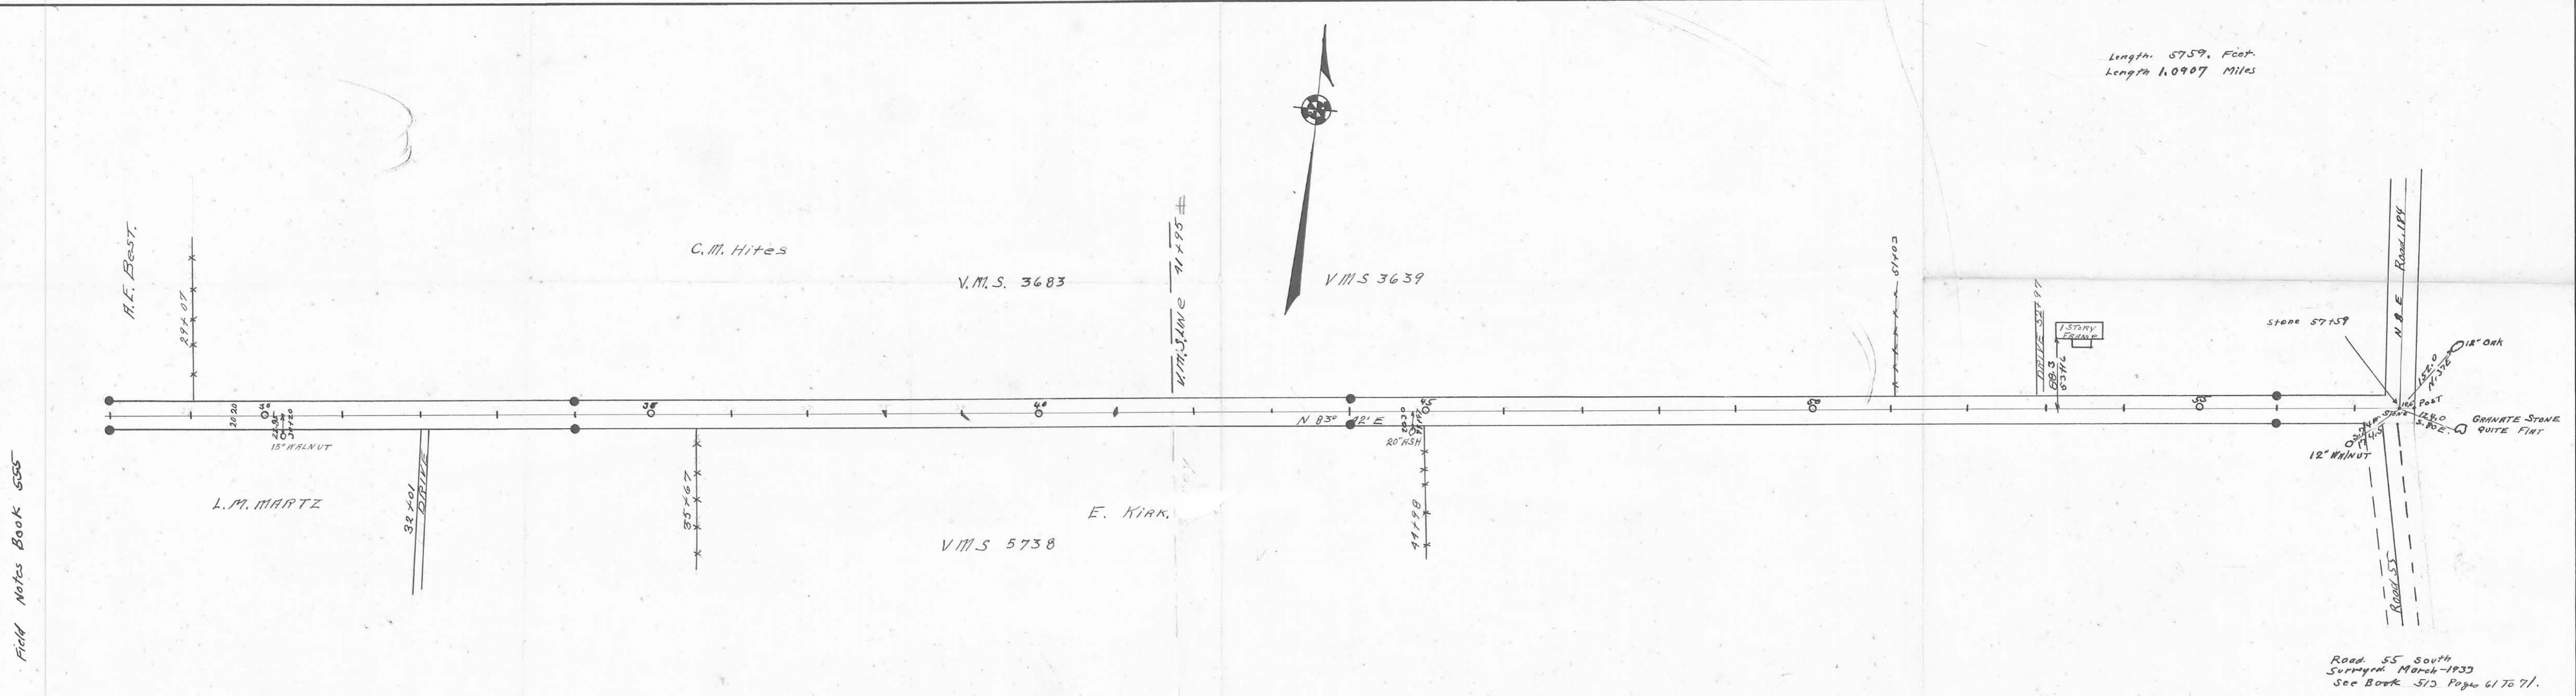

Road 55 South
Surveyed March 1932
See Book 513 Pages 61 to 71.

Field Notes Book 555

J.A.M.
1932

X-55C