

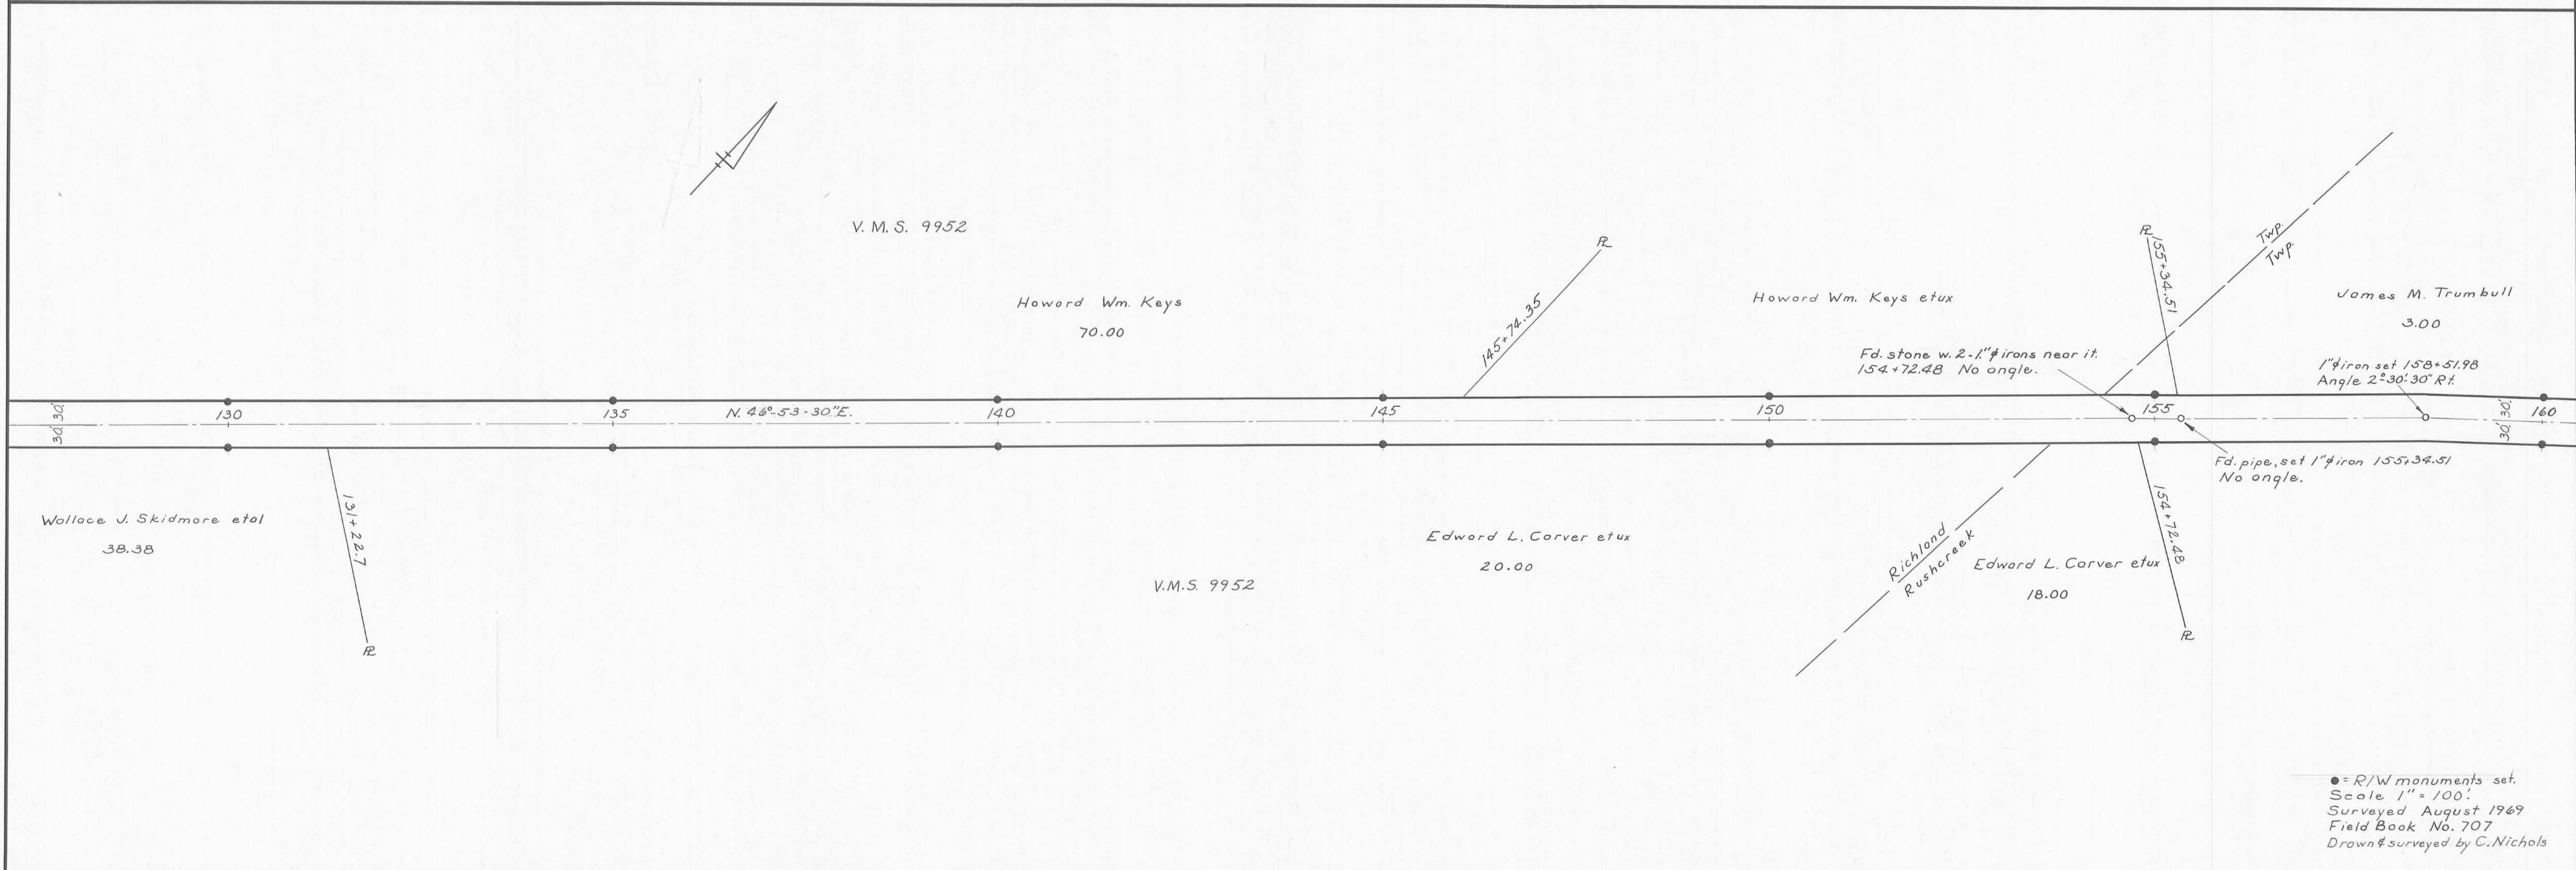
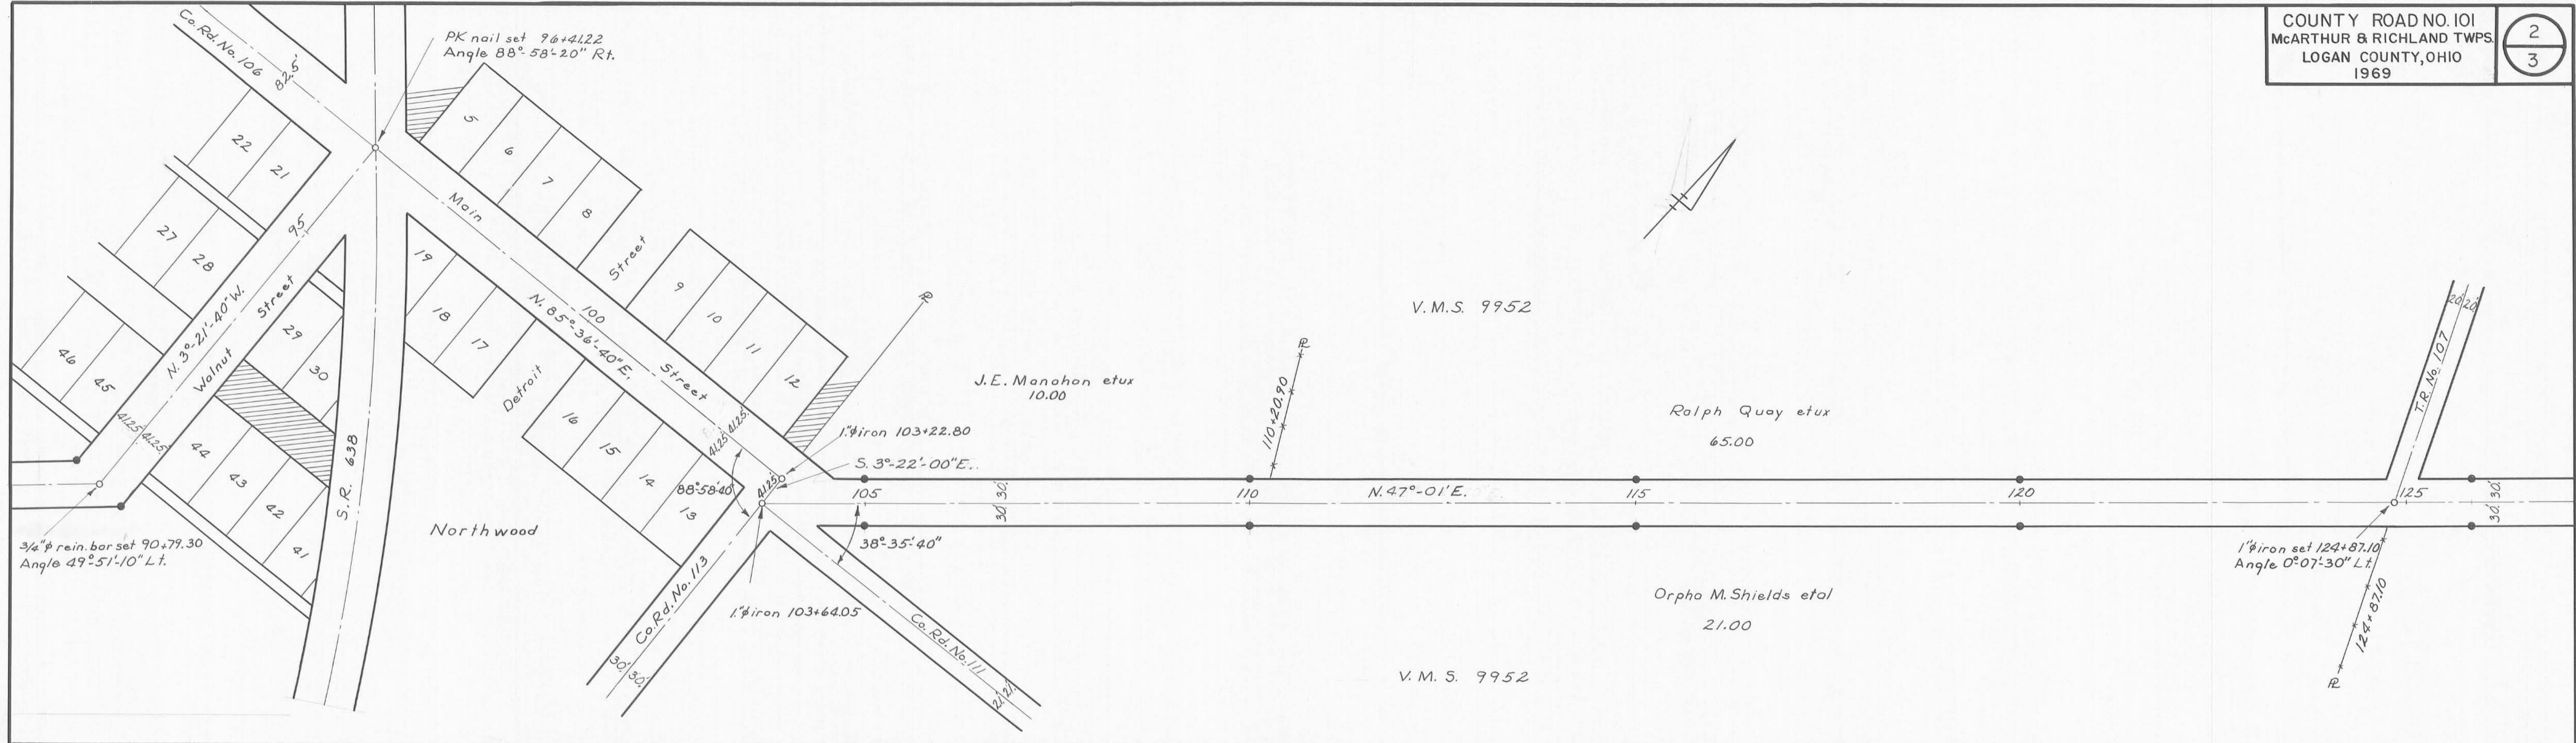


60' Right of way.
 1830 Commissioners Journal 2, page 102.
 82.5' Right of way.
 1832 Plat B. Volume 2, page 41.
 44' Right of way.
 1880 Free Turnpike Record 5, page 352.

• = R/W monuments set.
 Scale 1" = 100'.
 Surveyed August 1969
 Field Book No. 707
 Drawn & surveyed by C. Nichols

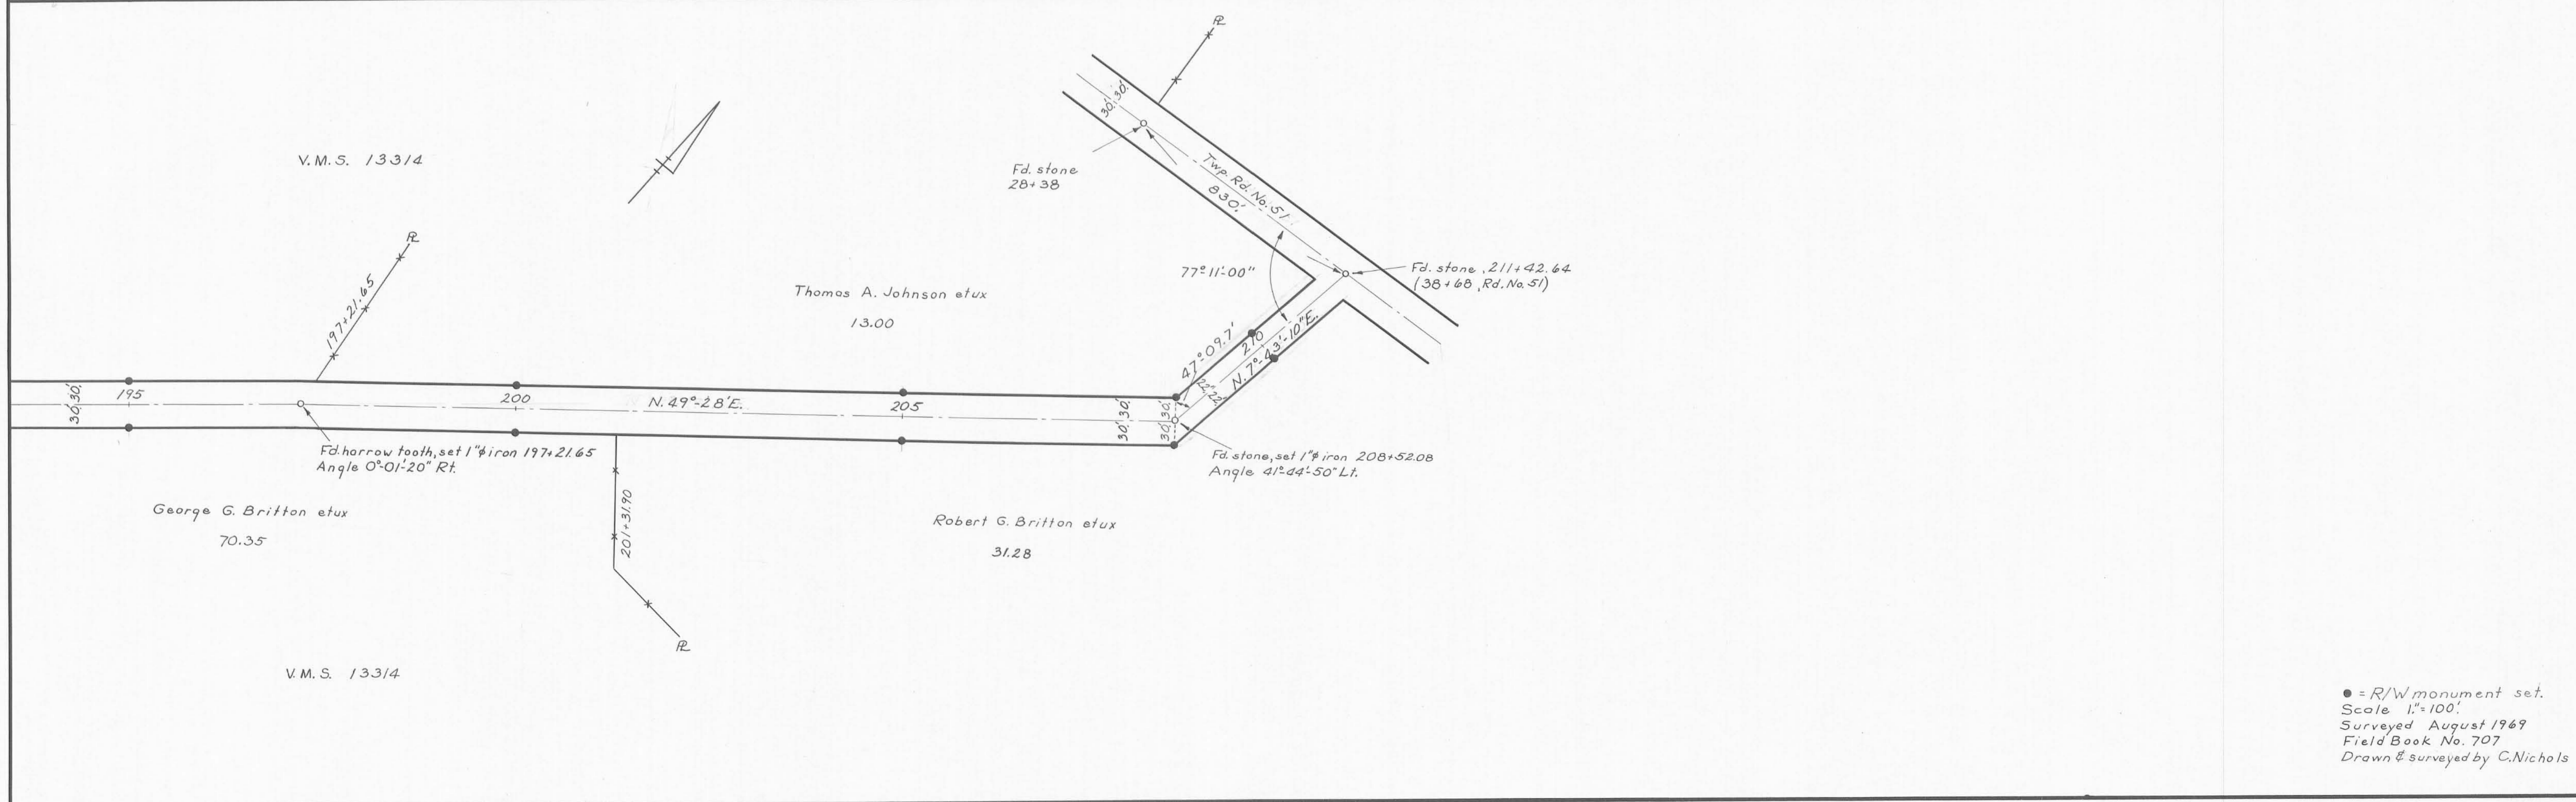

● = R/W monuments set
 Scale 1" = 100'
 Surveyed August 1969
 Field Book No. 707
 Drawn & surveyed by C. Nichols

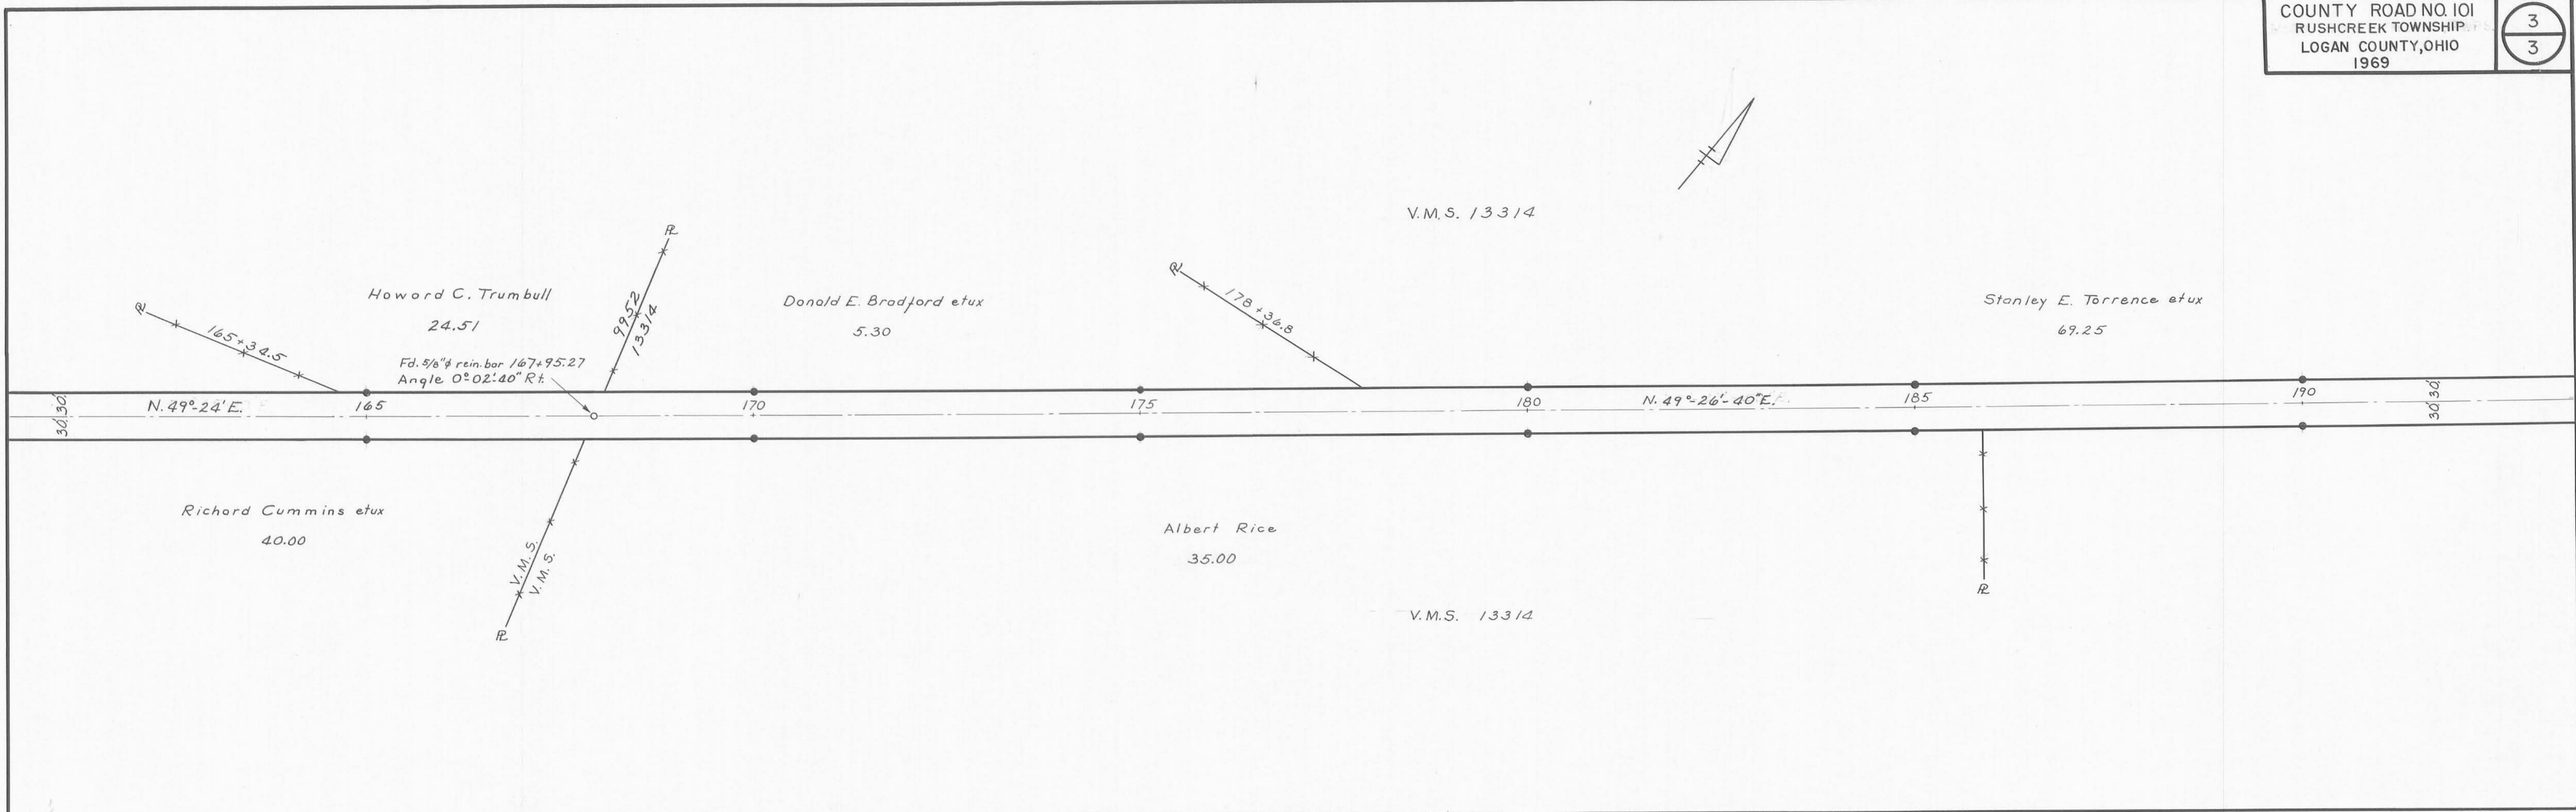

● = R/W monument set.
 Scale 1"=100'
 Surveyed August 1969
 Field Book No. 707
 Drawn & surveyed by C. Nichols