


BELLECENTER



Survey Notes in Logan County  
 Surveyor's Book No. 320 Pages 29 to 31  
 40' road see Road Record No. 1 Page 160

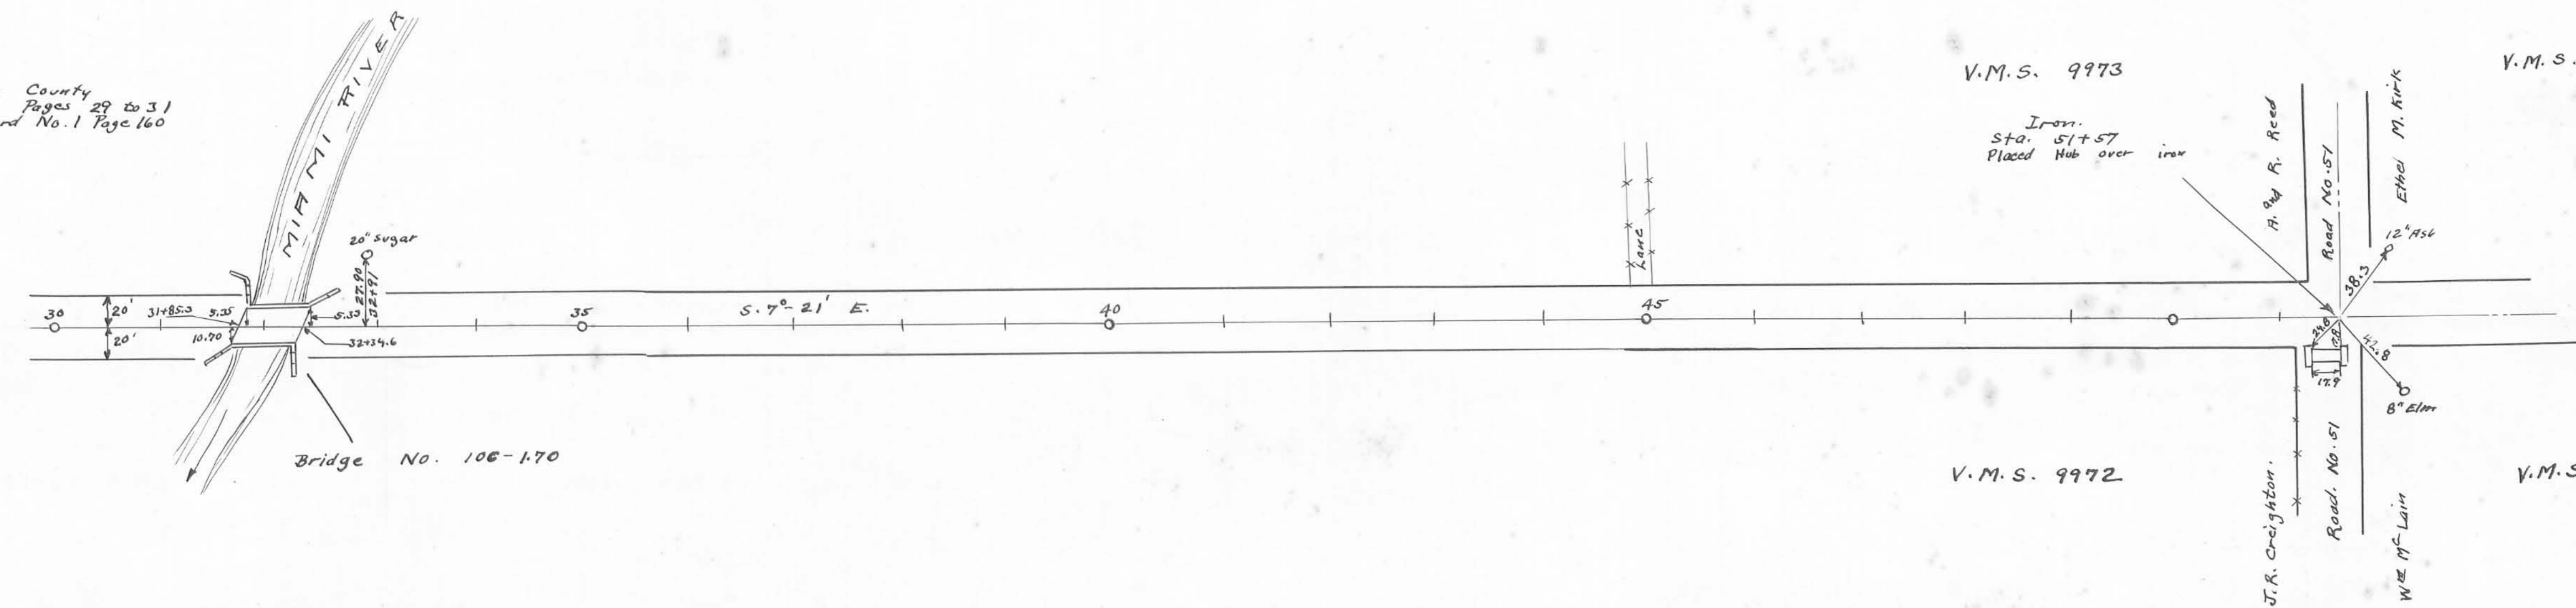

Length 5157 Feet  
 Length .9767 Miles

Drawn by  
 H.P. ...