



INDEXED ON MAP

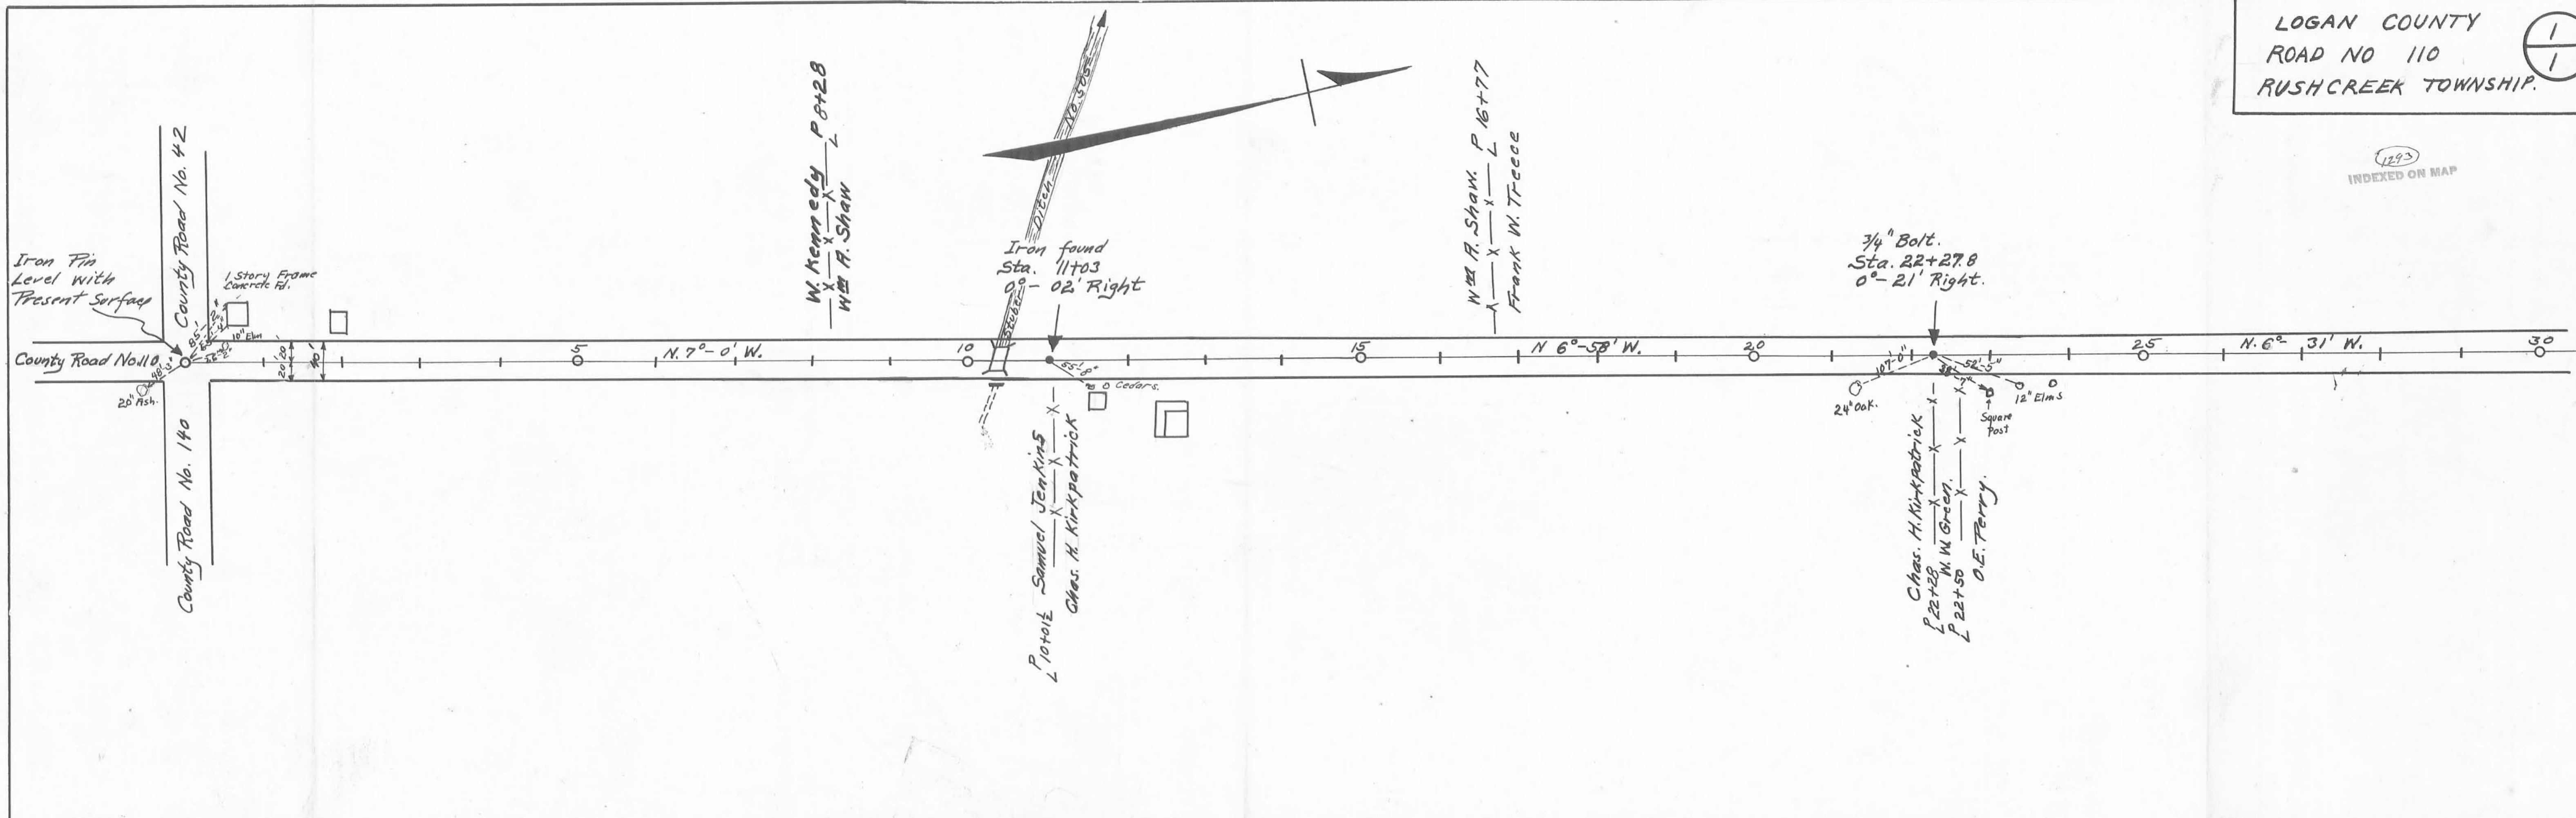

Field Notes in Logan County  
Surveyor's Book 552 Page 28-29 & 30  
Surveyed April 8, 1931.

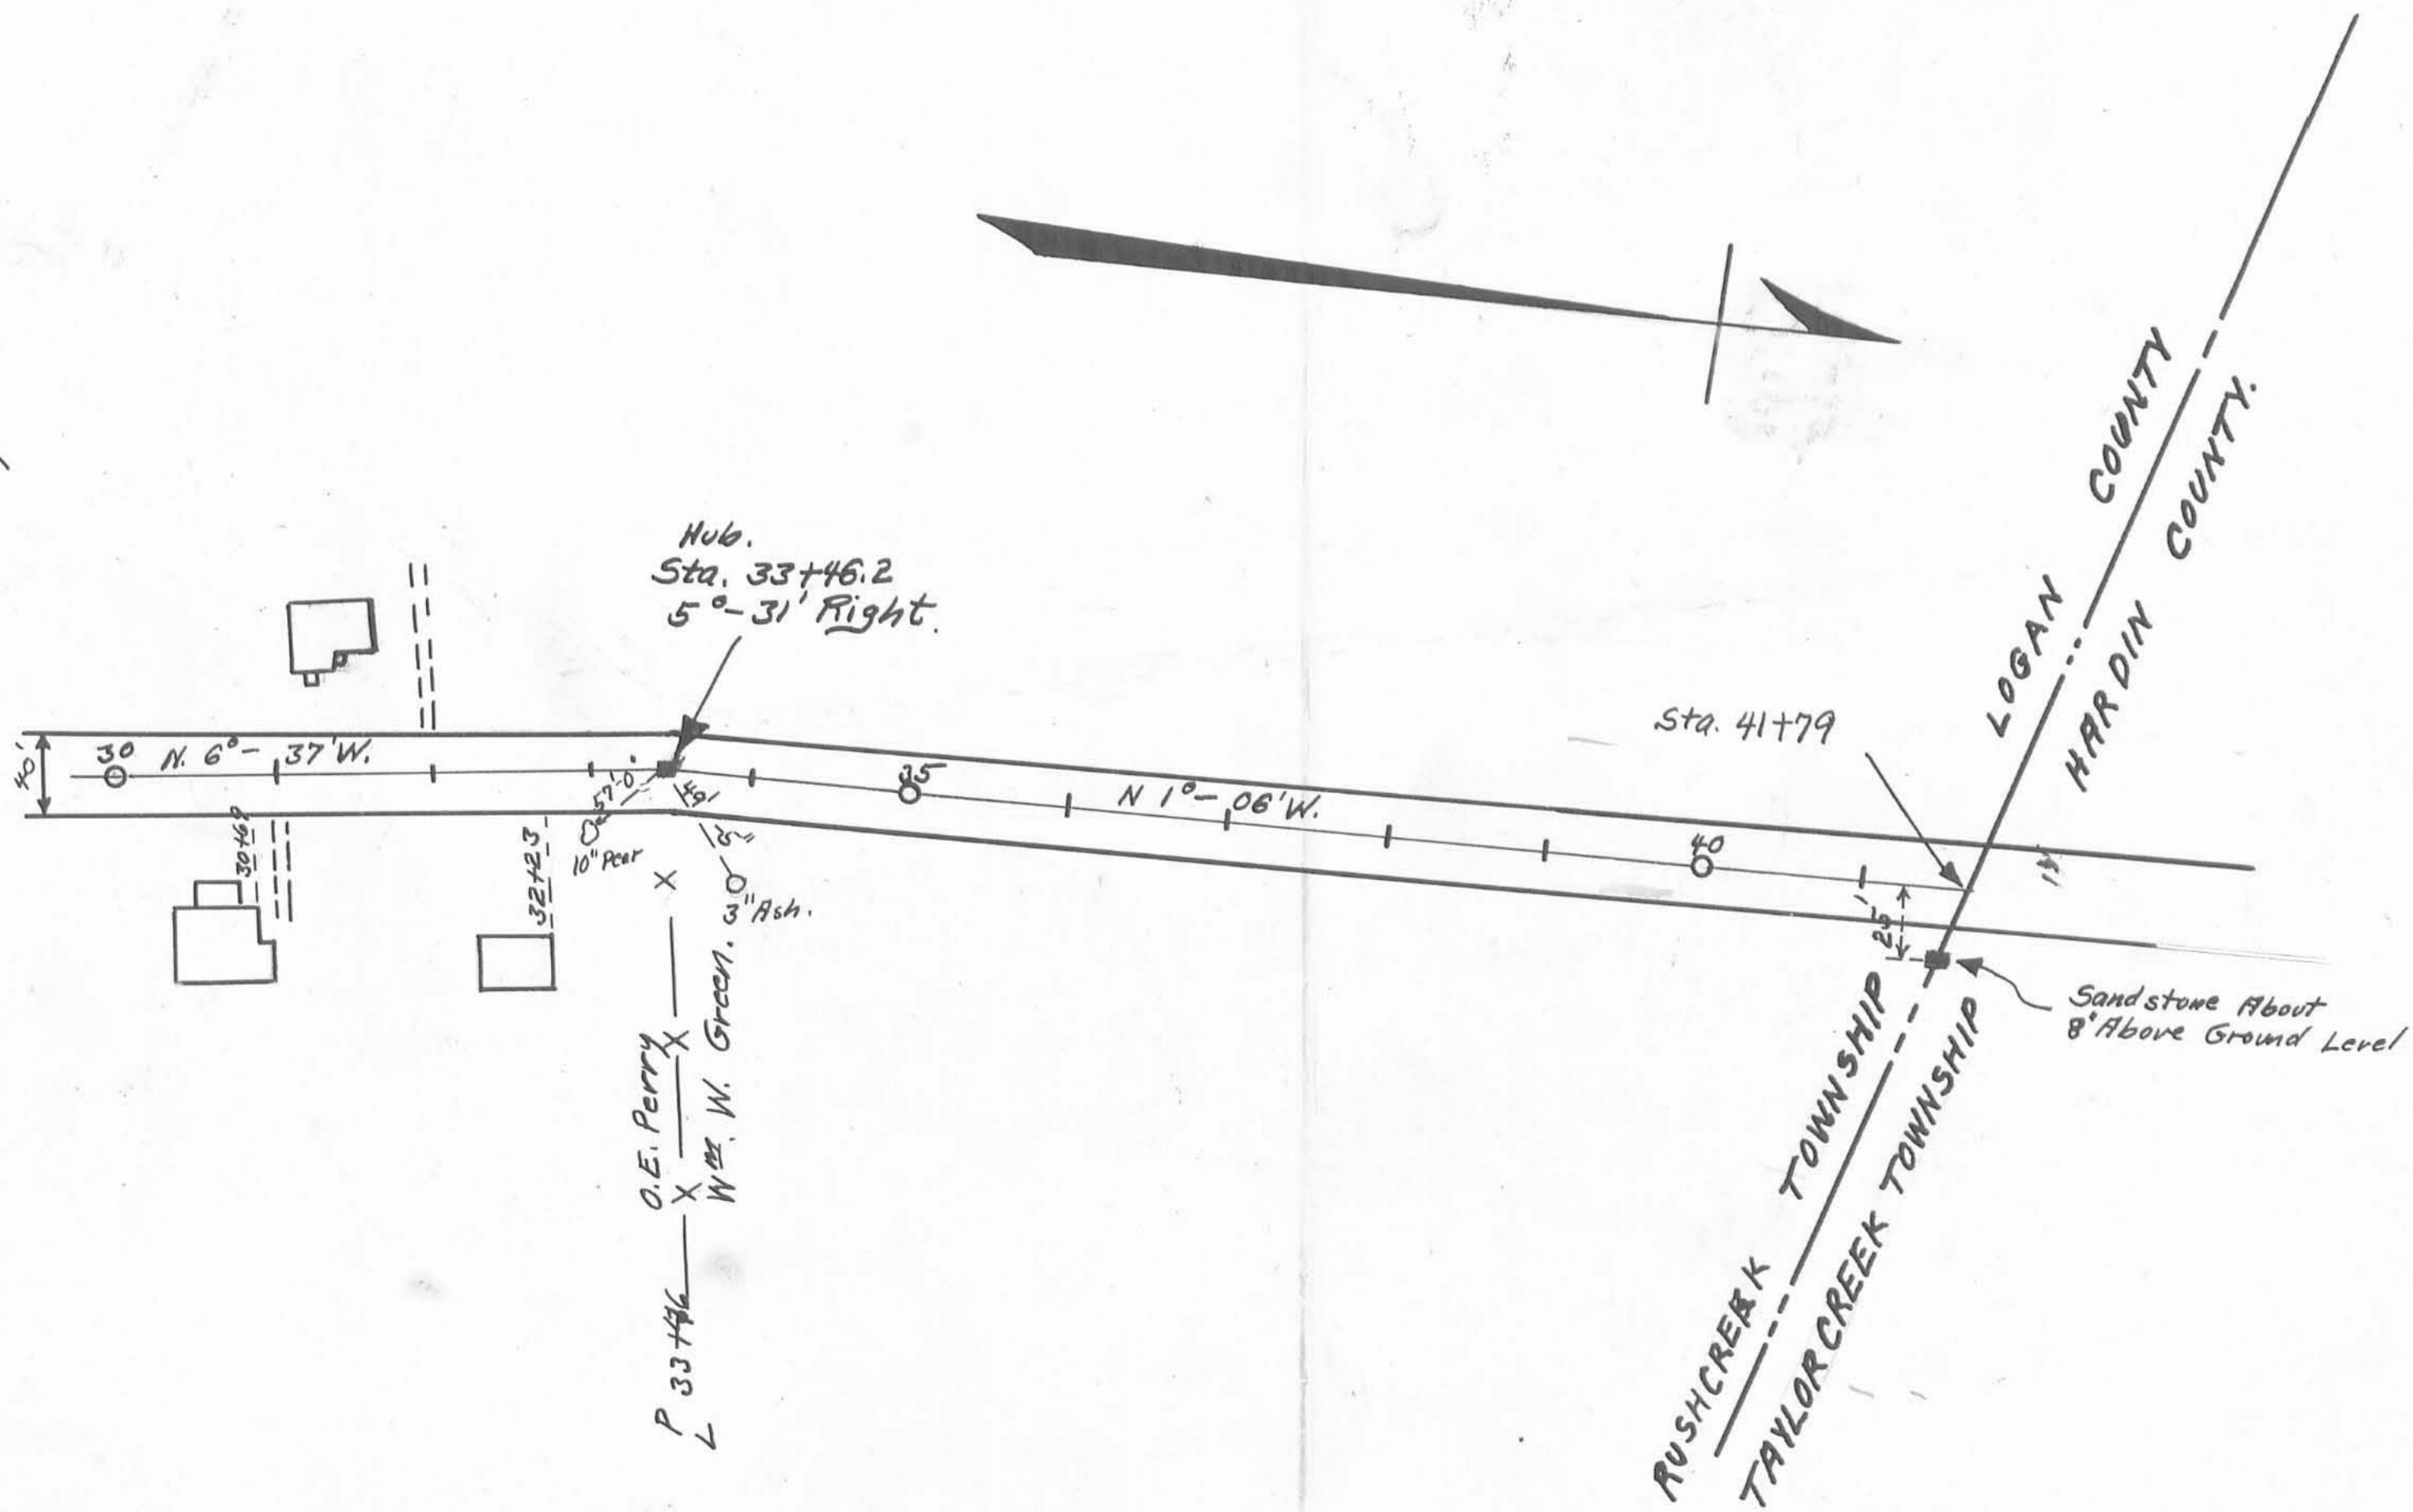

Distance  
4179 Feet  
0.791 Mile