

Recorder

BLOOMFIELD

TOWNSHIP

1942

H.E.Dyser

microfilmed 1958

BLOOMFIELD TOWNSHIP  
INDEX

INDEX PAGE A

SECTION	TOWN	RANGE	PAGE
---------	------	-------	------

12		7	7	1
13		7	7	8
24		7	7	9
25		7	7	16
26		7	7	17
7		7	8	1
8		7	8	2
9		7	8	3
10		7	8	4
11		7	8	4
14		7	8	5
15		7	8	5
16		7	8	6
17		7	8	7
18		7	8	8
19		7	8	9
20		7	8	10
21		7	8	11
22		7	8	12
27		7	8	13
NANCY STEWART	7	8		13
28		7	8	14
29		7	8	15
30		7	8	16
31		7	8	17
32		7	8	15

20		2	8	22
21		2	8	22
22		2	8	21
23		2	8	18
24		2	8	18
25		2	8	19
26		2	8	20
27		2	8	21
28		2	8	22
29		2	8	22
32		2	8	23
33		2	8	23
34		2	8	24
35		2	8	25
36		2	8	25

TOWNS SOUTH OF  
LATITUDE 41

RANGES EAST OF  
OHIO INDIANA LINE

TOWNS NORTH OF  
GREAT MIAMI RIVER

RANGES EAST OF  
OHIO INDIANA LINE

## BLOOMFIELD TOWNSHIP


## INDEX MAP

PAGE 0

ORDER OF NUMBERS

SECTION — TOWN — RANGE

SCALE 40 CHAINS TO THE INCH

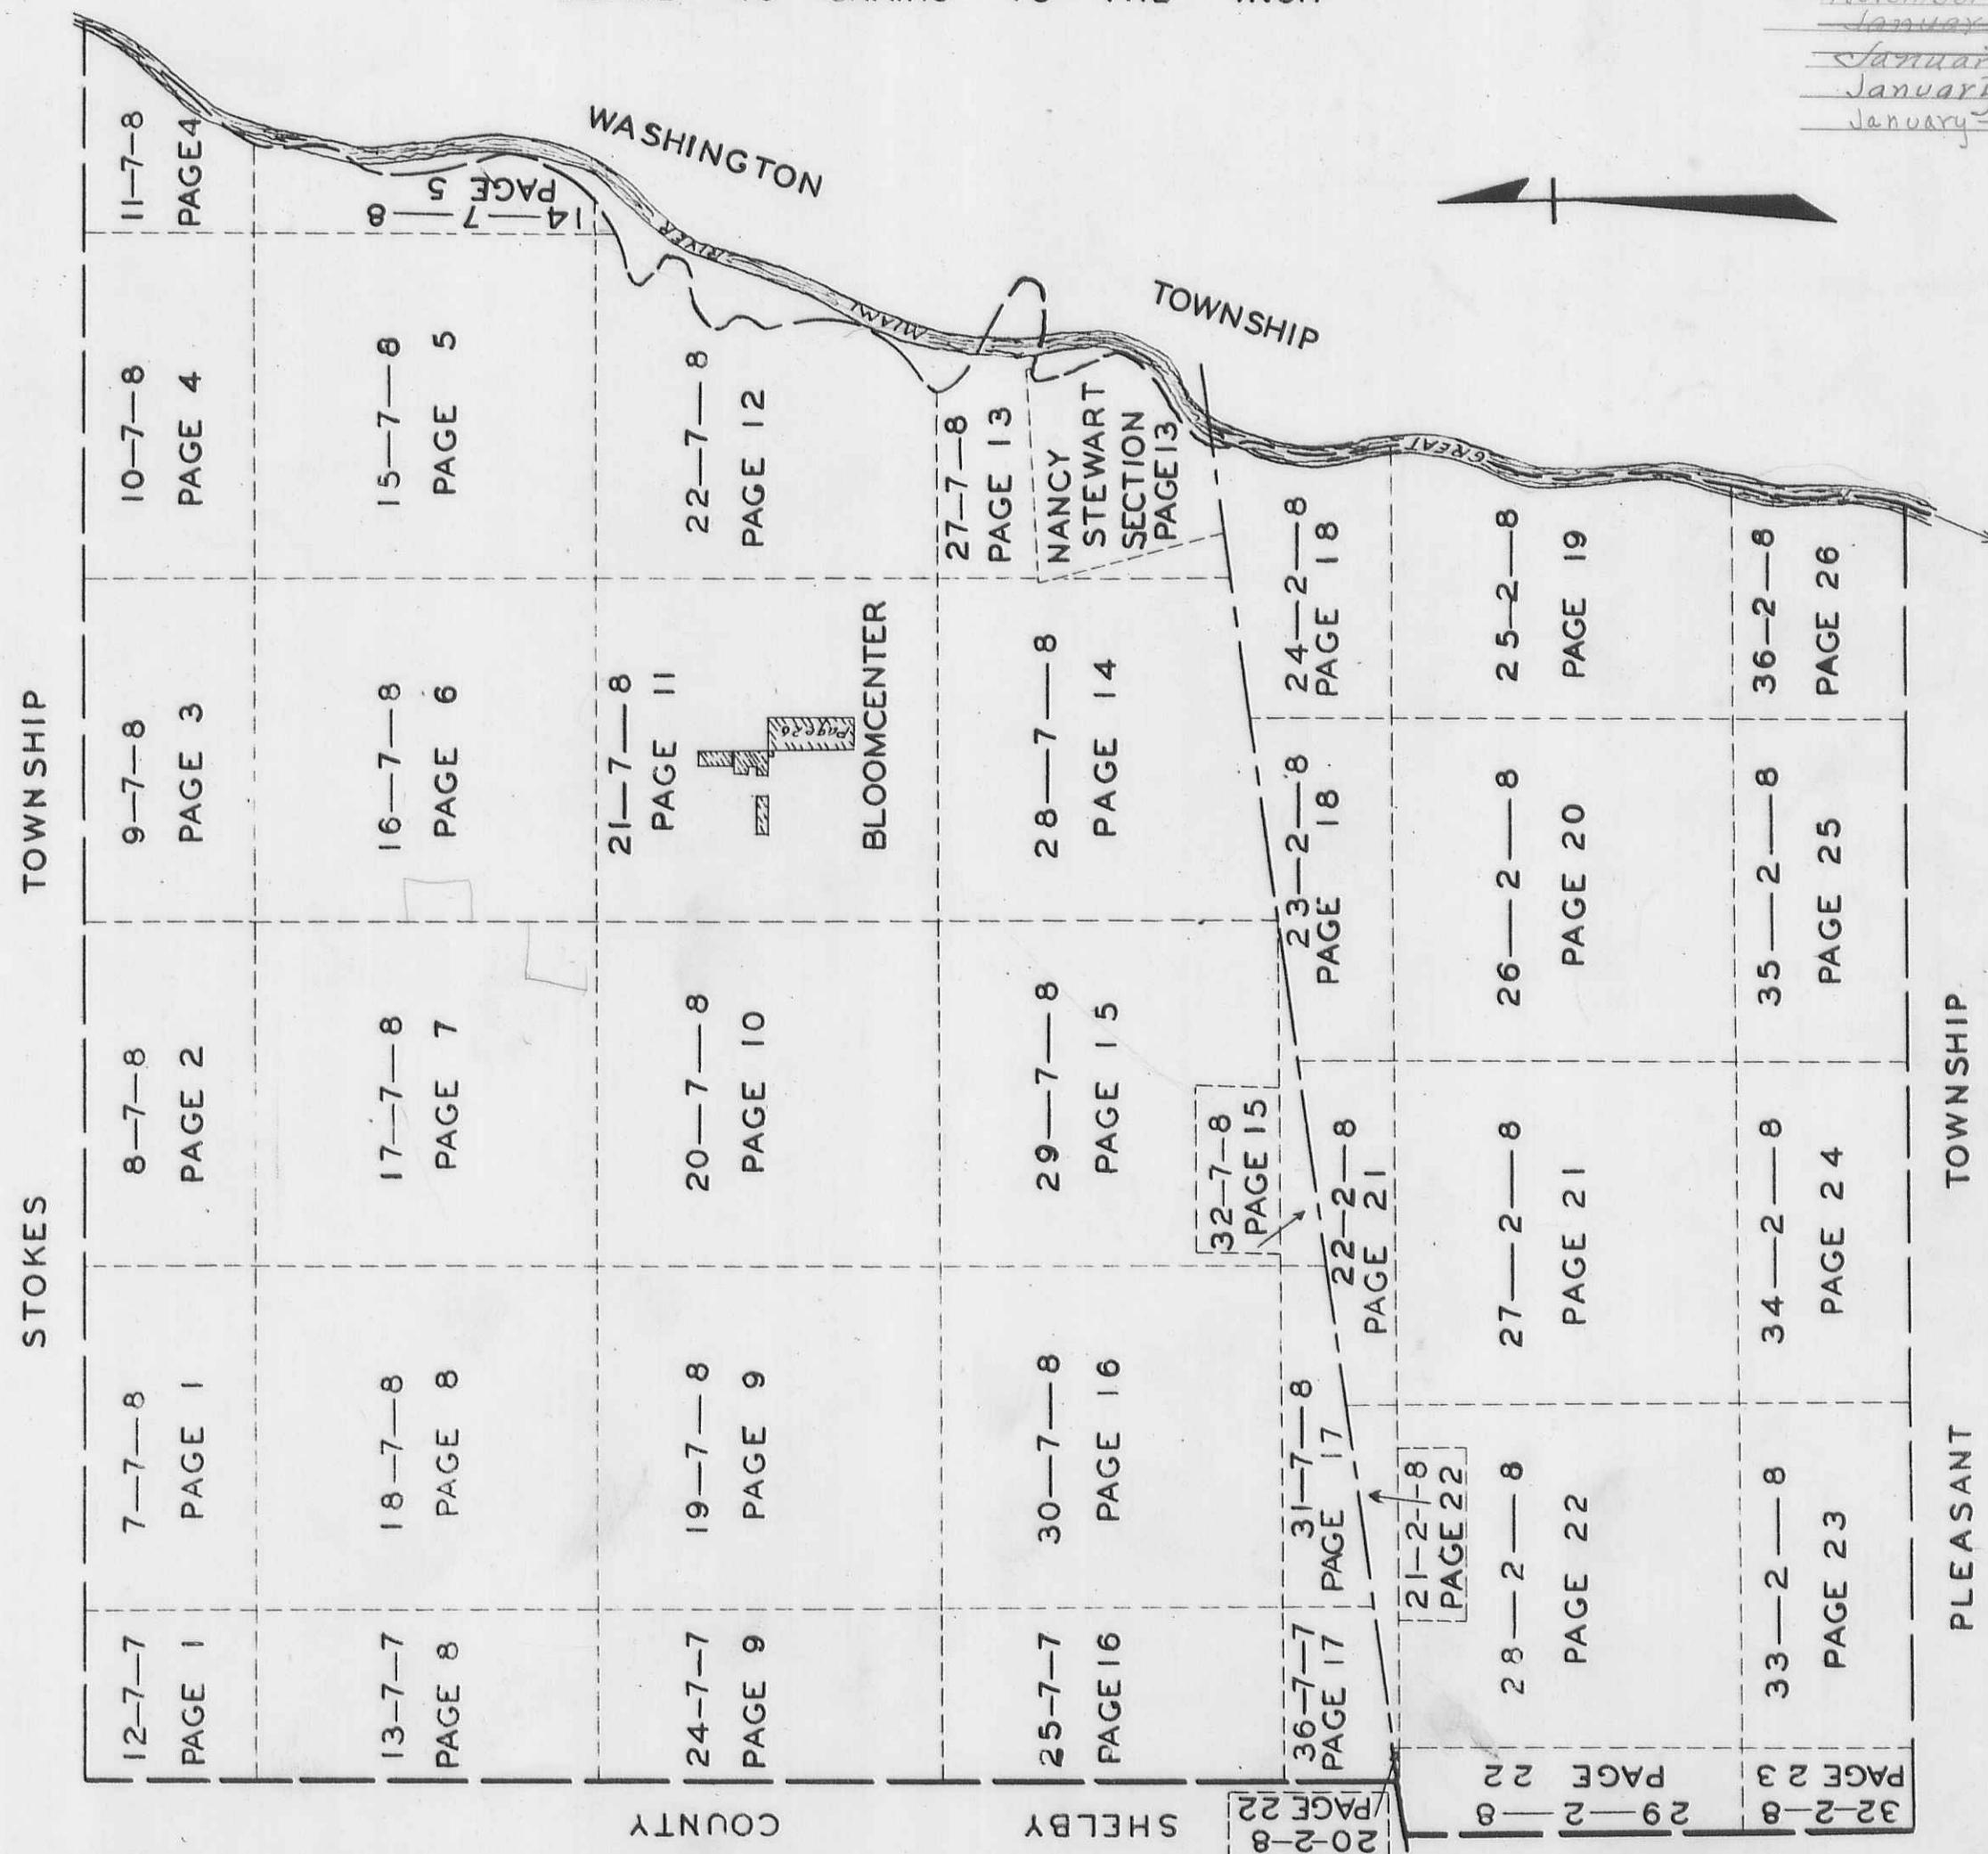
CORRECTED TO  
APRIL 12 - 1942

~~January 1 - 1940~~  
~~April 9 - 1940~~  
~~November 13, 1945~~  
~~January 1 - 1947~~  
~~January 1 - 1948~~  
~~January 1 - 1949~~  
~~January 1 - 1950~~

BLOOMFIELD TOWNSHIP  
SECTION 12 TOWN 7 S. RANGE 7 E.  
SECTION 7 TOWN 7 S. RANGE 8 E.

PAGE 1

SCALE 10 CHAINS TO THE INCH

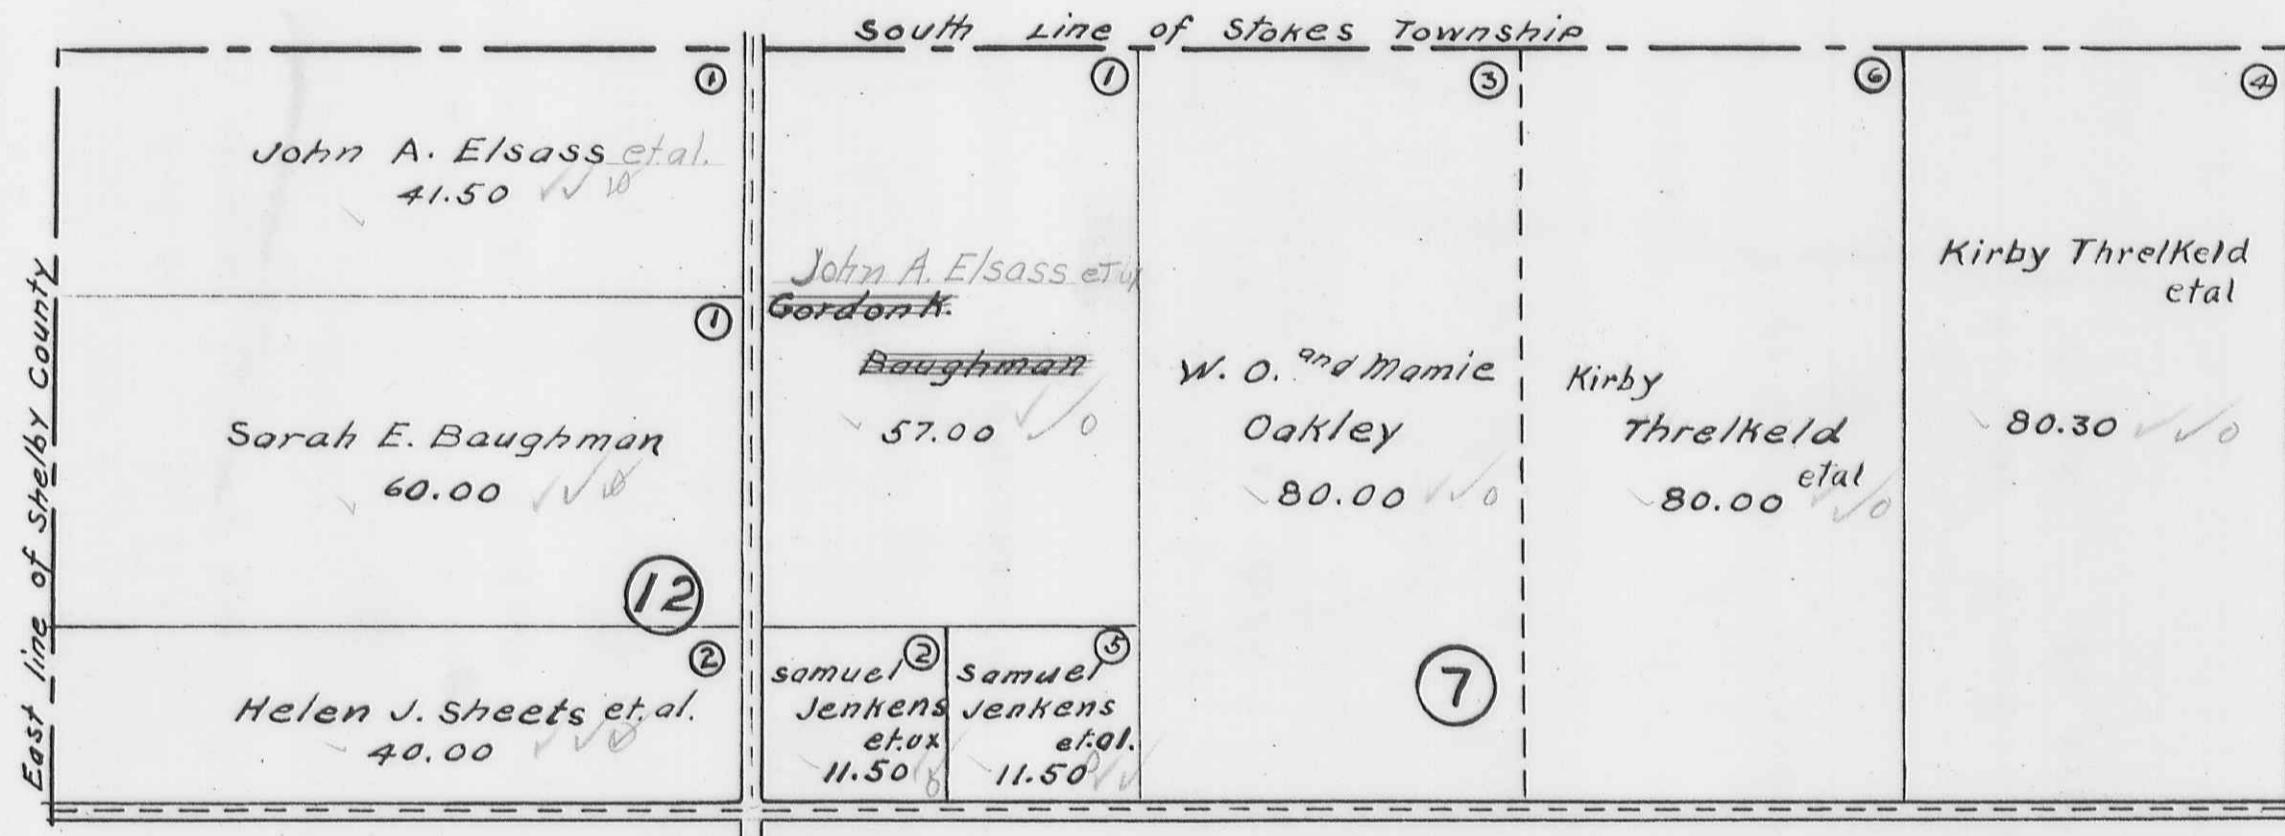

See Page 8

see page 2

BLOOMFIELD TOWNSHIP  
SECTION 8 TOWN 7 S. RANGE 8 E.

SCALE 10 CHAINS TO THE INCH


PAGE 2

South Line of Stokes Township		
(1)	(2)	(3)
Charles Brand 160.00 ✓ 0	Harold E. Bertha S. wright 80.00 ✓ 0	See Hand class W.E. Dudgeon 80.00 ✓ 0 A.S. Green 0
see page 1		see page 3
	See Page 7	

BLOOMFIELD TOWNSHIP  
SECTION 9 TOWN 7 S. RANGE 8 E.


SCALE 10 CHAINS TO THE INCH

PAGE 3

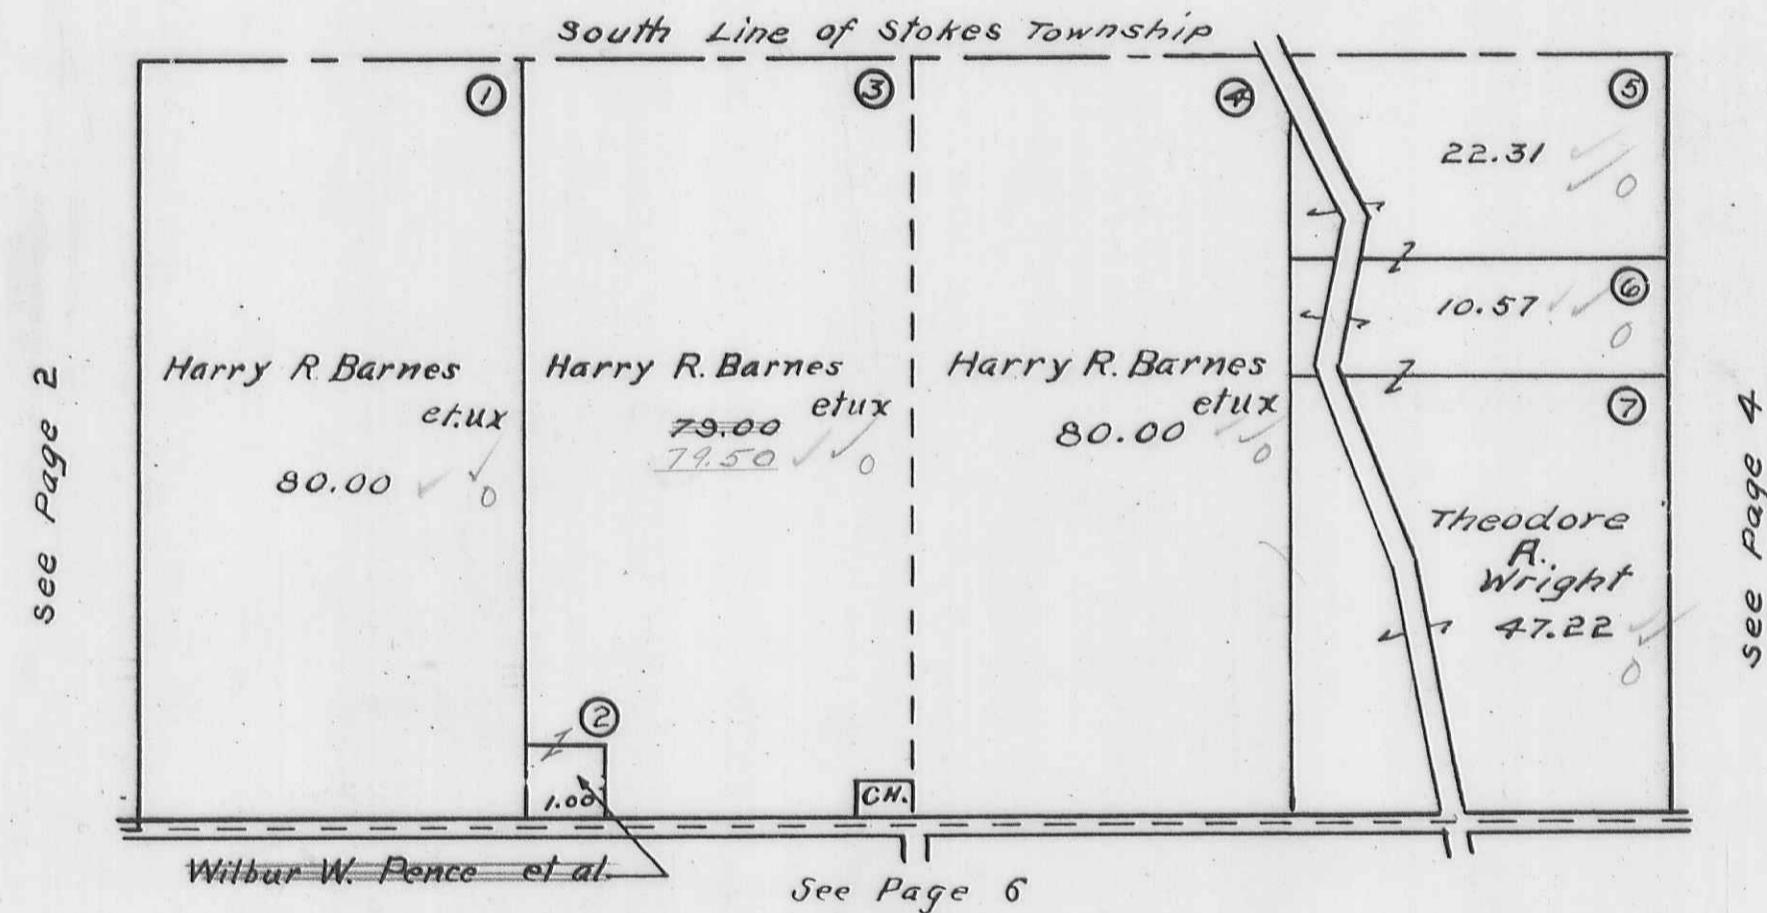

BLOOMFIELD TOWNSHP  
 SECTION 10 TOWN 7 S. RANGE 8 E.  
 SECTION 11 TOWN 7 S. RANGE 8 E.  
 SCALE 10 CHAINS TO THE INCH


PAGE 4

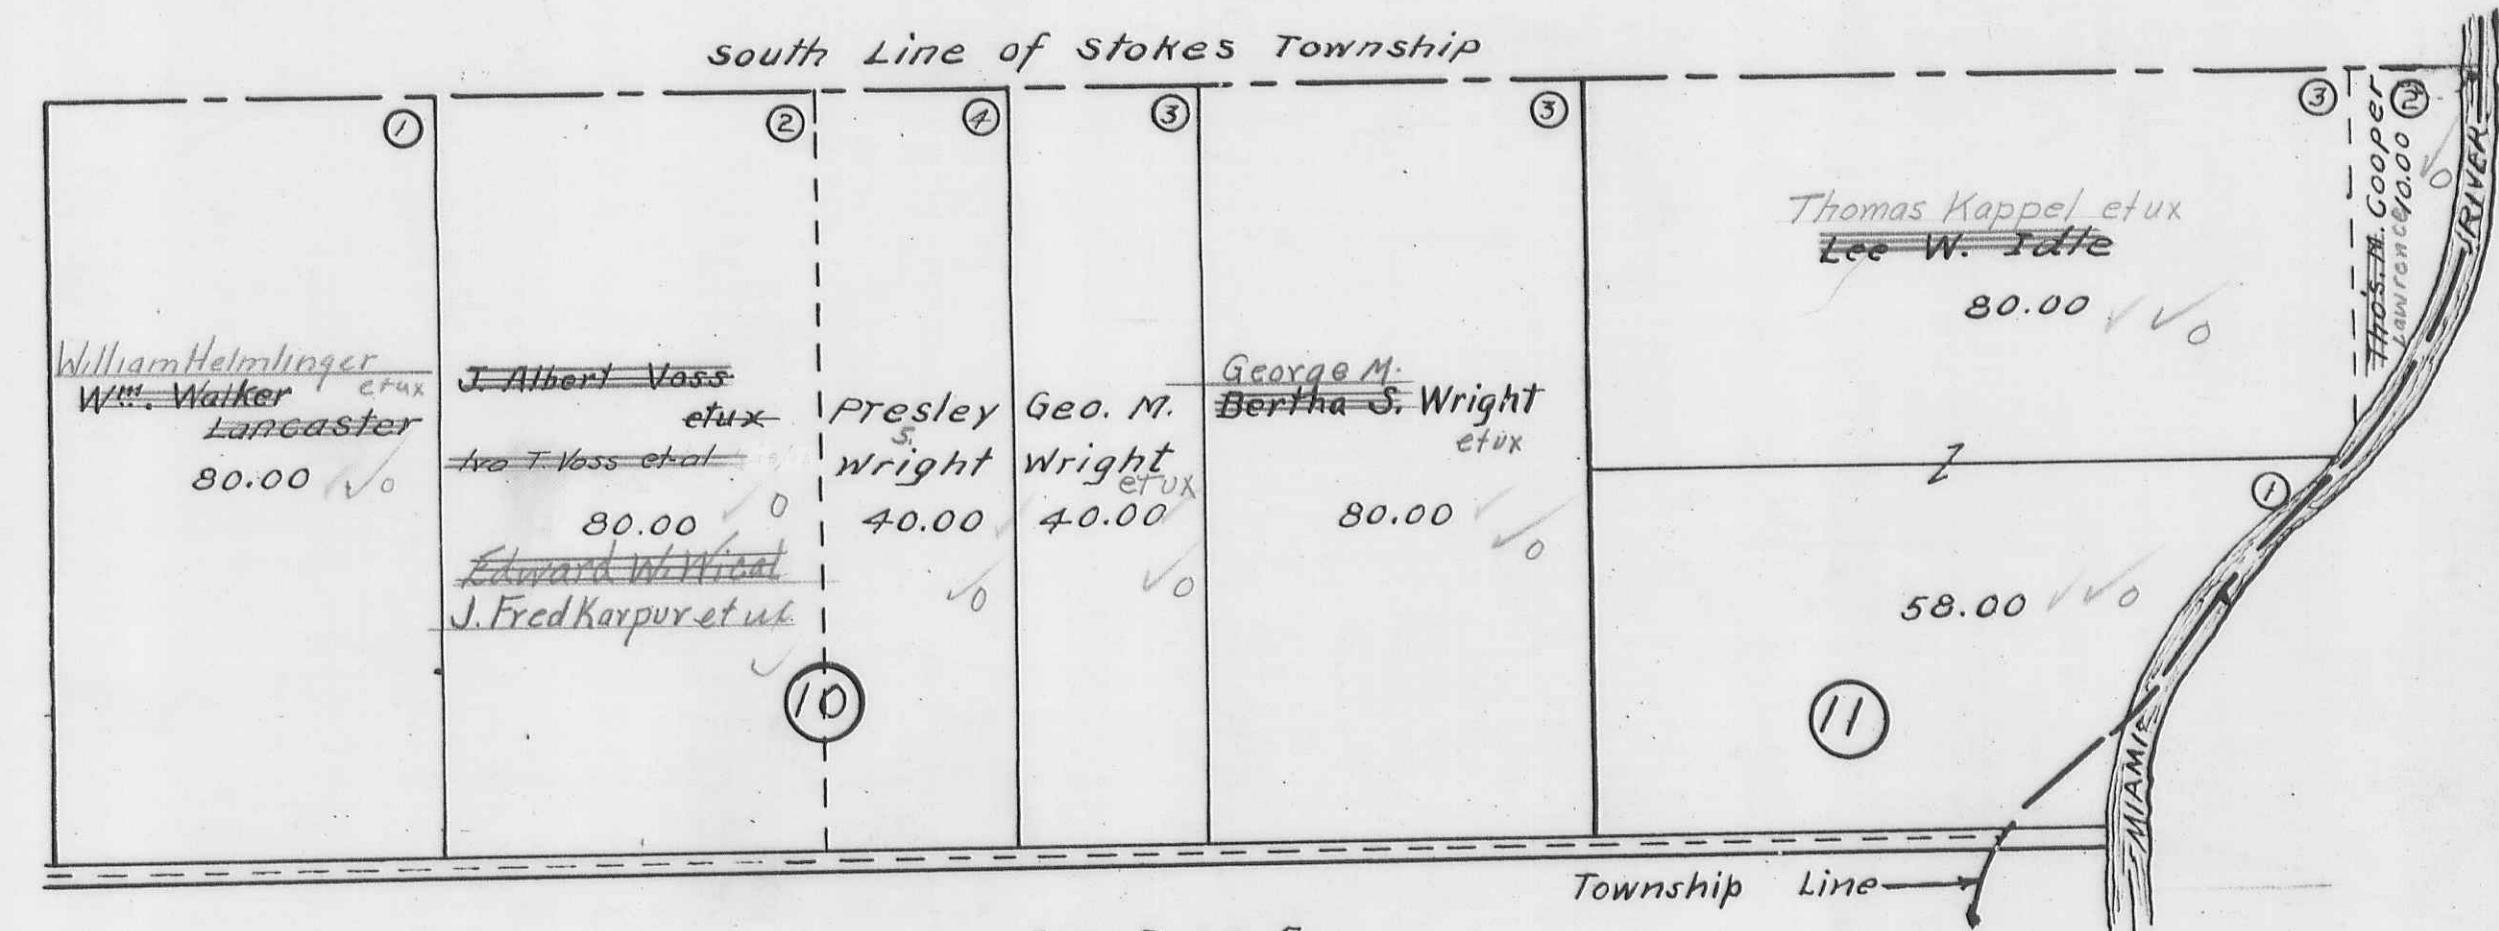

BLOOMFIELD TOWNSHIP  
 SECTION 14 TOWN 7 S. RANGE 8 E.  
 SECTION 15 TOWN 7 S. RANGE 8 E.  
 SCALE 10 CHAINS TO THE INCH

PAGE 5

See Page 4

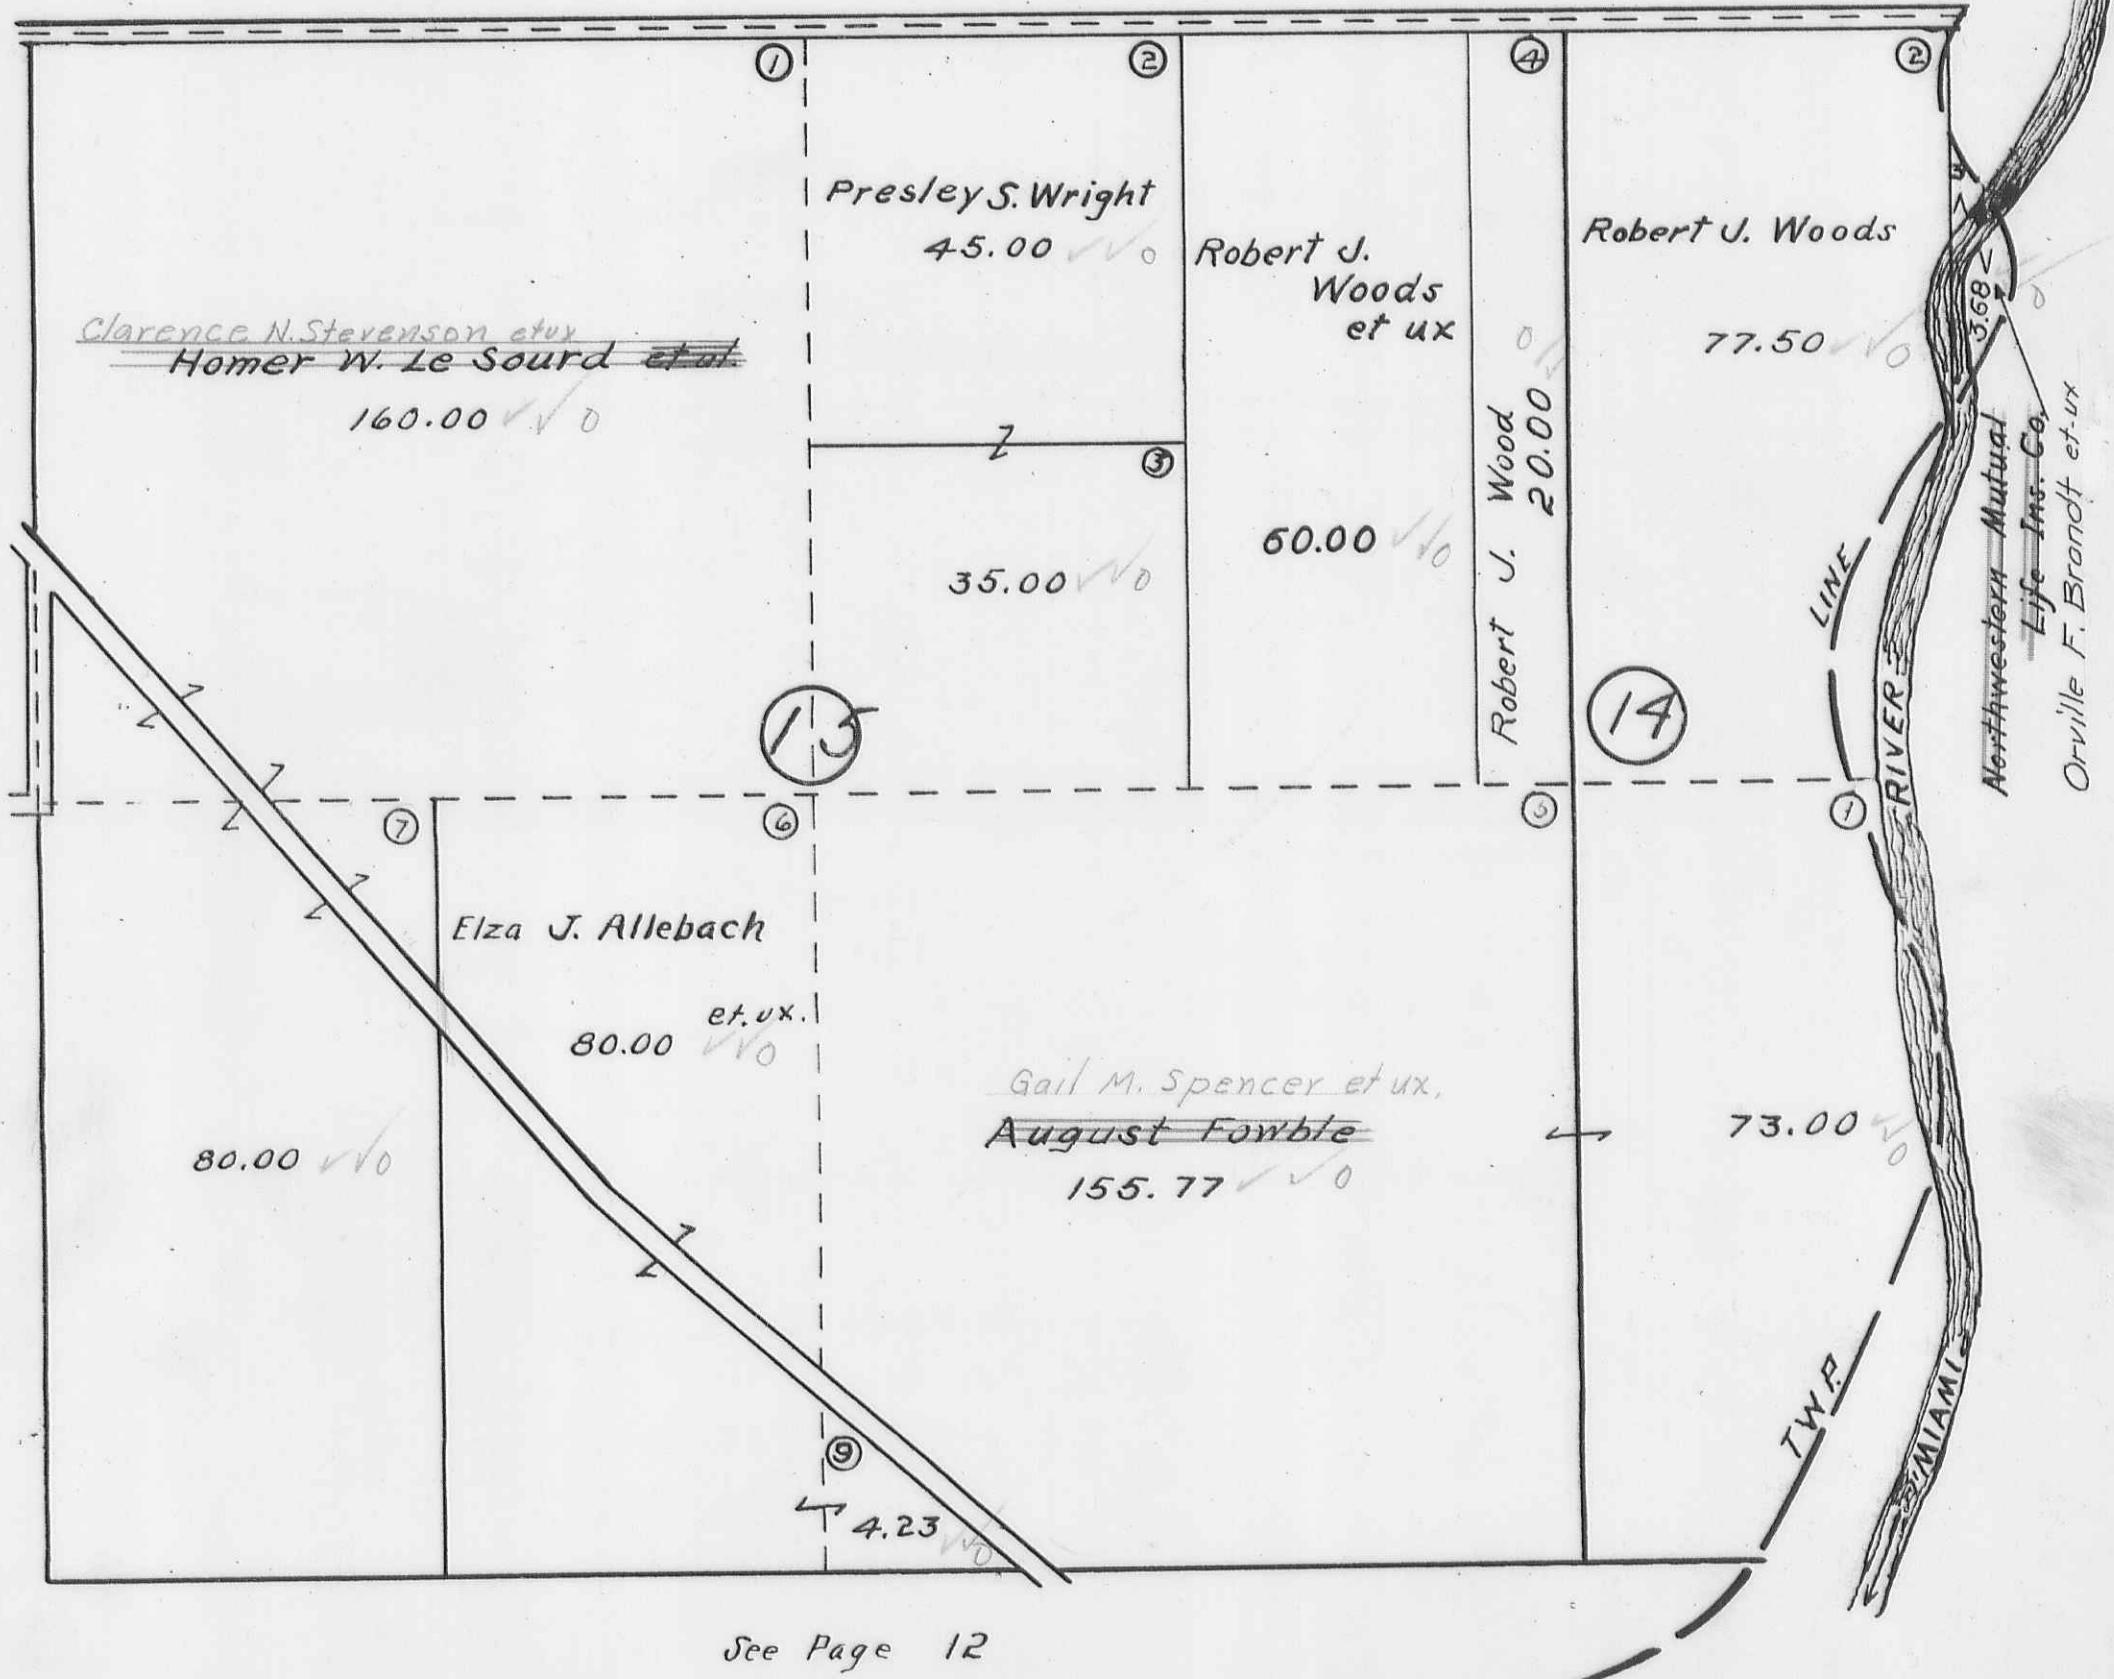

BLOOMFIELD TOWNSHIP  
SECTION 16 TOWN 7 S. RANGE 8 E.

SCALE 10 CHAINS TO THE INCH

PAGE 6

see Page 3

(1)	(2)		(4)				
Roy M. Davis et.ux 40.00 ✓ 0	Ray M. Davis etux Norman J. Wilder et ux Estella Jane Barlow 30.00 Gus B. Barlow et al		20.00 ✓ 0				
				Groce L. Ward 65.95 ✓ 0			
					Norma M. Price Clara Edith Hodge 55.20 ✓ et al		
(14)	(13)	(10)	(7)	(7)	(7)	(7)	
Harriet A. Scrimshaw Aiven U. smith 20.00 0	Phillip L. Bennoront 40.00 Lewis E. Ward et ux ✓ 0	Chas. A. Currie et ux 20.00 ✓ 0	Lurie snapp et al. 20.00 ✓ 0	Clorence B. Snapp 20.00 ✓ 0	Orville T. Wren 20.00 ✓ 0		
Daisy Bonnie Pence 60.00 ✓ 0	Alice L. Davis 14.00 Alice S. Davis et al 2/19/43 ✓ 0						
	(11)	(9)	(8)				
	Fred T. Orville T. Wren et ux Barkett 26.00 ✓ 0	Harriett Wright 40.00 ✓ 0		40.00 ✓ 0			

See Page 7

See Page 5

See Page 11

BLOOMFIELD TOWNSHIP  
SECTION 17 TOWN 7 S. RANGE 8 E.

SCALE 10 CHAINS TO THE INCH

PAGE 7

see Page 2

10.00 ✓✓ 1	Edward Krief 40.00 ✓✓ 2	6
Chas. Brand 35.00 ✓✓ 3	40.00 ✓✓ 4	Estella U. Barlow 121.91 ✓✓ Gus B. Barlow et al Norman J. Wildermuth et ux 5
Anna Hoover 35.00 ✓✓ 6	40.00 ✓✓ 7	7
25.00 ✓✓ 8	Nellie Lenhart 40.00 ✓✓ 9	Chas. A. Wren ct. al. 40.00 ✓✓ Grover Watkins ct. al. 40.00 ✓✓ 10
Ivo A. Coover 55.00 ✓✓ 11	M. Blanche Hogan 40.00 ✓✓ 12	Harriet F. Scrimshaw Nevin U. Smith 40.00 ✓✓ 13

see Page 8

see Page 6

See Page 10


## BLOOMFIELD TOWNSHIP

PAGE 8

SECTION 13 TOWN 7 S. RANGE 7 E.  
 SECTION 18 TOWN 7 S. RANGE 8 E.

SCALE 10 CHAINS TO THE INCH

see Page 1

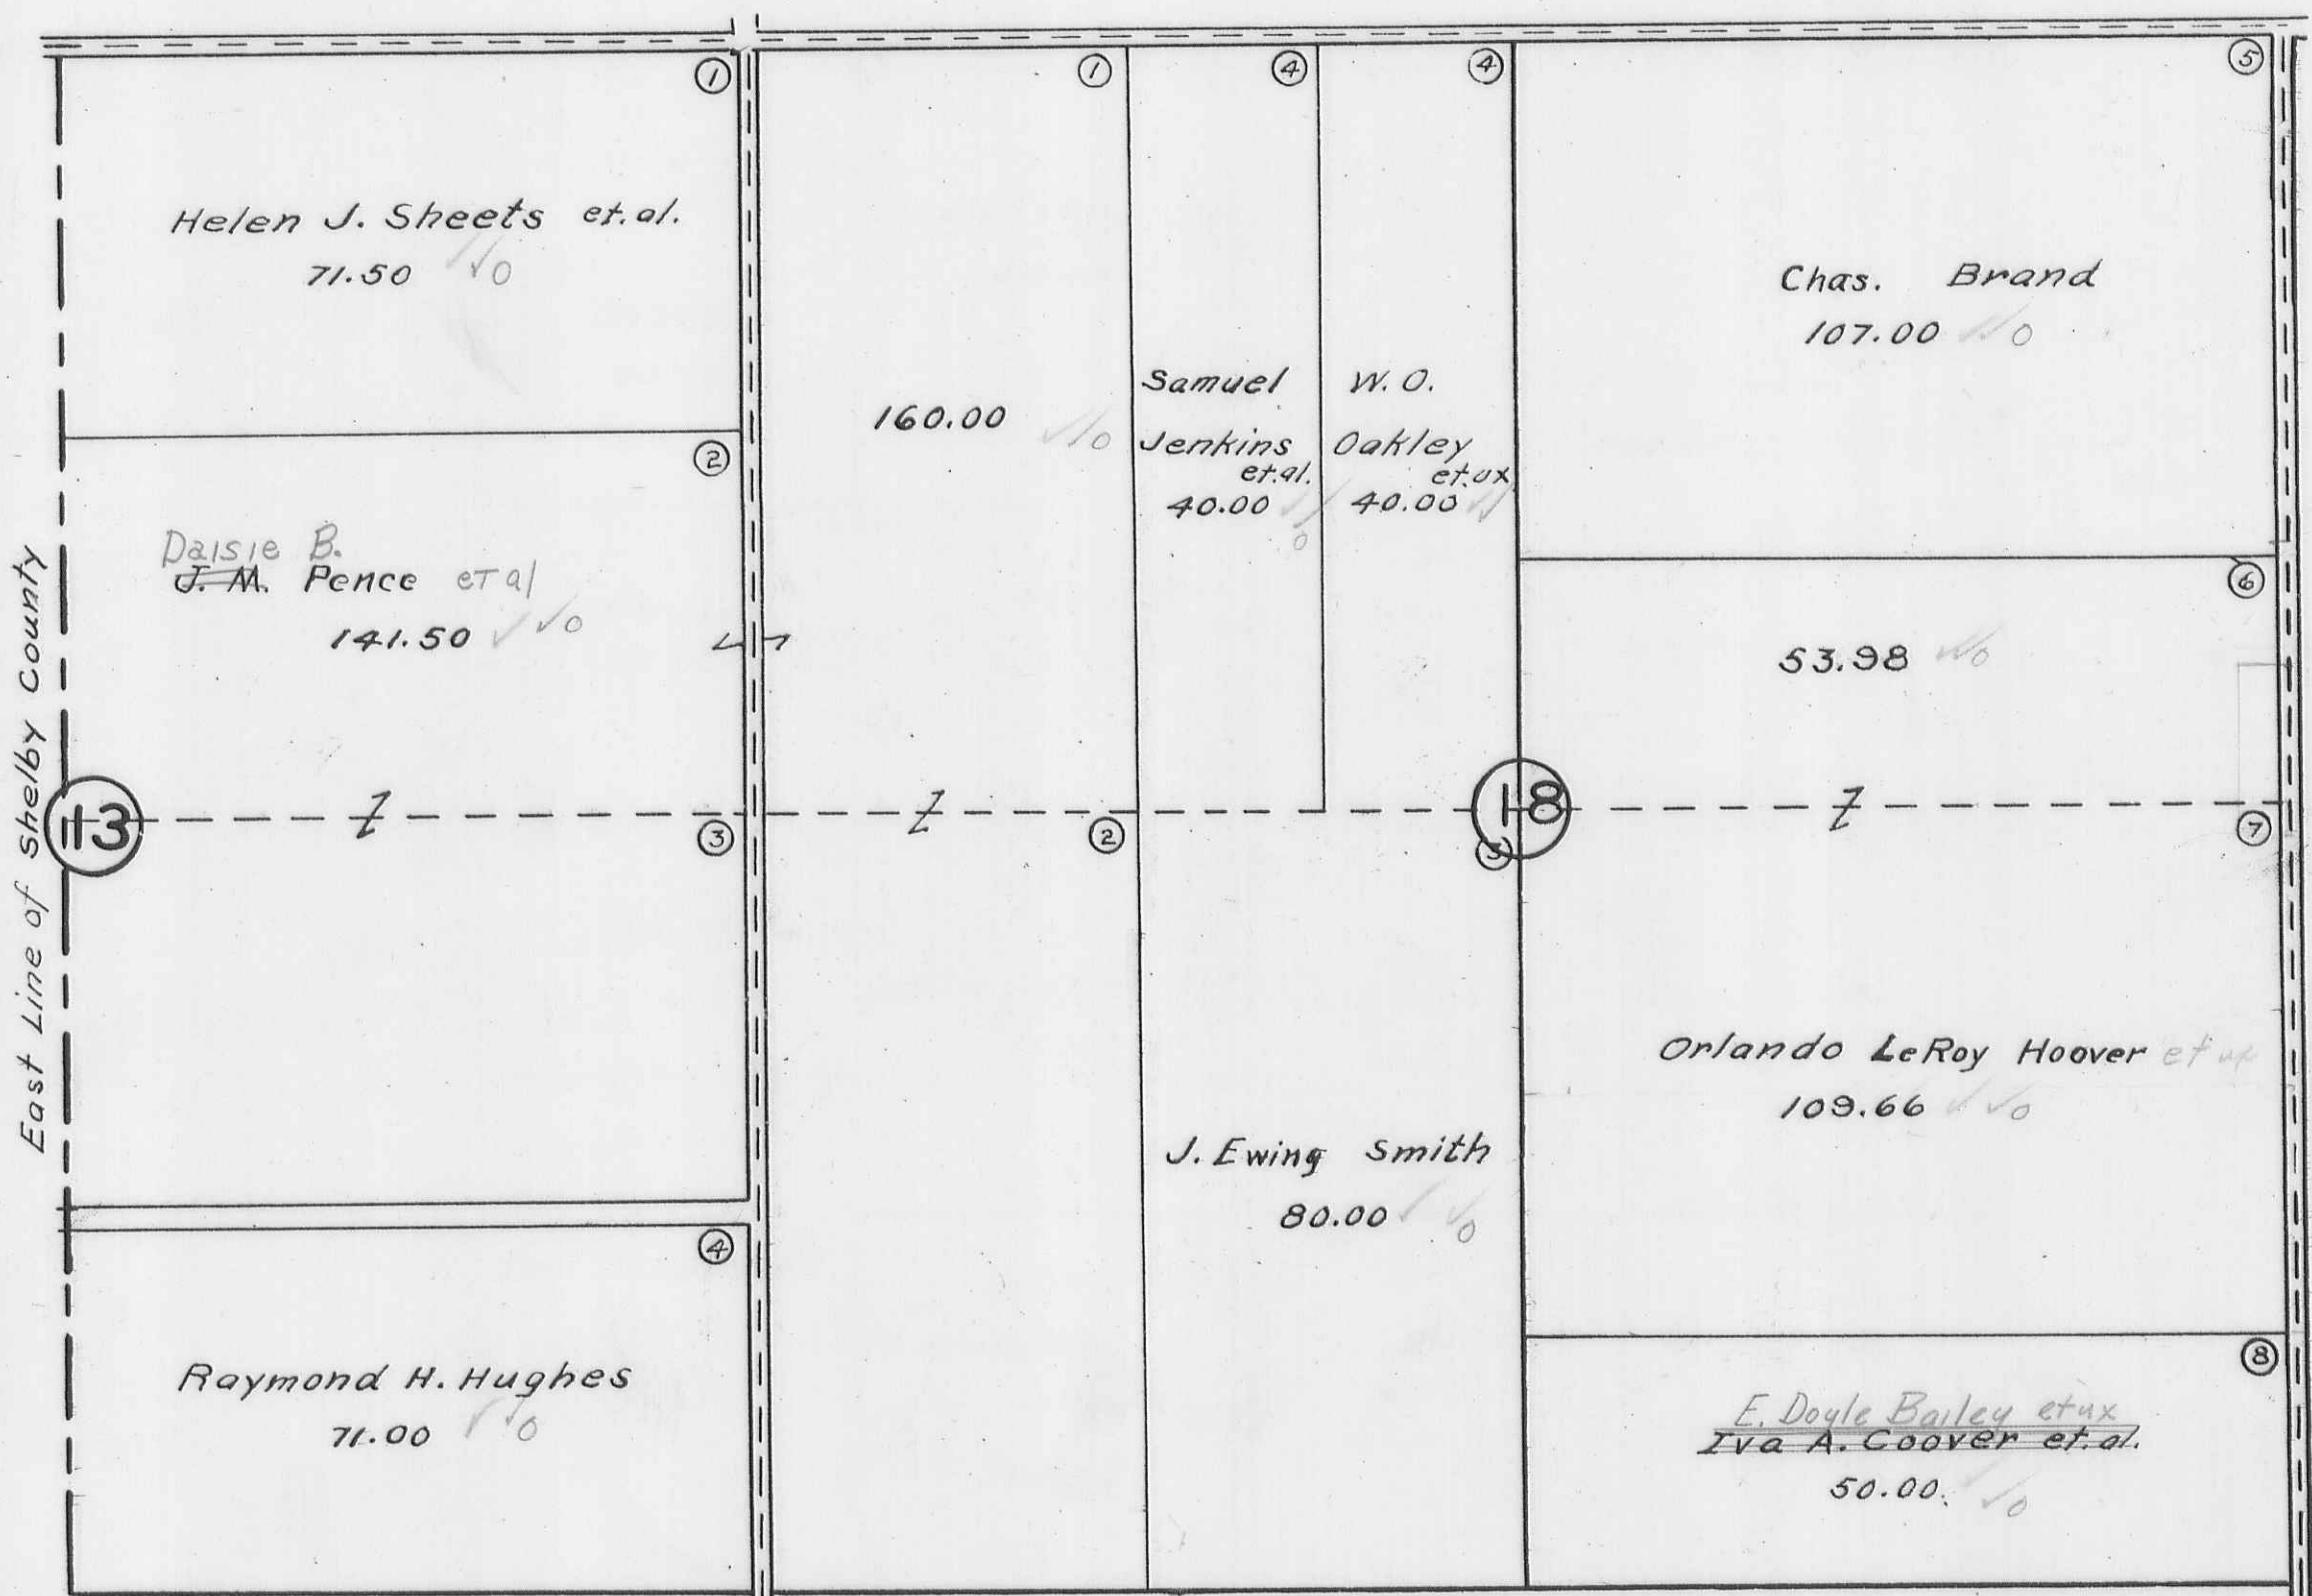

See Page 9

BLOOMFIELD TOWNSHIP  
SECTION 19 TOWN 7 S. RANGE 8 E.  
SECTION 24 TOWN 7 S. RANGE 7 E.

PAGE 9

SCALE 10 CHAINS TO THE INCH

See Page 8						
		①	②	③	④	⑤
Shelby County						
24	Raymond H. Hughes 64.00 1/10 724.00	J. Ewing Smith 160.00 1/10	Ray Dalrymple 40.00 1/10	Iva A. Coover 40.00 1/10	Nelson Hoffman 80.00 1/10	
	Delmer J. Sprague et al 80.00 1/10 10.00 1/10 10.00 1/10					
East Line of	Cleo King et al Viola B. Clayton 72.00 1/10	Elizabeth Gerber 100.00 1/10	Horriet F. Scrimshaw Nevin U. Smith 50.00 1/10	Ray D. Dalrymple et al Rosella B. Garling 110.00 1/10		
	Lewis P. Metz Louisa Metz 72.50 1/10	Lewis P. & Louise Metz 40.00 1/10	Hulda Gerber et. vir. 19.88 1/10			
					See Page 16	See Page 10

BLOOMFIELD TOWNSHIP  
SECTION 20 TOWN 7 S. RANGE 8 E.

SCALE 10 CHAINS TO THE INCH

PAGE 10

see Page 7

(1)	Edward Krief 48.00 ✓0	(2)	Sarah E. Longbrake 40.00 ✓0	(3)	Herbert L. Ault etux 40.00 ✓0
EMERSON W. Gurling etux 80.00 ✓0					
Ray D. Delrymple etux 32.00 ✓0		(3)	Ray D. Delrymple 40.00 ✓0		Nannie A Wildermuth 39.00 ✓0
					Glee Arthur ✓0 Arthur Glee etux ✓0/44 2 houses 100 Longbrake
Ray D. Delrymple etux Rosetta B. Gurling 37.00 ✓0	(12)	(13)	Anna B. Gurling 40.00 ✓0	(8)	John J. Wildermuth 80.00 ✓0
Edward Krief 120.00 ✓0					
			40.00 ✓0		

see Page 9

see Page 11

See Page 15

BLOOMFIELD TOWNSHIP  
SECTION 21 TOWN 7 S. RANGE 8 E.

SCALE 10 CHAINS TO THE INCH

PAGE 11

See Page 6

		Fred T. Burkett ②	
①	Orville T. Wren etux Bonnie S. Burkett 31.50 ✓/o	.25	②
Herbert L. Ault etux	Russell Kneif 14.83 ✓/o	④	Russell Kneif etux. Ruben Guy Rex
80.00 ✓/o	12.34 ✓/o	⑤	80.00 ✓/o
7	8.57 ✓/o	⑥	80.00 ✓/o
7	See Page 26	See Page 26	
⑩	John Culver 20.00 ✓/o	Church	⑧
Ray D. Dallympic 40.00 ✓/o	Milton E. Metz etux Geo. Metz et.al 99.50 ✓/o	BLOOMCENTER See Page 26	⑨
Lewis Miller et.al	G. Harry & Olive Aiken 124.00 ✓/o		

See Page 10


See Page 12

See Page 14

BLOOMFIELD TOWNSHIP  
 SECTION 22 TOWN 7 S. RANGE 8 E.  
 SECTION 23 TOWN 7 S. RANGE 8 E.

PAGE 12


SCALE 10 CHAINS TO THE INCH

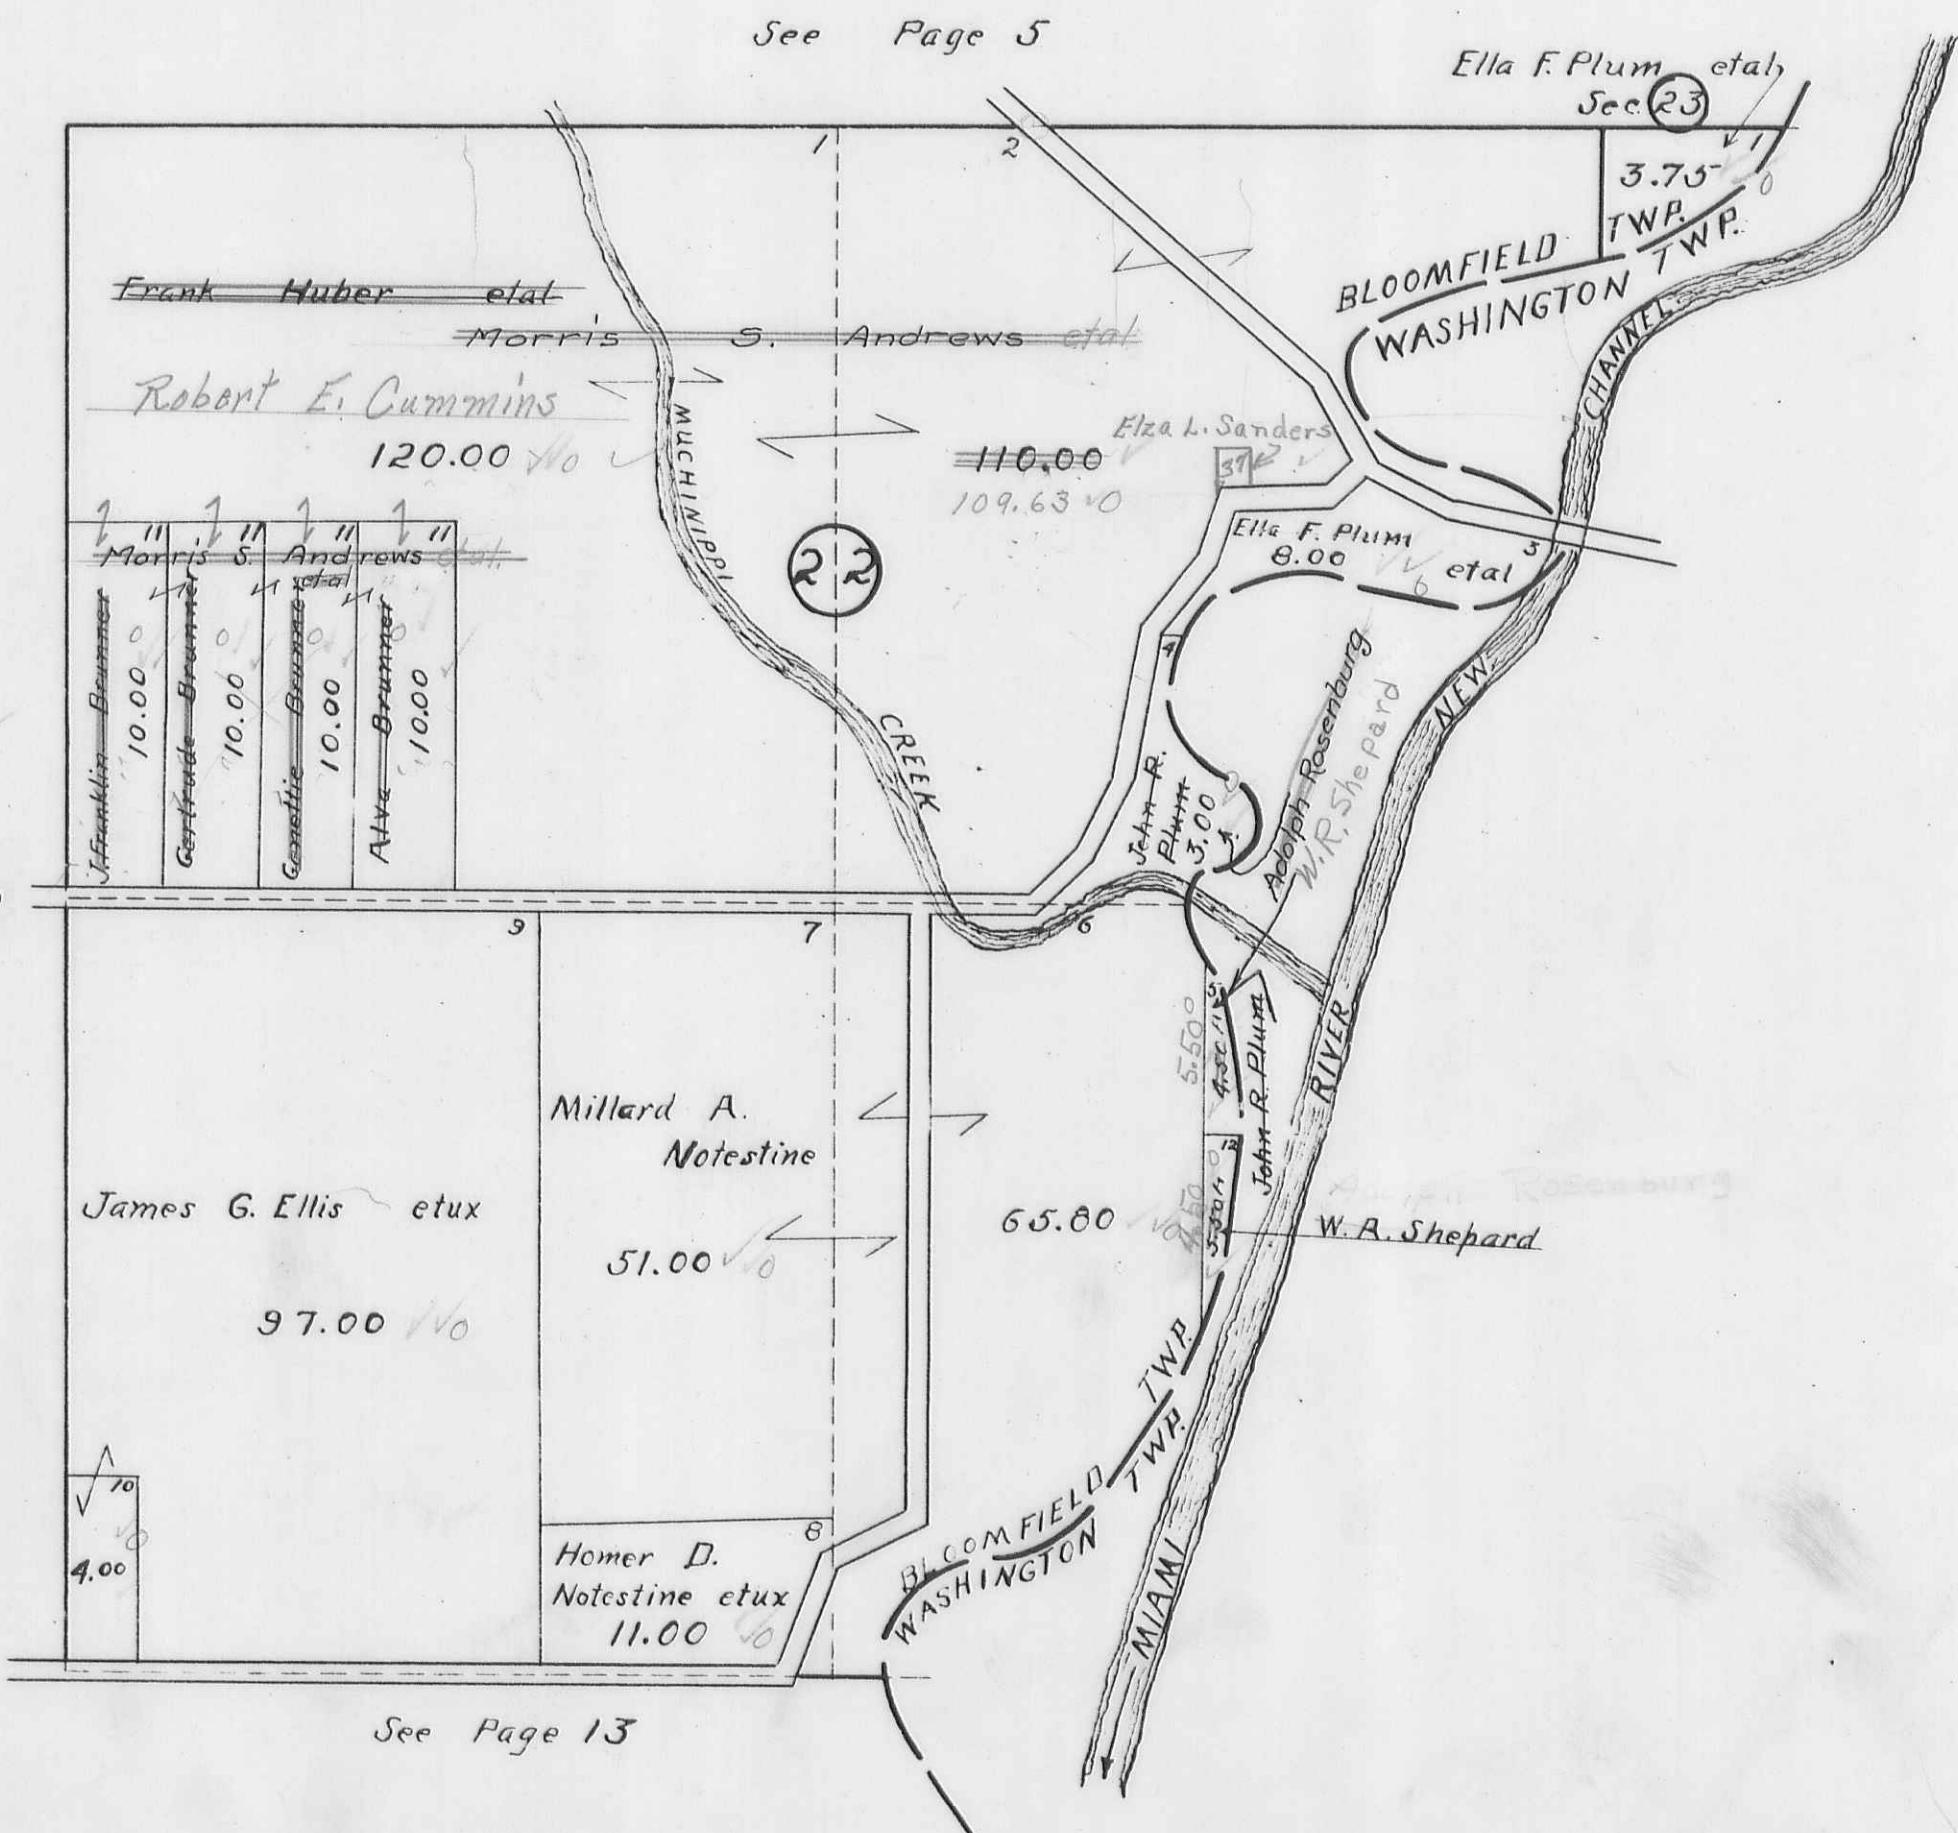

BLOOMFIELD TOWNSHIP  
SECTION 27 TOWN 7 S. RANGE 8 E.  
NANCY STEWART SECTION

PAGE 13


SCALE 10 CHAINS TO THE INCH

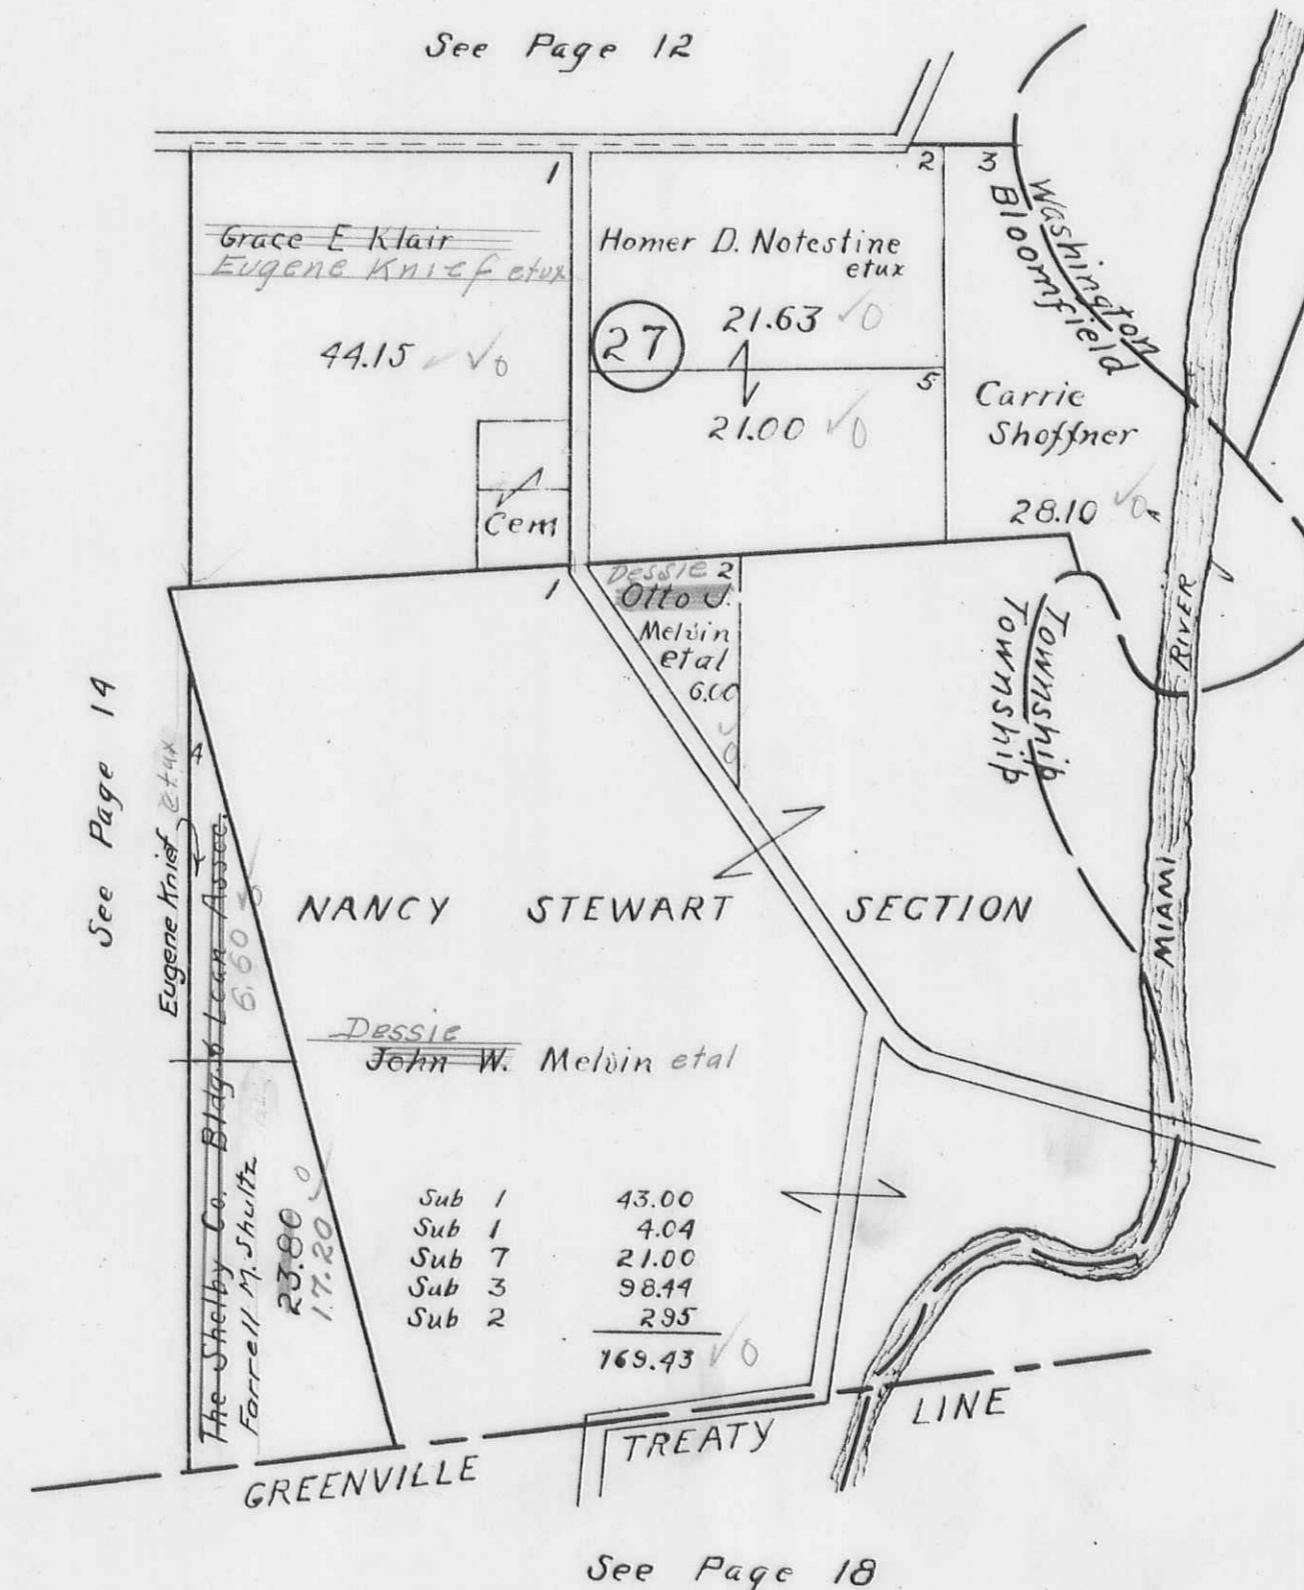

BLOOMFIELD TOWNSHIP  
SECTION 28 TOWN 7 S. RANGE 8 E.

SCALE 10 CHAINS TO THE INCH


PAGE 14

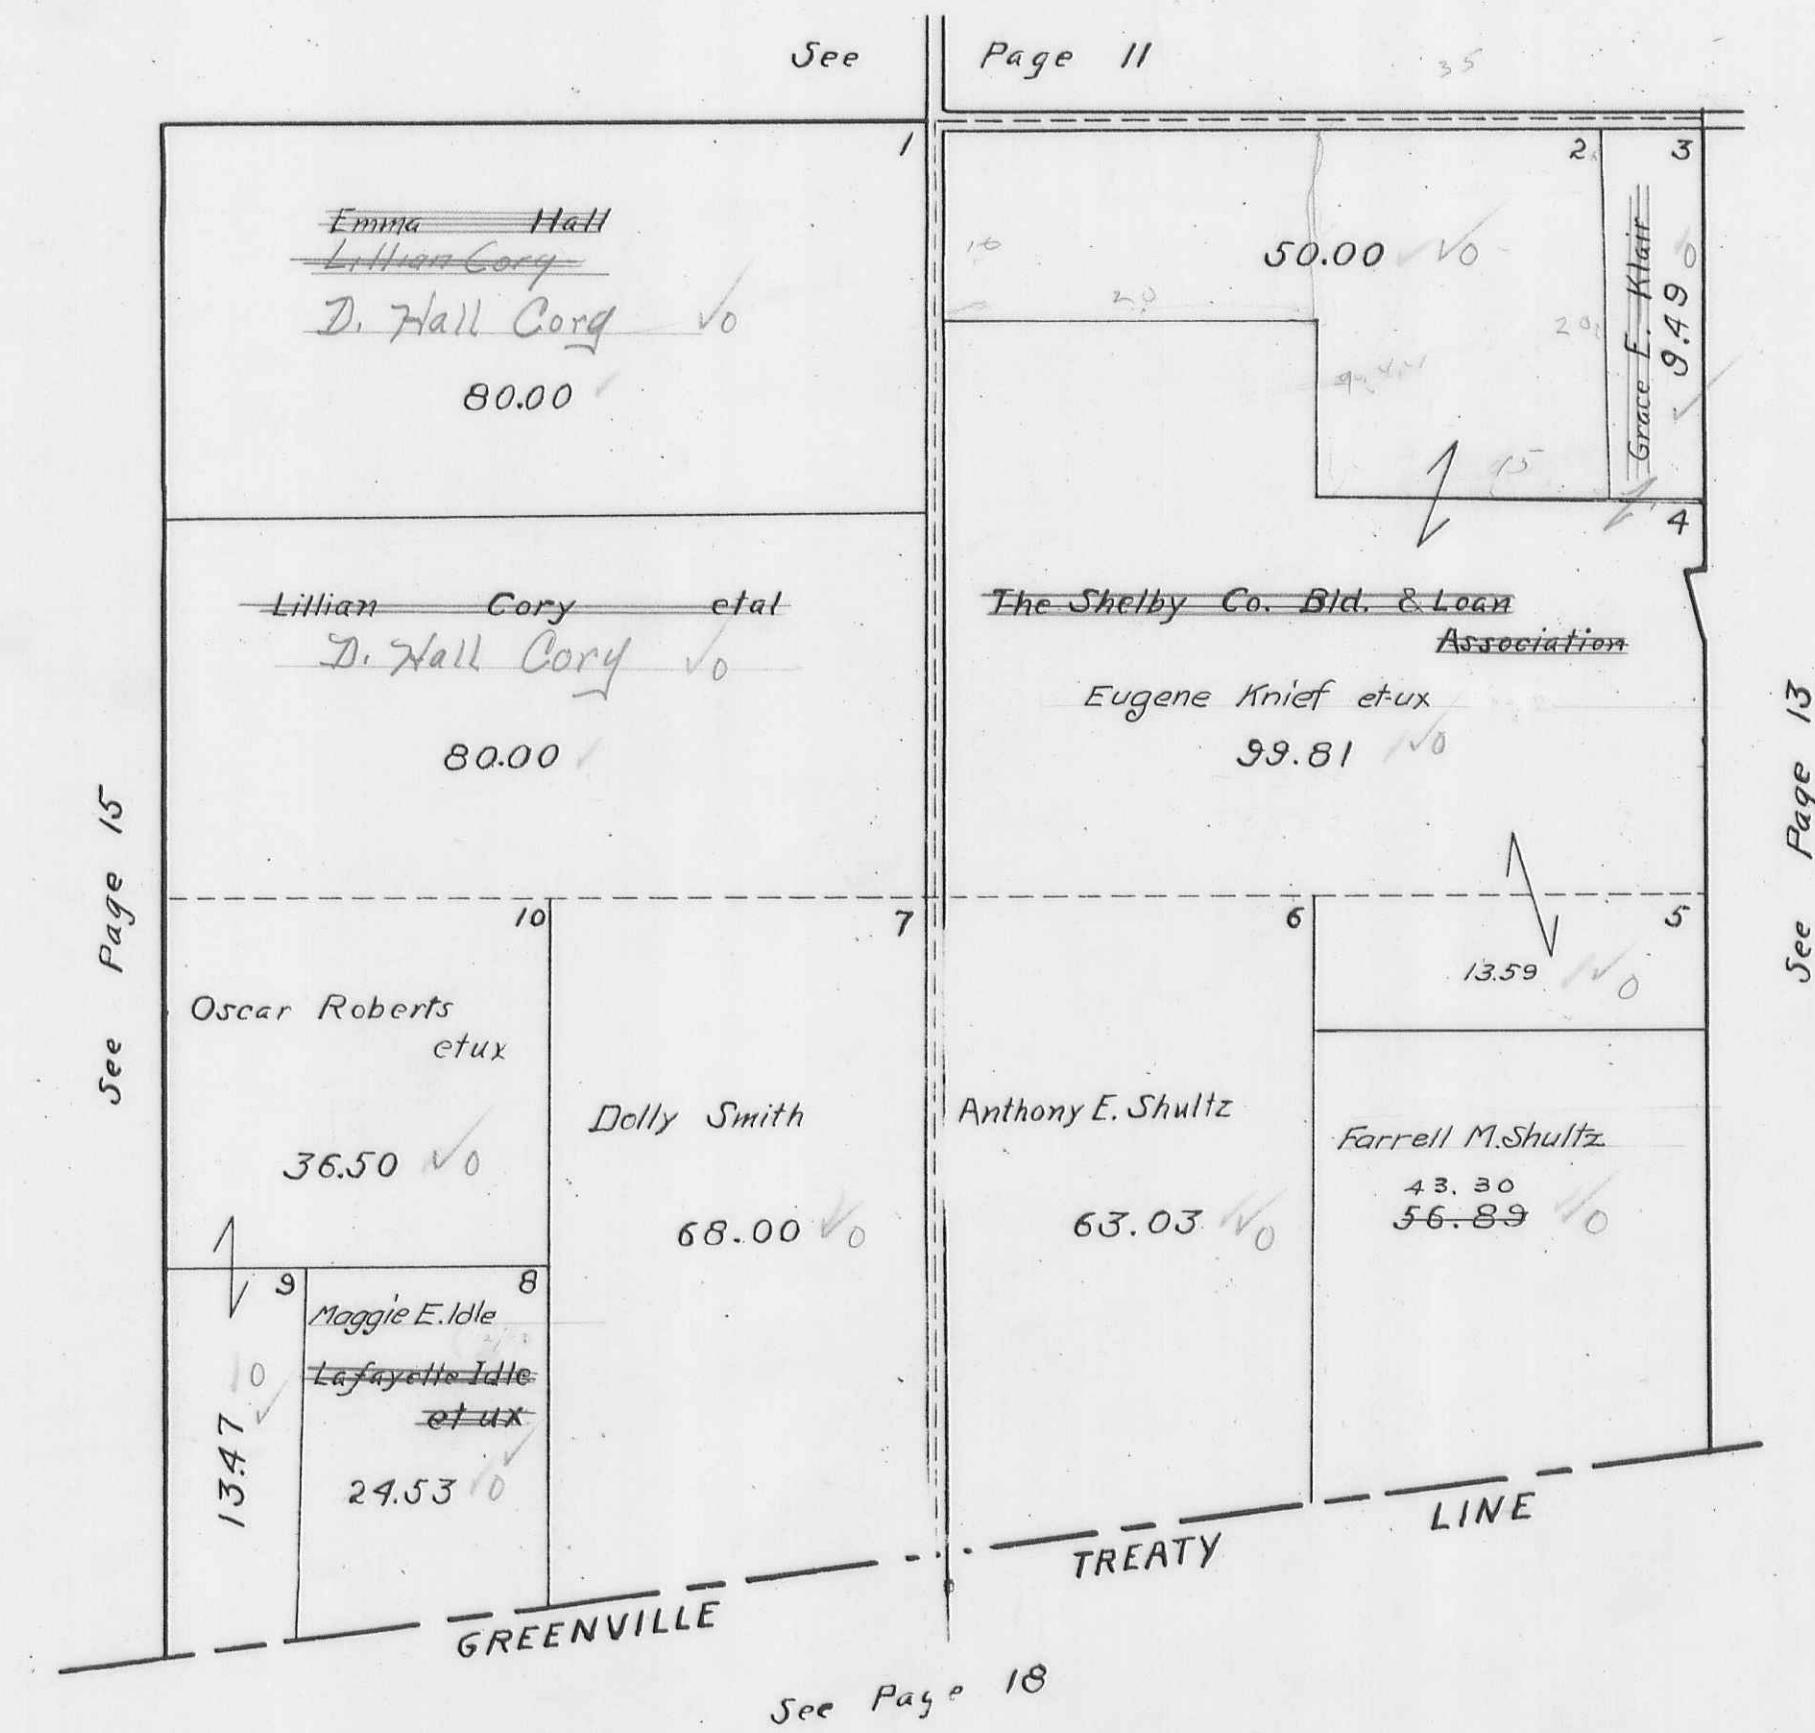

BLOOMFIELD TOWNSHIP  
 SECTION 29 TOWN 7 S. RANGE 8 E.  
 SECTION 32 TOWN 7 S. RANGE 8 E.

SCALE 10 CHAINS TO THE INCH

PAGE 15

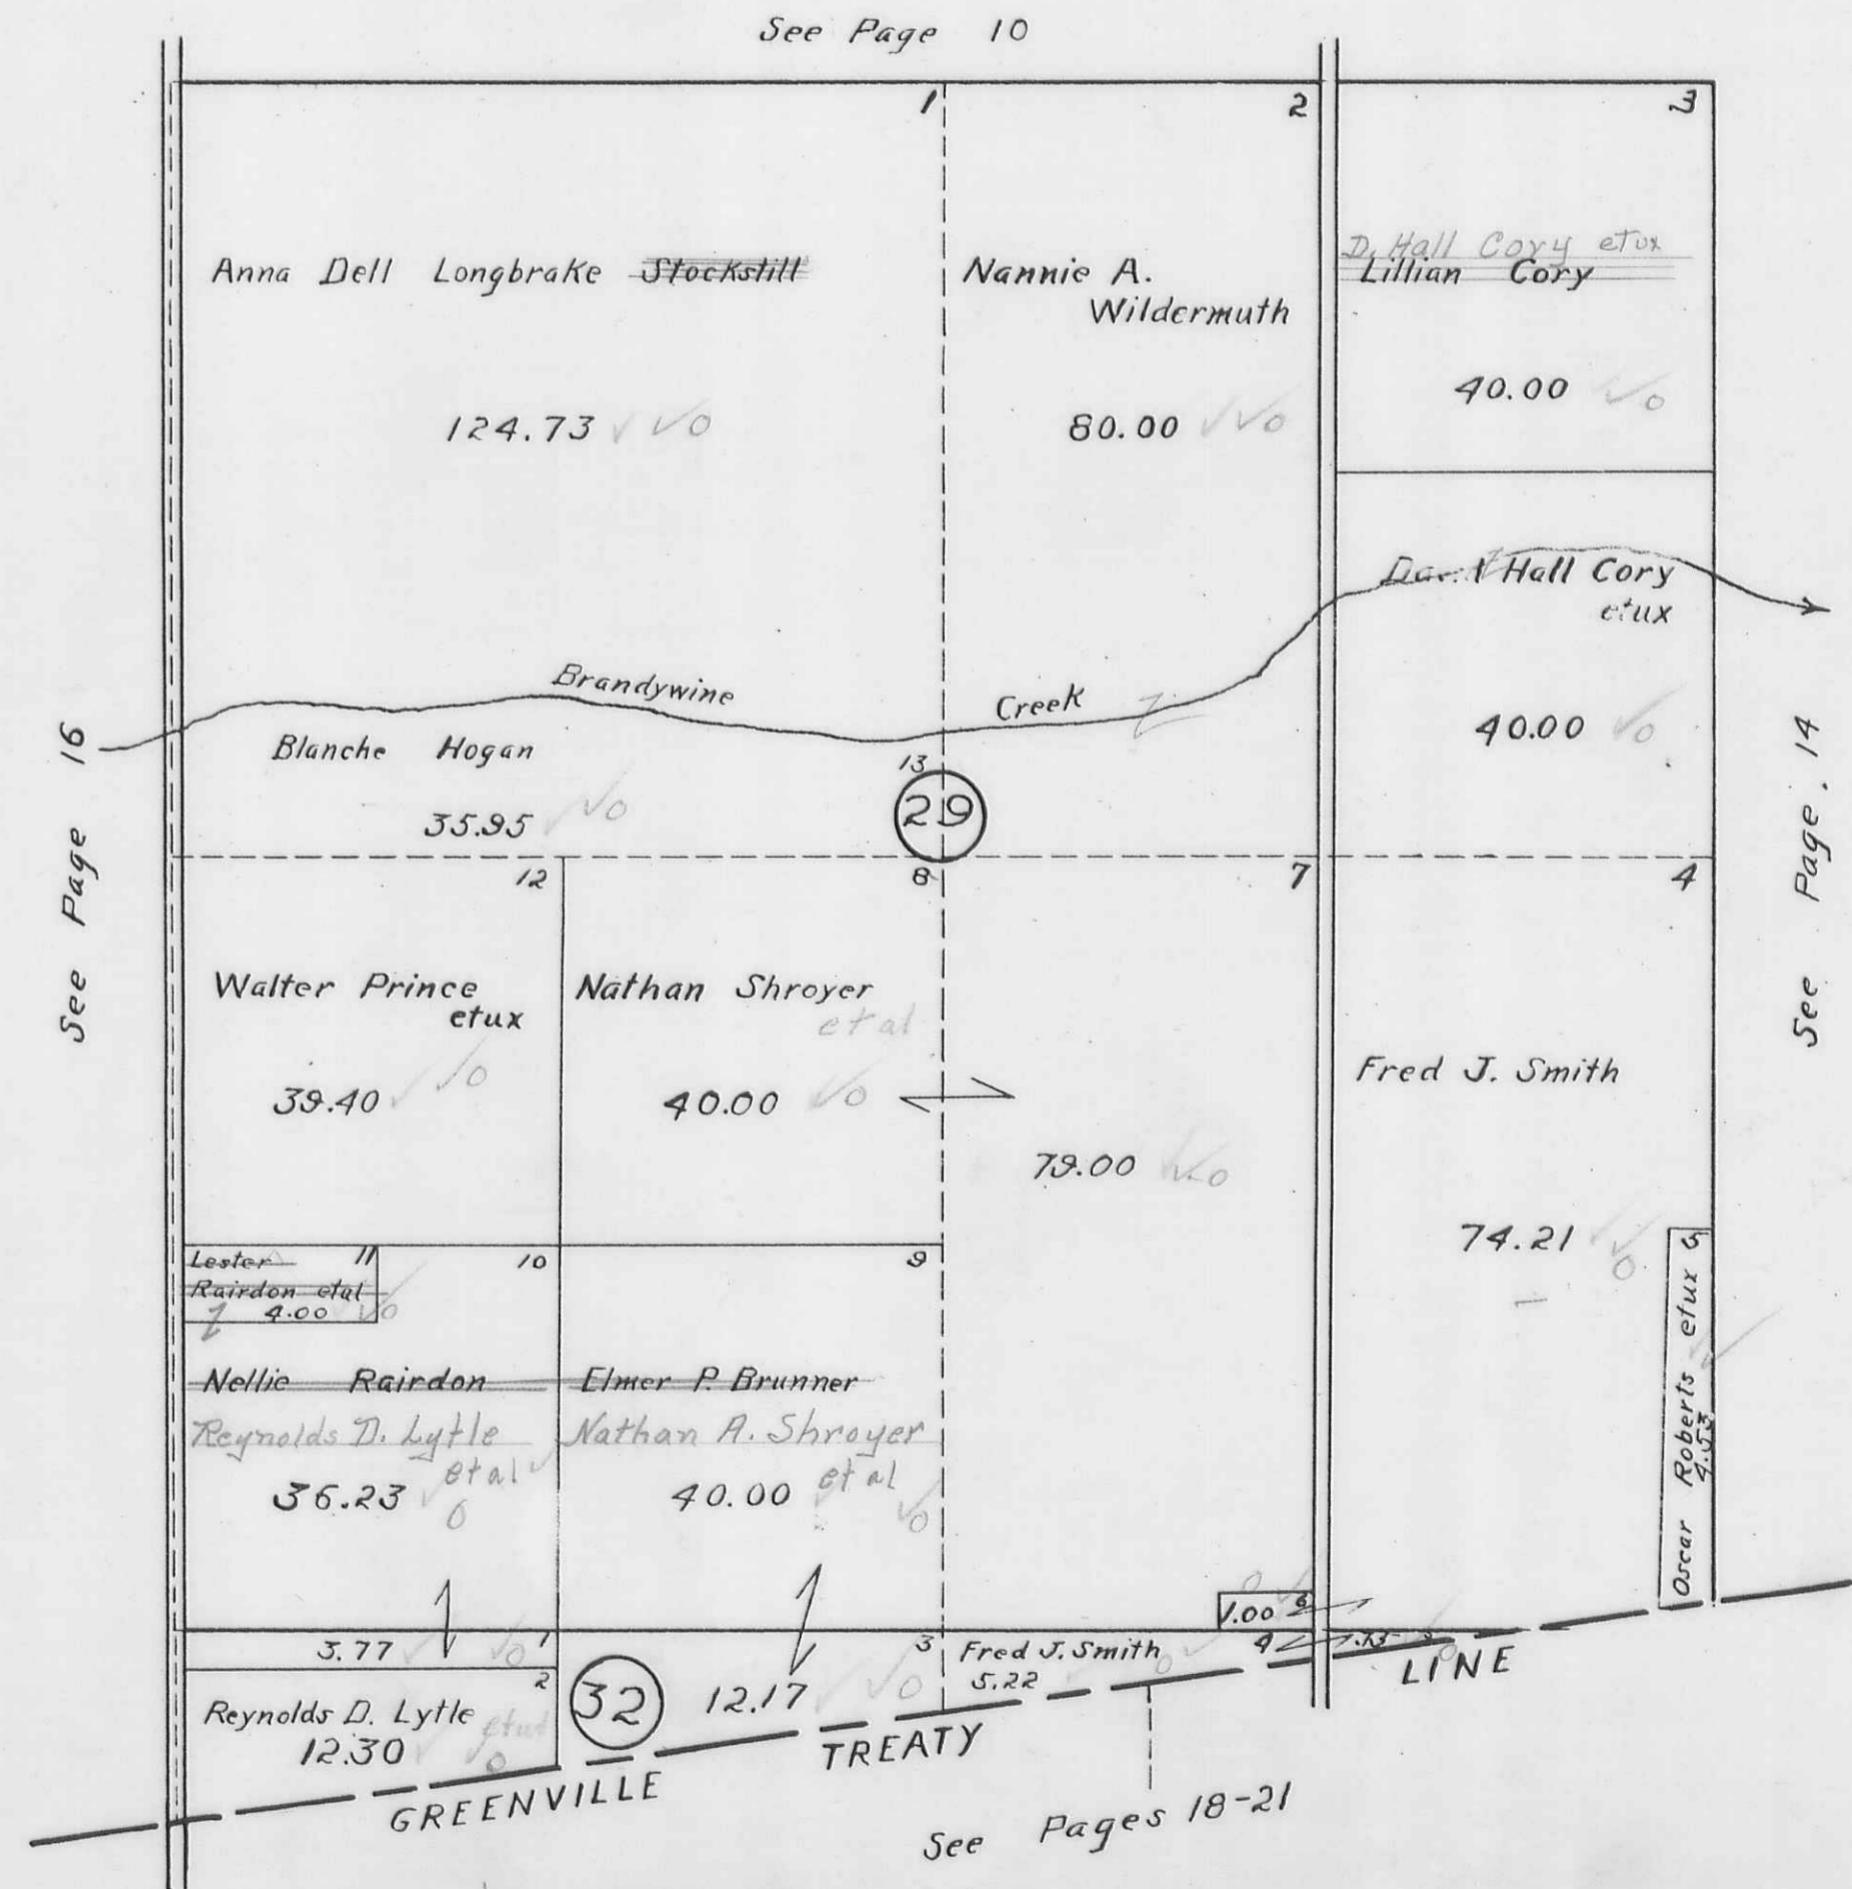

BLOOMFIELD TOWNSHIP  
 SECTION 25 TOWN 7 S. RANGE 7 E.  
 SECTION 30 TOWN 7 S. RANGE 8 E.

SCALE 10 CHAINS TO THE INCH

		See Page 9			
		1	1	2	4
SHELBY COUNTY LINE		H. M. Herbert 72.75 ✓/o		Lucille Smith Forsythe 40.00 ✓/o	Ray D. Delrumpel et al Rosetta B. Garling 20.00 ✓/o
LOGAN AND SHELBY COUNTY LINE		Lee R. Valentine Alfred Groves et al. 73.00 ✓/o	Roy Forsythe 80.00 ✓/o	Harriet F. Scrimshaw Nivin U. Smith 40.00 ✓/o	Mary B. Hogan 60.00 ✓/o
(25)				10.00 ✓/o	Charles Herbert Judy et ux <sup>7</sup> 31.16 ✓/o
SHELBY COUNTY LINE		Geo. Metz et al Albert W. Metz 111.19 ✓/o	Orville Falter et ux Geo. F. Sherer 86.00 ✓/o	Robert A. Bigget et ux 25.48 ✓/o 26.12 ✓/o 0.64 ✓/o	21.34 ✓/o
LOGAN AND SHELBY COUNTY LINE		George F. Sherer et ux 25.81 ✓/o		Dana W. Staley et ux Orville Falter et ux 41.14 ✓/o	Nell B. Raidon et al 20.70 ✓/o
(30)		Bell Cole et al Worth L. Stahler et ux 10.25 ✓/o		86.80 ✓/o	


See Page 17

See Page 15

BLOOMFIELD TOWNSHIP  
SECTION 36 TOWN 7 S. RANGE 7 E.  
SECTION 31 TOWN 7 S. RANGE 8 E.

SCALE 10 CHAINS TO THE INCH


PAGE 17

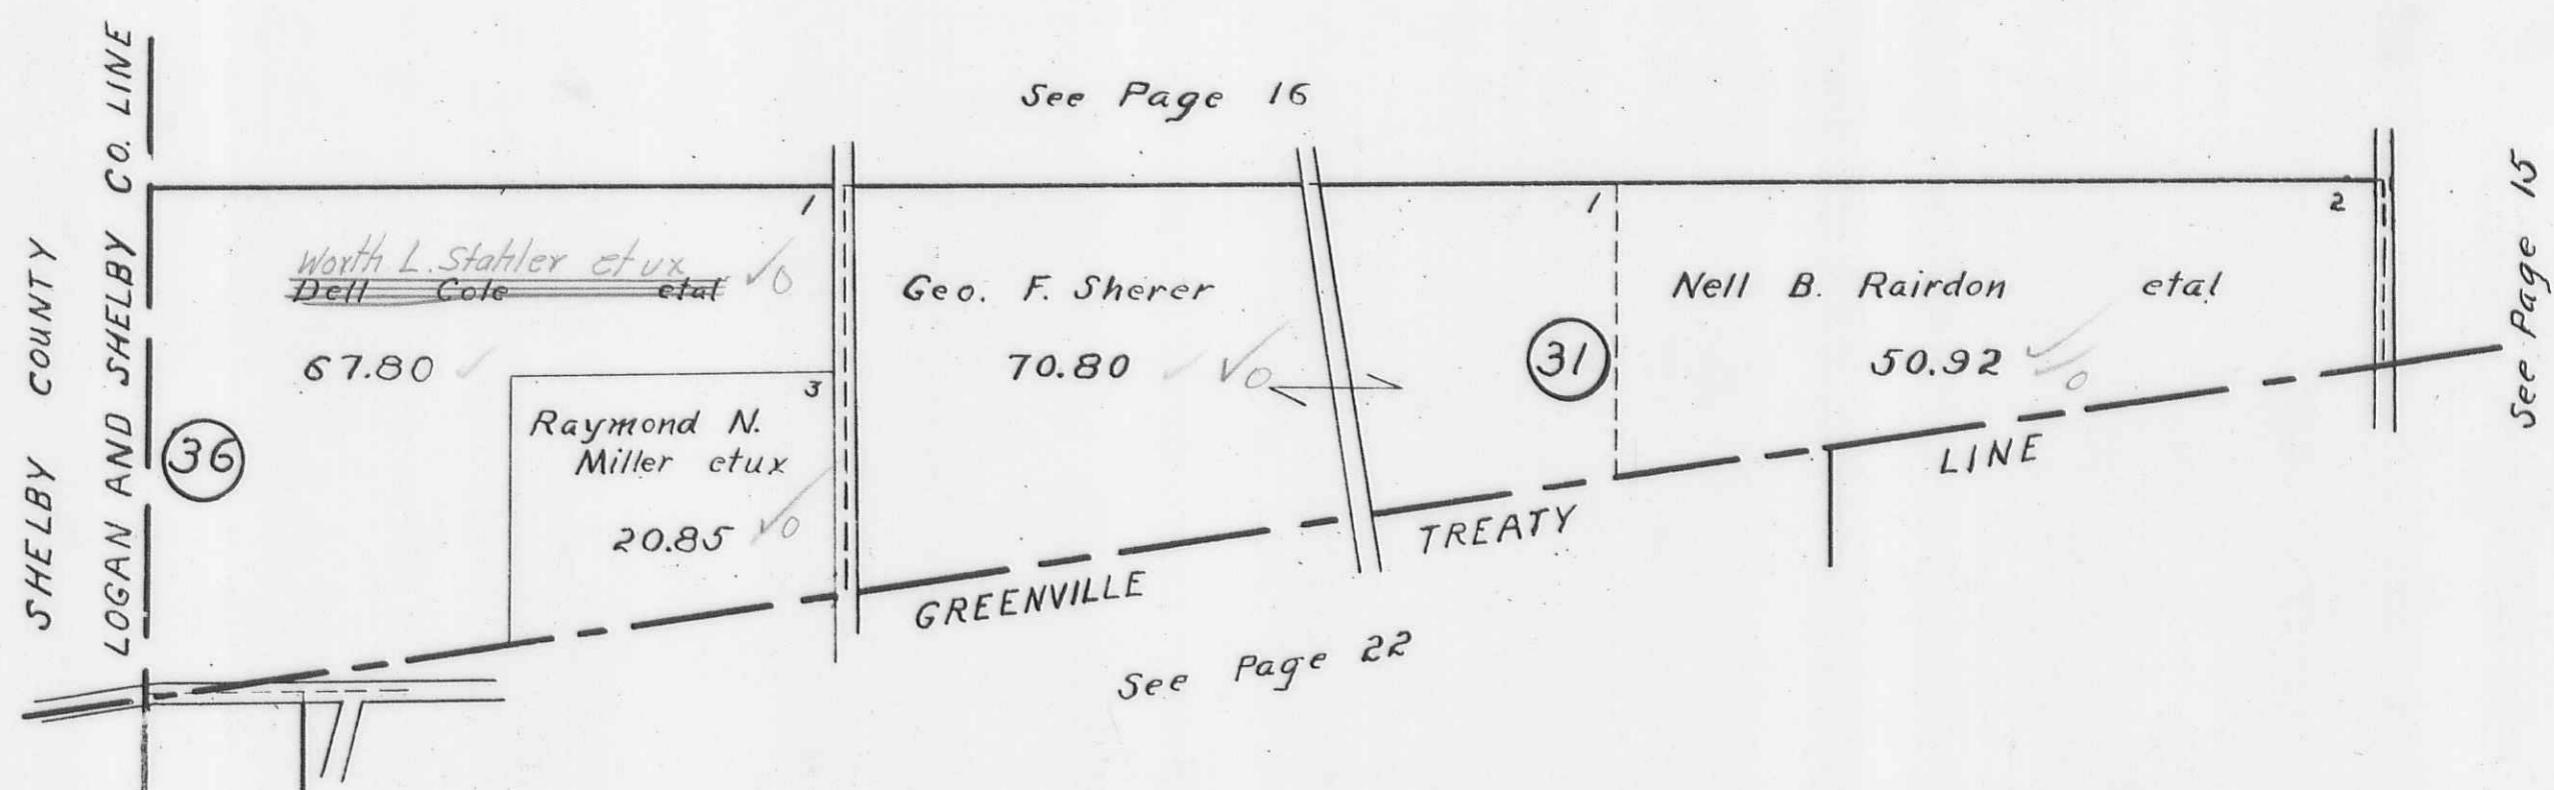

BLOOMFIELD TOWNSHIP  
 SECTION 23 TOWN 2 RANGE 8  
 SECTION 24 TOWN 2 RANGE 8

PAGE 18


SCALE 10 CHAINS TO THE INCH

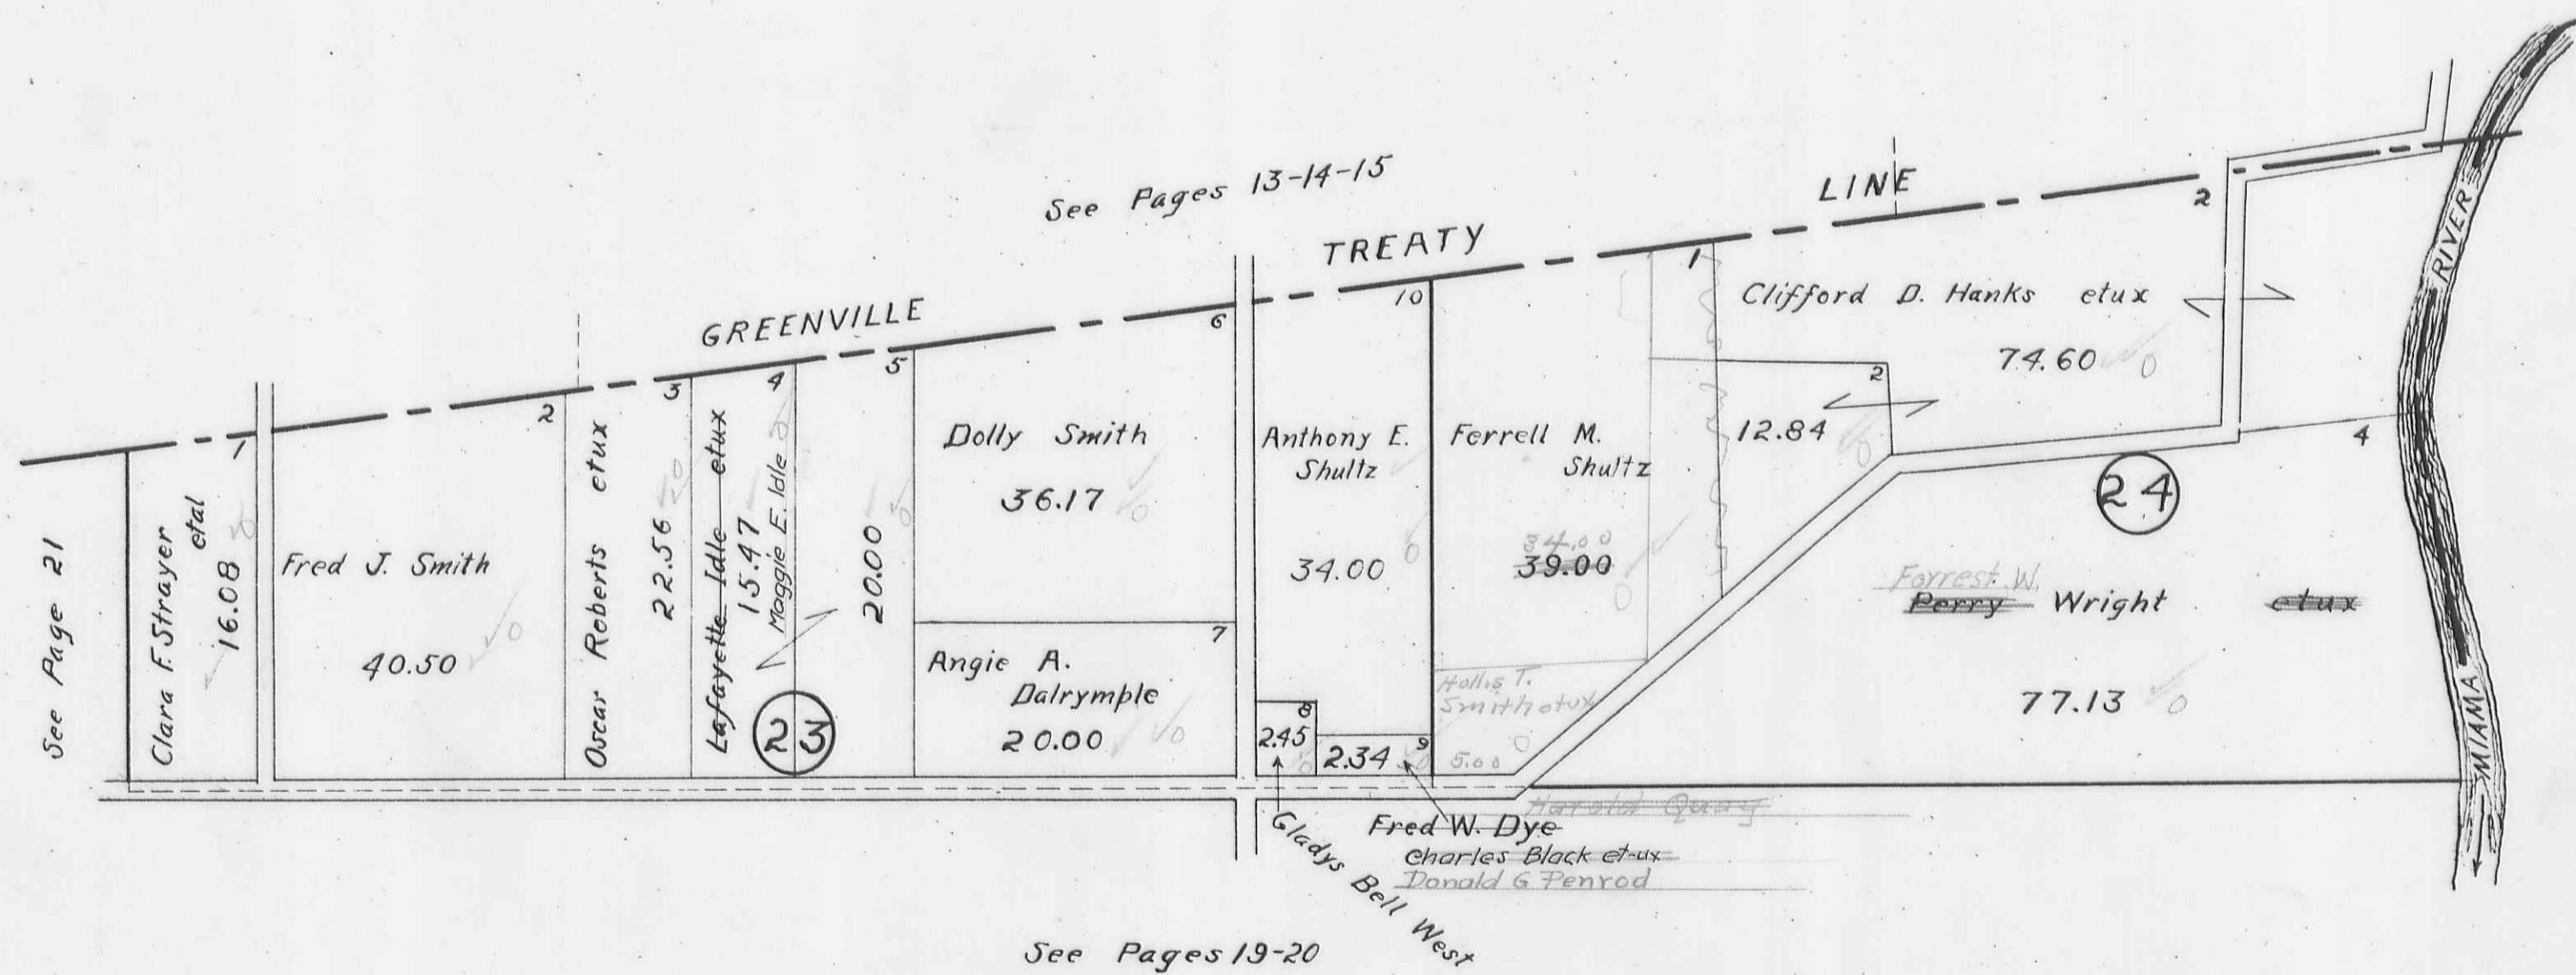

BLOOMFIELD TOWNSHIP  
SECTION 25 TOWN 2 RANGE 8

SCALE 10 CHAINS TO THE INCH

PAGE 19

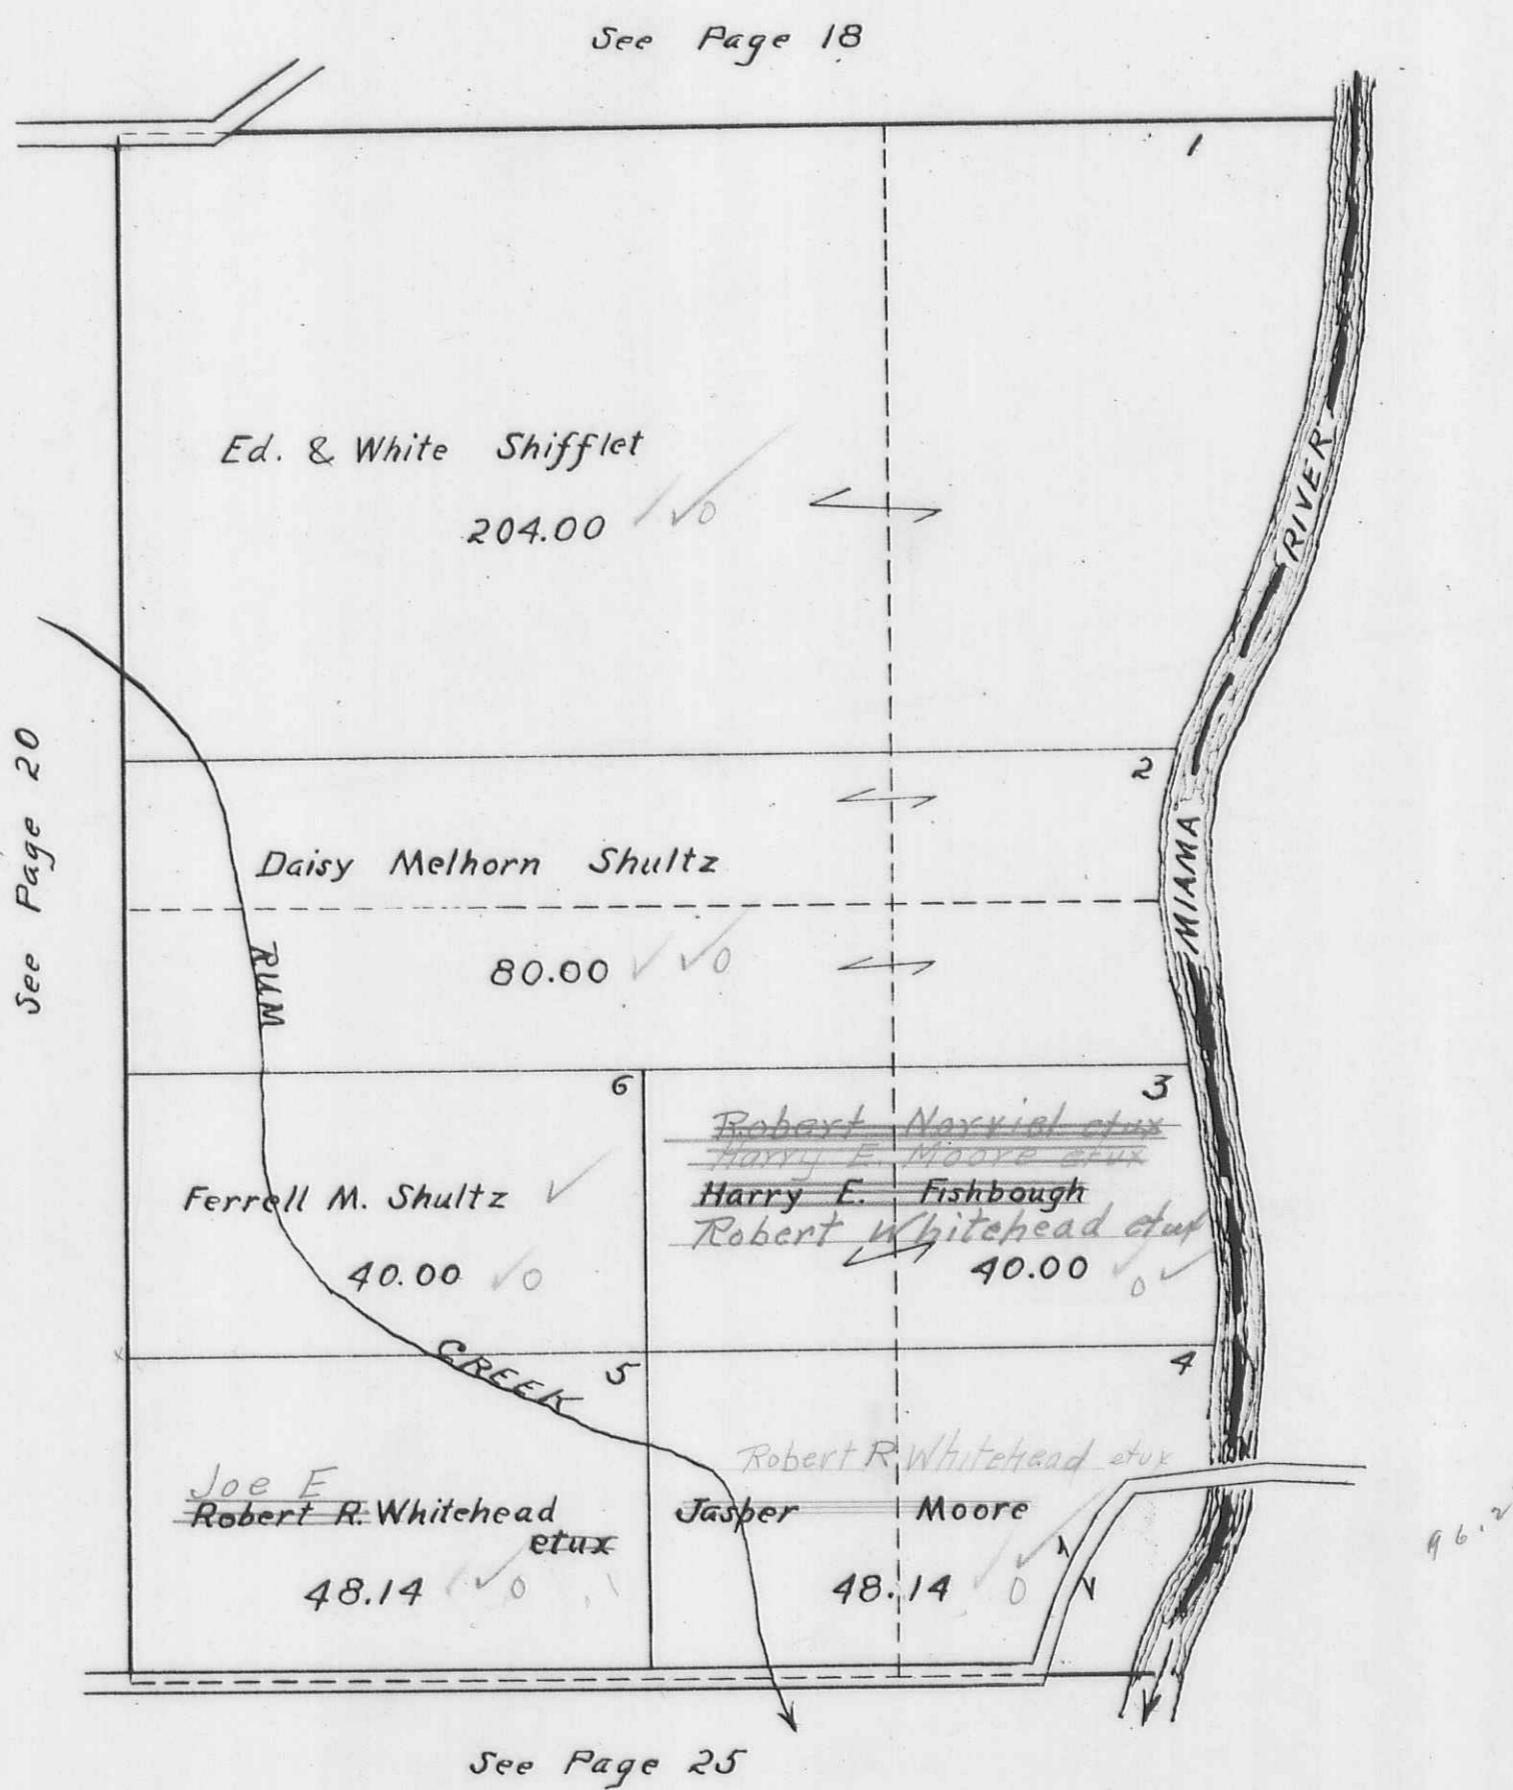


BLOOMFIELD TOWNSHIP  
SECTION 26 TOWN 2 RANGE 8

SCALE 10 CHAINS TO THE INCH

PAGE 20

See Page 18

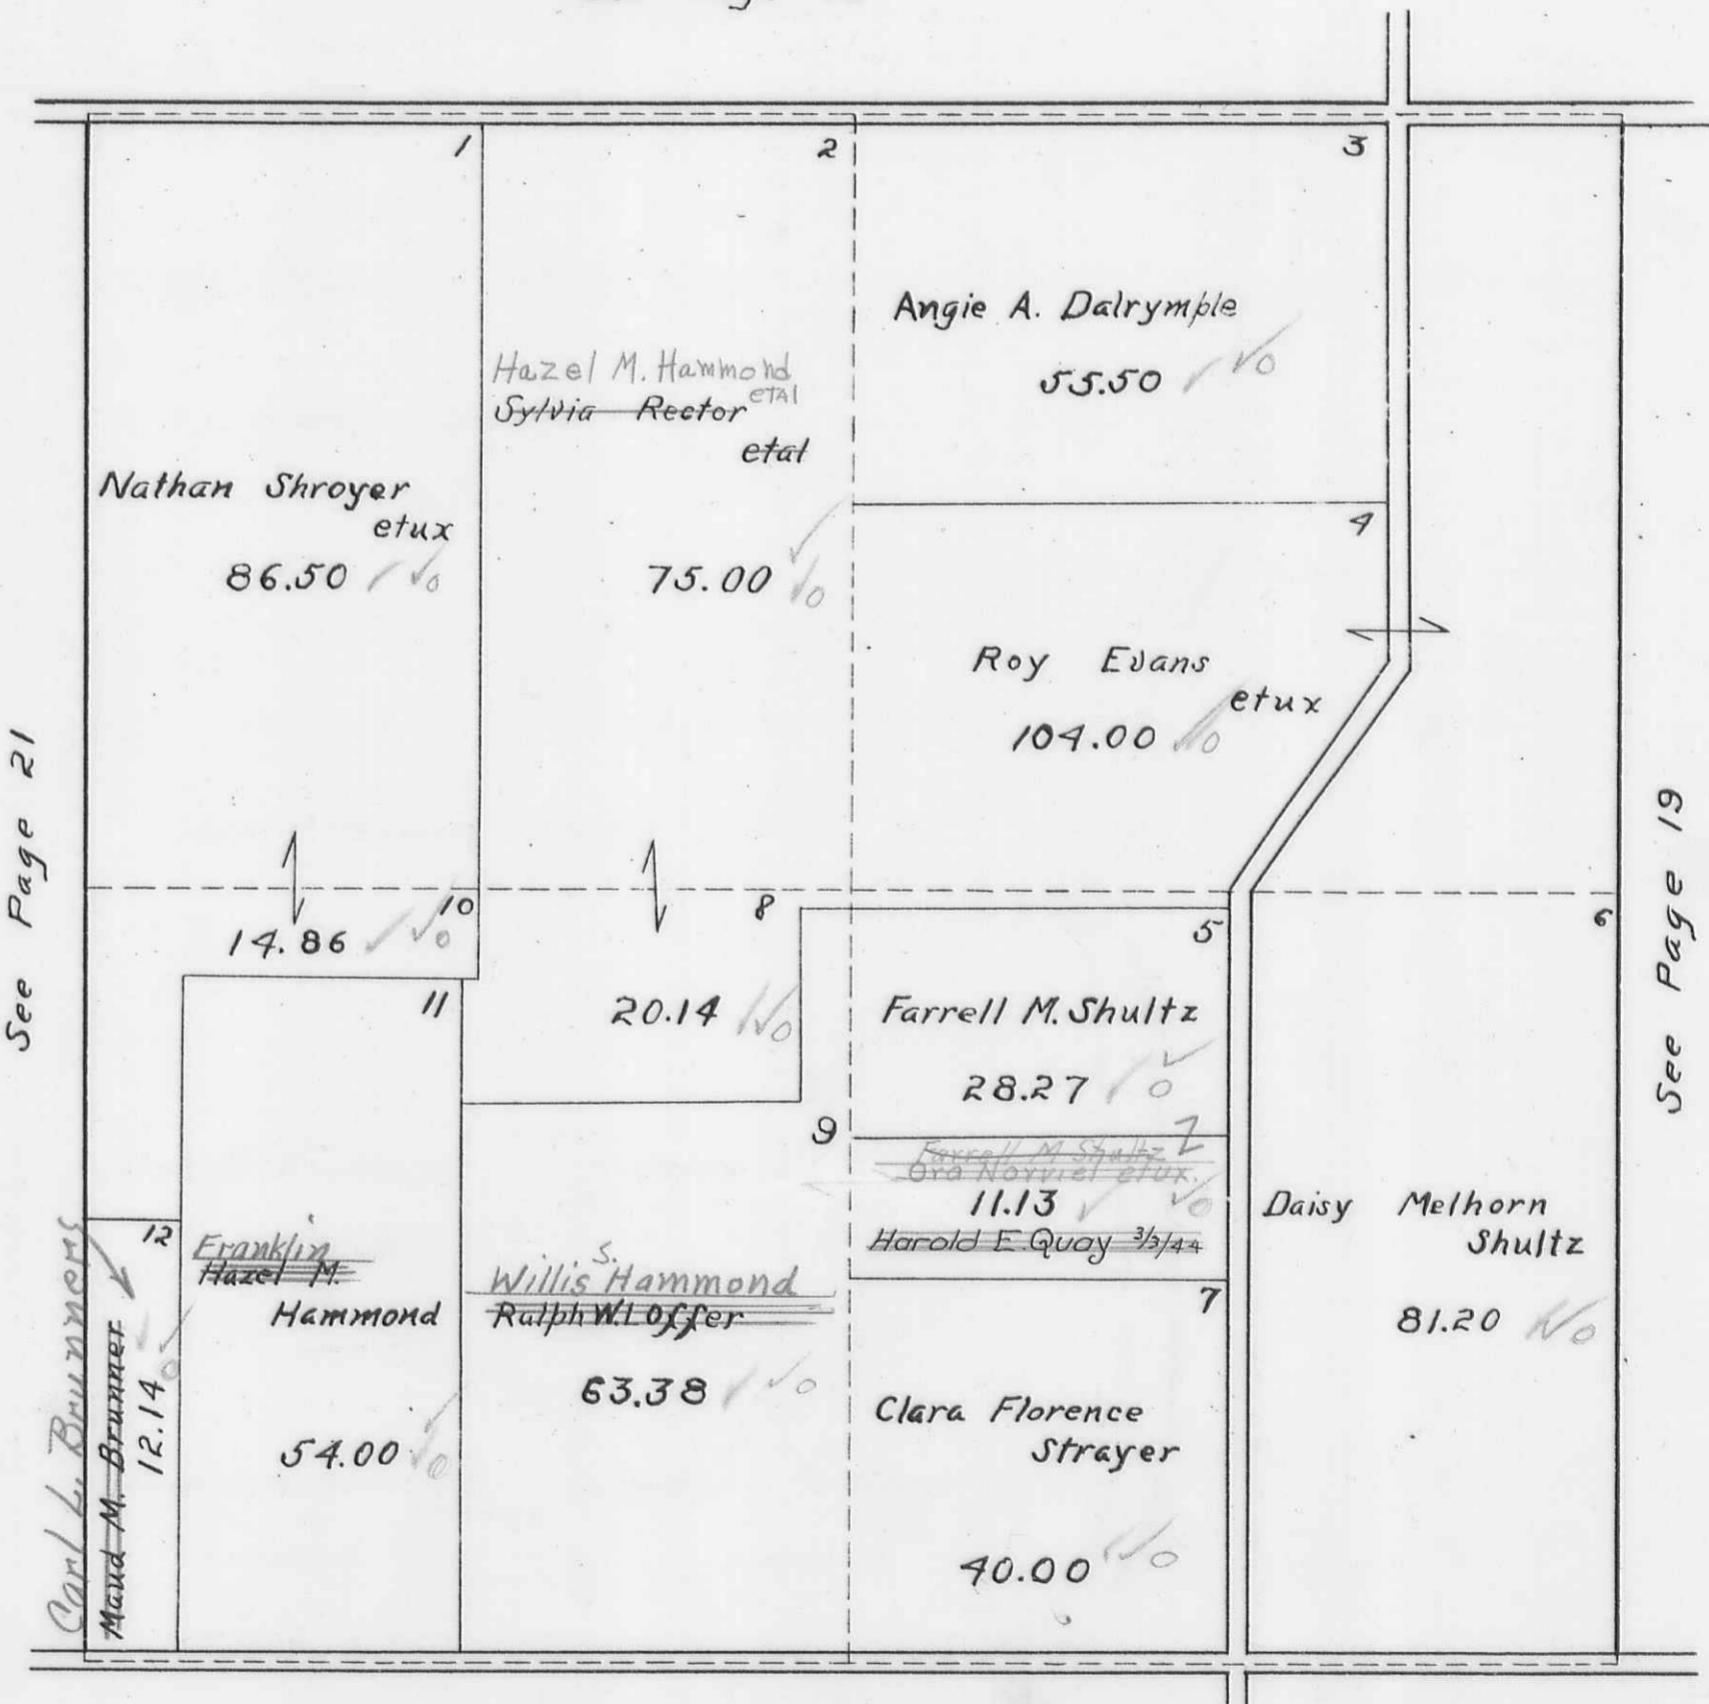

BLOOMFIELD TOWNSHIP  
 SECTION 22 TOWN 2 RANGE 8  
 SECTION 27 TOWN 2 RANGE 8

SCALE 10 CHAINS TO THE INCH


See Page 15			
TREATY LINE			
GREENVILLE			
Nell B. Raidon 36.23 ✓ 0	Reynolds D. Lytle etux 28.64 ✓ 0	Elmer P. Brunner Nathan A. Shroyer et al 39.06 ✓ 0	Clara F. Strayer et al 23.78 ✓ 0
1	2	3	4
Geo. F. Sherer etux 80.00 ✓ 0	Eber & H. Hedge Robert H. Dodge et ux John W. Hoy etux 80.00 ✓ 0	Lucy Cote Reynolds D. Lytle etux 80.00 ✓ 0	Hodge H. Longbrake et al Glen E. Burch et ux 80.00 ✓ 0
See Page 22	27	8	7
Wm. M. Wright etal 80.50 ✓ 0	Hamer W. Smith 60.80 ✓ 0	Gee A. Brunner Carl L. Brunner 60.80 ✓ 0	Nathan Shroyer etux 15.04 ✓ 0
Flossie O. Sherer etal 80.50 ✓ 0			Maud M. Brunner 22.86 ✓ 0 Carl L. Brunner
			6

## BLOOMFIELD TOWNSHIP

PAGE 22


SECTION 28 TOWN 2 RANGE 8  
 SECTION 29 TOWN 2 RANGE 8  
 SECTION 20 TOWN 2 RANGE 8  
 SECTION 21 TOWN 2 RANGE 8

SCALE 10 CHAINS TO THE INCH

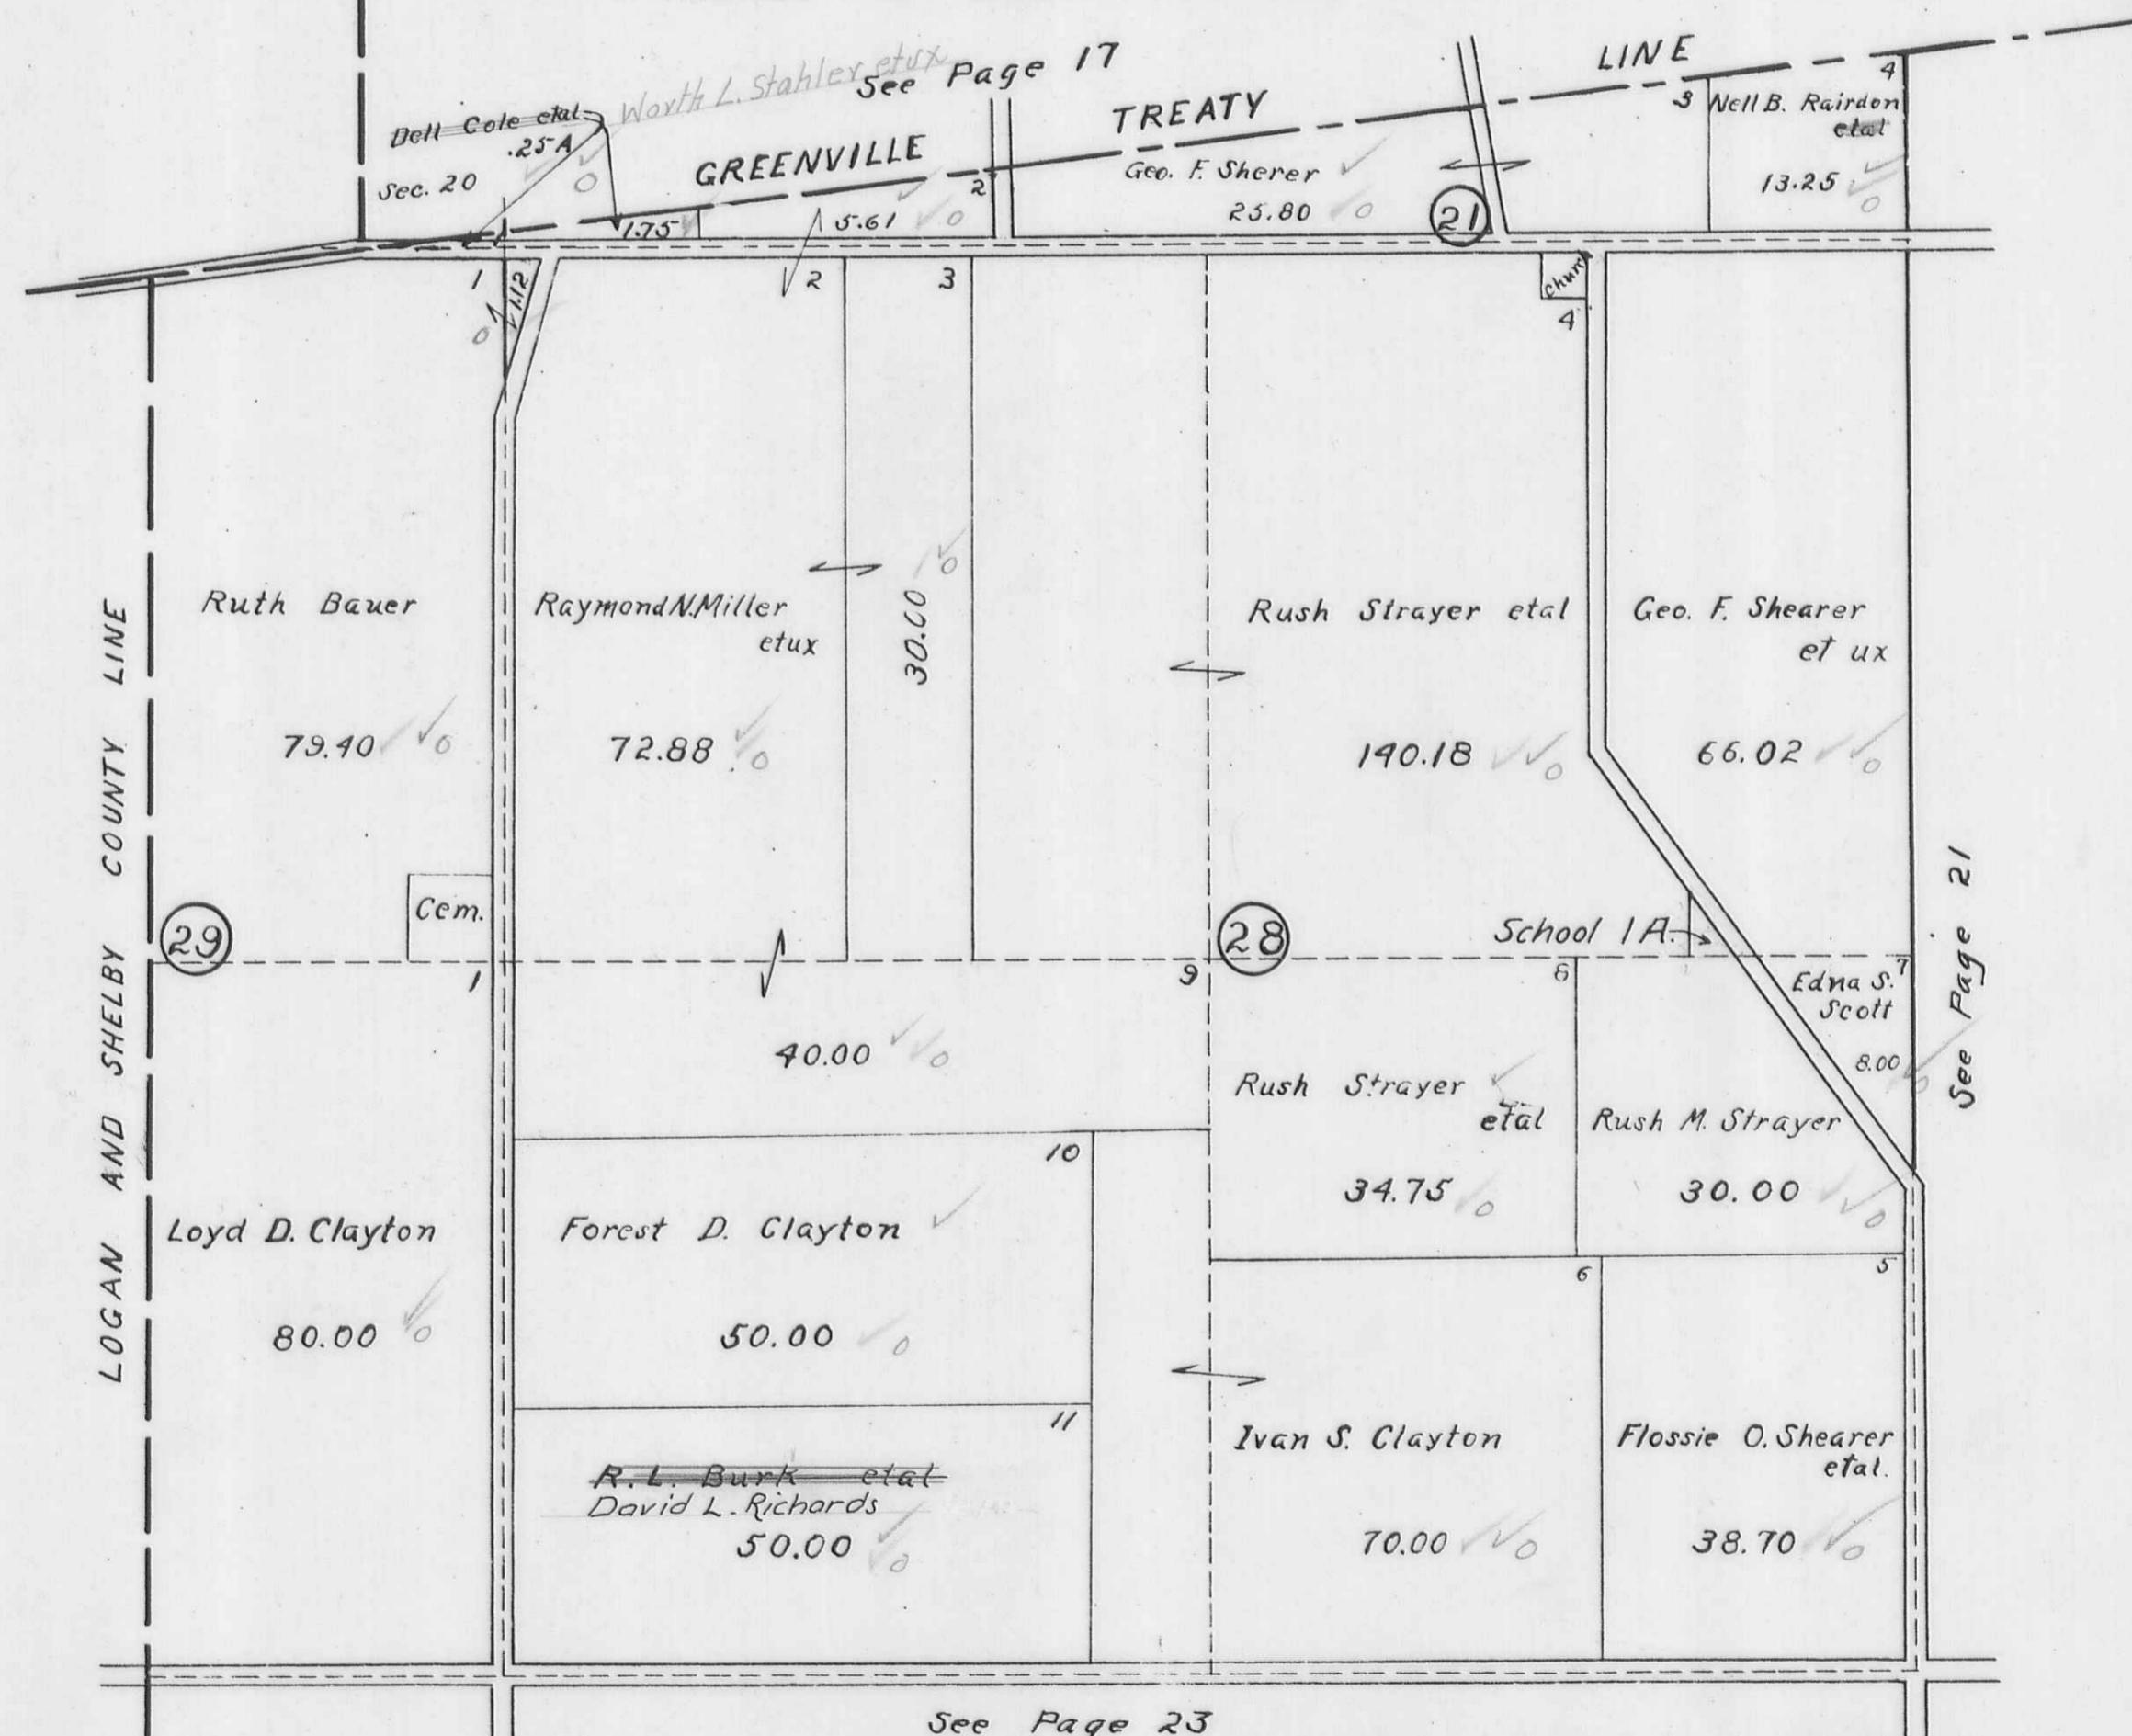

See Page 23

BLOOMFIELD TOWNSHIP  
SECTION 32 TOWN 2 RANGE 8  
SECTION 33 TOWN 2 RANGE 8  
SCALE 10 CHAINS TO THE INCH

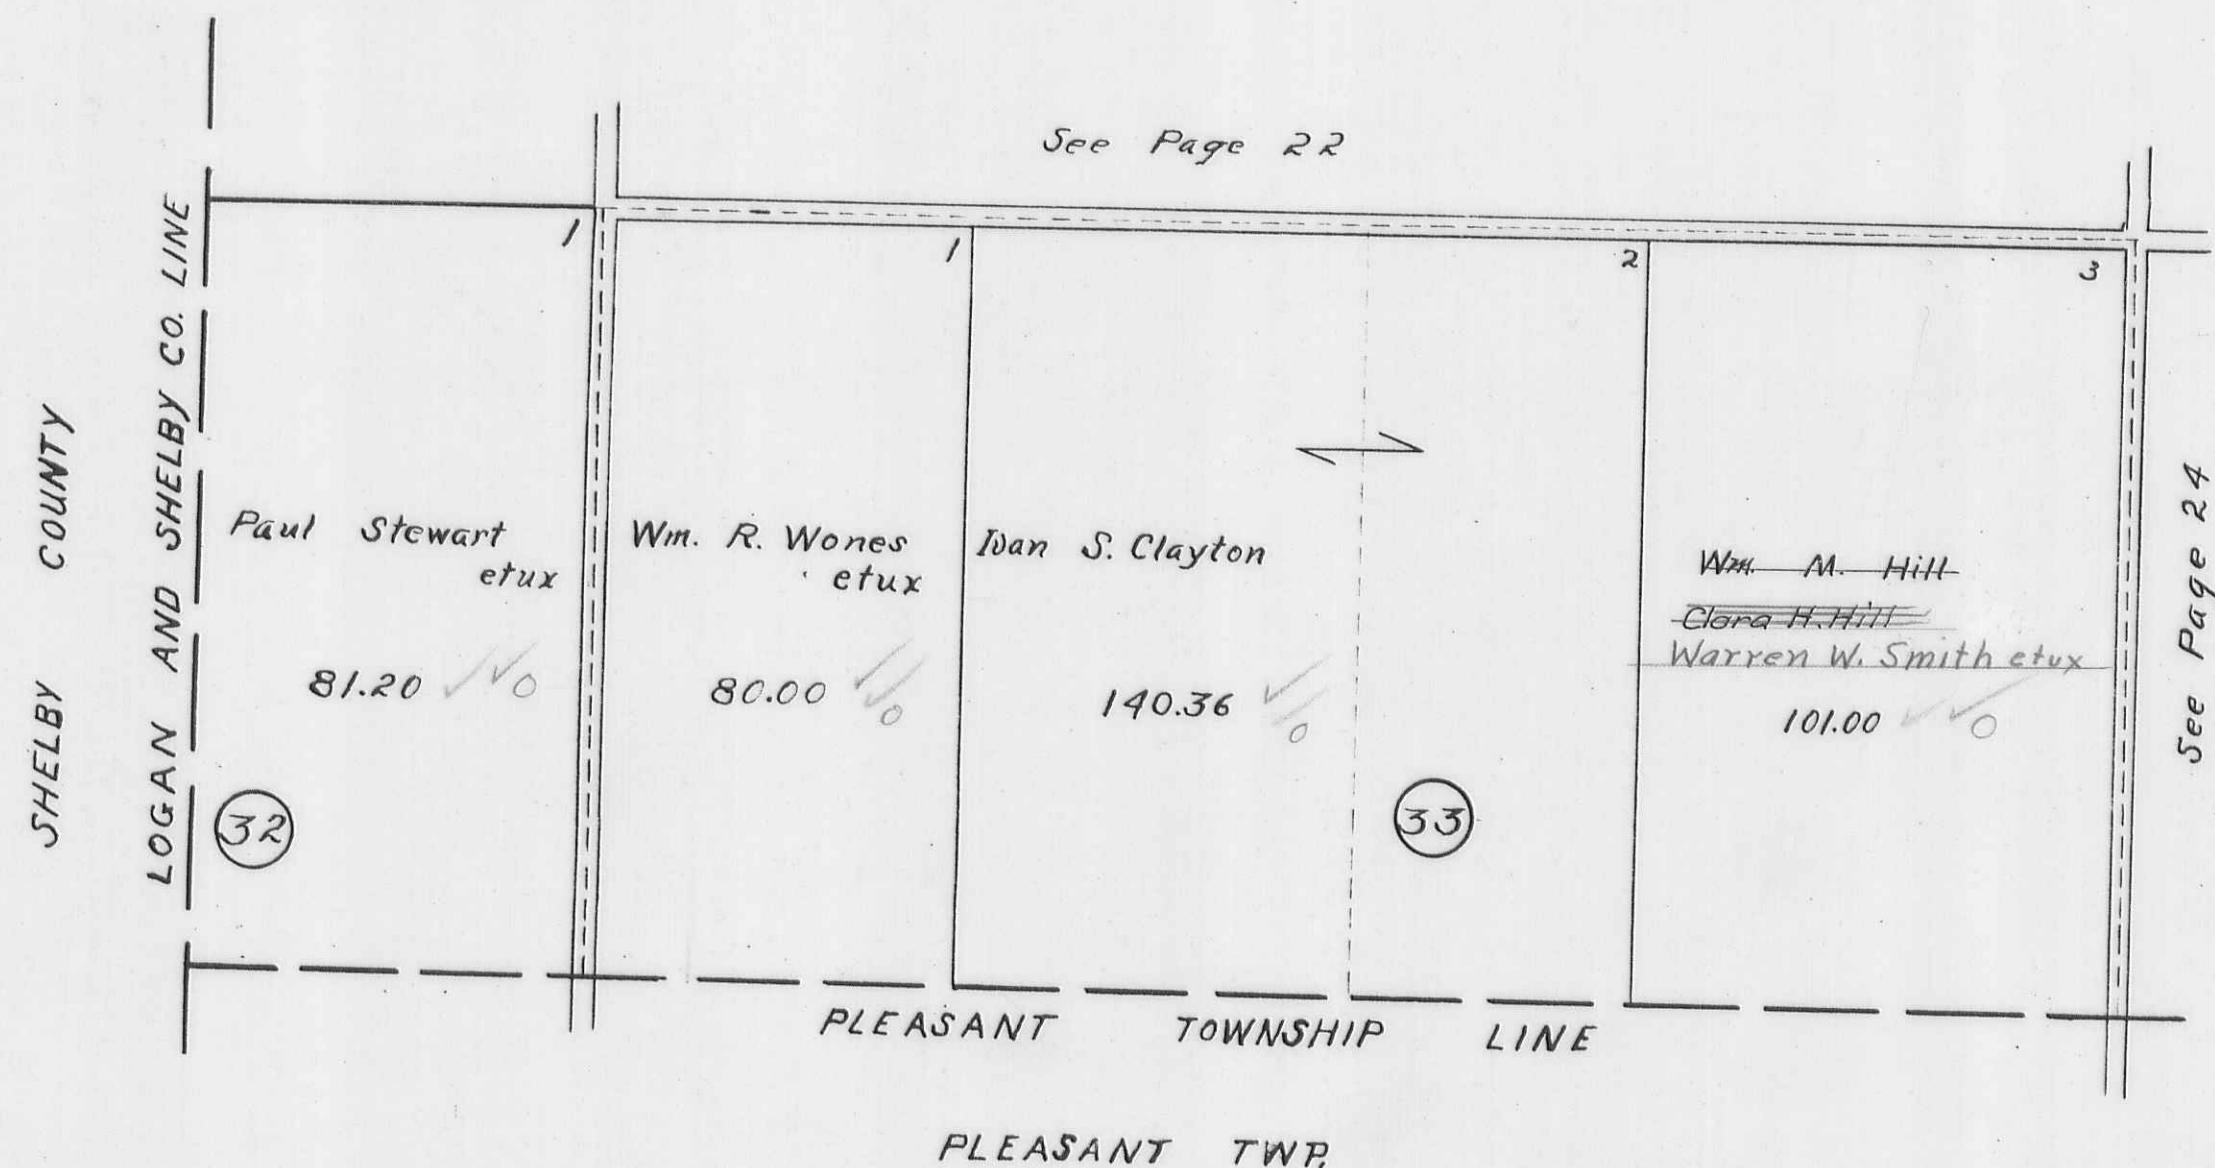

BLOOMFIELD TOWNSHIP  
SECTION 34 TOWN 2 RANGE 8

SCALE 10 CHAINS TO THE INCH

PAGE 24

See Page 21

1	4	6	7	8
Lucy Cote 26.67 ✓ Rush M. Strayer				Geo A. Brunner Carl L. Brunner 20.00 ✓
Lucy Shultz Moury 26.66 ✓	Lucy Shultz Moury 70.00 ✓	Hamer W. Smith 80.00 ✓		The N.W. Mutual Life Ins. Co. 60.00 ✓ Wm. A. Wright et ux ✓
Geo. Wilson Shultz 26.67 ✓	Carey Kreglow et al 10.00 ✓			Herry E. Engelhardt
		PLEASANT	TOWNSHIP	LINE
		PLEASANT	TWP.	

See Page 23


See Page 25

BLOOMFIELD TOWNSHIP  
SECTION 35 TOWN 2 RANGE 8  
SECTION 36 TOWN 2 RANGE 8

SCALE 10 CHAINS TO THE INCH

PAGE 25

See Pages 19-20

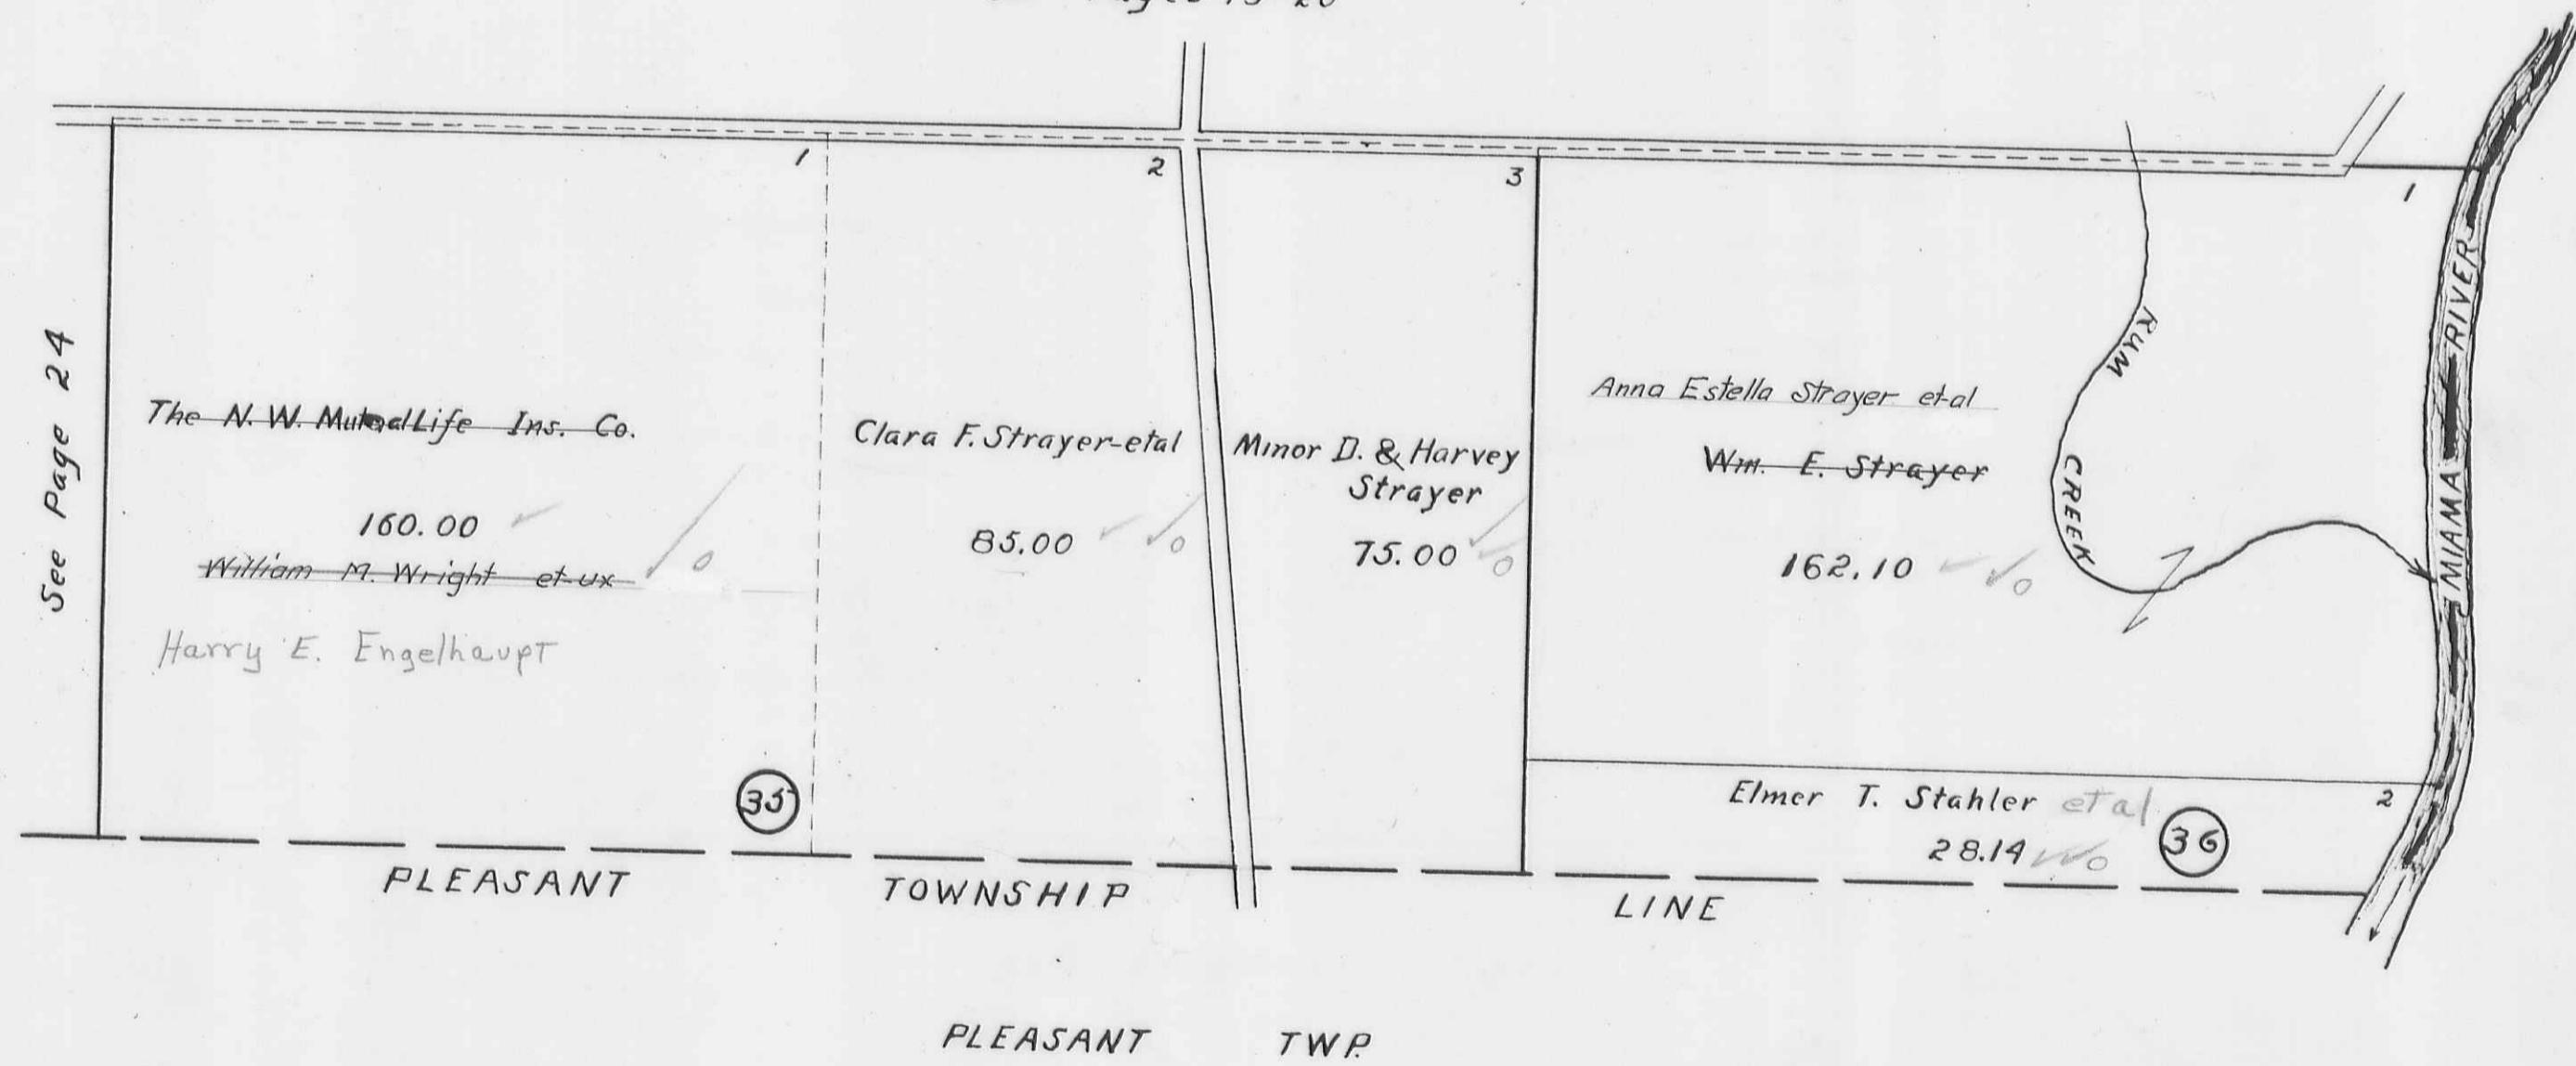

## BLOOMFIELD TOWNSHIP

PAGE 26

## BLOOMCENTER

SCALE 200 FEET TO THE INCH

