

R

MONROE TOWNSHIP

1942

INDEX

VIRGINIA MILITARY SURVEYS	PAGE
5864	1
8303}	2
8485)	2
6449	2
6762	2
4957	3
9793	4
10853	4
4493}	5
4525)	
12099	6
9592}	
9618)	7
10075)	
3242	7
3138	8
4497	8
9878)	
10109	9
10718	
10719,	
3222	10
3221	11

VIRGINIA MILITARY SURVEYS	PAGE
3159	12
4676	12
7318	12
6516	13
4479	14
2220	15
6487	15
10091	15
3224	16
3223	17
4570 - N. PART	18
4570 - S. PART	19
4492 - W. PART	20
4492 - E. PART	21
3225	22
3226	23
3227	24
3228	25
9676	25
3229	26
3230	27
5042	28
5044	28

SECTION	TOWN	RANGE	PAGE
19	4	14	29
24	5	13	29
17	5	13	30
23	5	13	30
16	5	13	31
22	5	13	31
21	5	13	32
15	5	13	33

PICKRELL TOWN —————— 34


MONROE TOWNSHIP
INDEX MAP

PAGE 0

Jan. 1, 1950

CORRECTED TO

~~4-12-42~~
~~January 1, 1945?~~
~~April 9, 1950~~
~~November 10, 1945~~
~~January 1-1947~~
~~January 1-1948~~
~~January 1, 1949~~

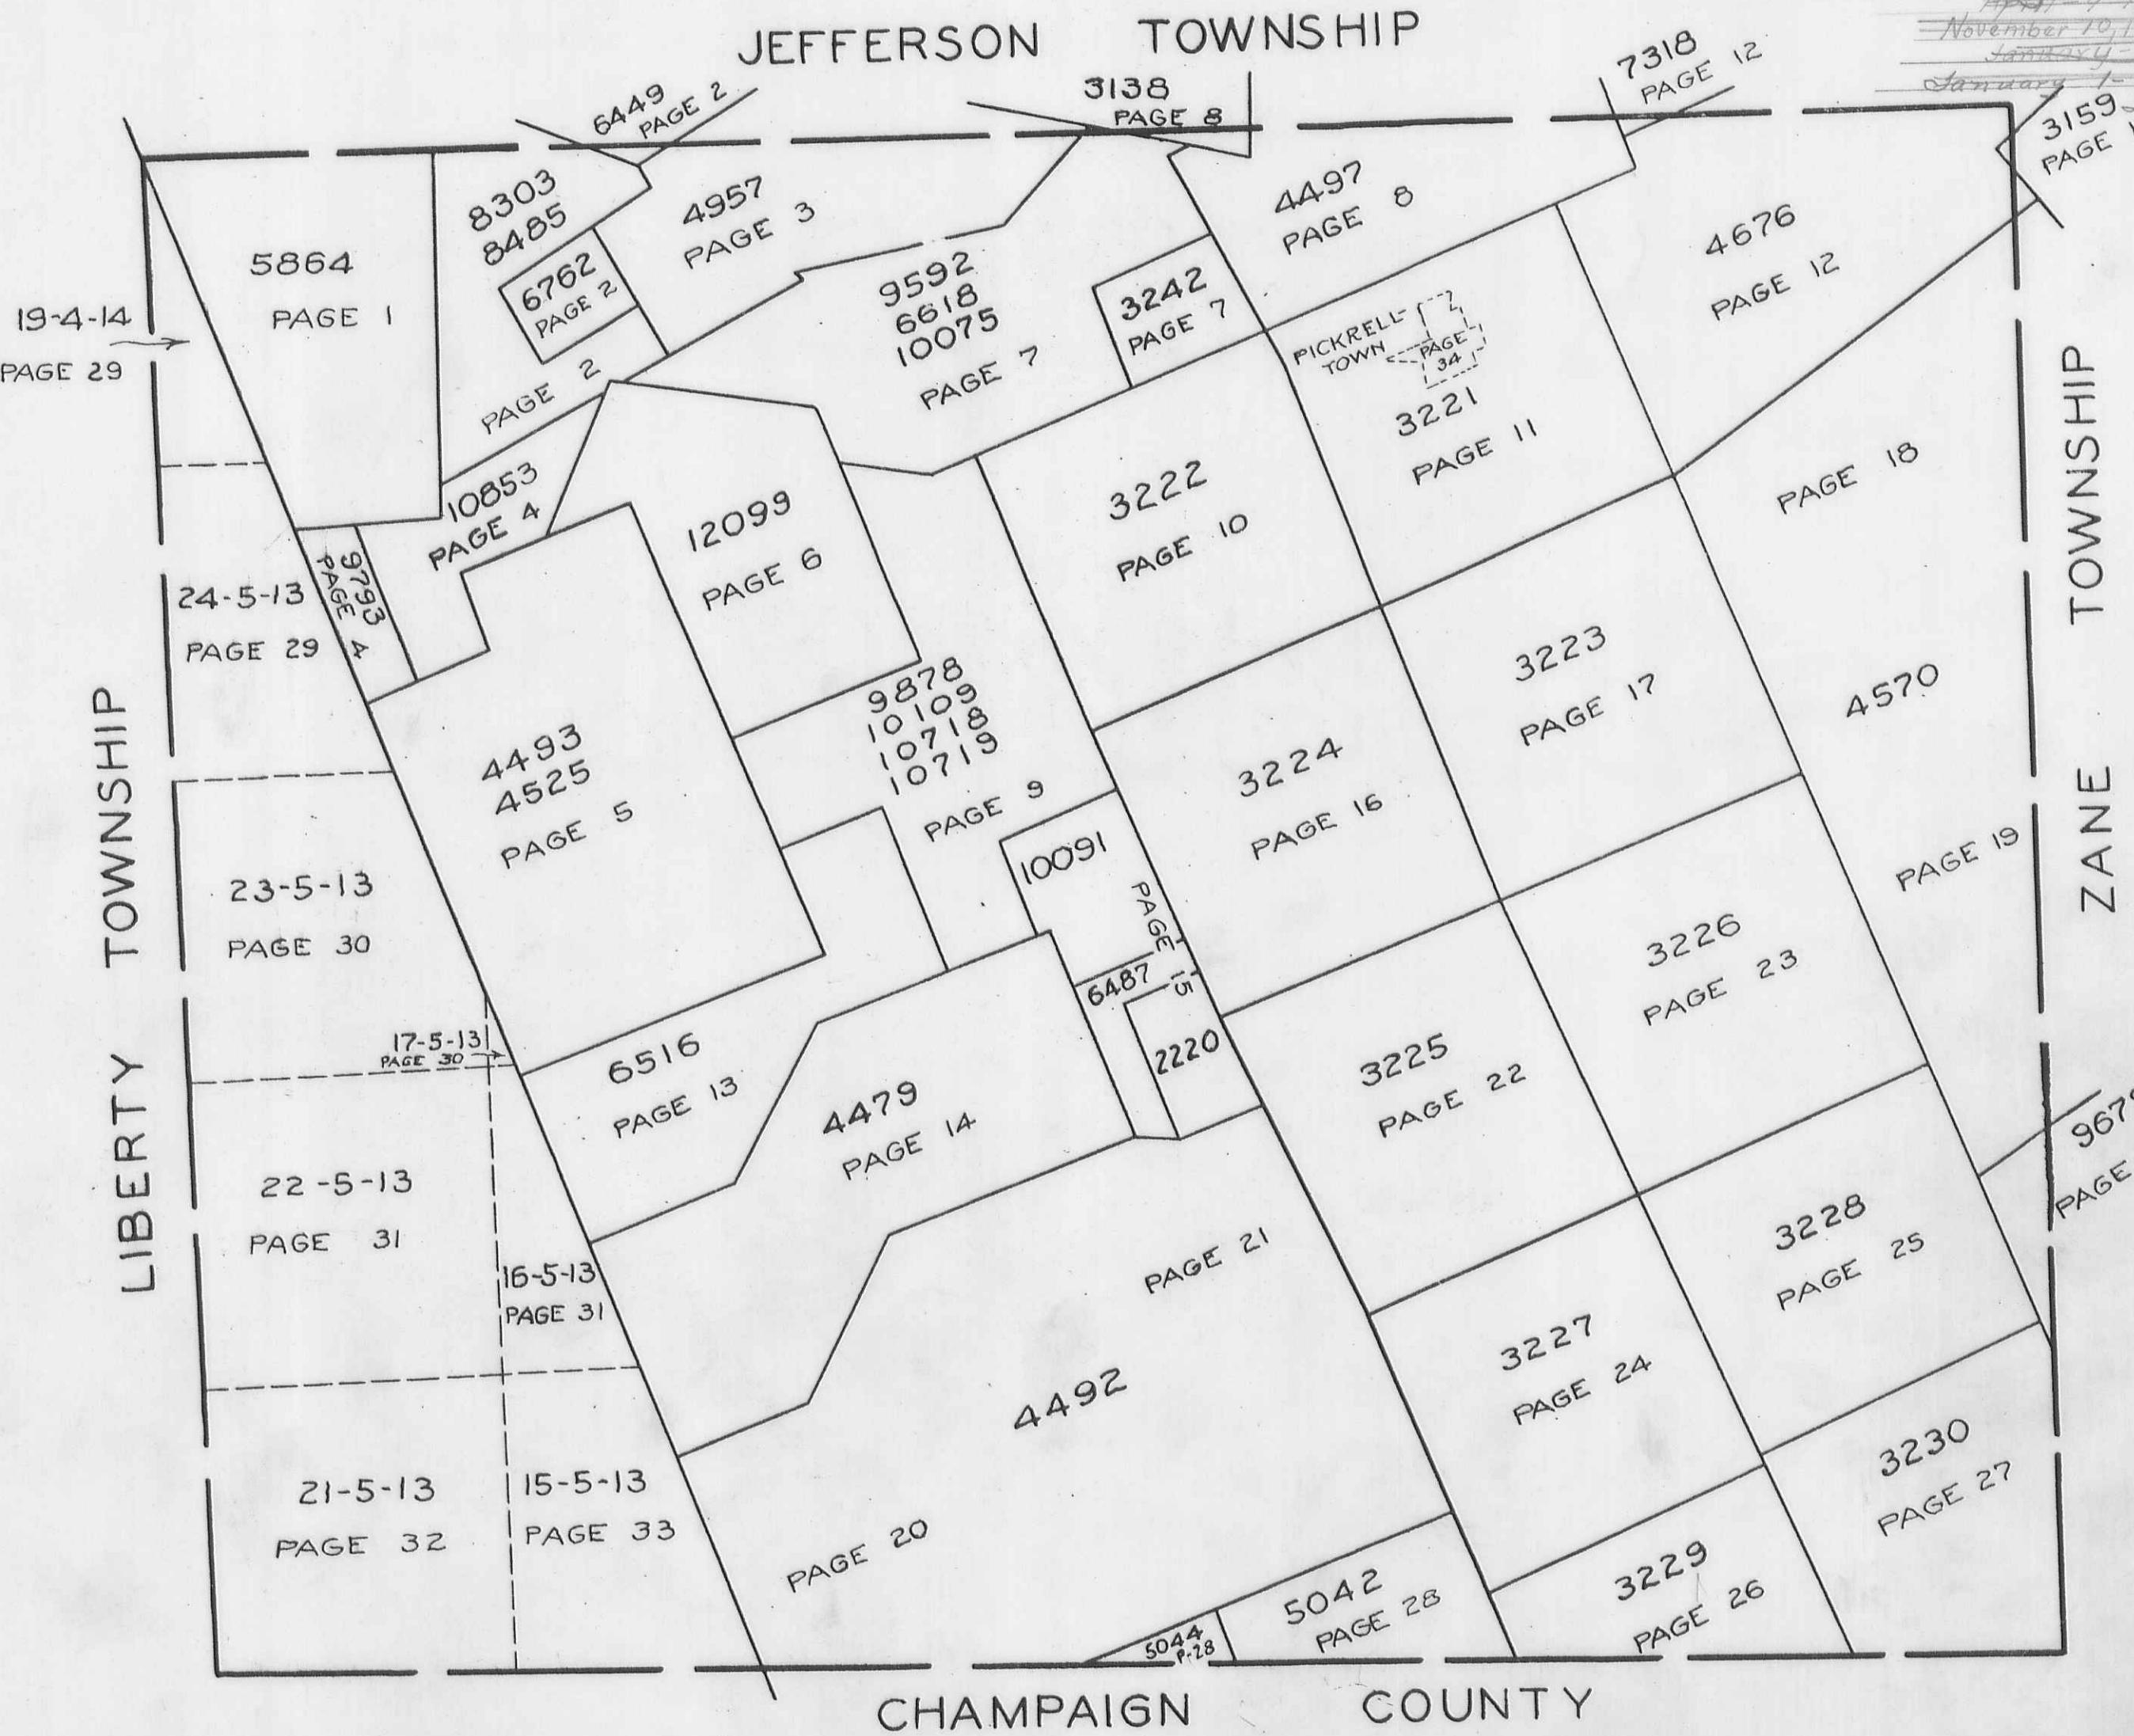


MONROE

TOWNSHIP

PAGE

VIRGINIA MILITARY SURVEY 5864

SCALE 10 CHAINS TO THE INCH

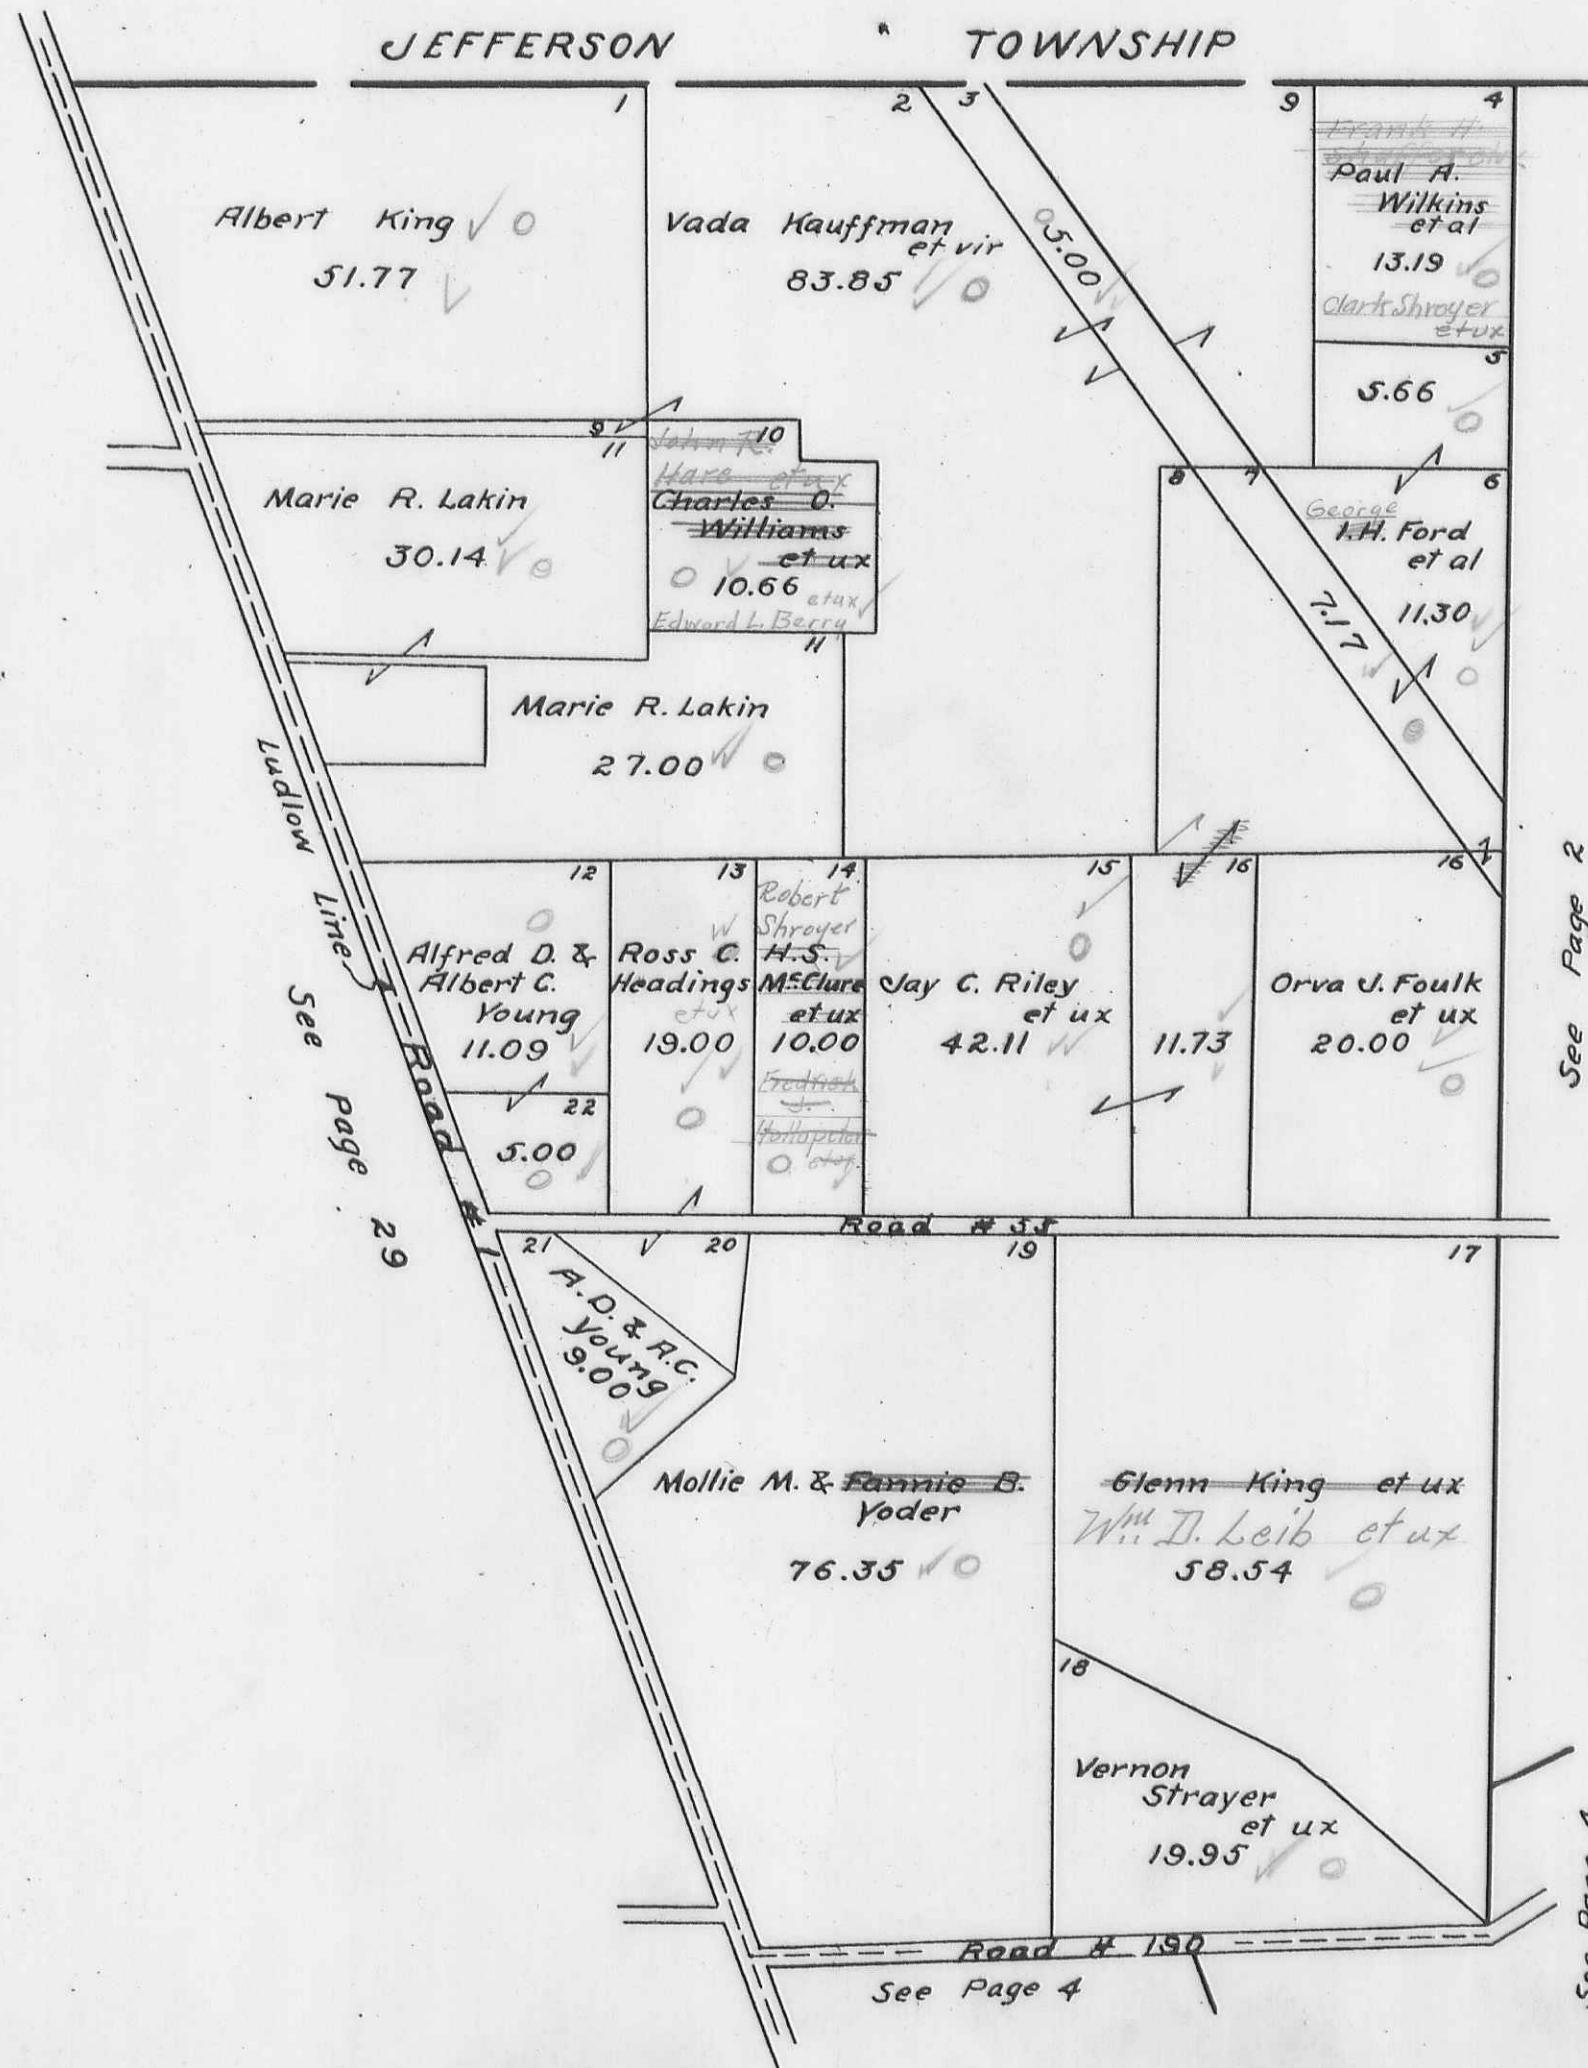


MONROE TOWNSHIP
VIRGINIA MILITARY SURVEYS
SCALE 10 CHAINS TO THE INCH

PAGE 2

{8303
8485
6449
6762


6449

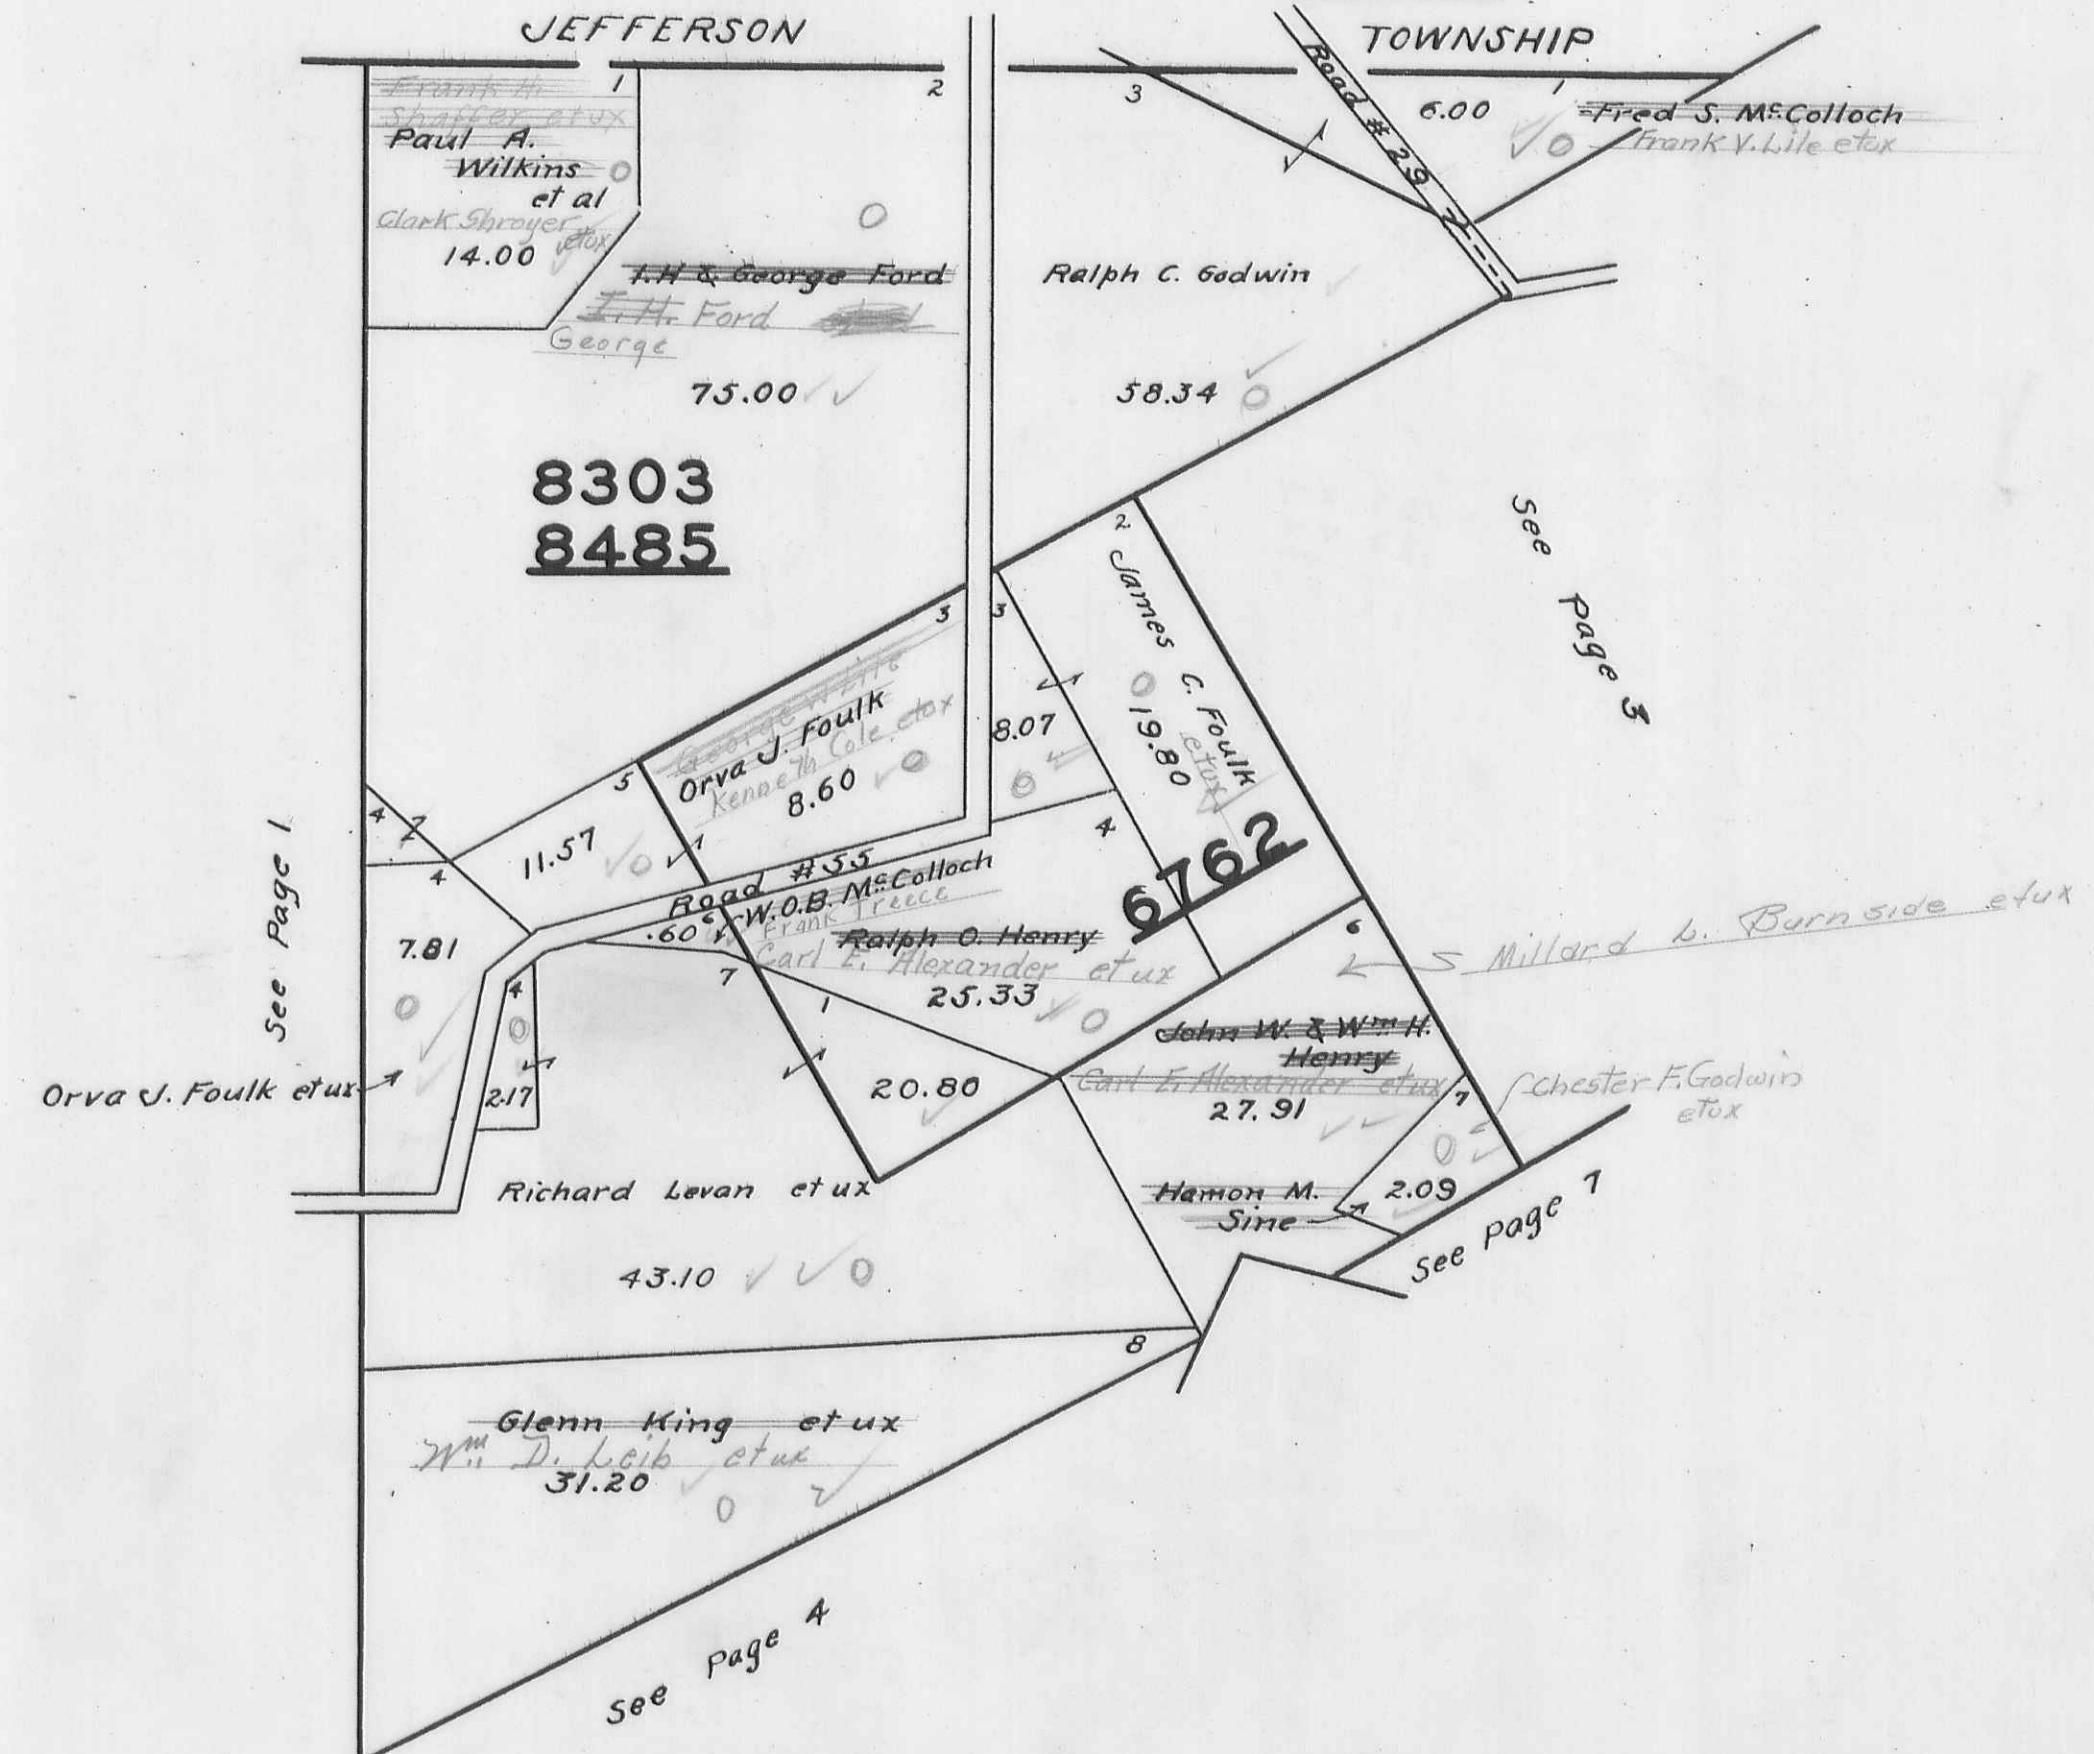

MONROE TOWNSHIP
VIRGINIA MILITARY SURVEY 4957

SCALE 10 CHAINS TO THE INCH


PAGE 3

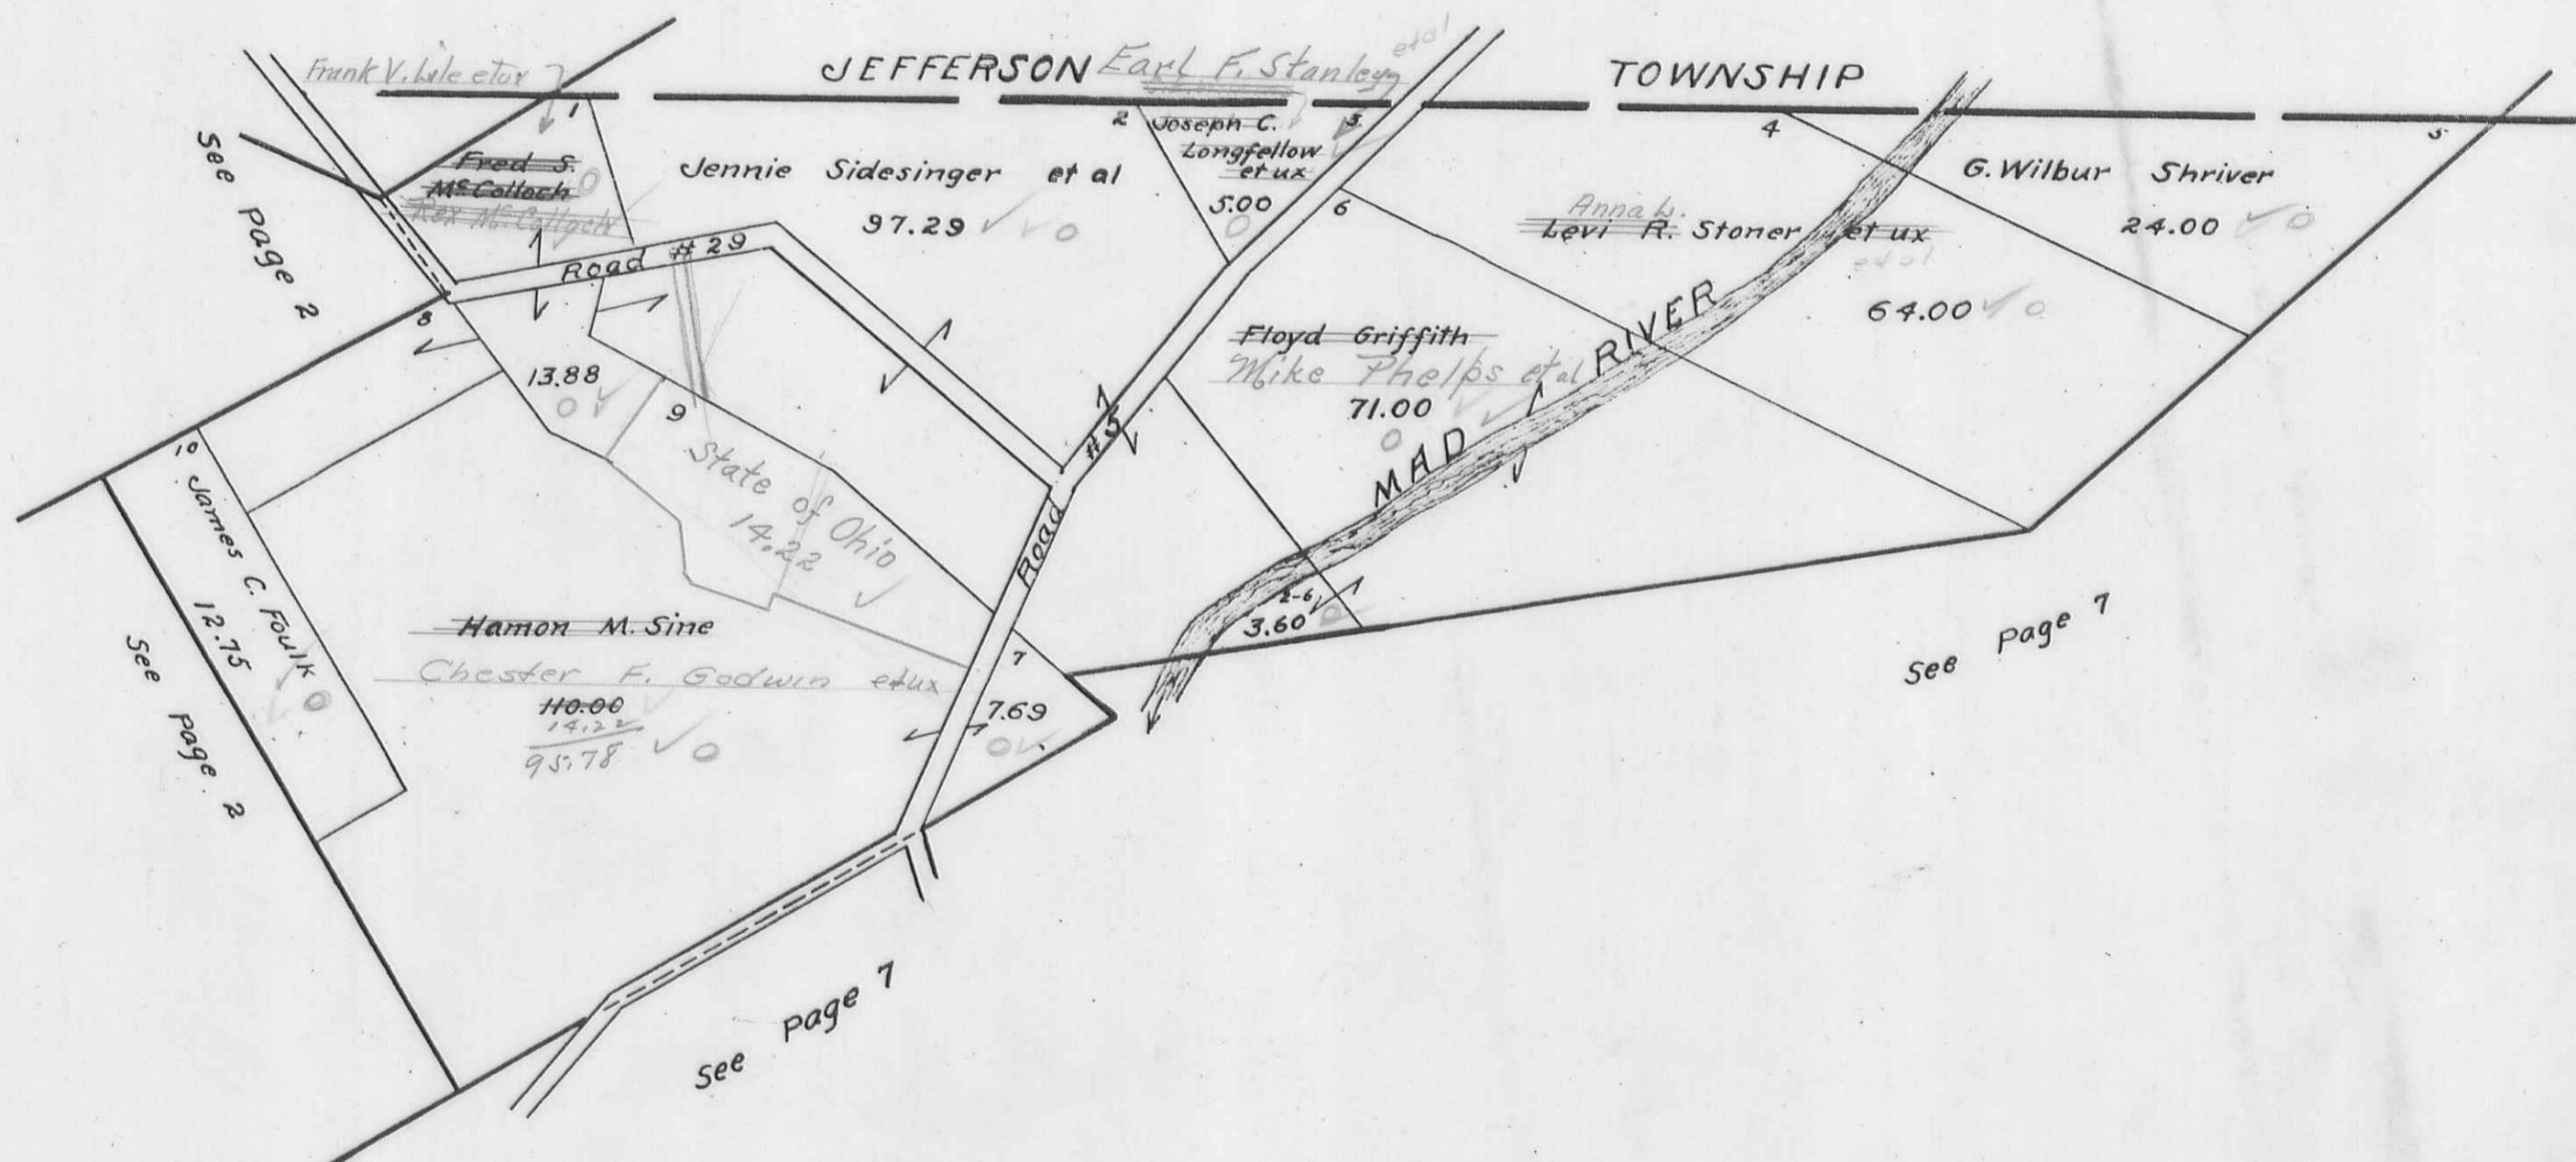

MONROE TOWNSHIP
VIRGINIA MILITARY SURVEYS 9793
10853

PAGE 4


SCALE 10 CHAINS TO THE INCH

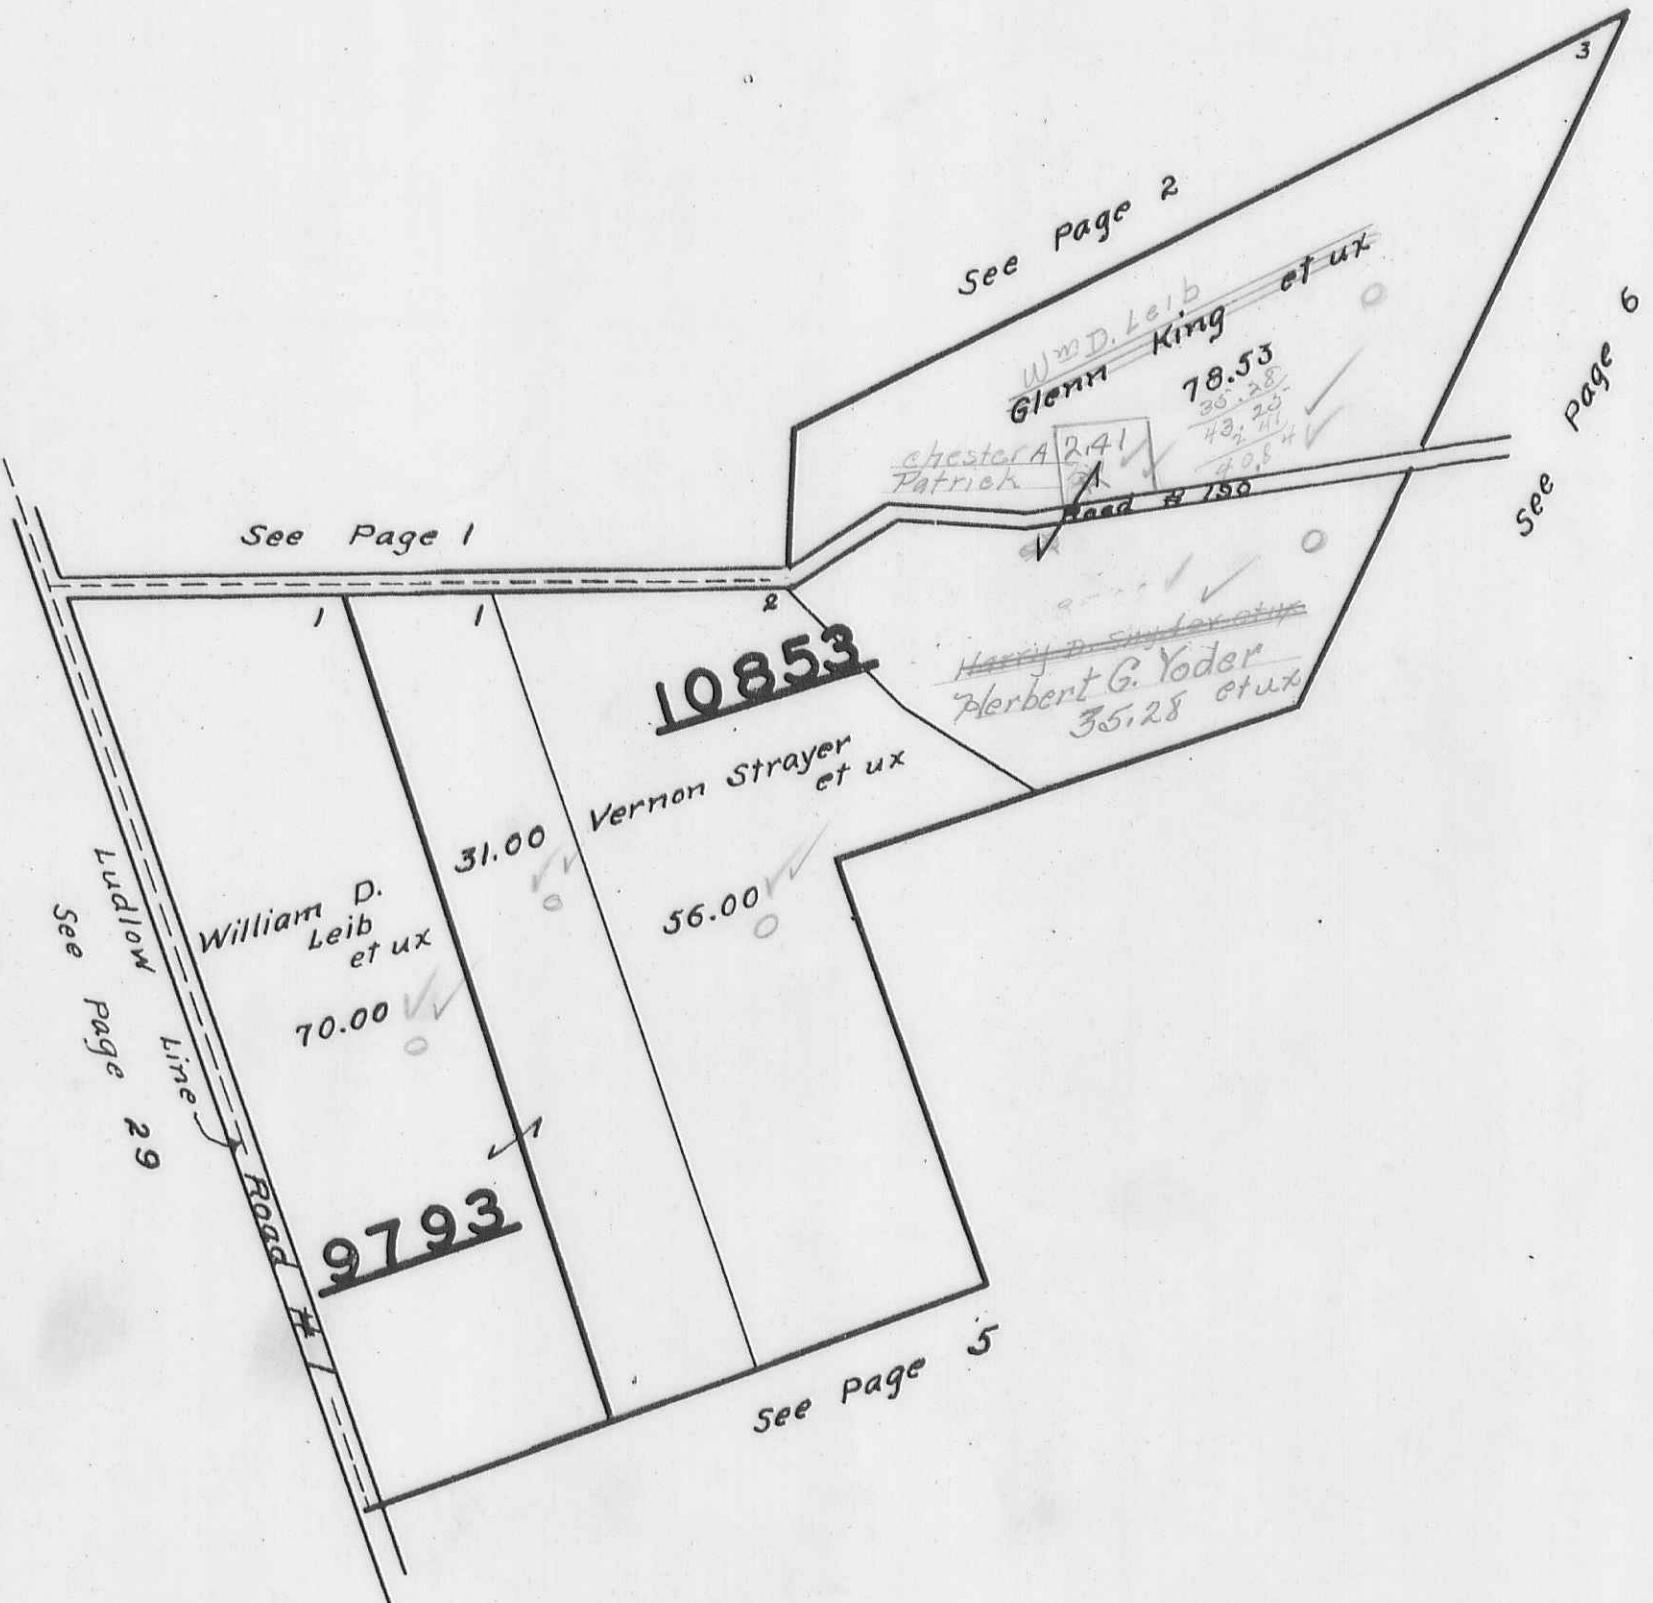

MONROE TOWNSHIP
VIRGINIA MILITARY SURVEYS {4493
 {4525

5

SCALE 10 CHAINS TO THE INCH

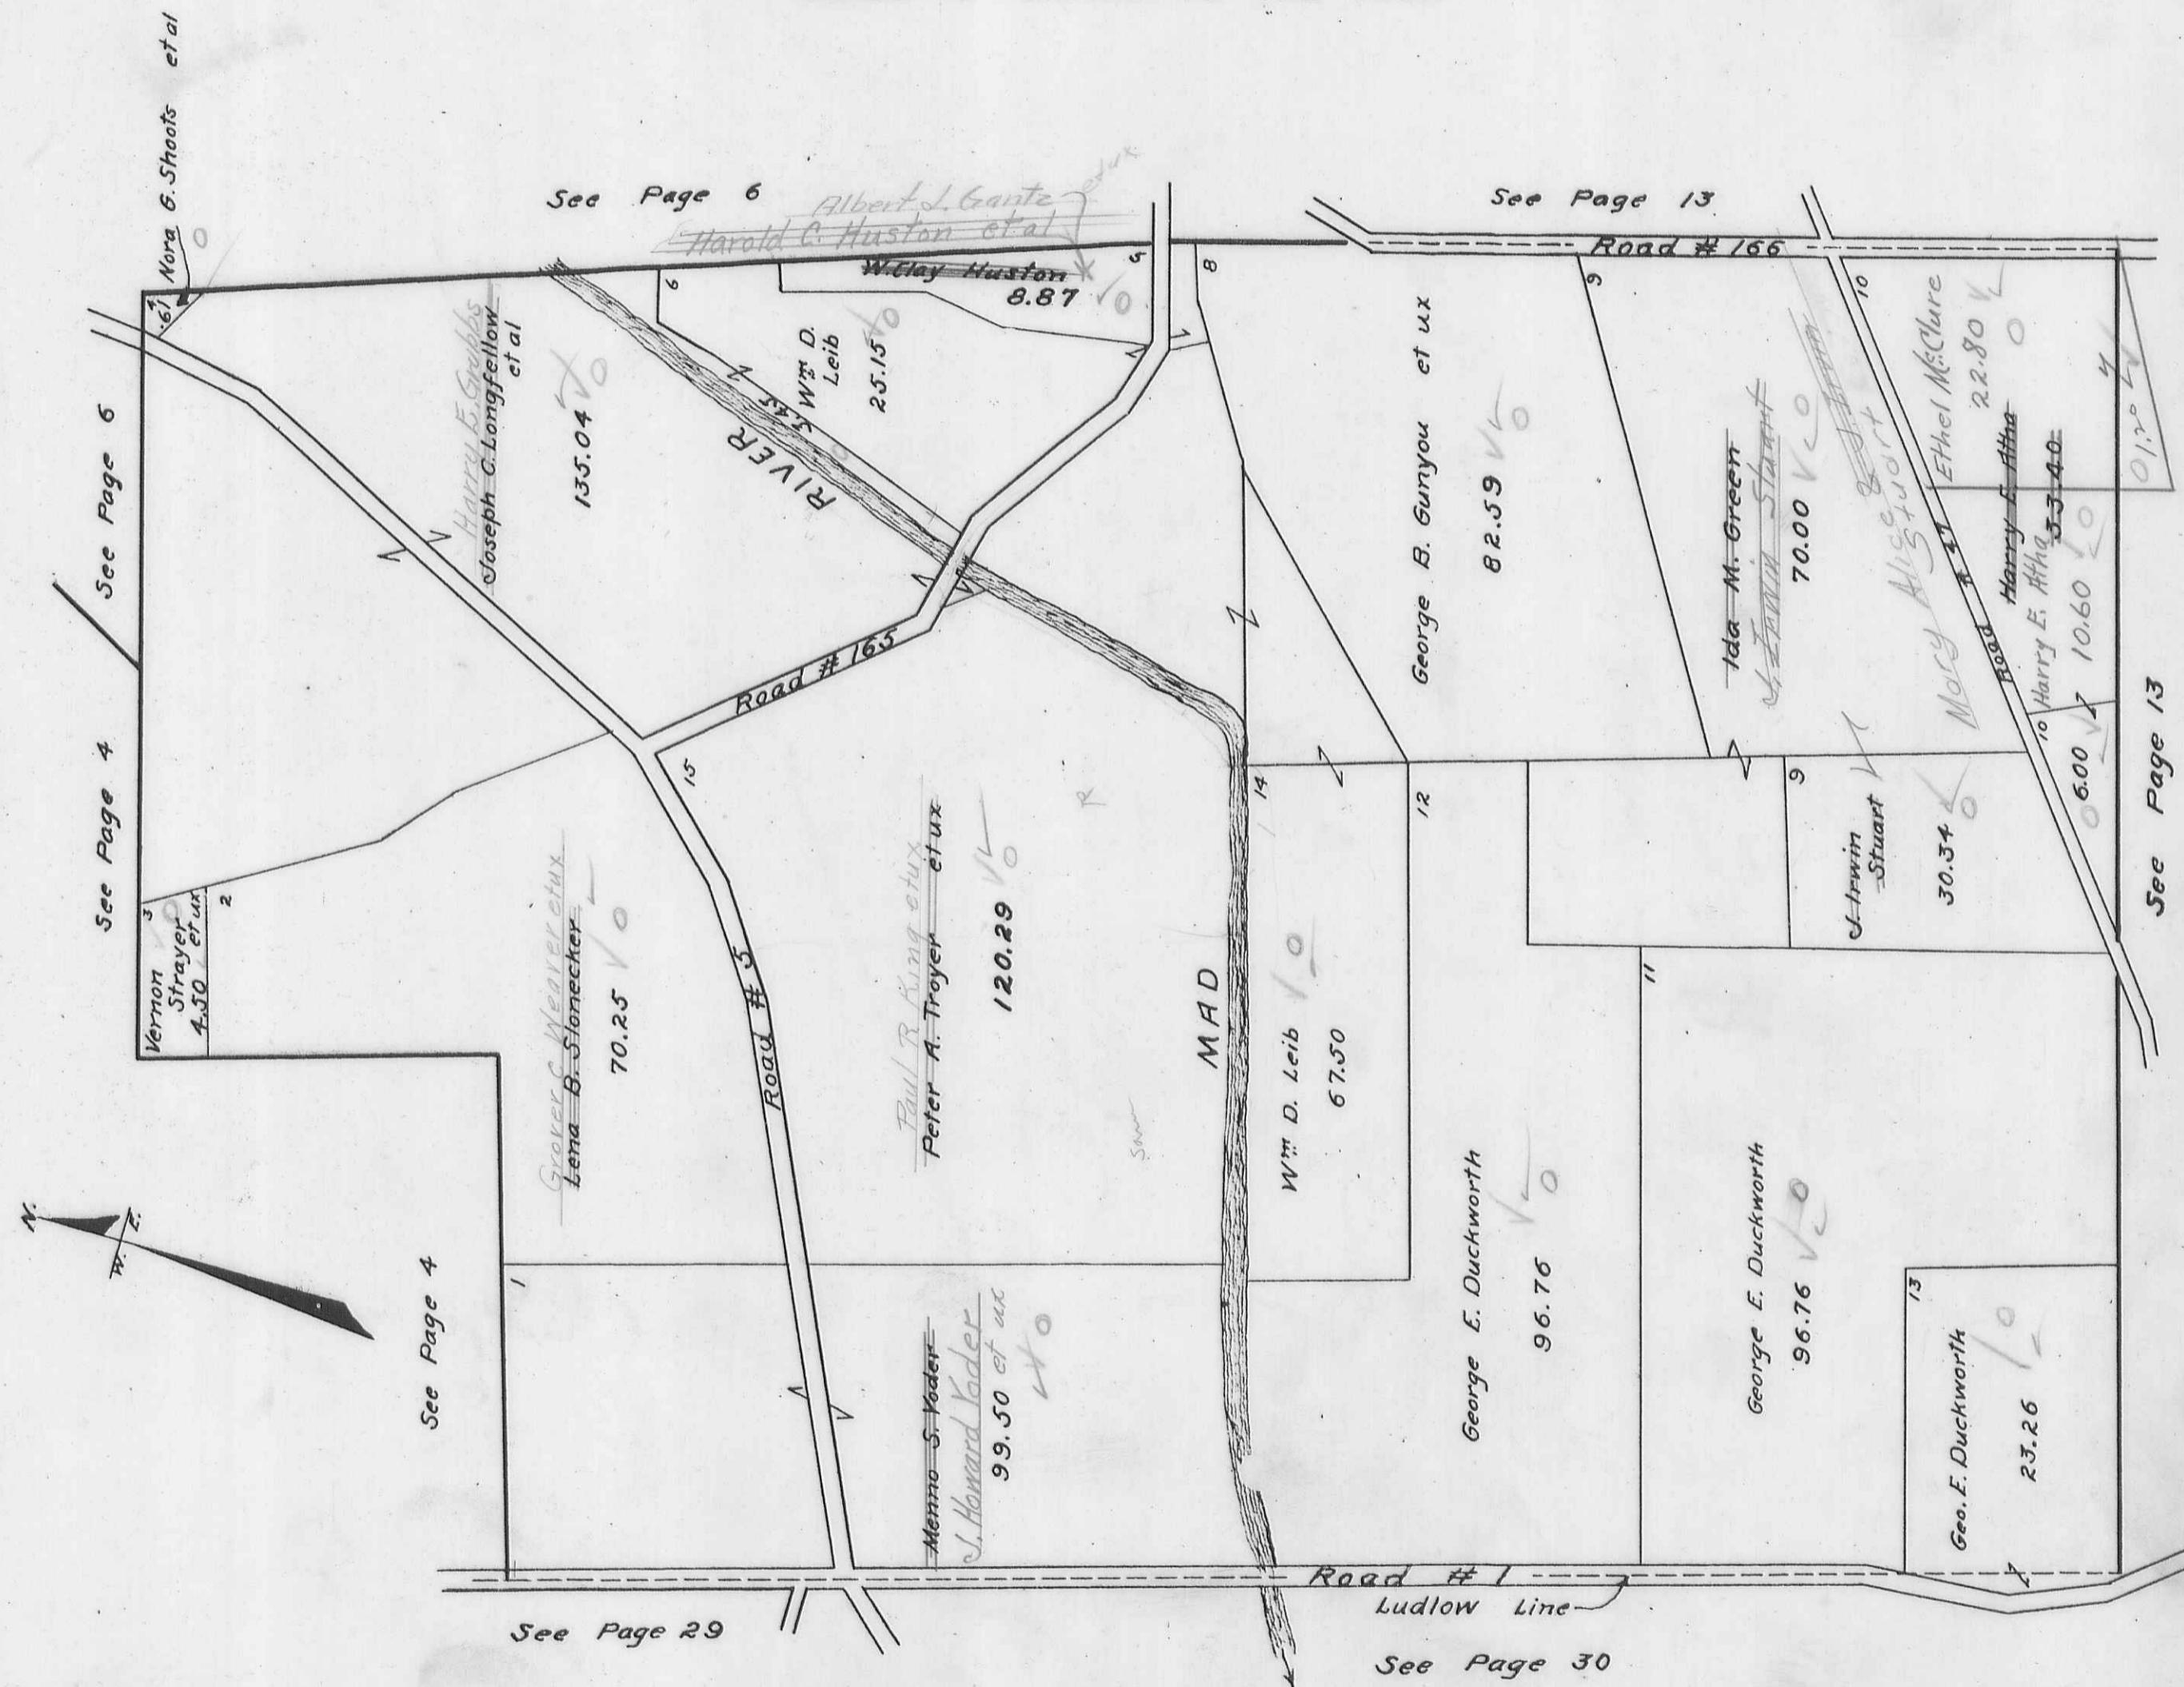

H.E. Dysent


MONROE TOWNSHIP

PAGE

6

VIRGINIA MILITARY SURVEY 12099

SCALE 10 CHAINS TO THE INCH

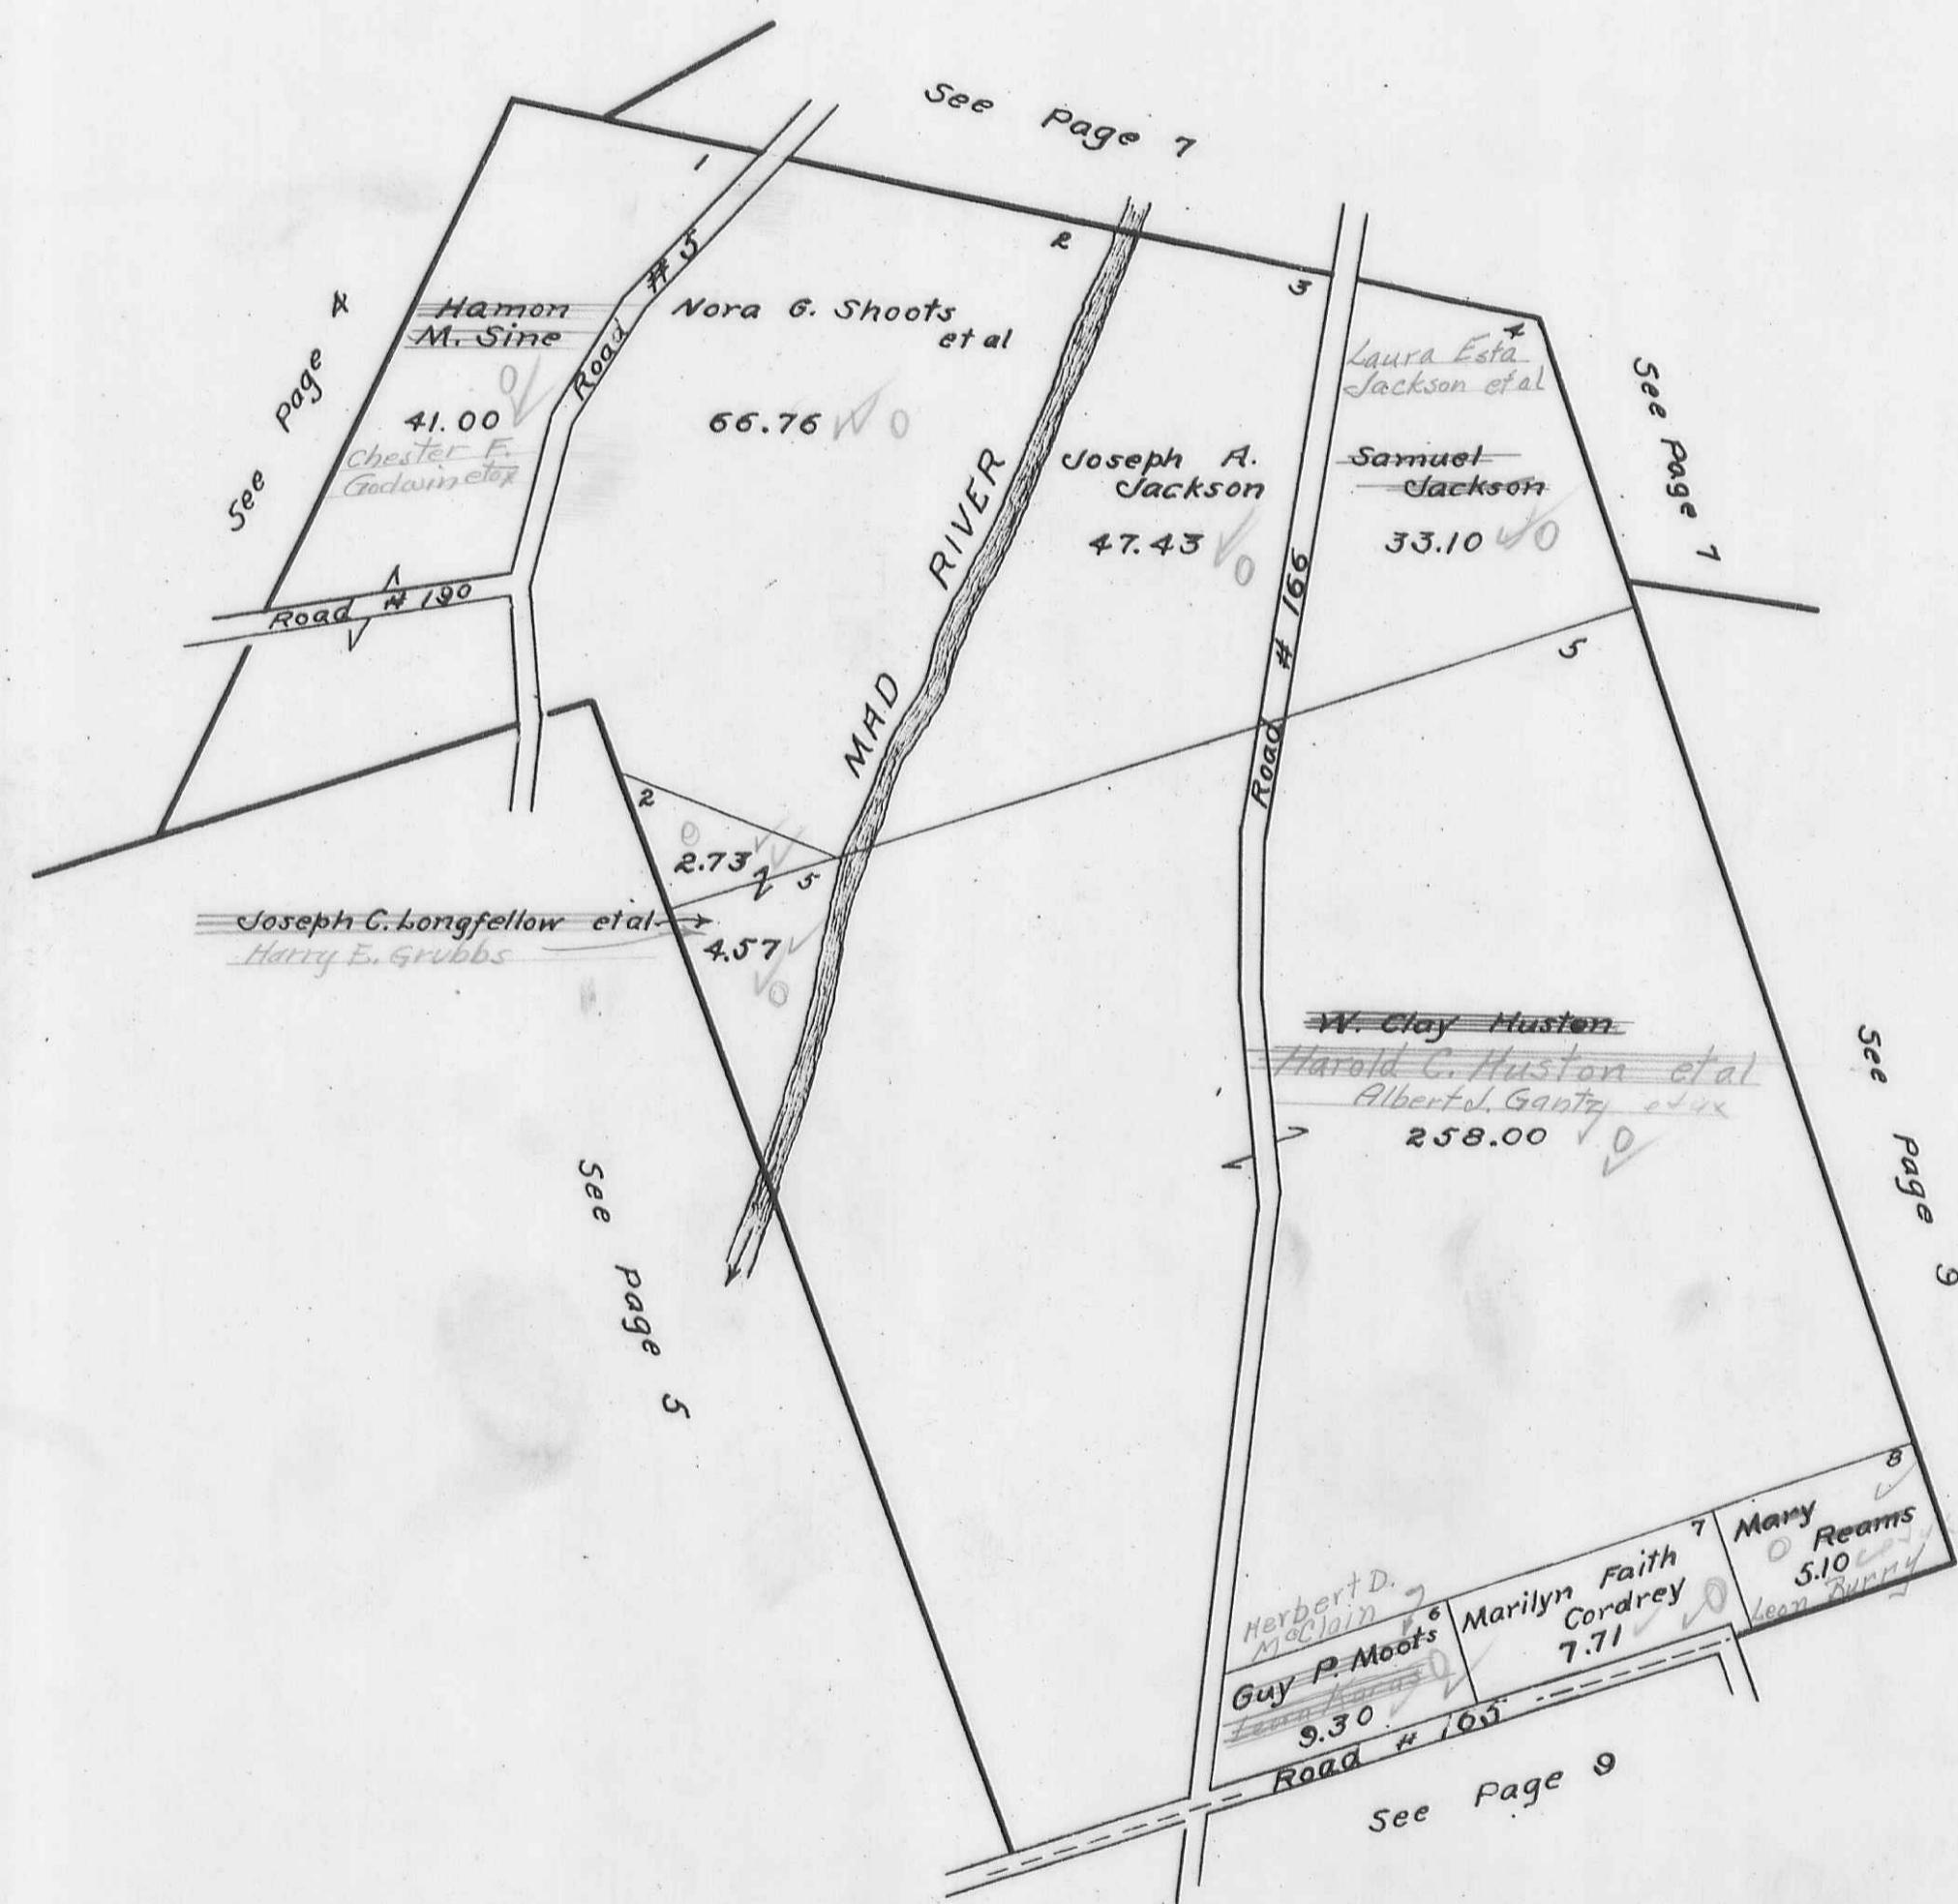

MONROE

TOWNSHIP


VIRGINIA MILITARY SURVEYS

SCALE 10 CHAINS TO THE INCH

PAGE

7

9592
9618
10075
3242

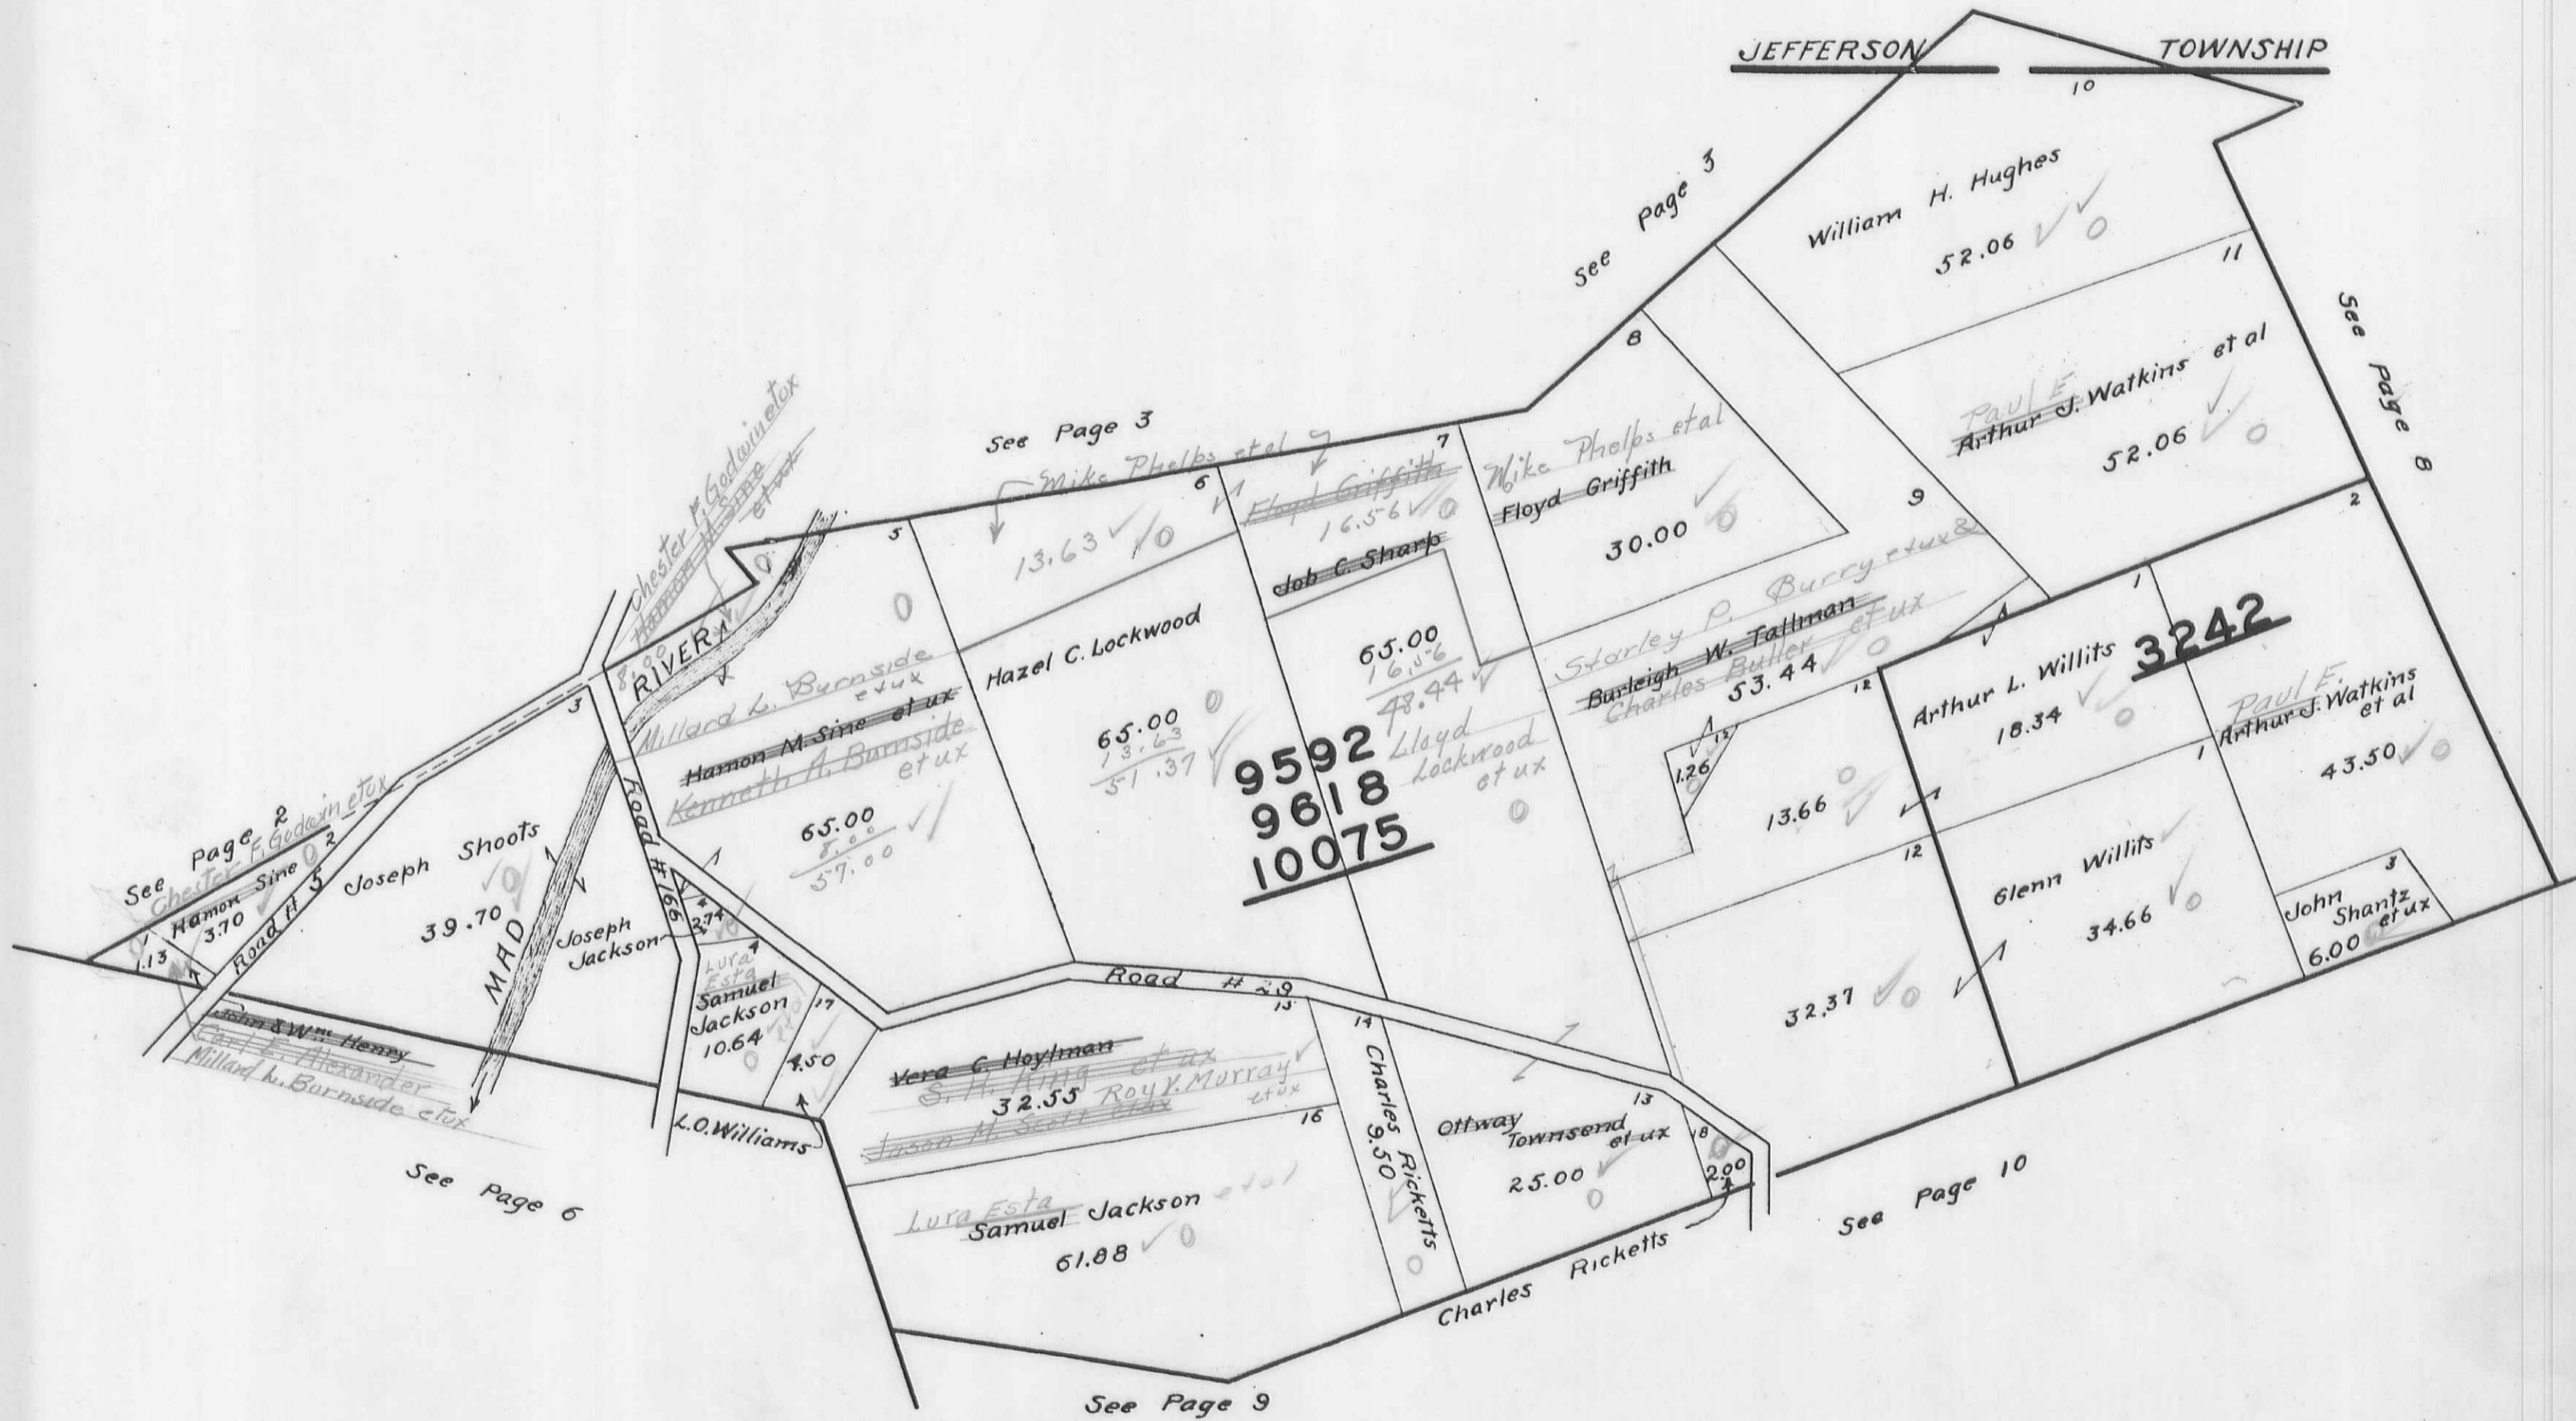


MONROE TOWNSHIP
VIRGINIA MILITARY SURVEYS 3138
4497

SCALE 10 CHAINS TO THE INCH

PAGE

8

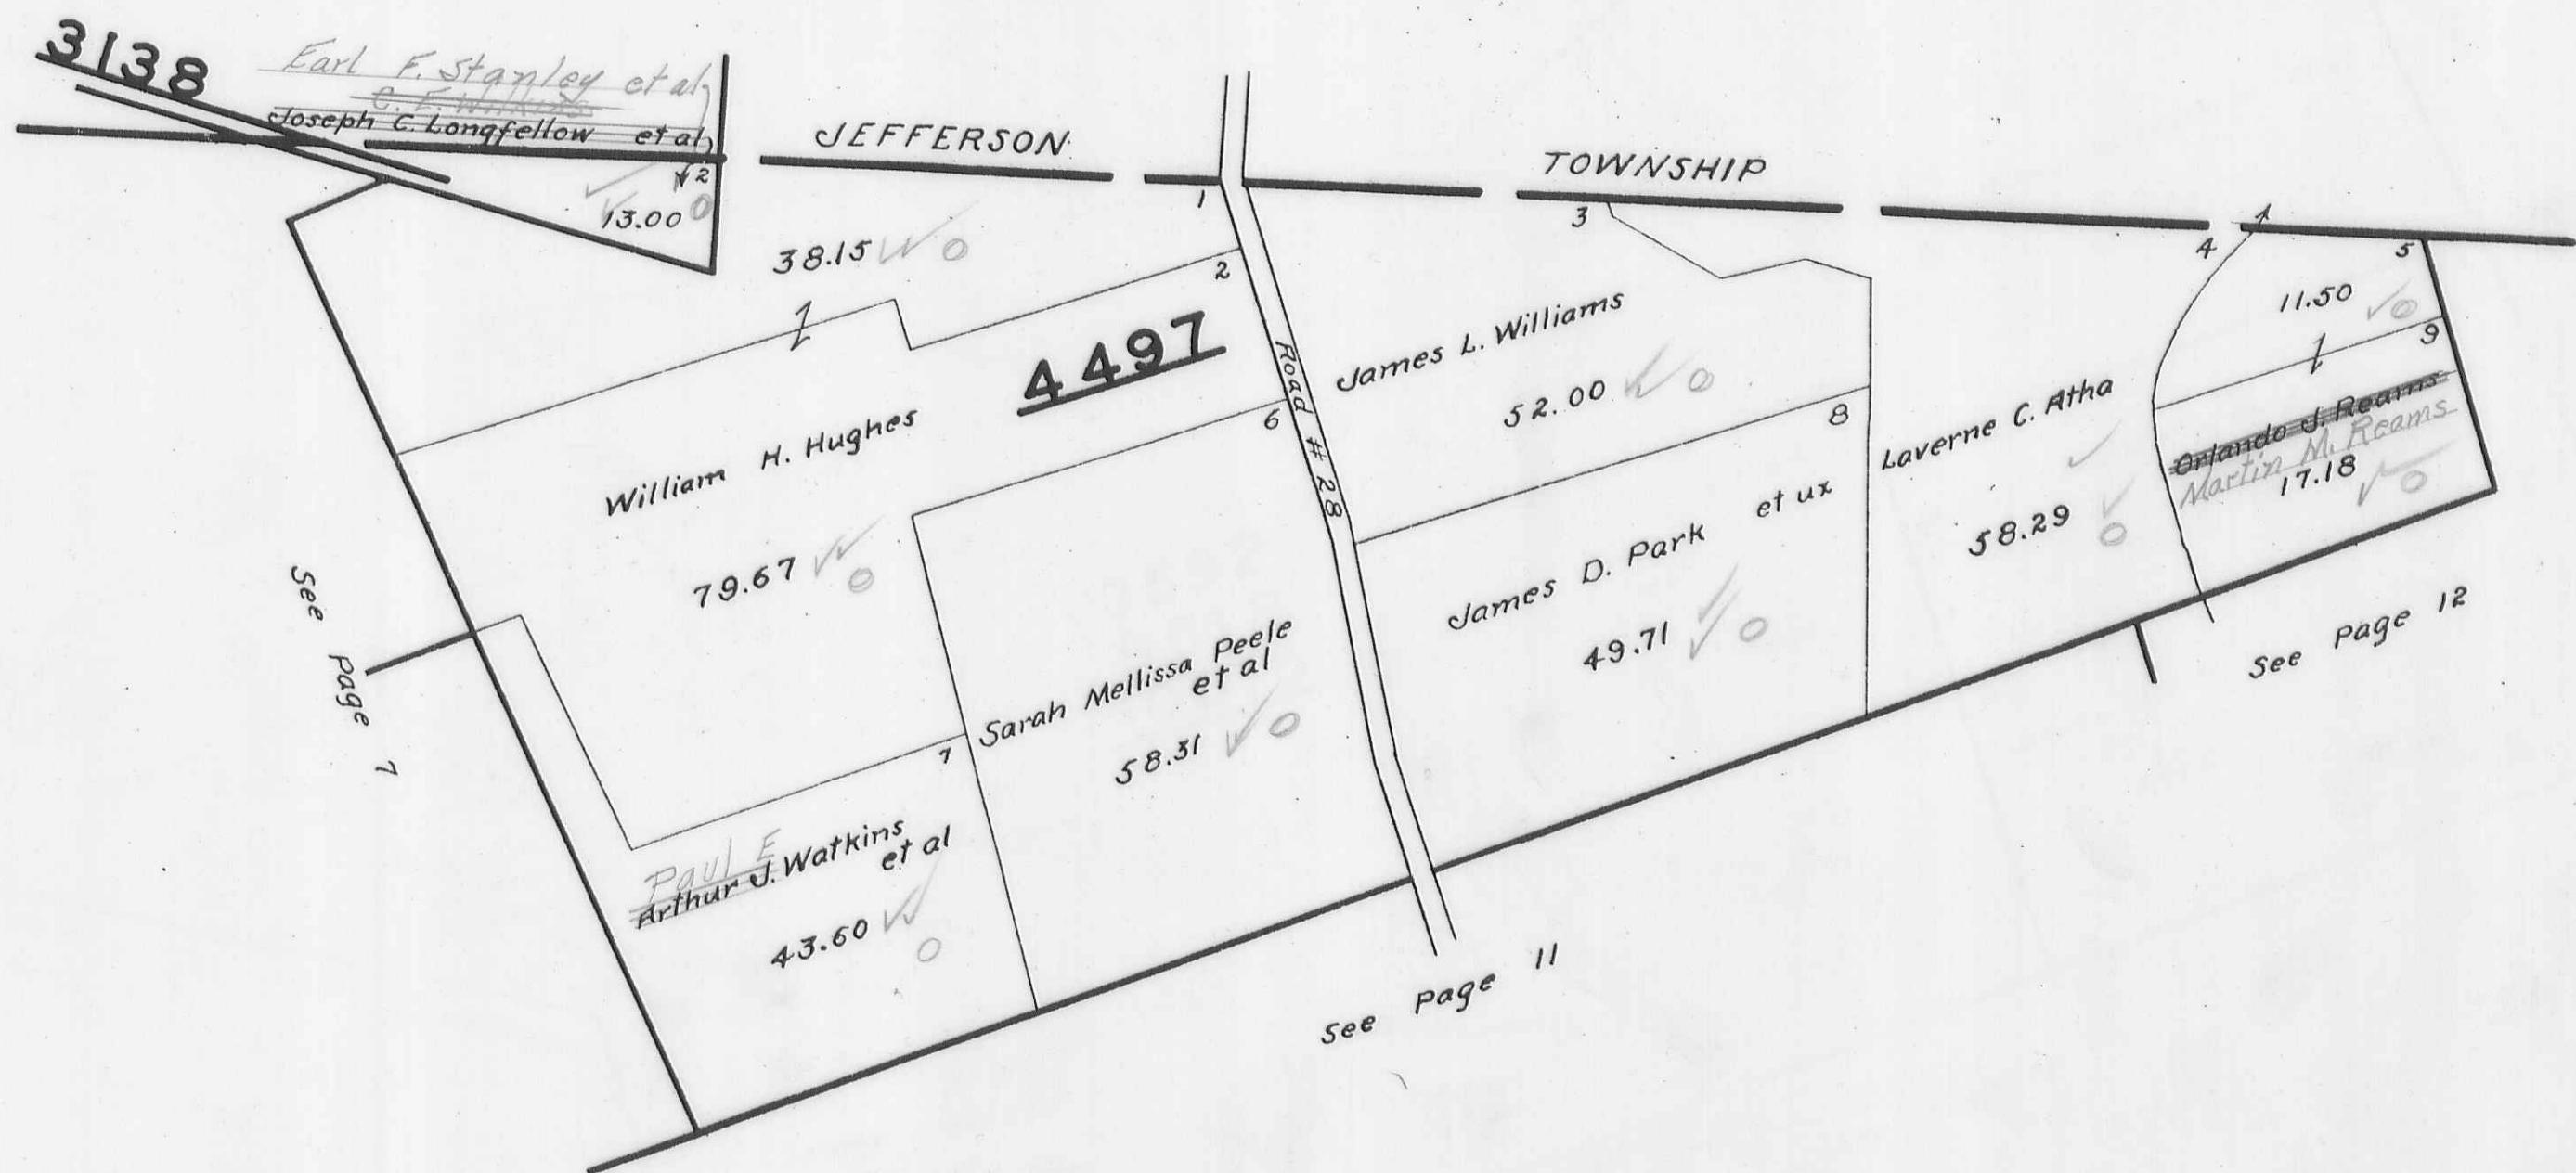

MONROE TOWNSHIP
VIRGINIA MILITARY SURVEYS

SCALE 10 CHAINS TO THE INCH

9878
10109
10718
10719


PAGE 9



MONROE TOWNSHIP
VIRGINIA MILITARY SURVEY 3222


SCALE 10 CHAINS TO THE INCH

PAGE 10

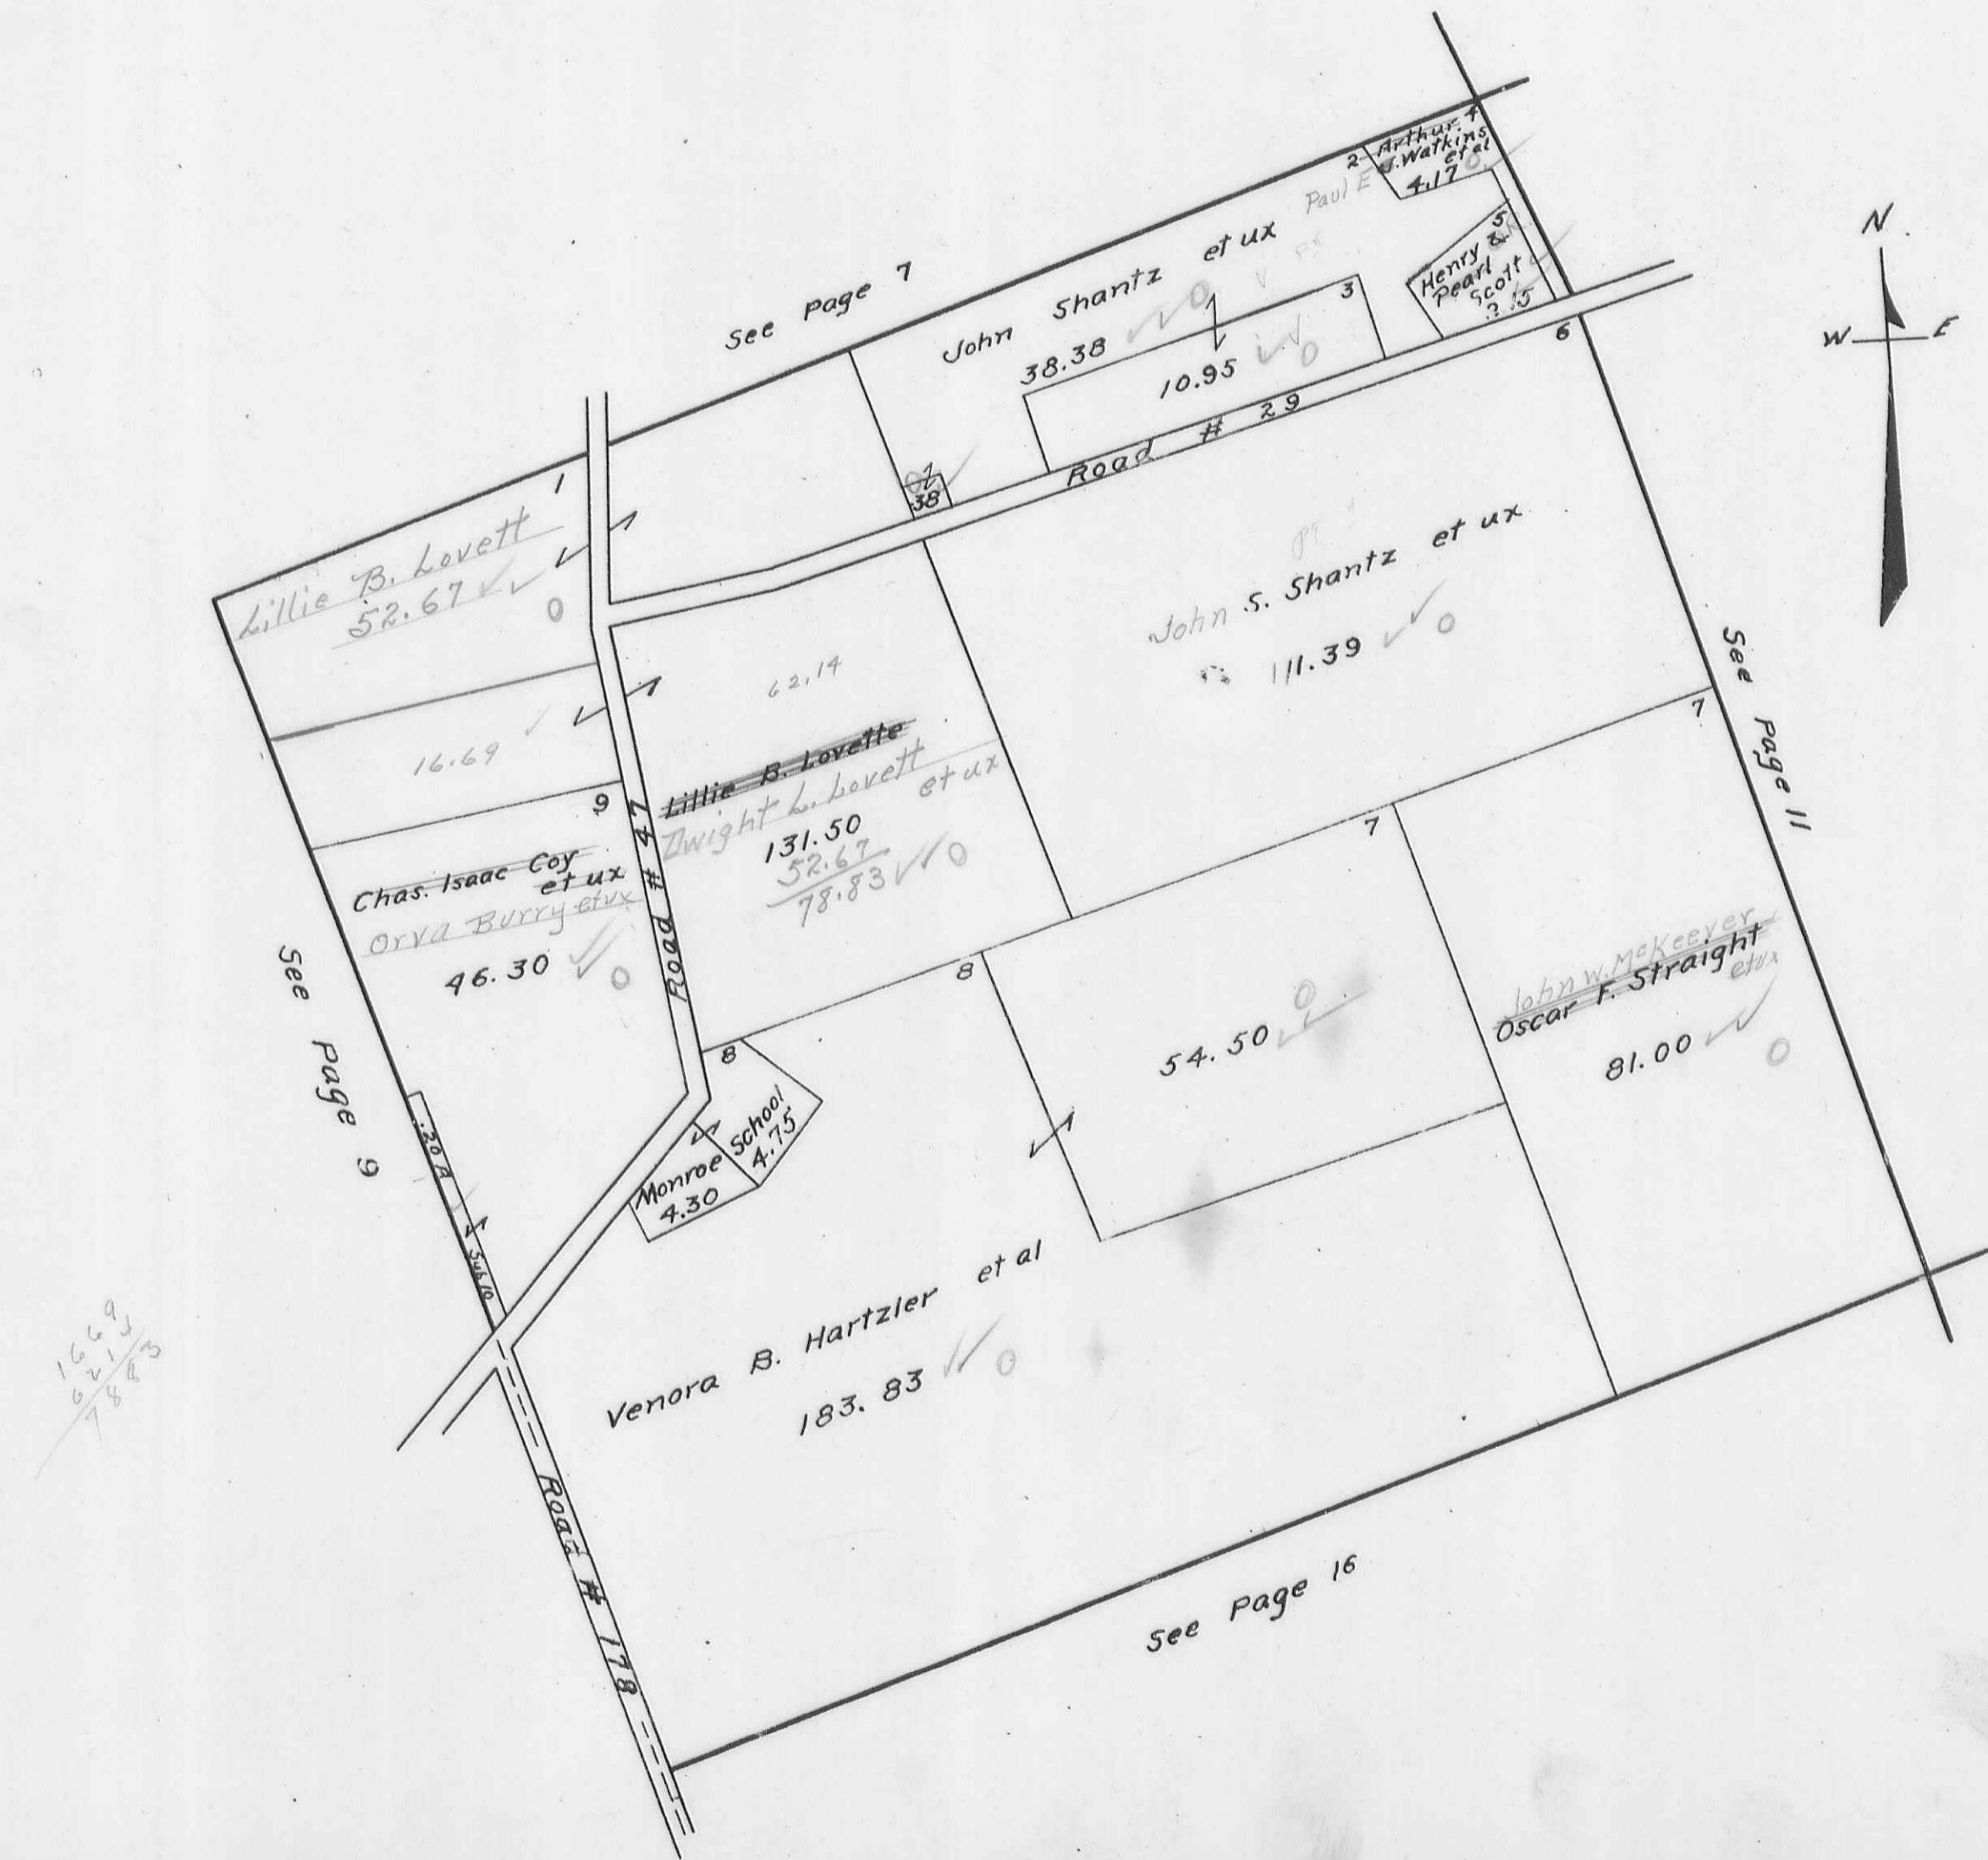

MONROE TOWNSHIP
VIRGINIA MILITARY SURVEY 3221


SCALE 10 CHAINS TO THE INCH

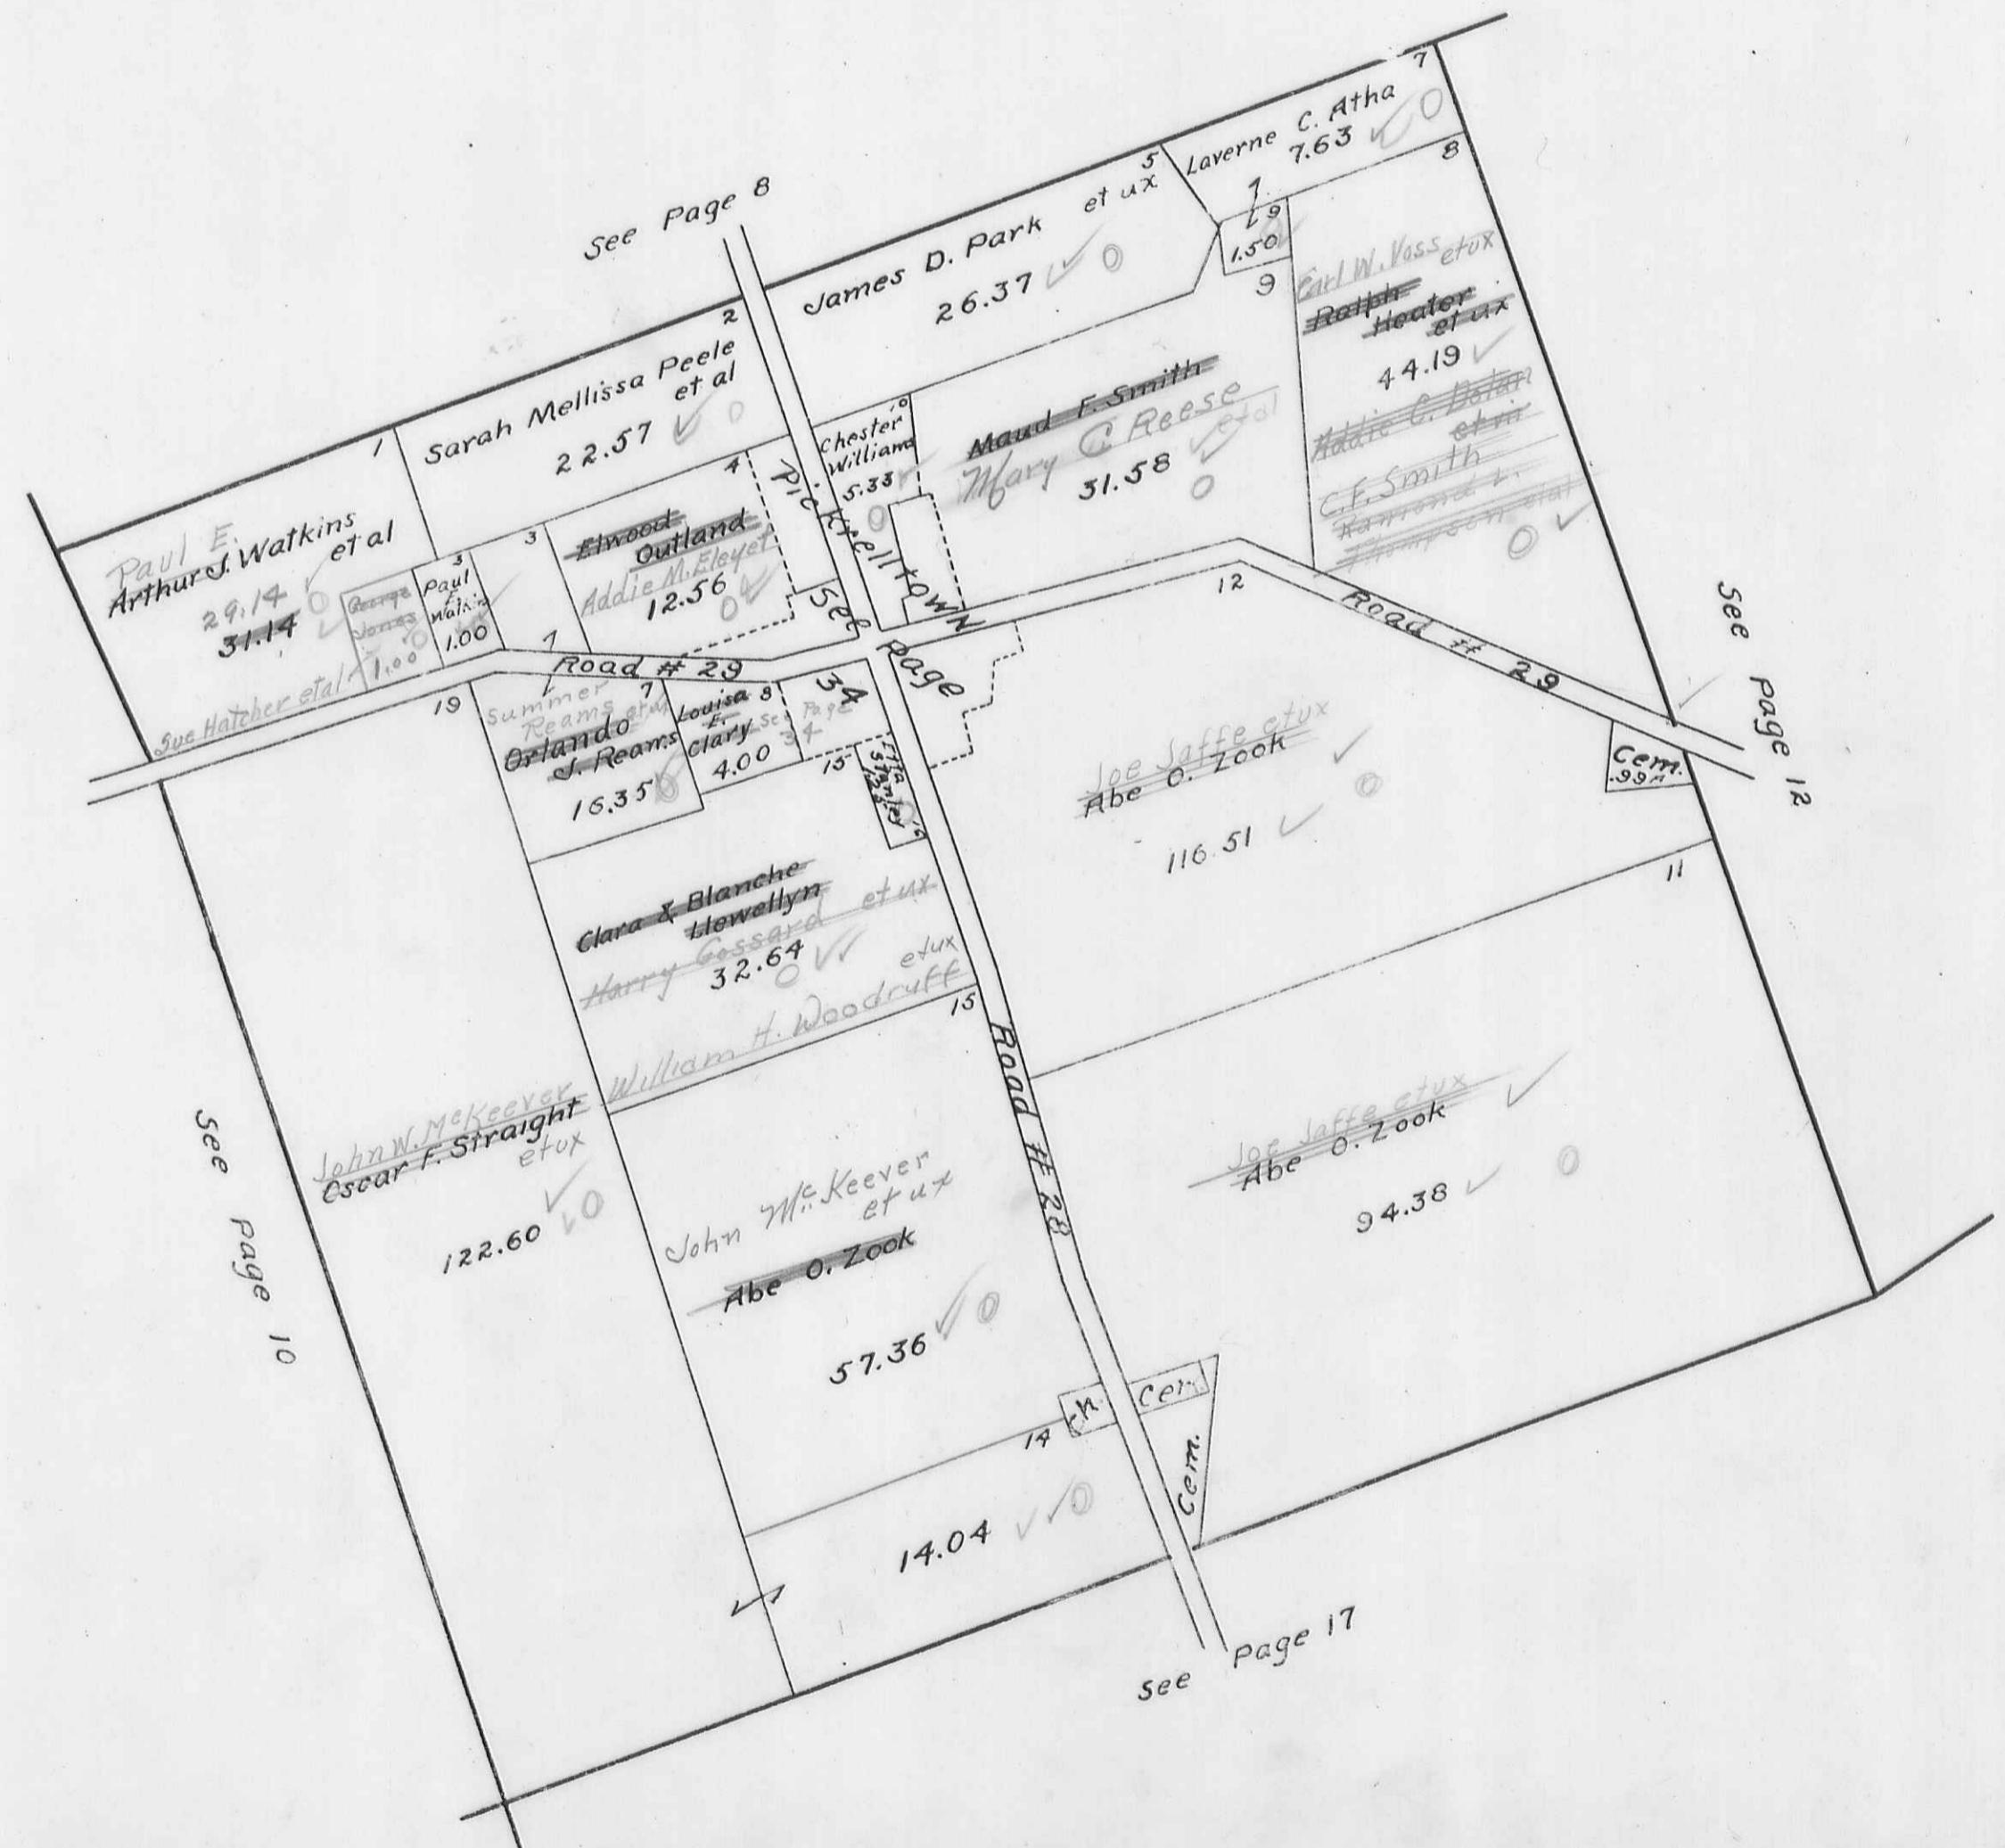

MONROE TOWNSHIP
VIRGINIA MILITARY SURVEYS
SCALE 10 CHAINS TO THE INCH

3159
4676
7318


PAGE 12

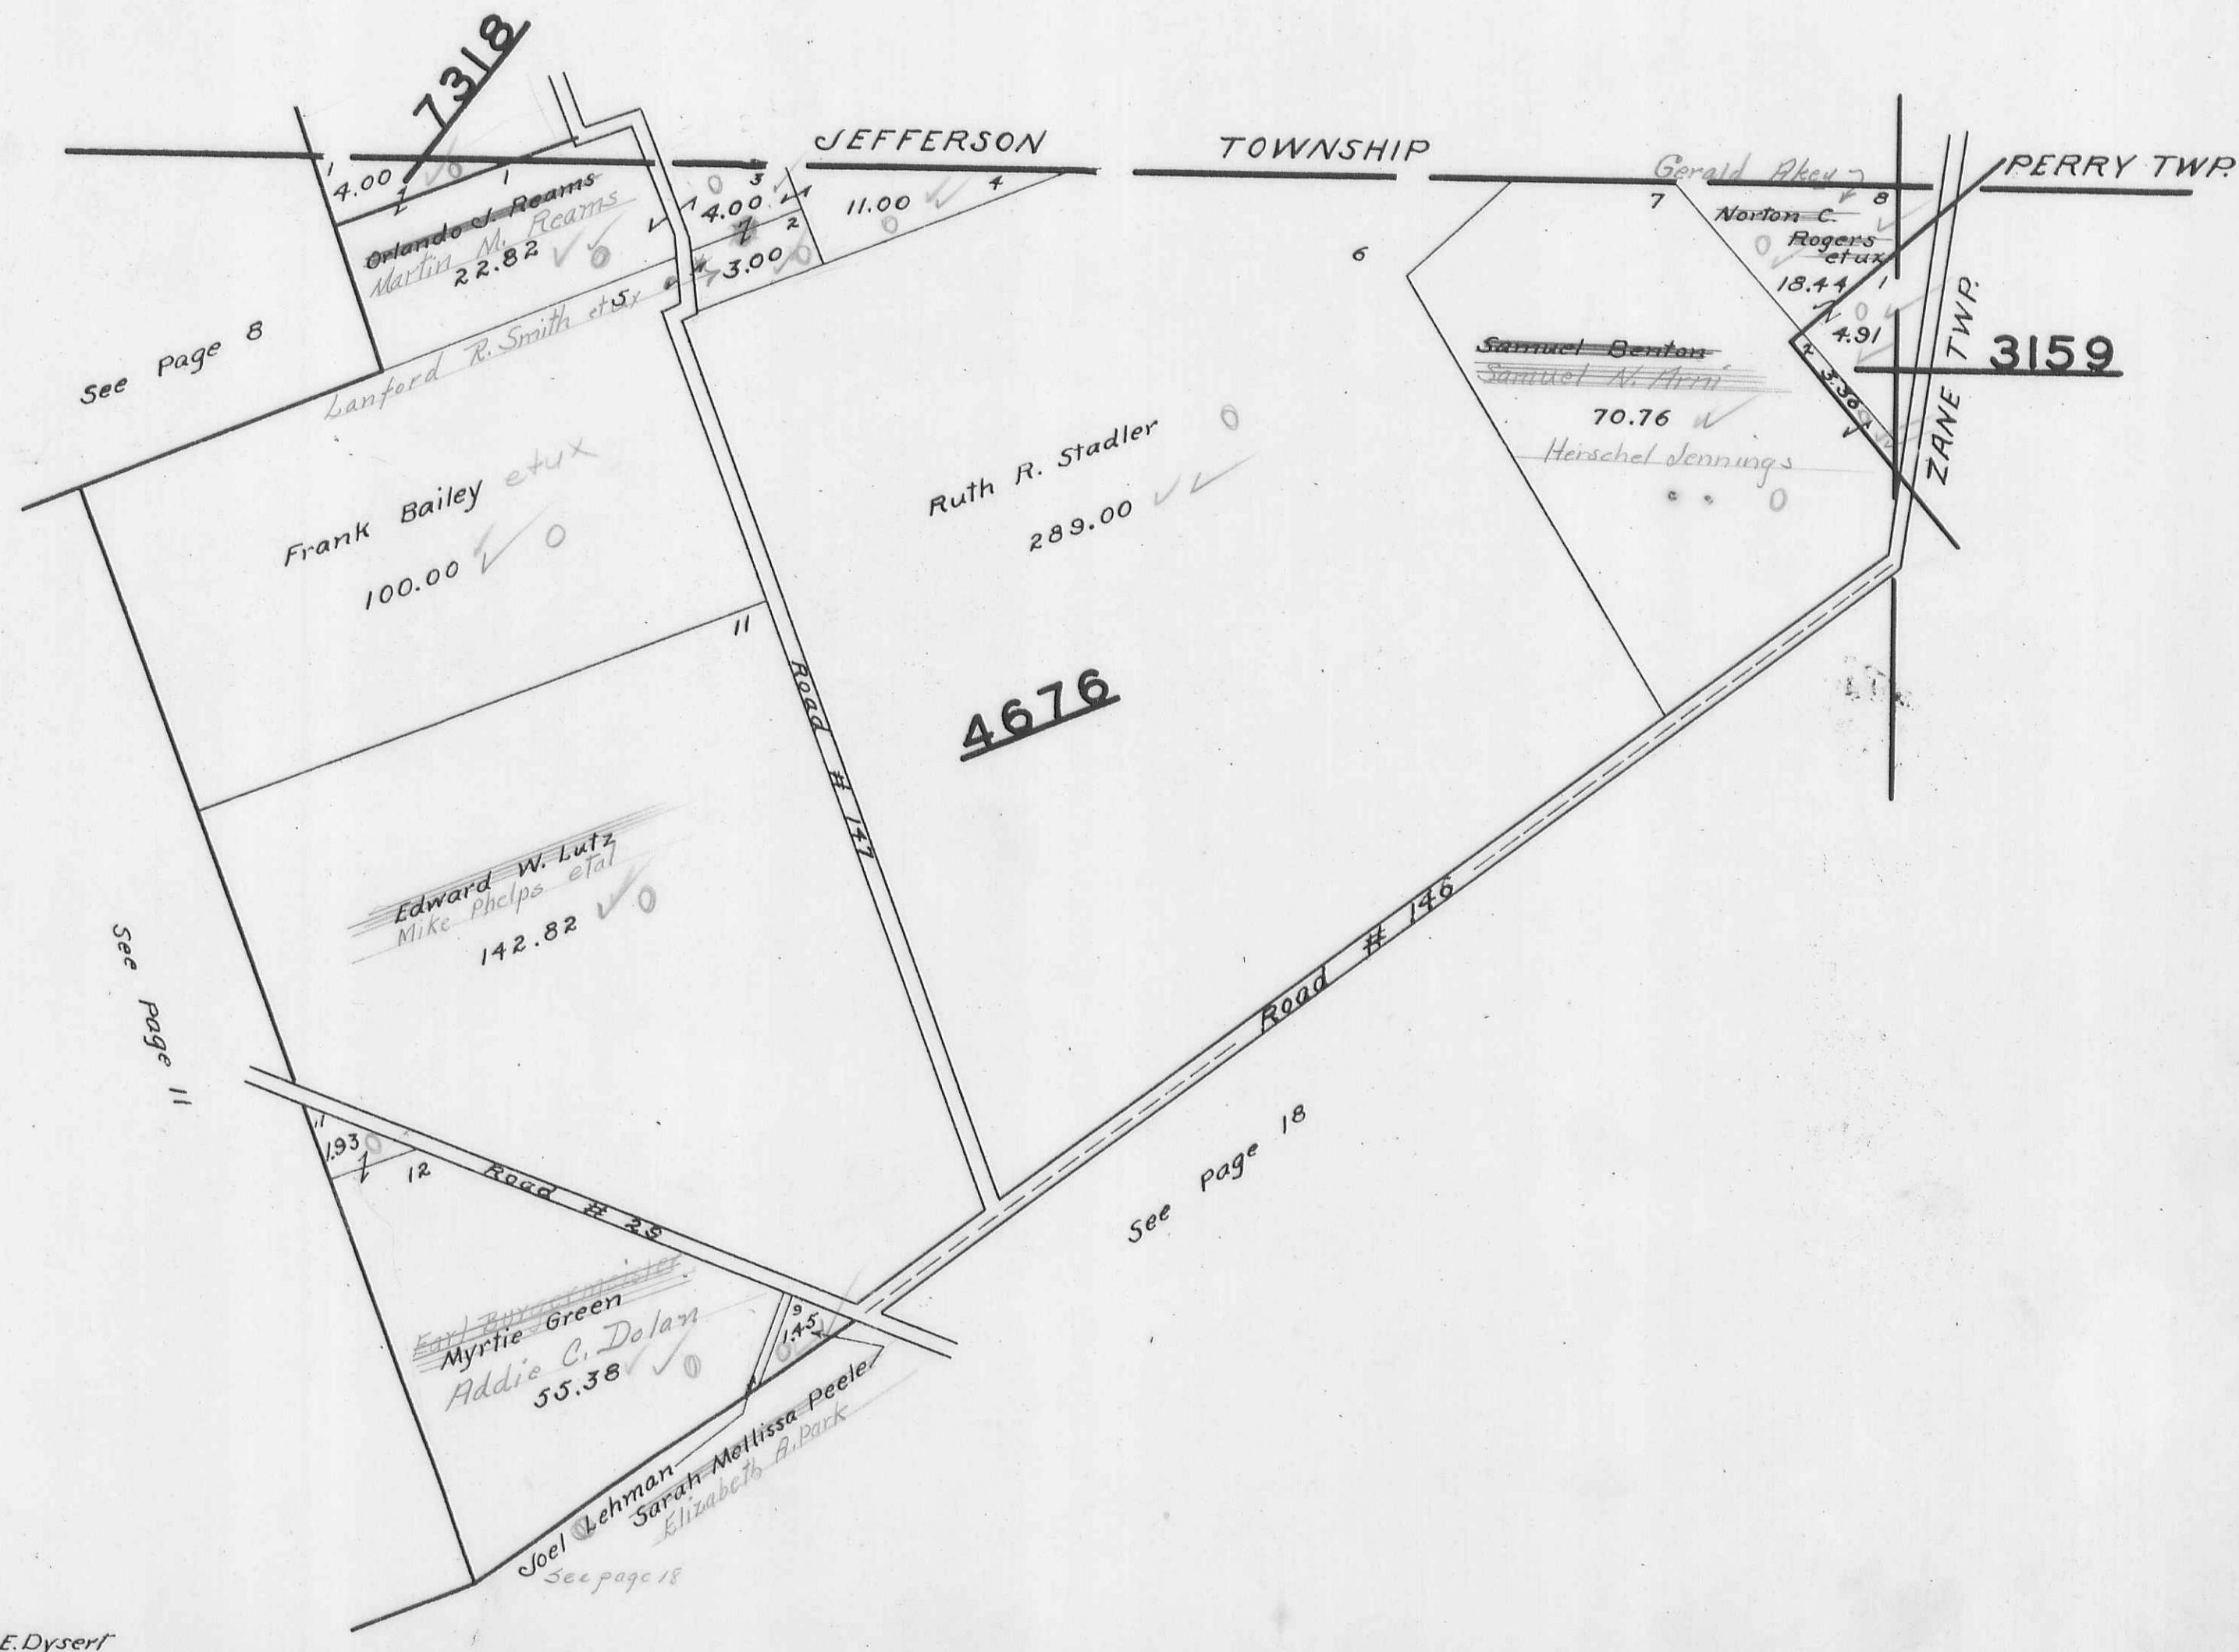

MONROE TOWNSHIP
VIRGINIA MILITARY SURVEY 6516

SCALE 10 CHAINS TO THE INCH


PAGE 13

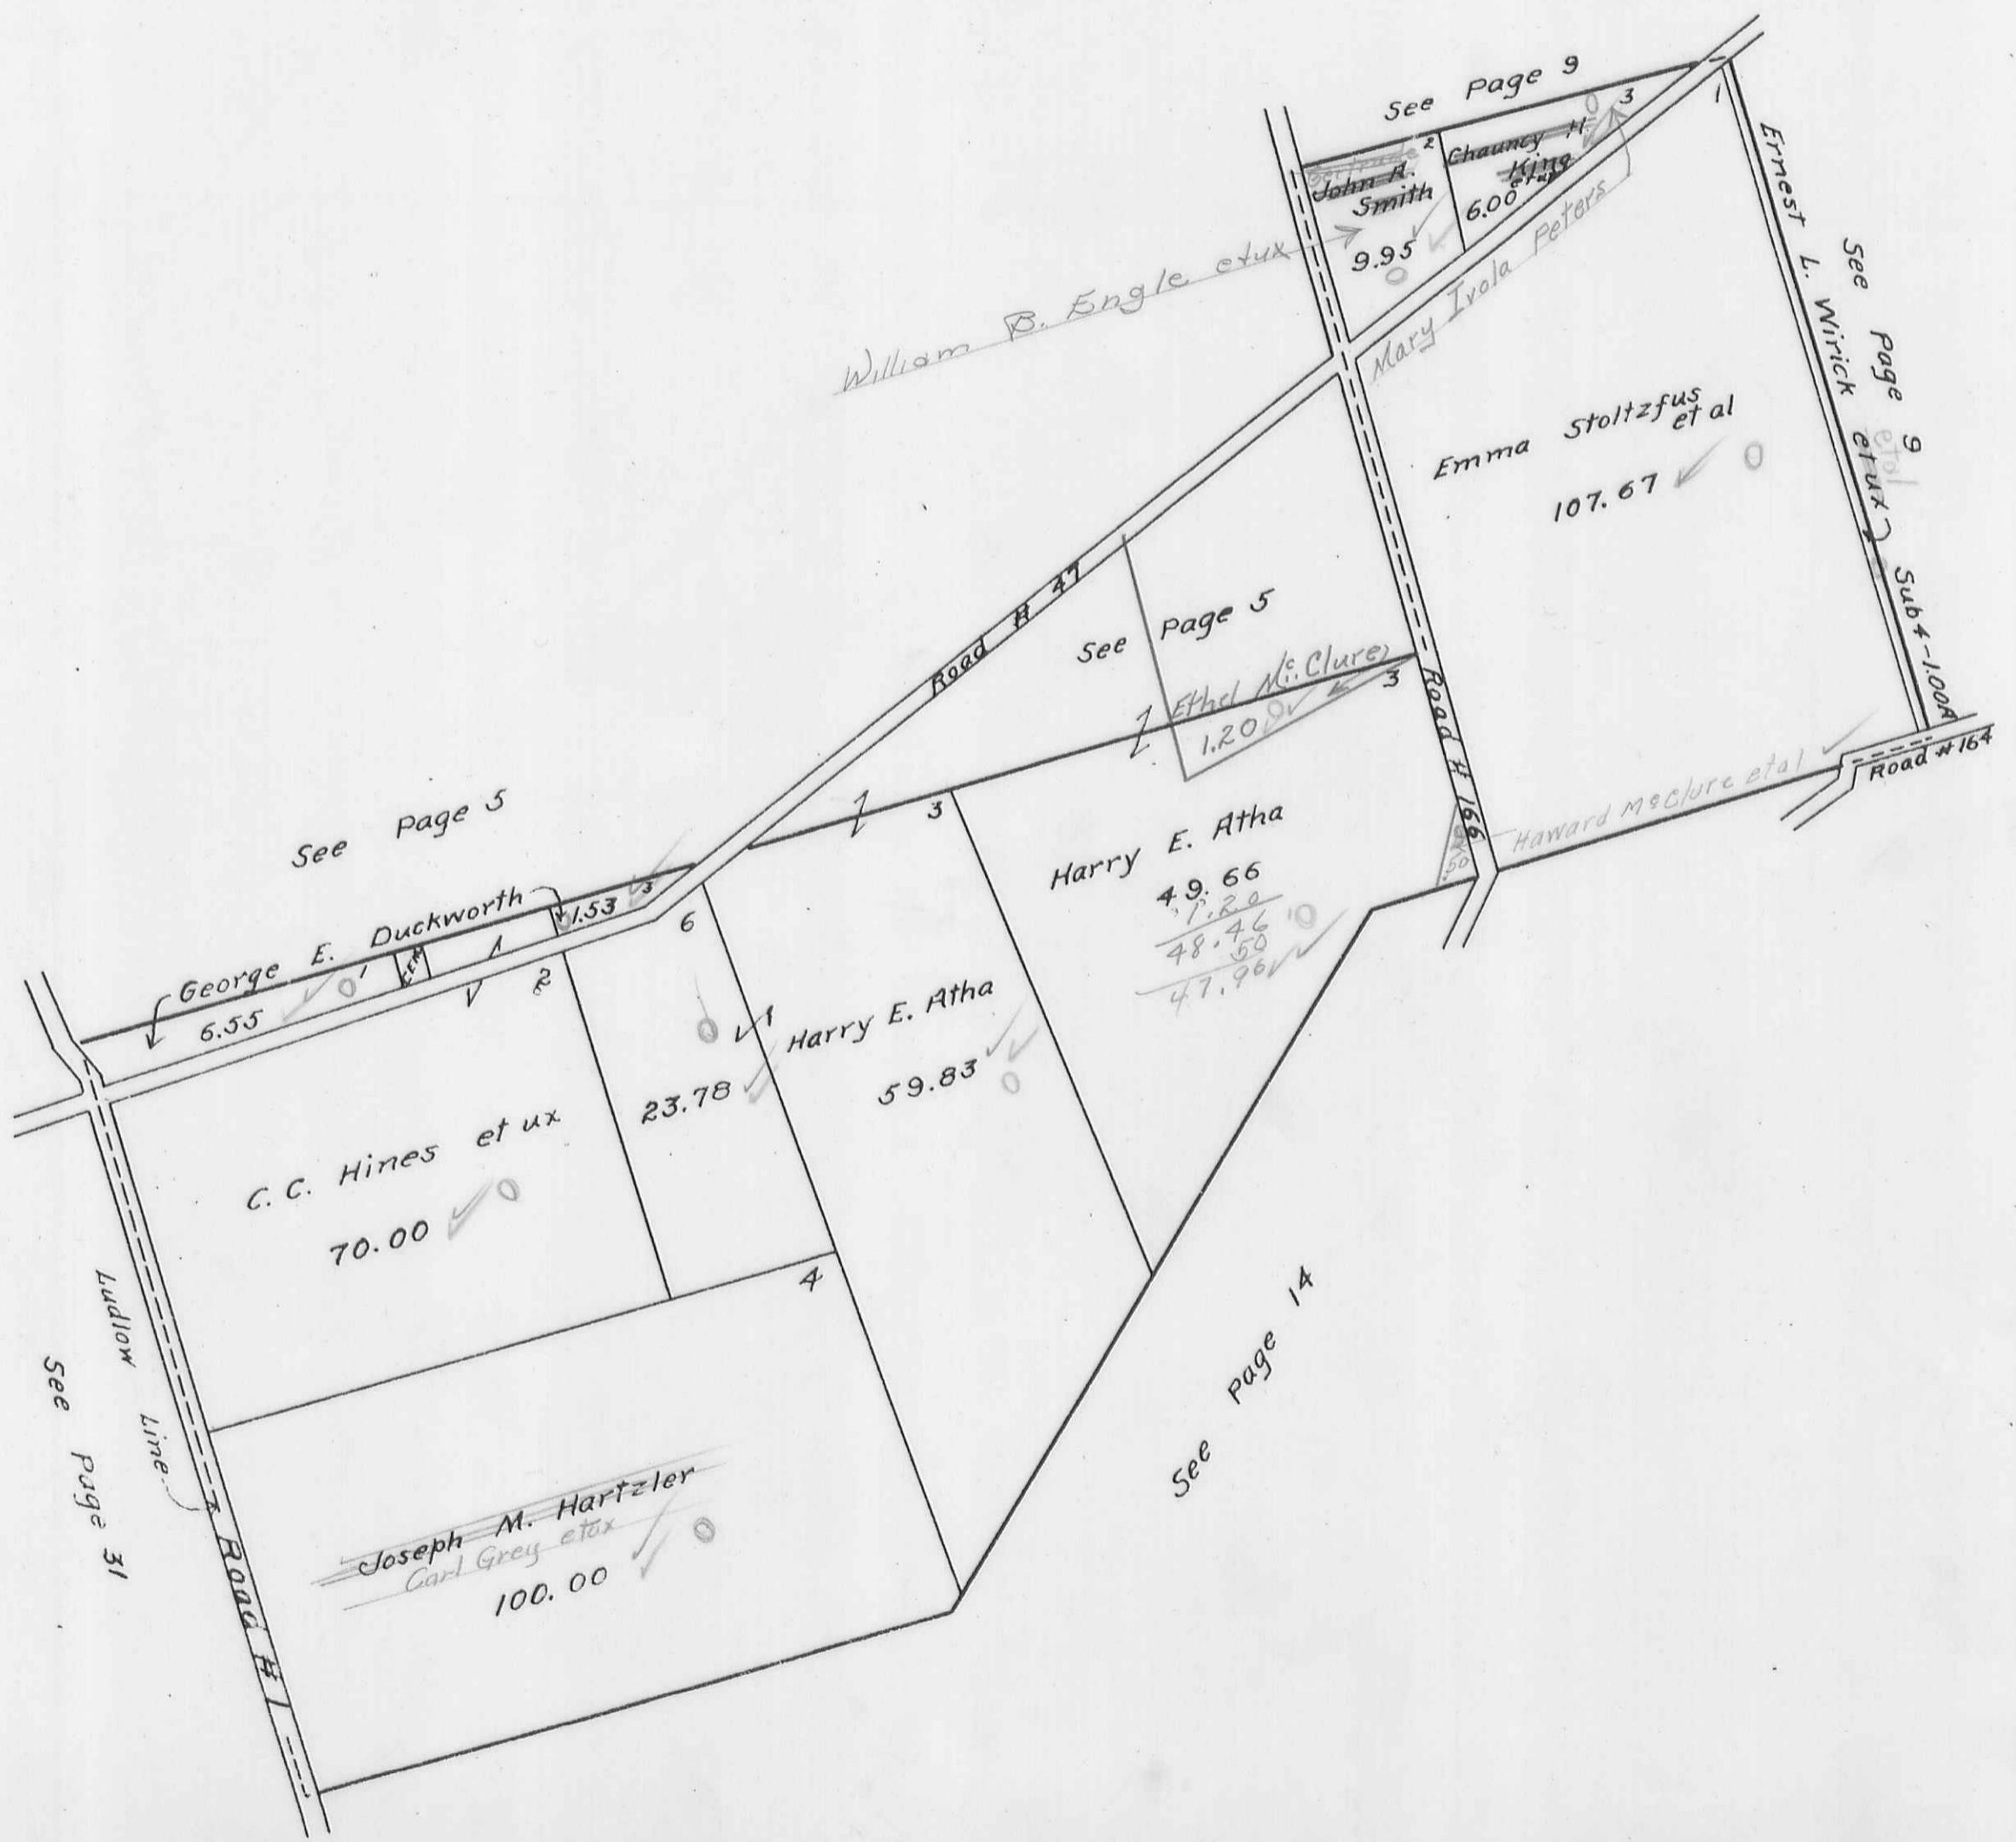

MONROE TOWNSHIP
VIRGINIA MILITARY SURVEY 4479

SCALE 10 CHAINS TO THE INCH


PAGE 14

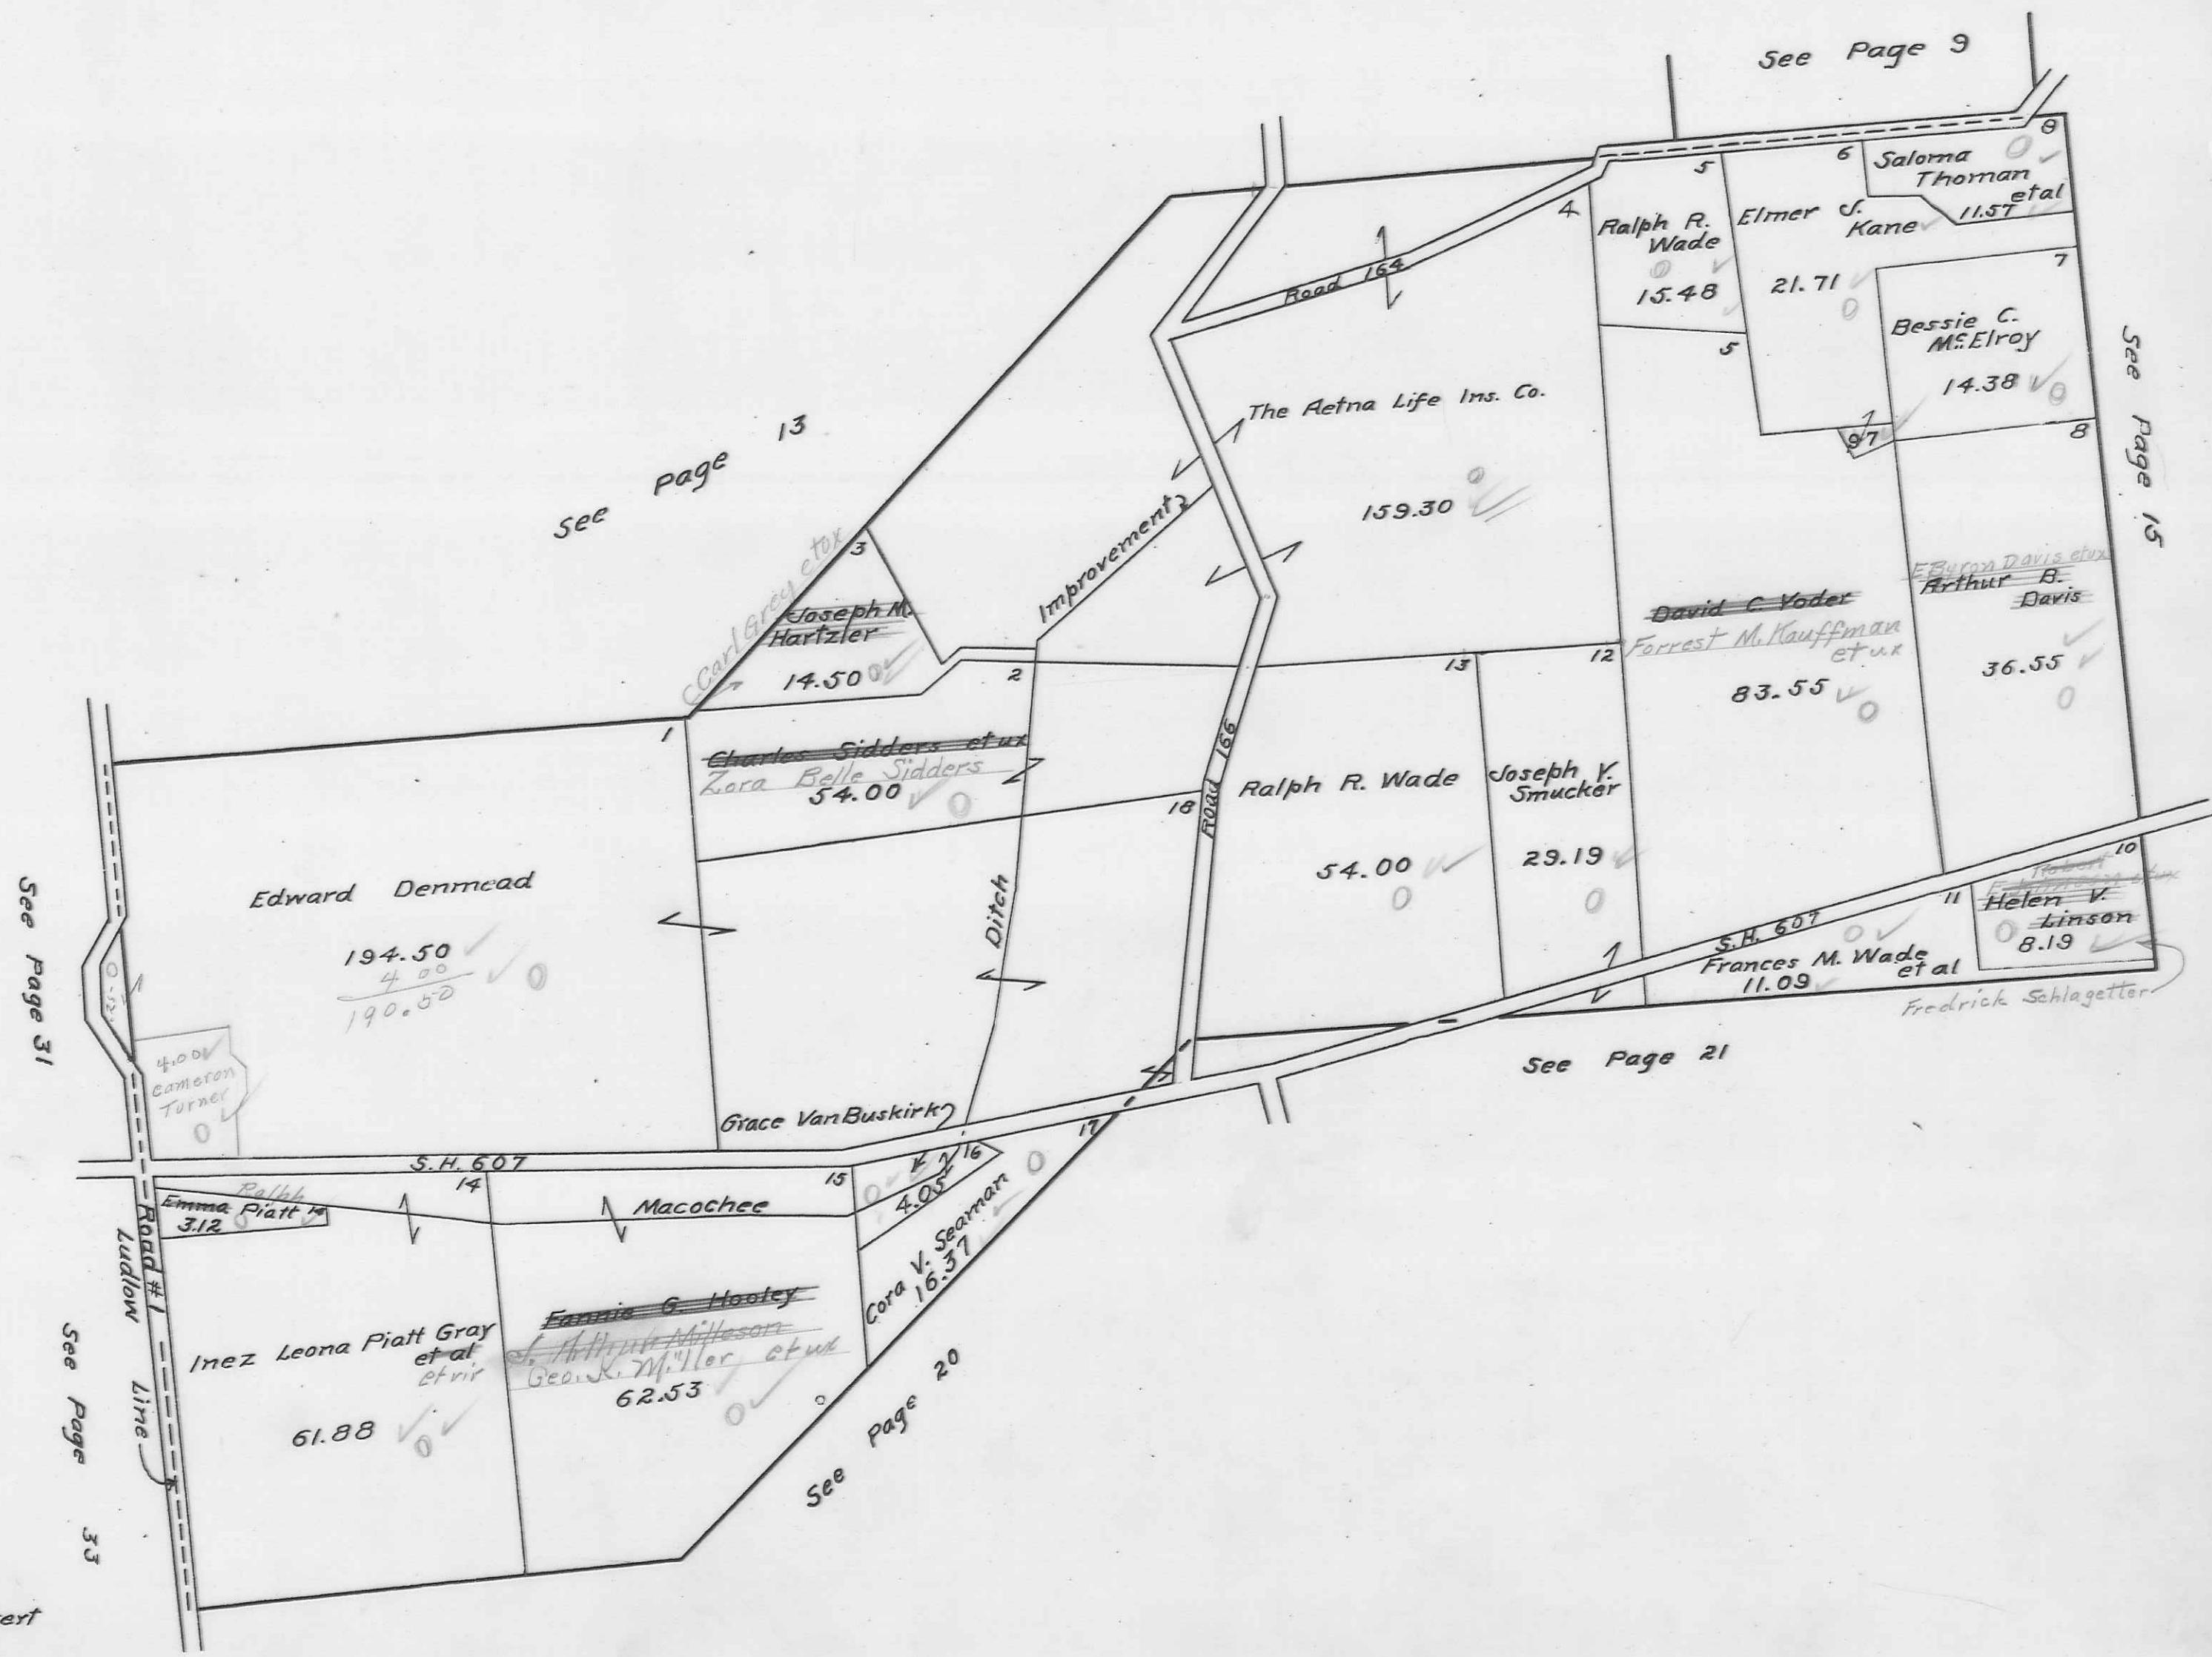

MONROE TOWNSHIP
VIRGINIA MILITARY SURVEYS
SCALE 10 CHAINS TO THE INCH

10091
6487
2220


PAGE 15

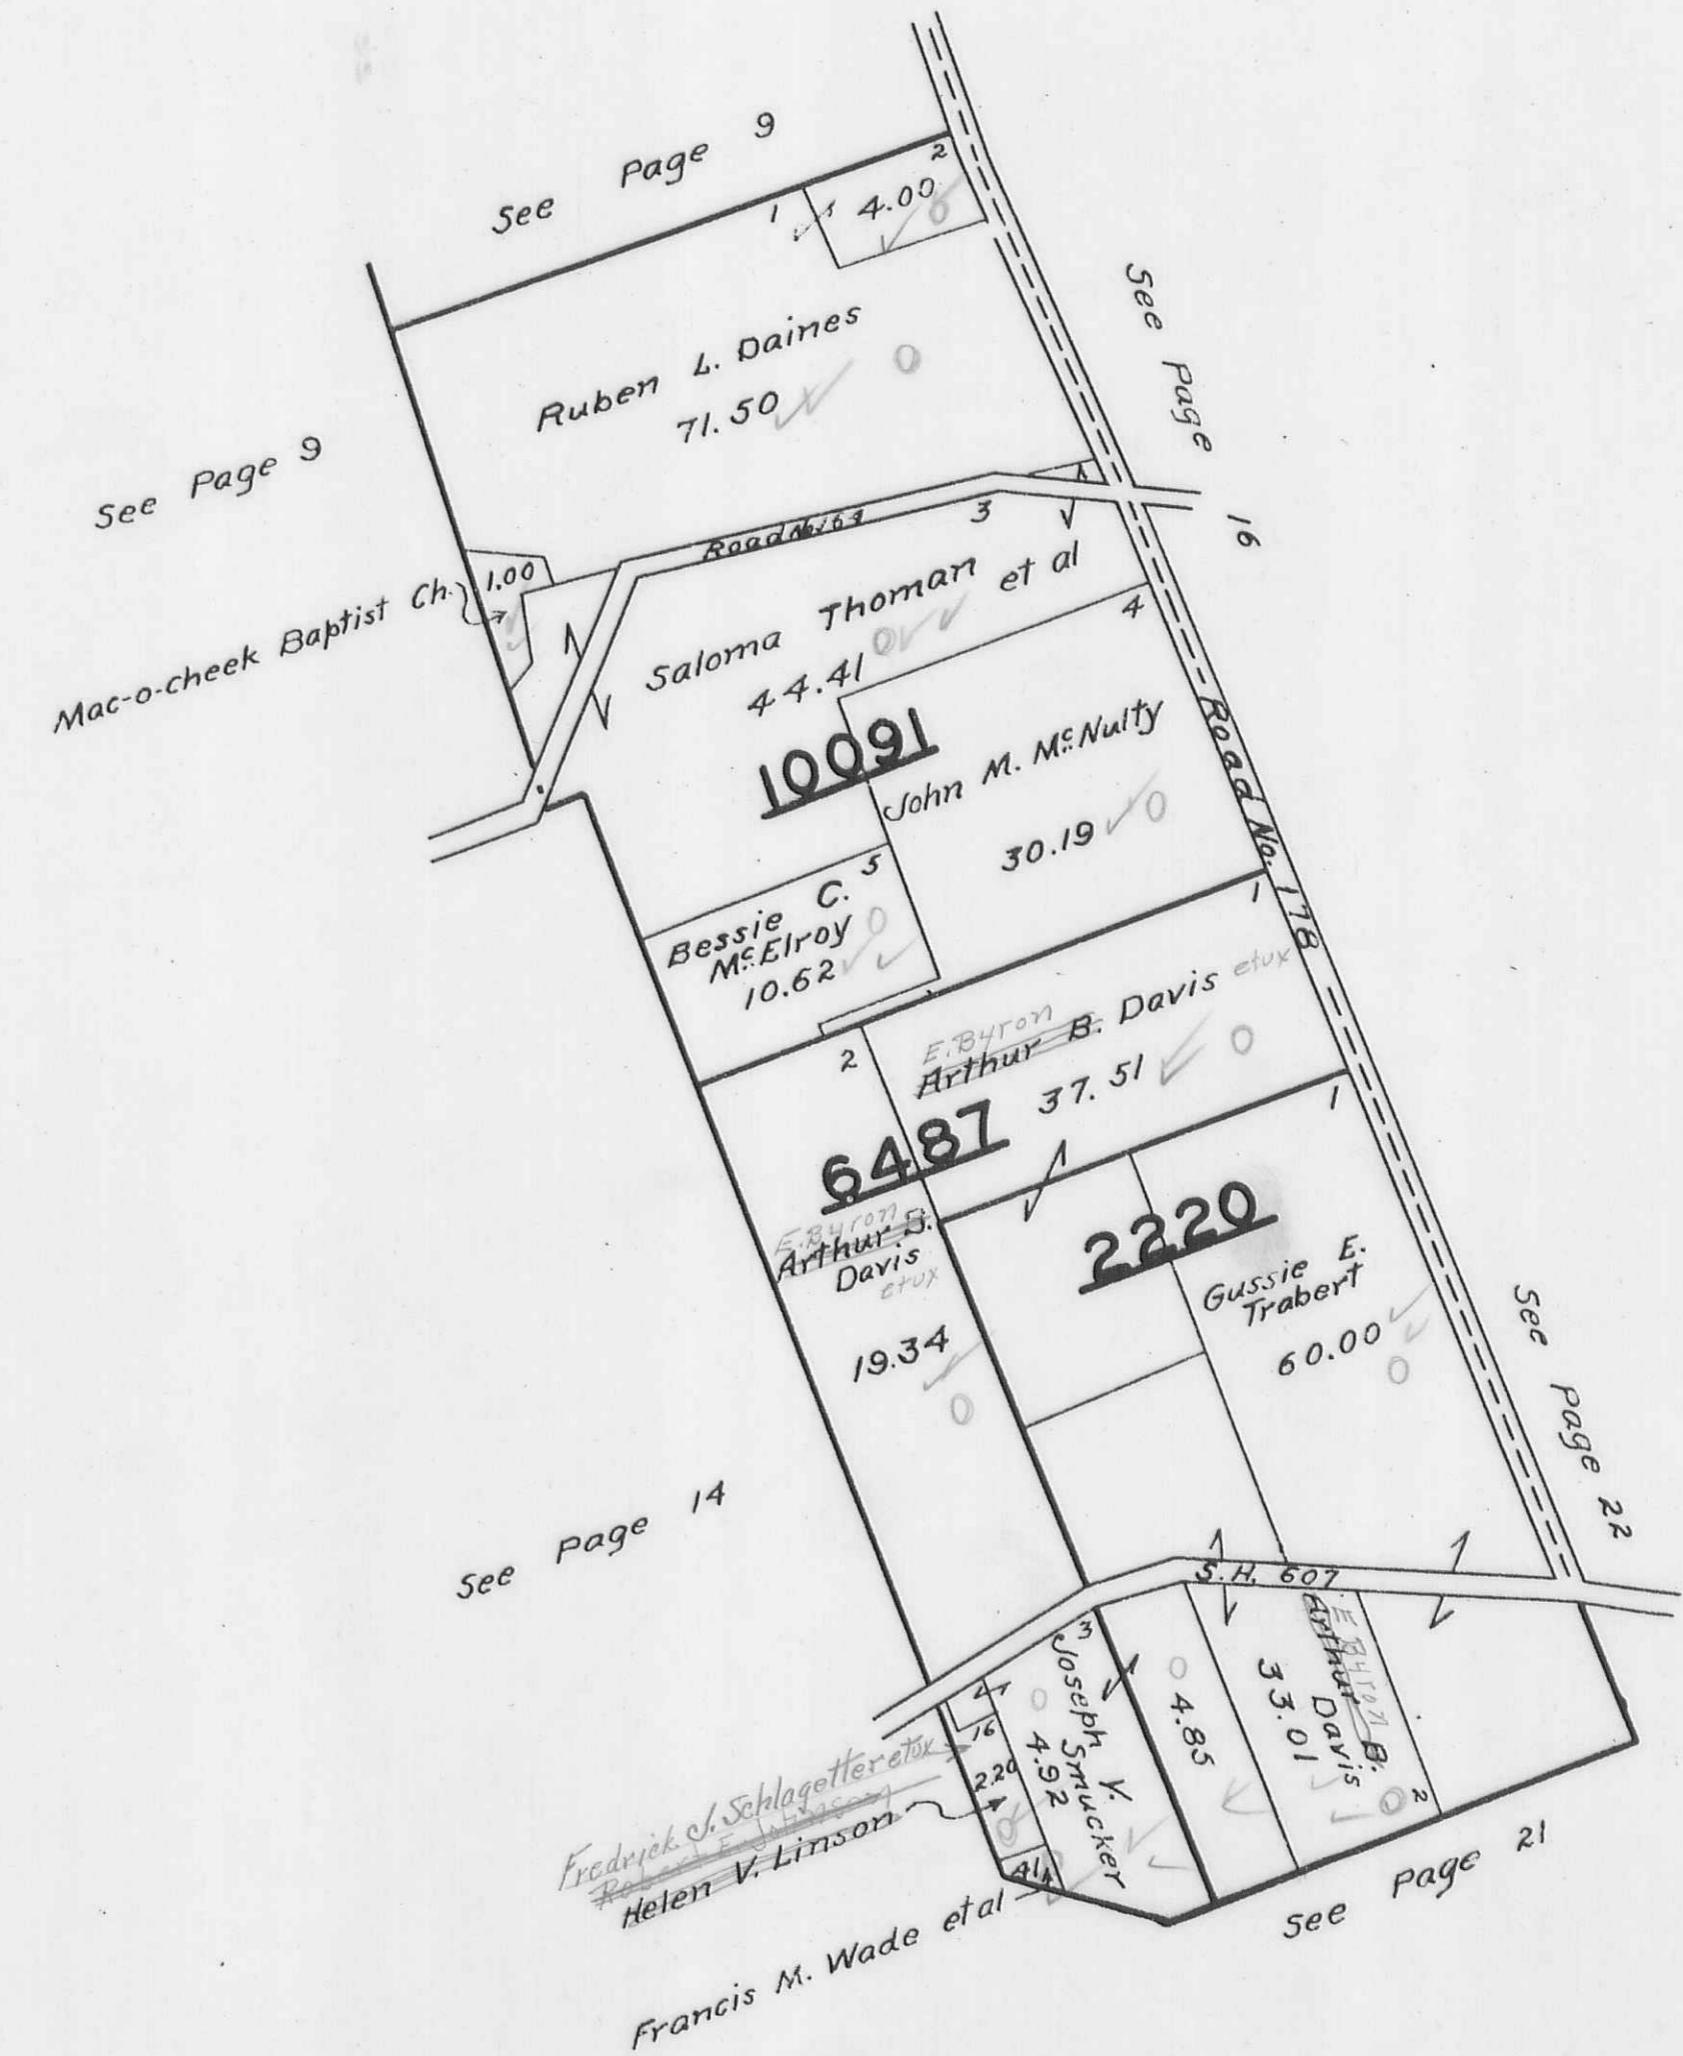

MONROE TOWNSHIP
VIRGINIA MILITARY SURVEY 3224

SCALE 10 CHAINS TO THE INCH

PAGE 16

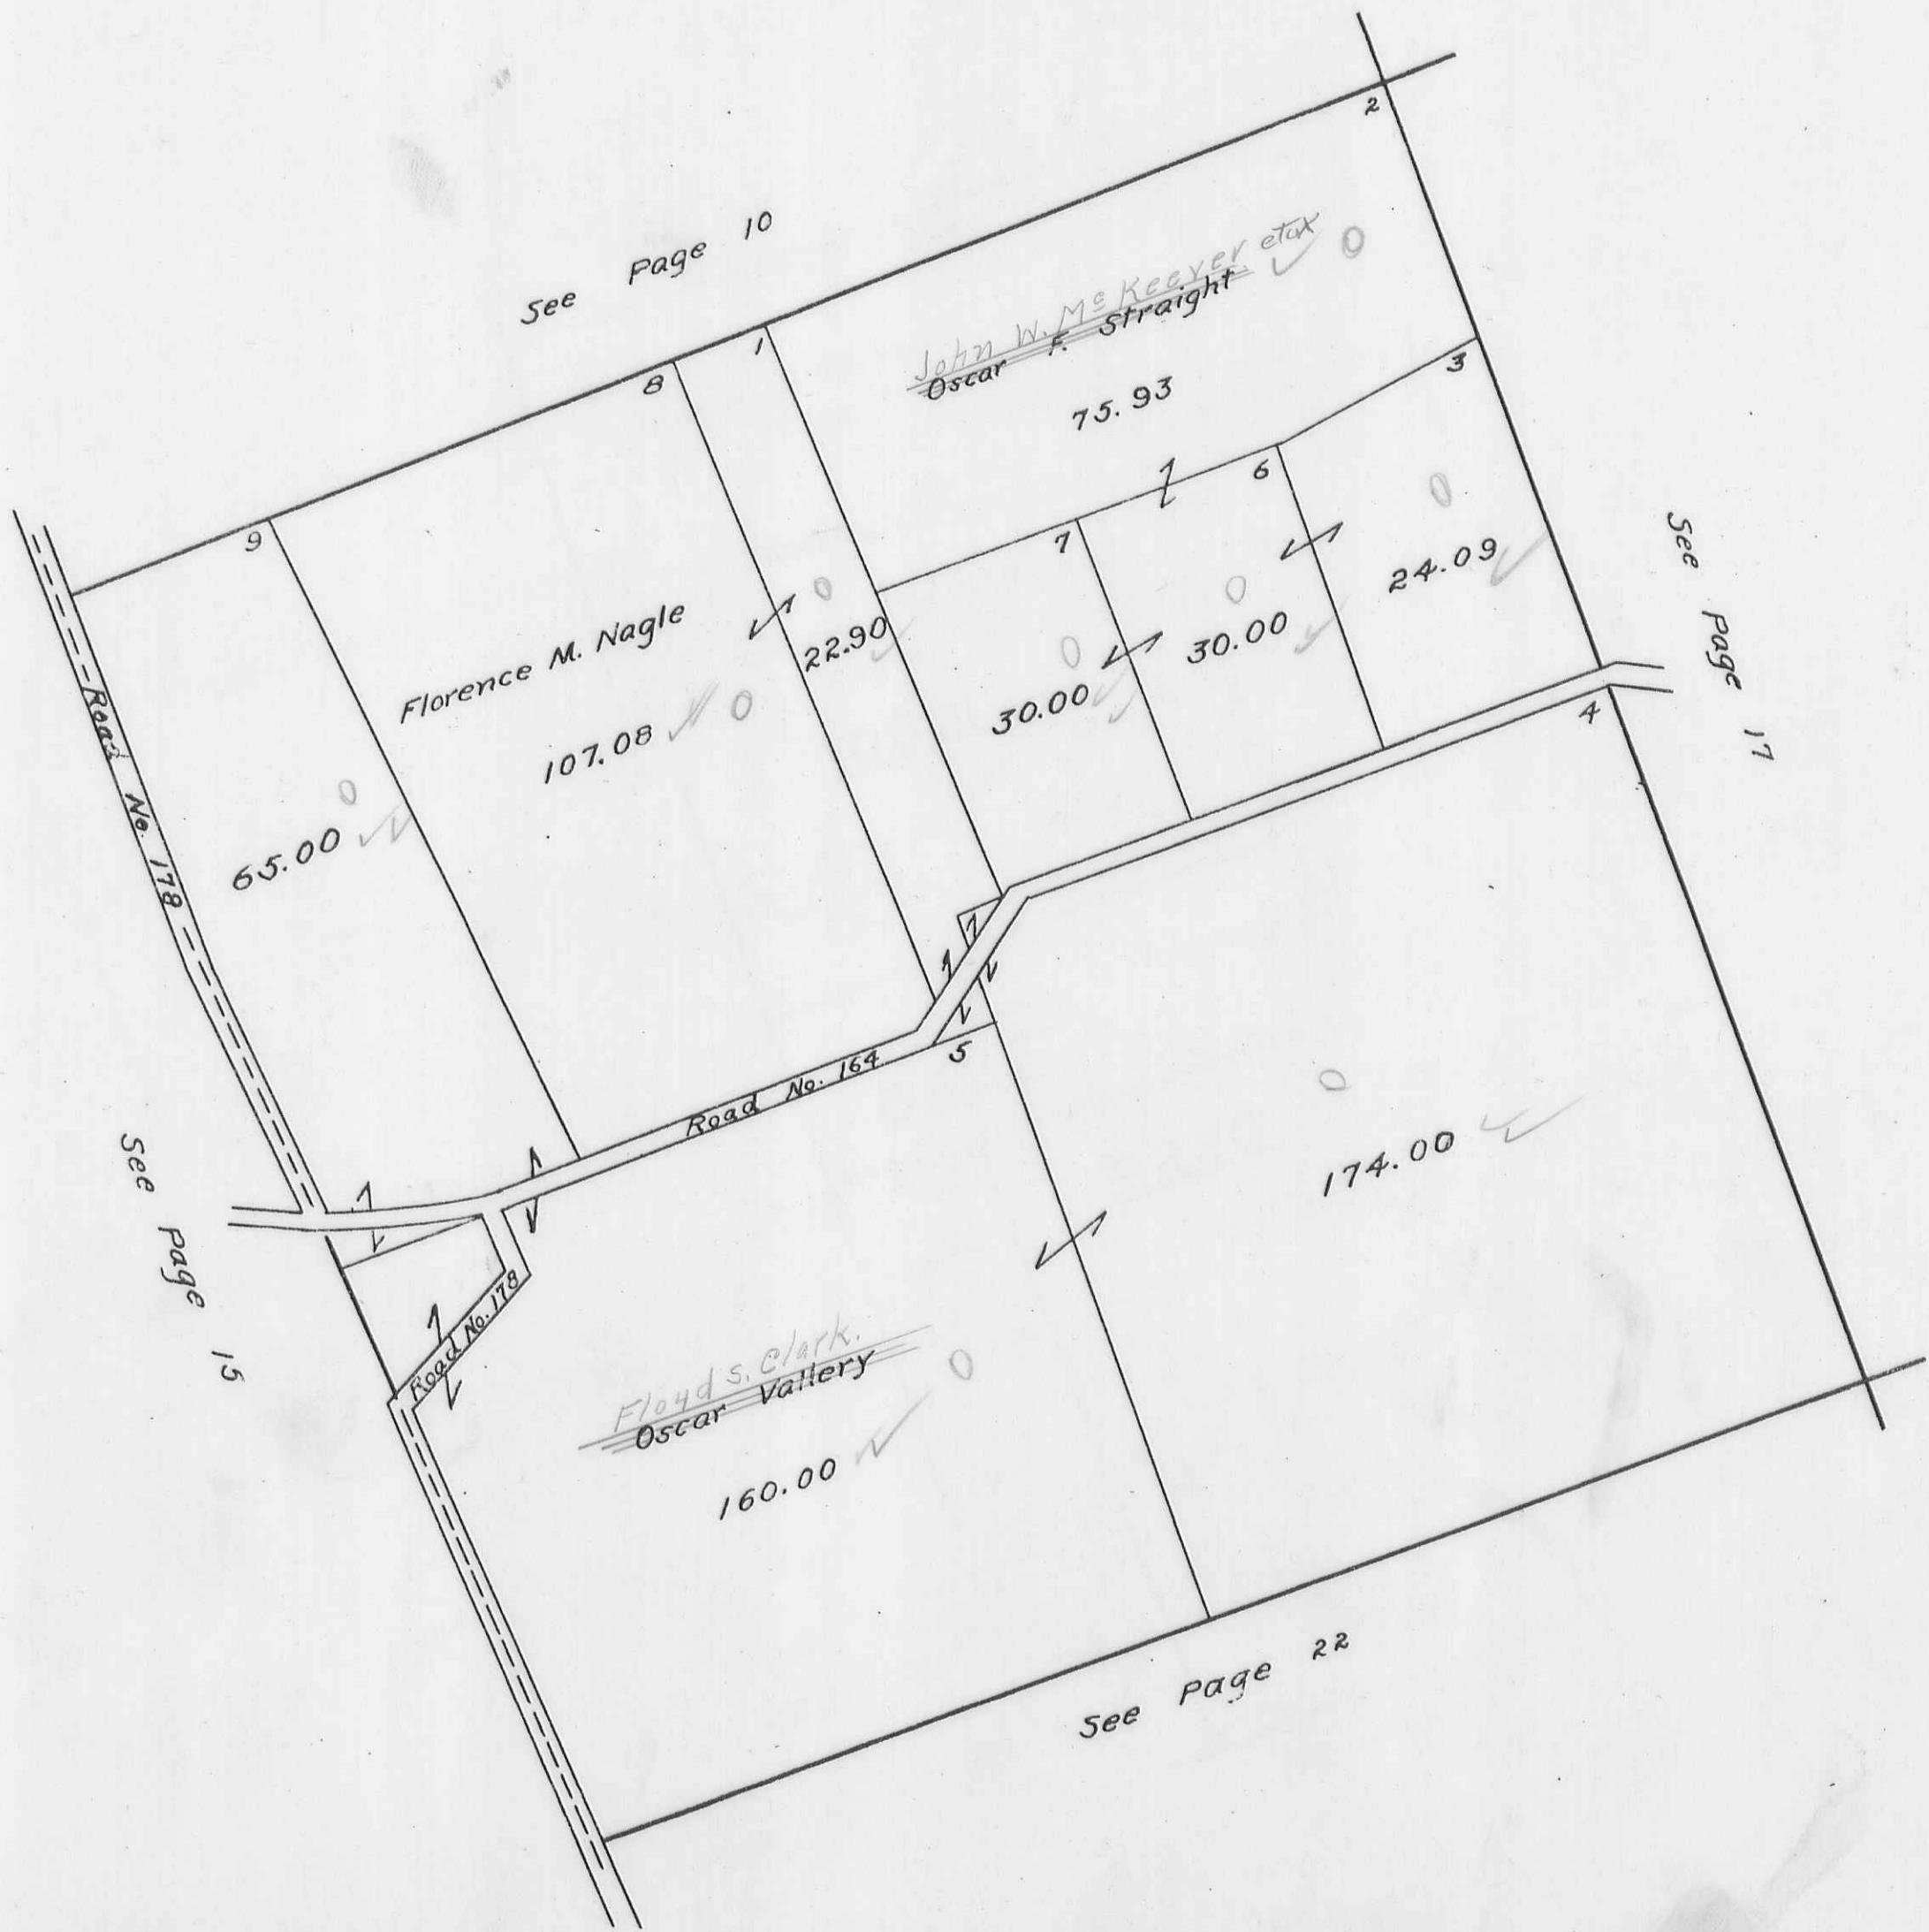


MONROE

TOWNSHIP

PAGE 17


VIRGINIA MILITARY SURVEY 3223

SCALE 10 CHAINS TO THE INCH

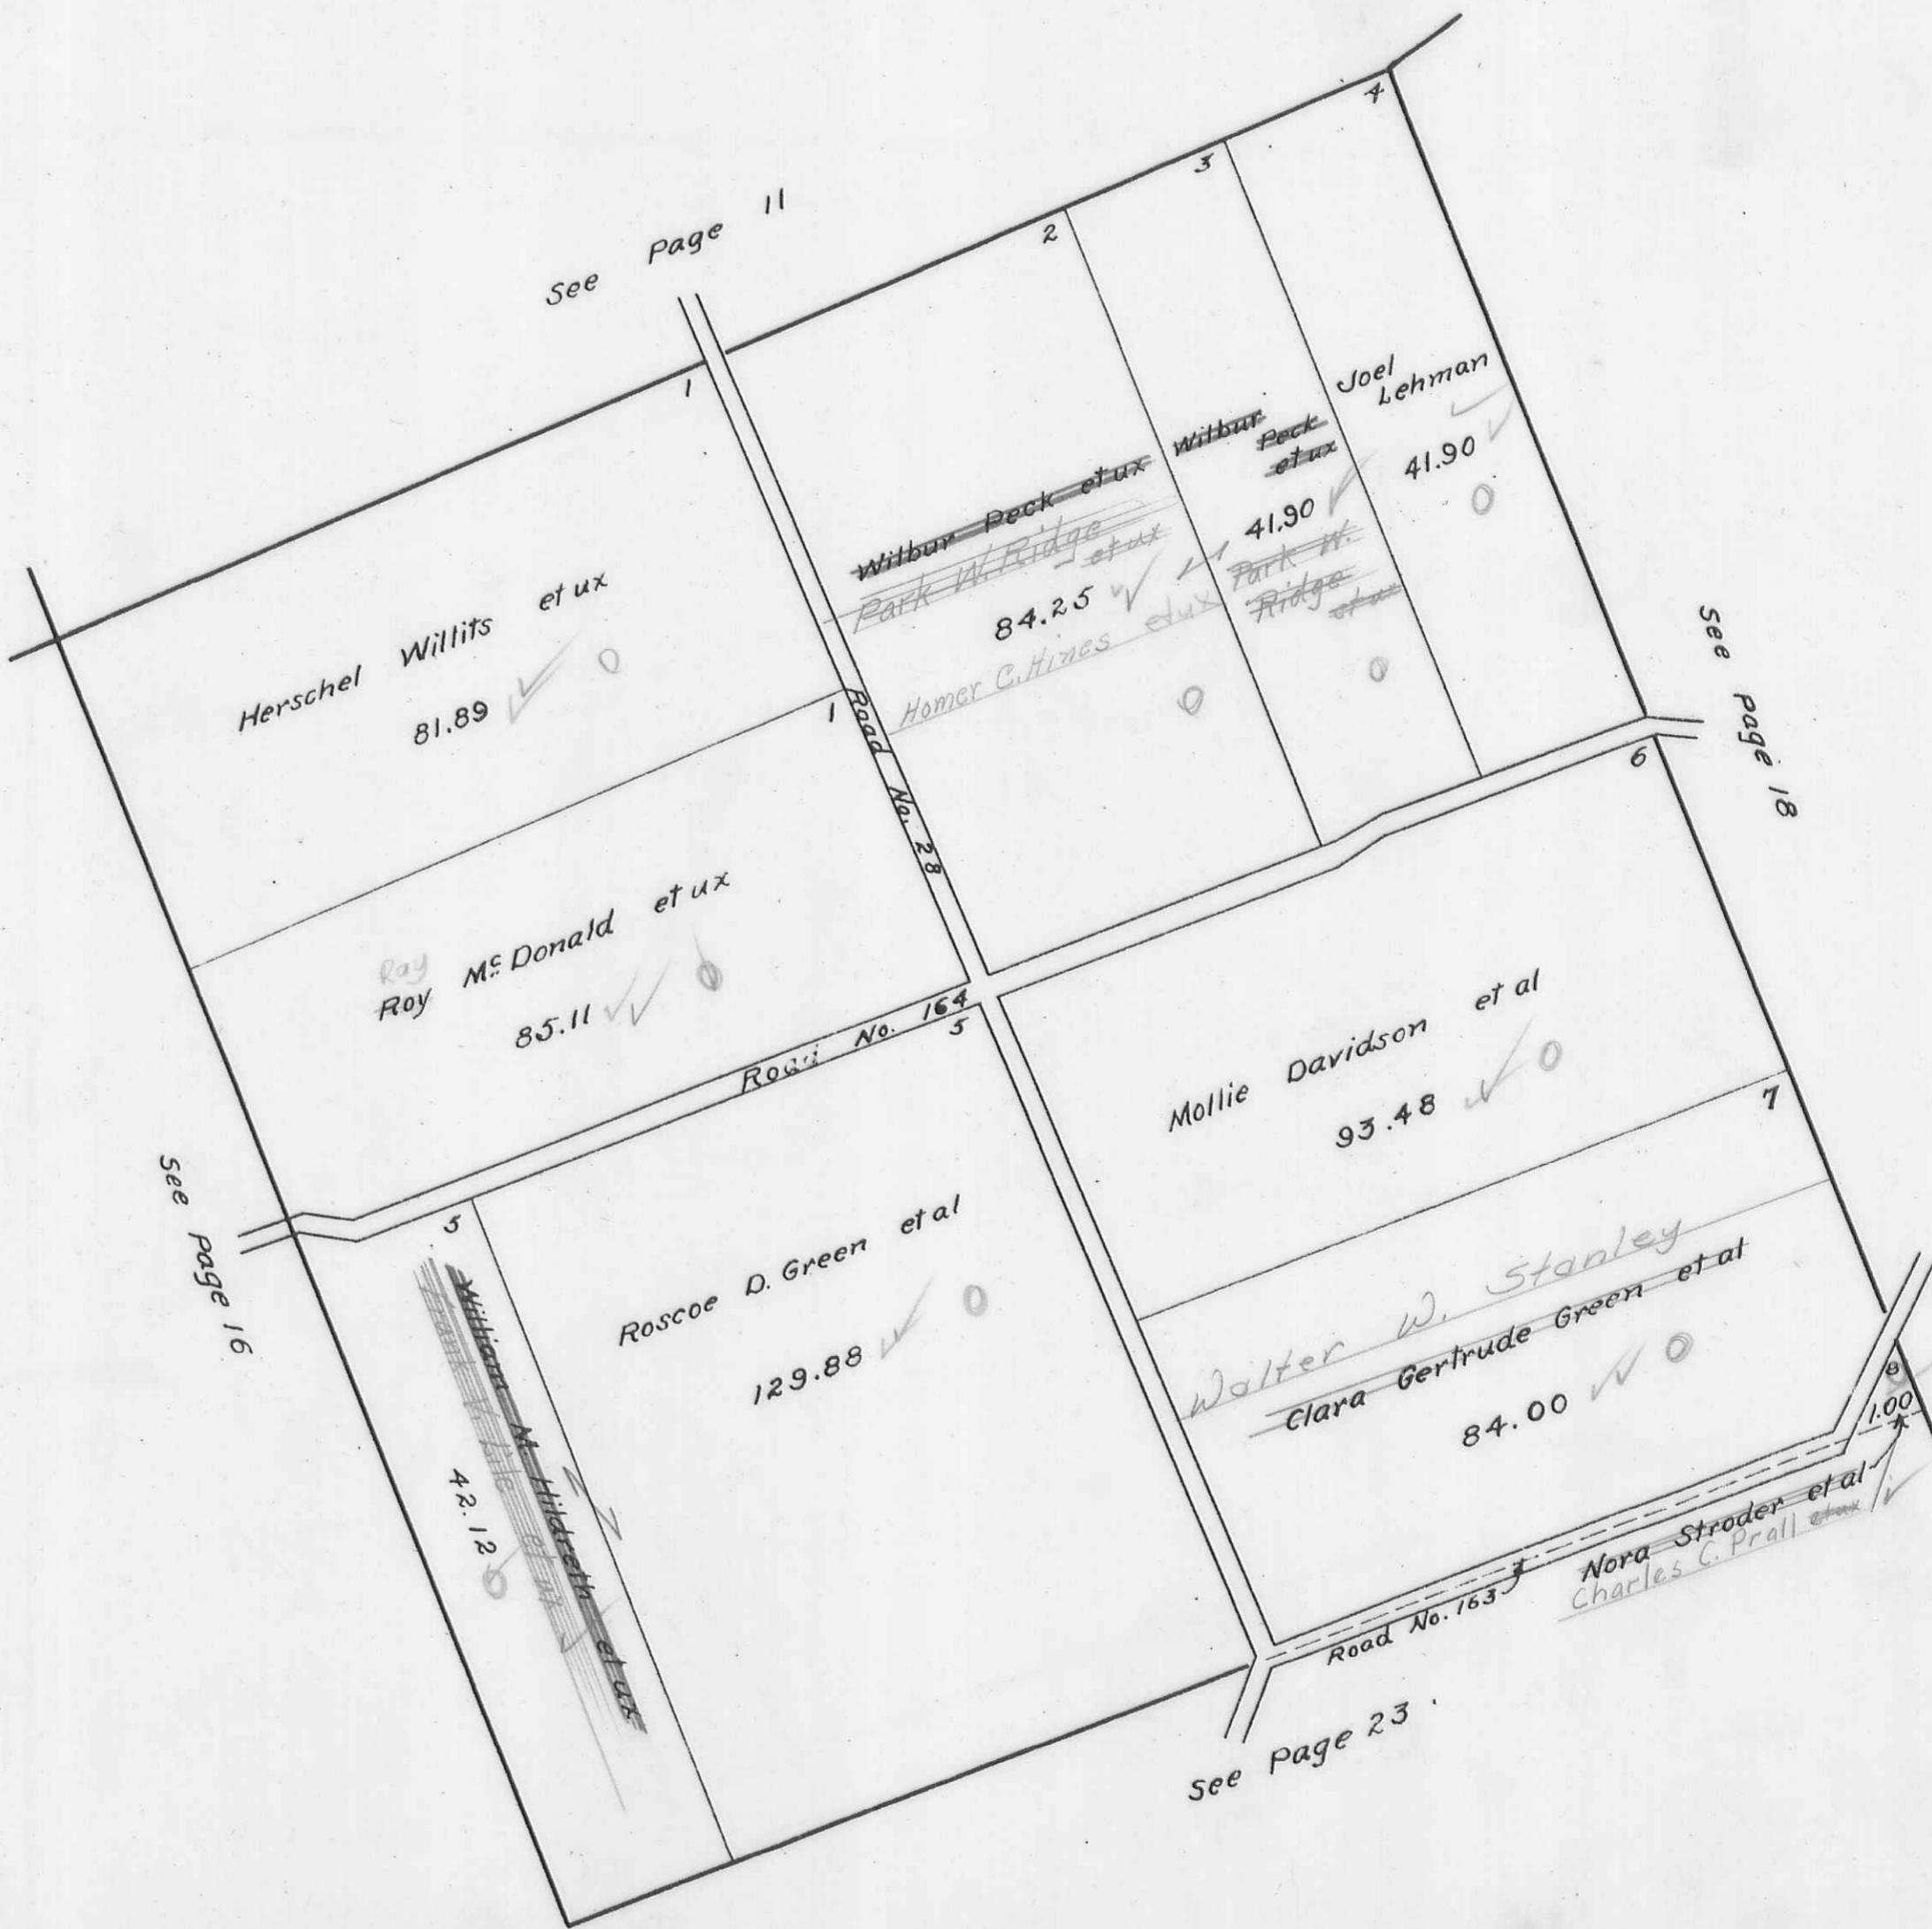

VIRGINIA MILITARY SURVEY N. PART 4570

SCALE 10 CHAINS TO THE INCH

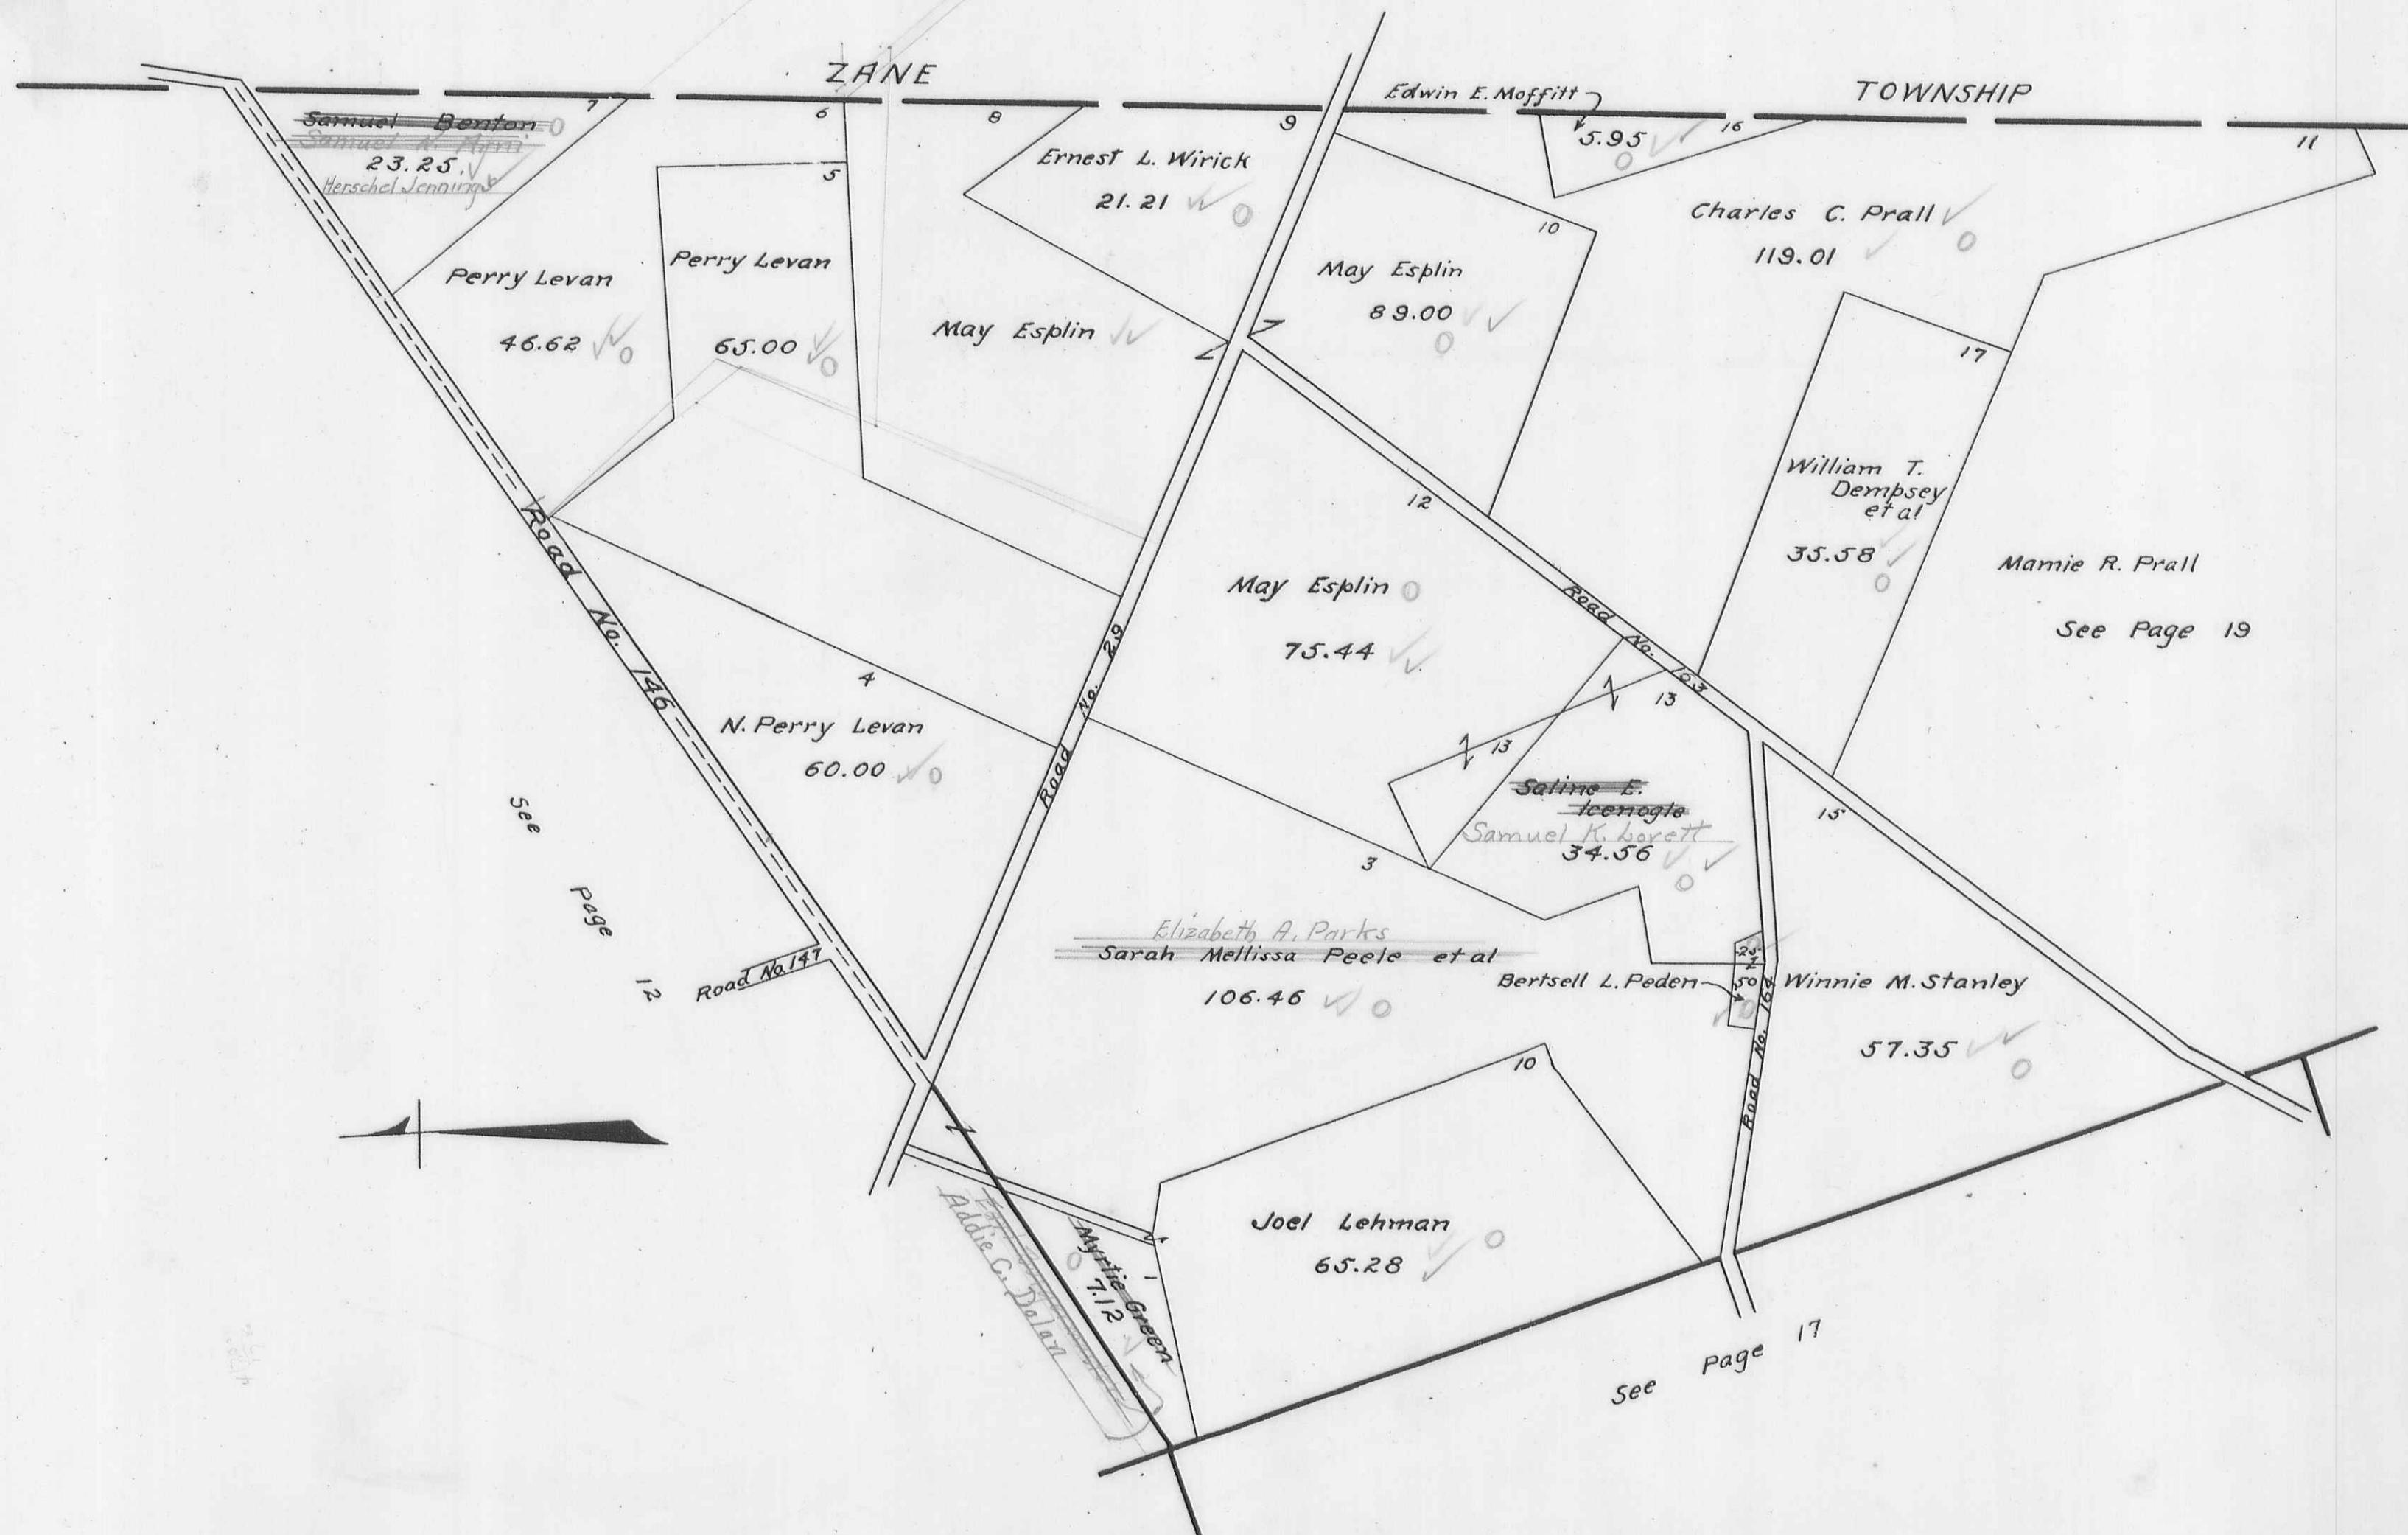

MONROE TOWNSHIP PAGE 19
VIRGINIA MILITARY SURVEY S.PART 4570

SCALE 10 CHAINS TO THE INCH



ZANE

TOWNSHIP

18

19

21

10

See page 18

Mamie R. Prall

322.58 ✓✓ 0

Marie
Dallas M. McCrory et al

198.25 ✓ 0

Arla Brownfield et ux
30.68 ✓✓ 0

James W. Bishop
47.50 ✓ 0

See page 25
Road

4130

See page 25

See page 23

Road #16

See page 18













MONROE TOWNSHIP
VIRGINIA MILITARY SURVEY W. PART 4492

SCALE 10 CHAINS TO THE INCH

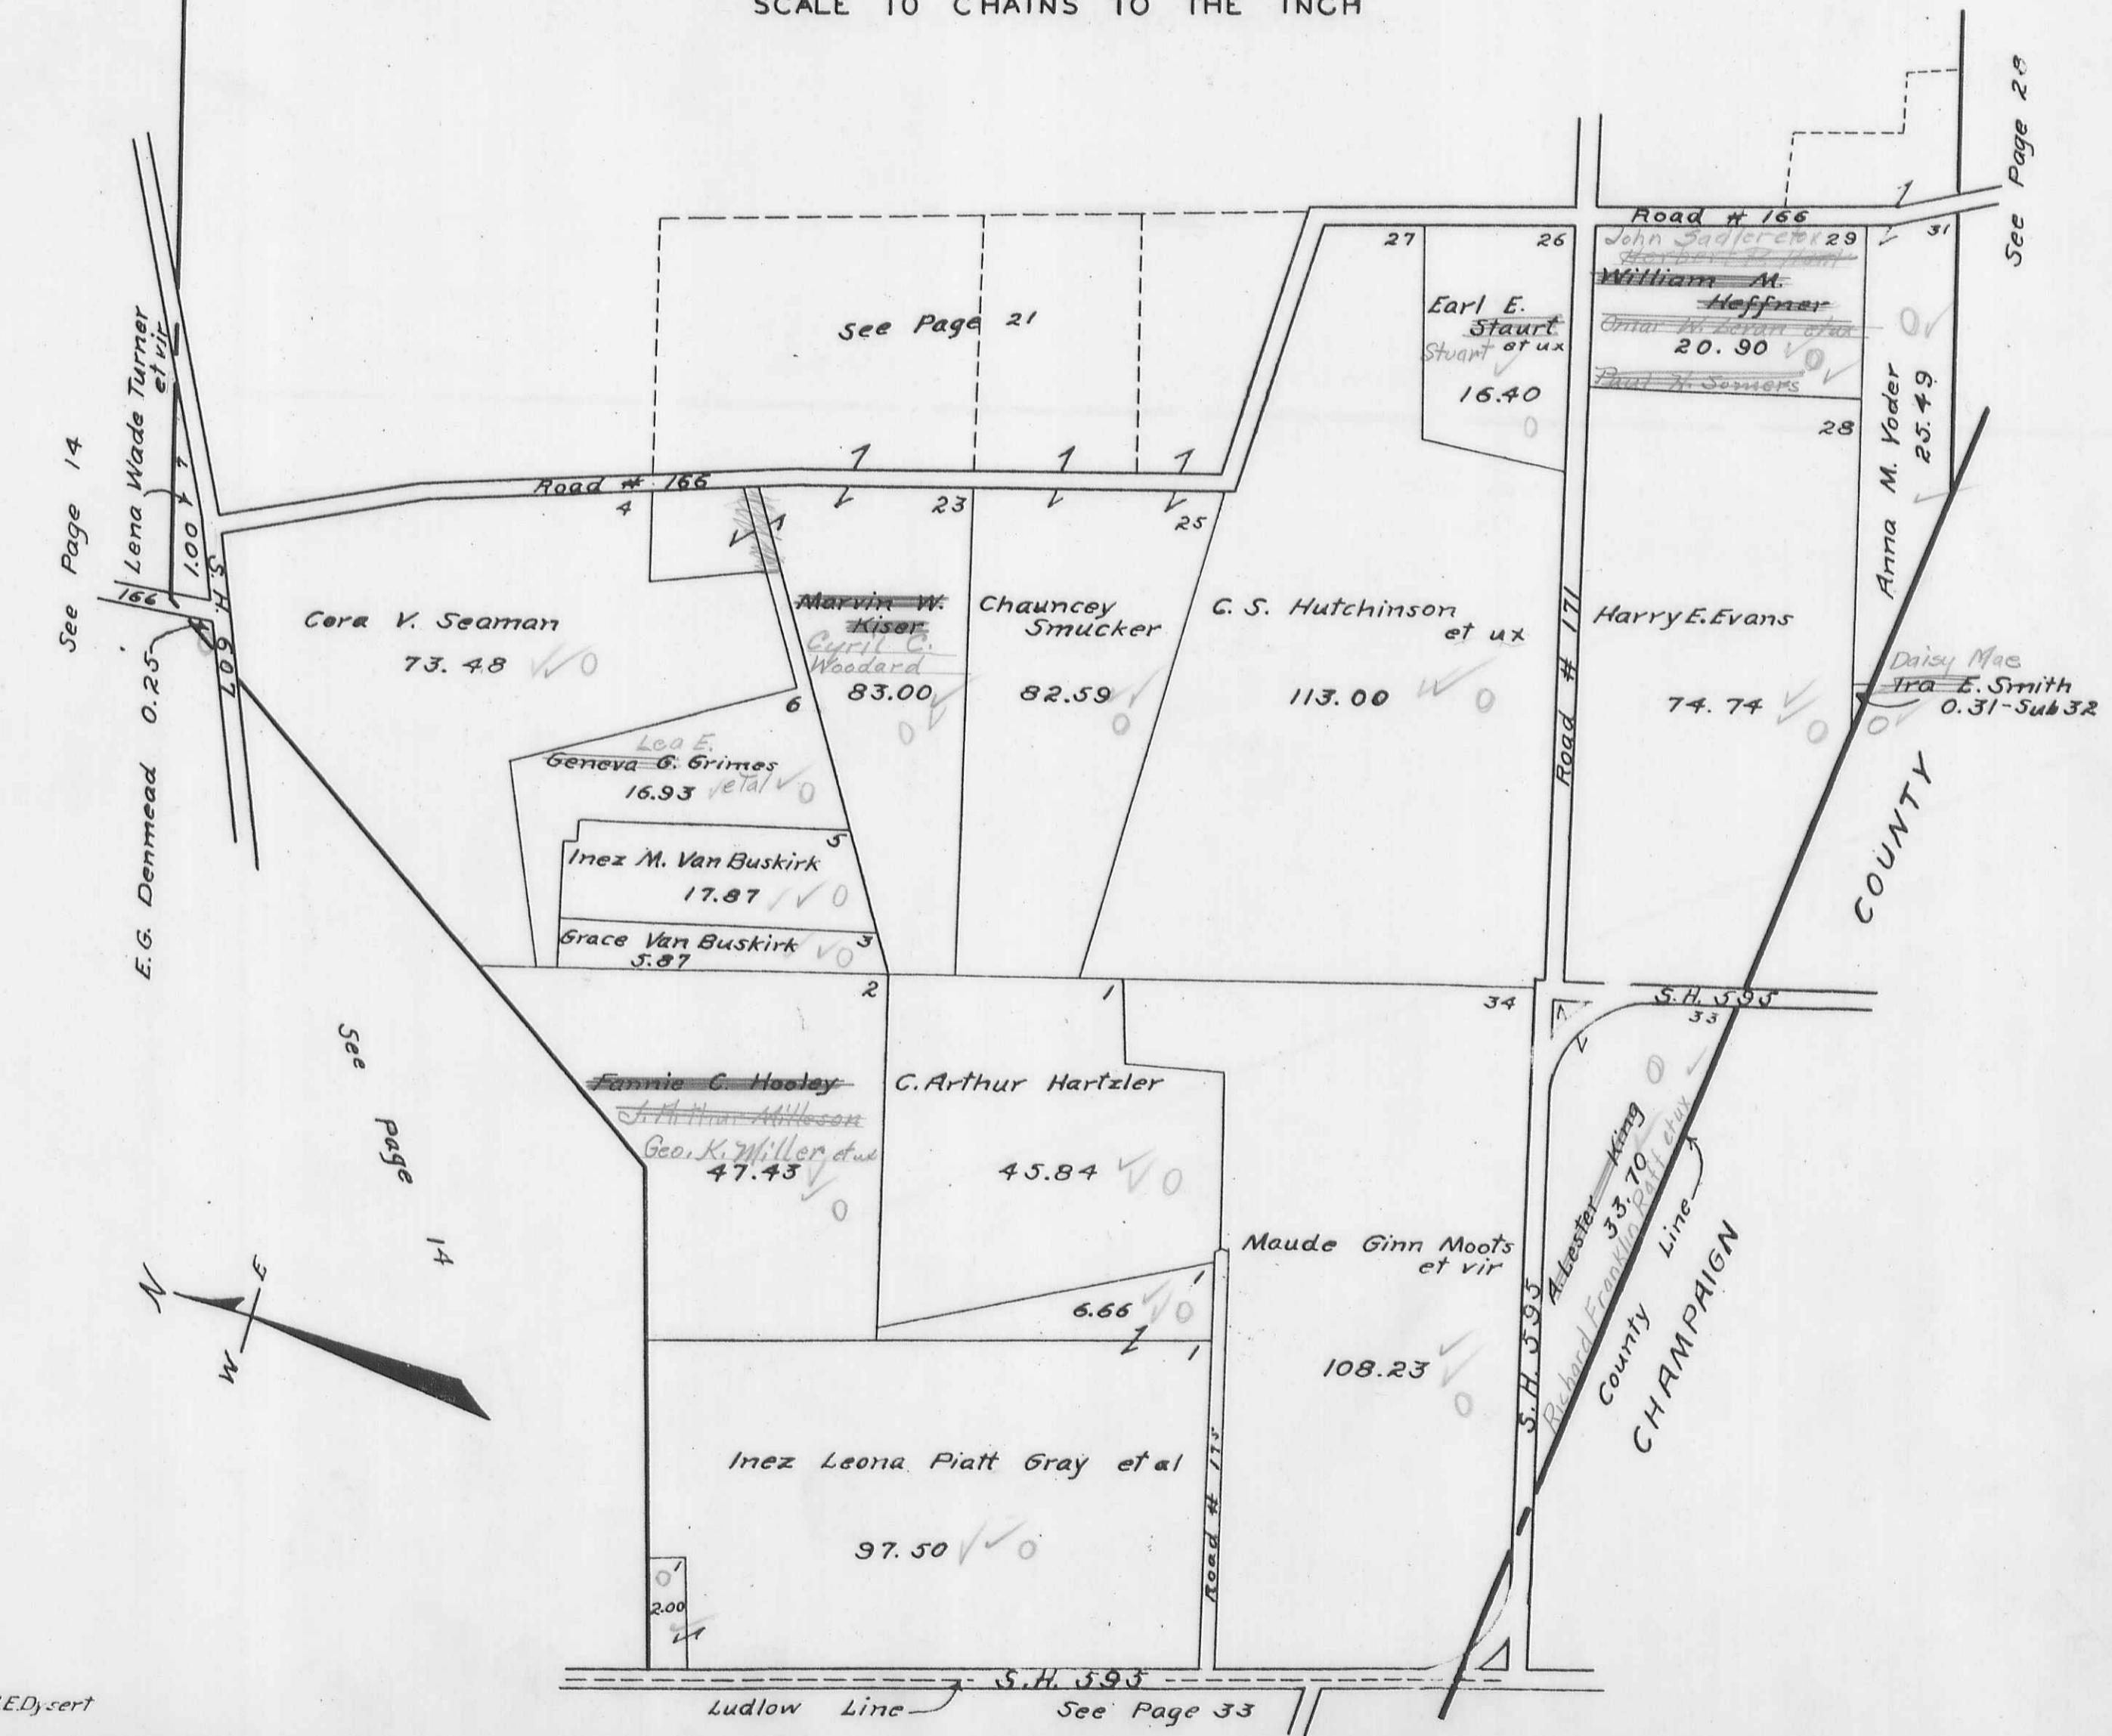


MONROE

TOWNSHIP

PAGE 22

VIRGINIA MILITARY SURVEY 3225


SCALE 10 CHAINS TO THE INCH

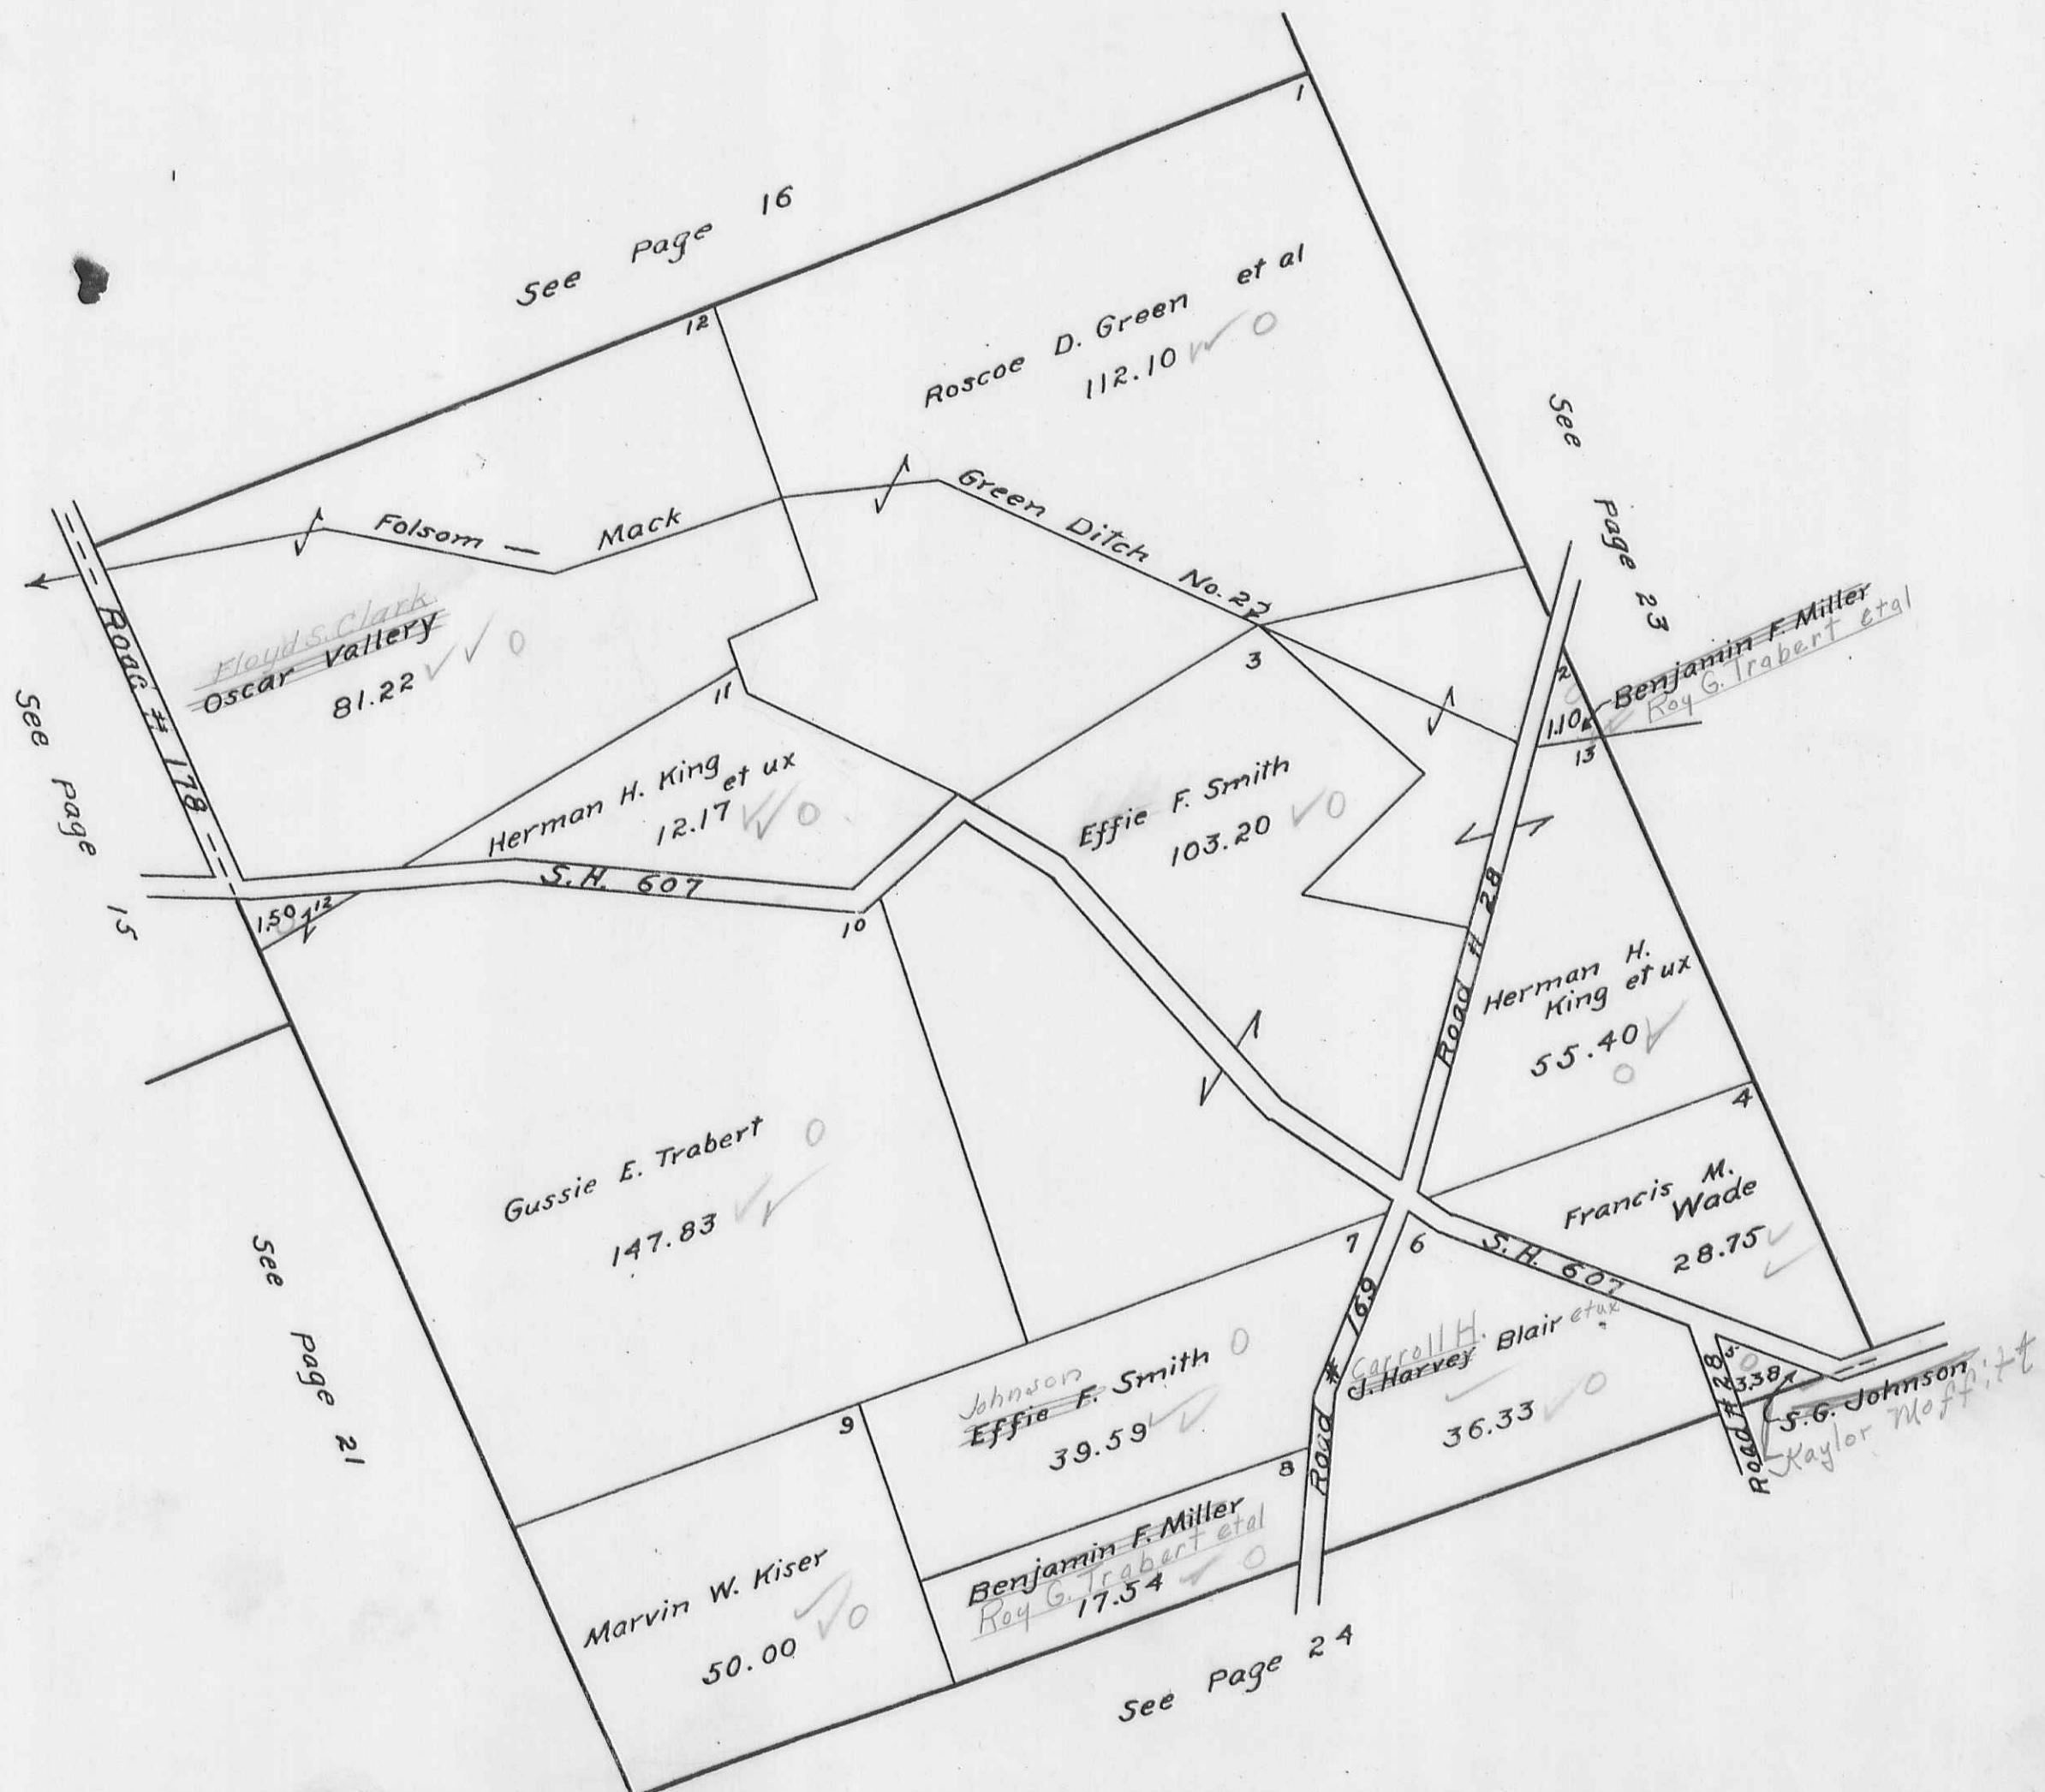

MON ROE TOWNSHIP
VIRGINIA MILITARY SURVEY 3226

SCALE 10 CHAINS TO THE INCH


PAGE 23

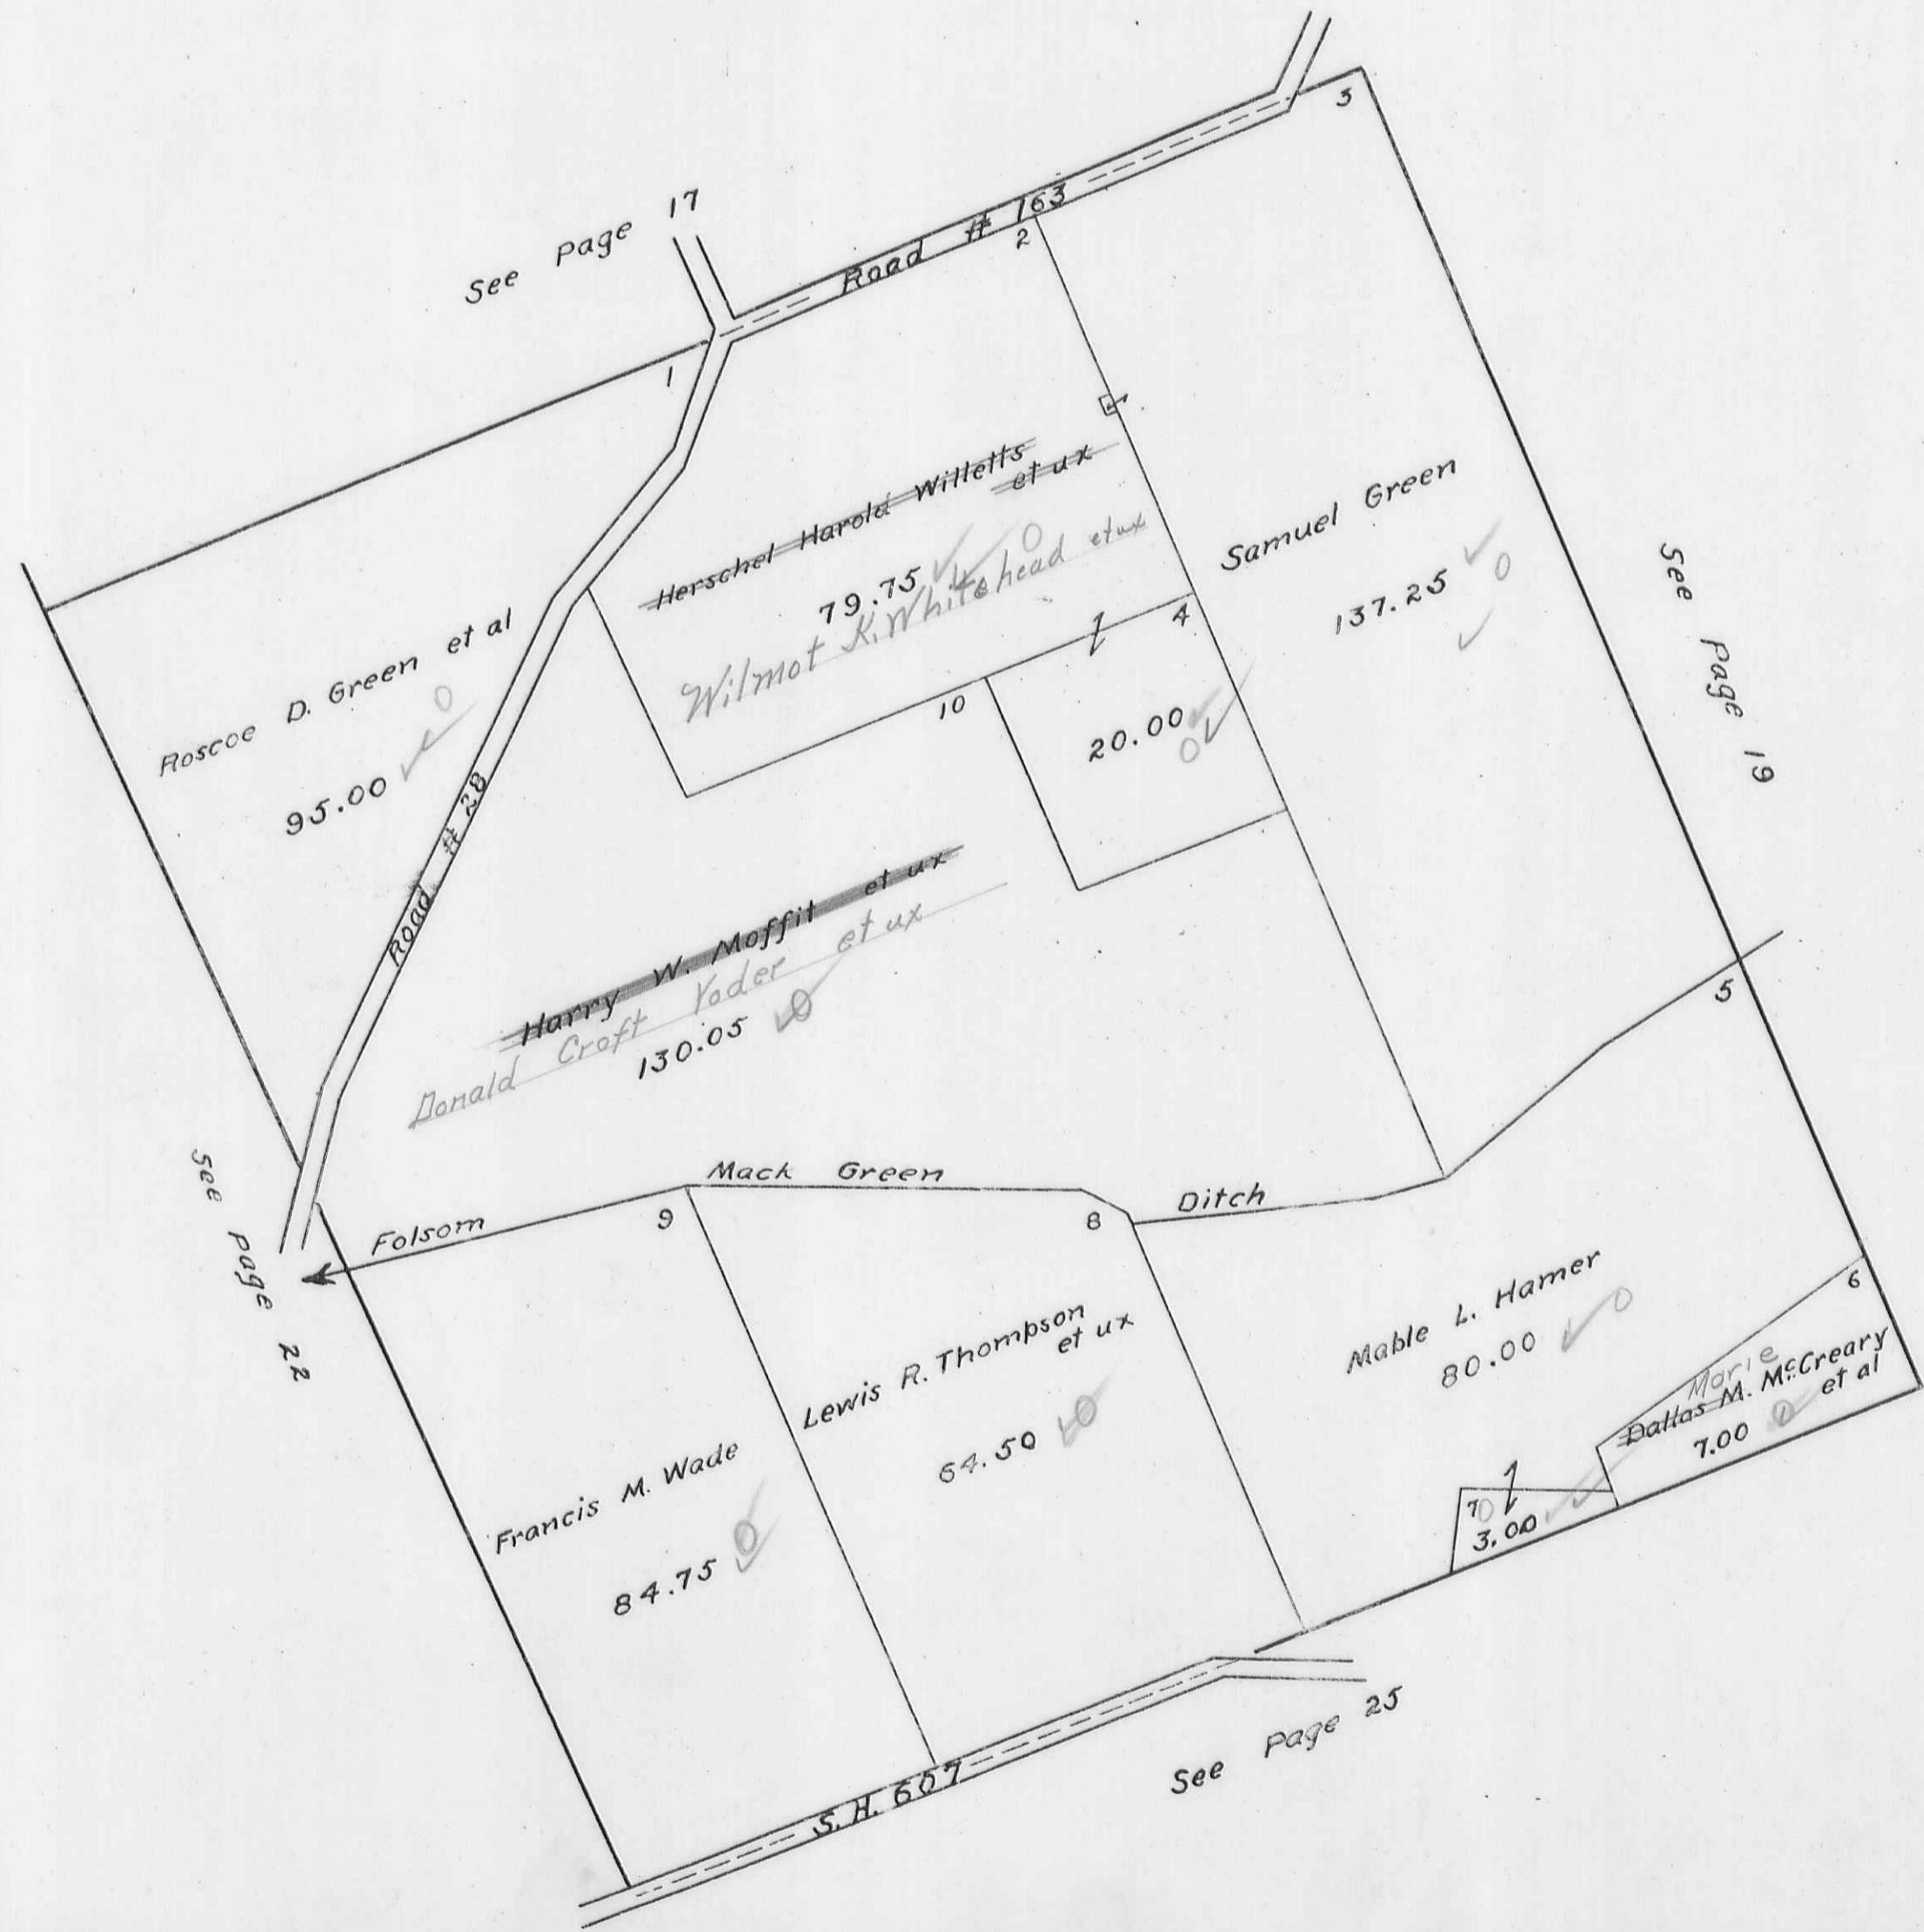

MONROE TOWNSHIP
VIRGINIA MILITARY SURVEY 3227

SCALE 10 CHAINS TO THE INCH

PAGE 24

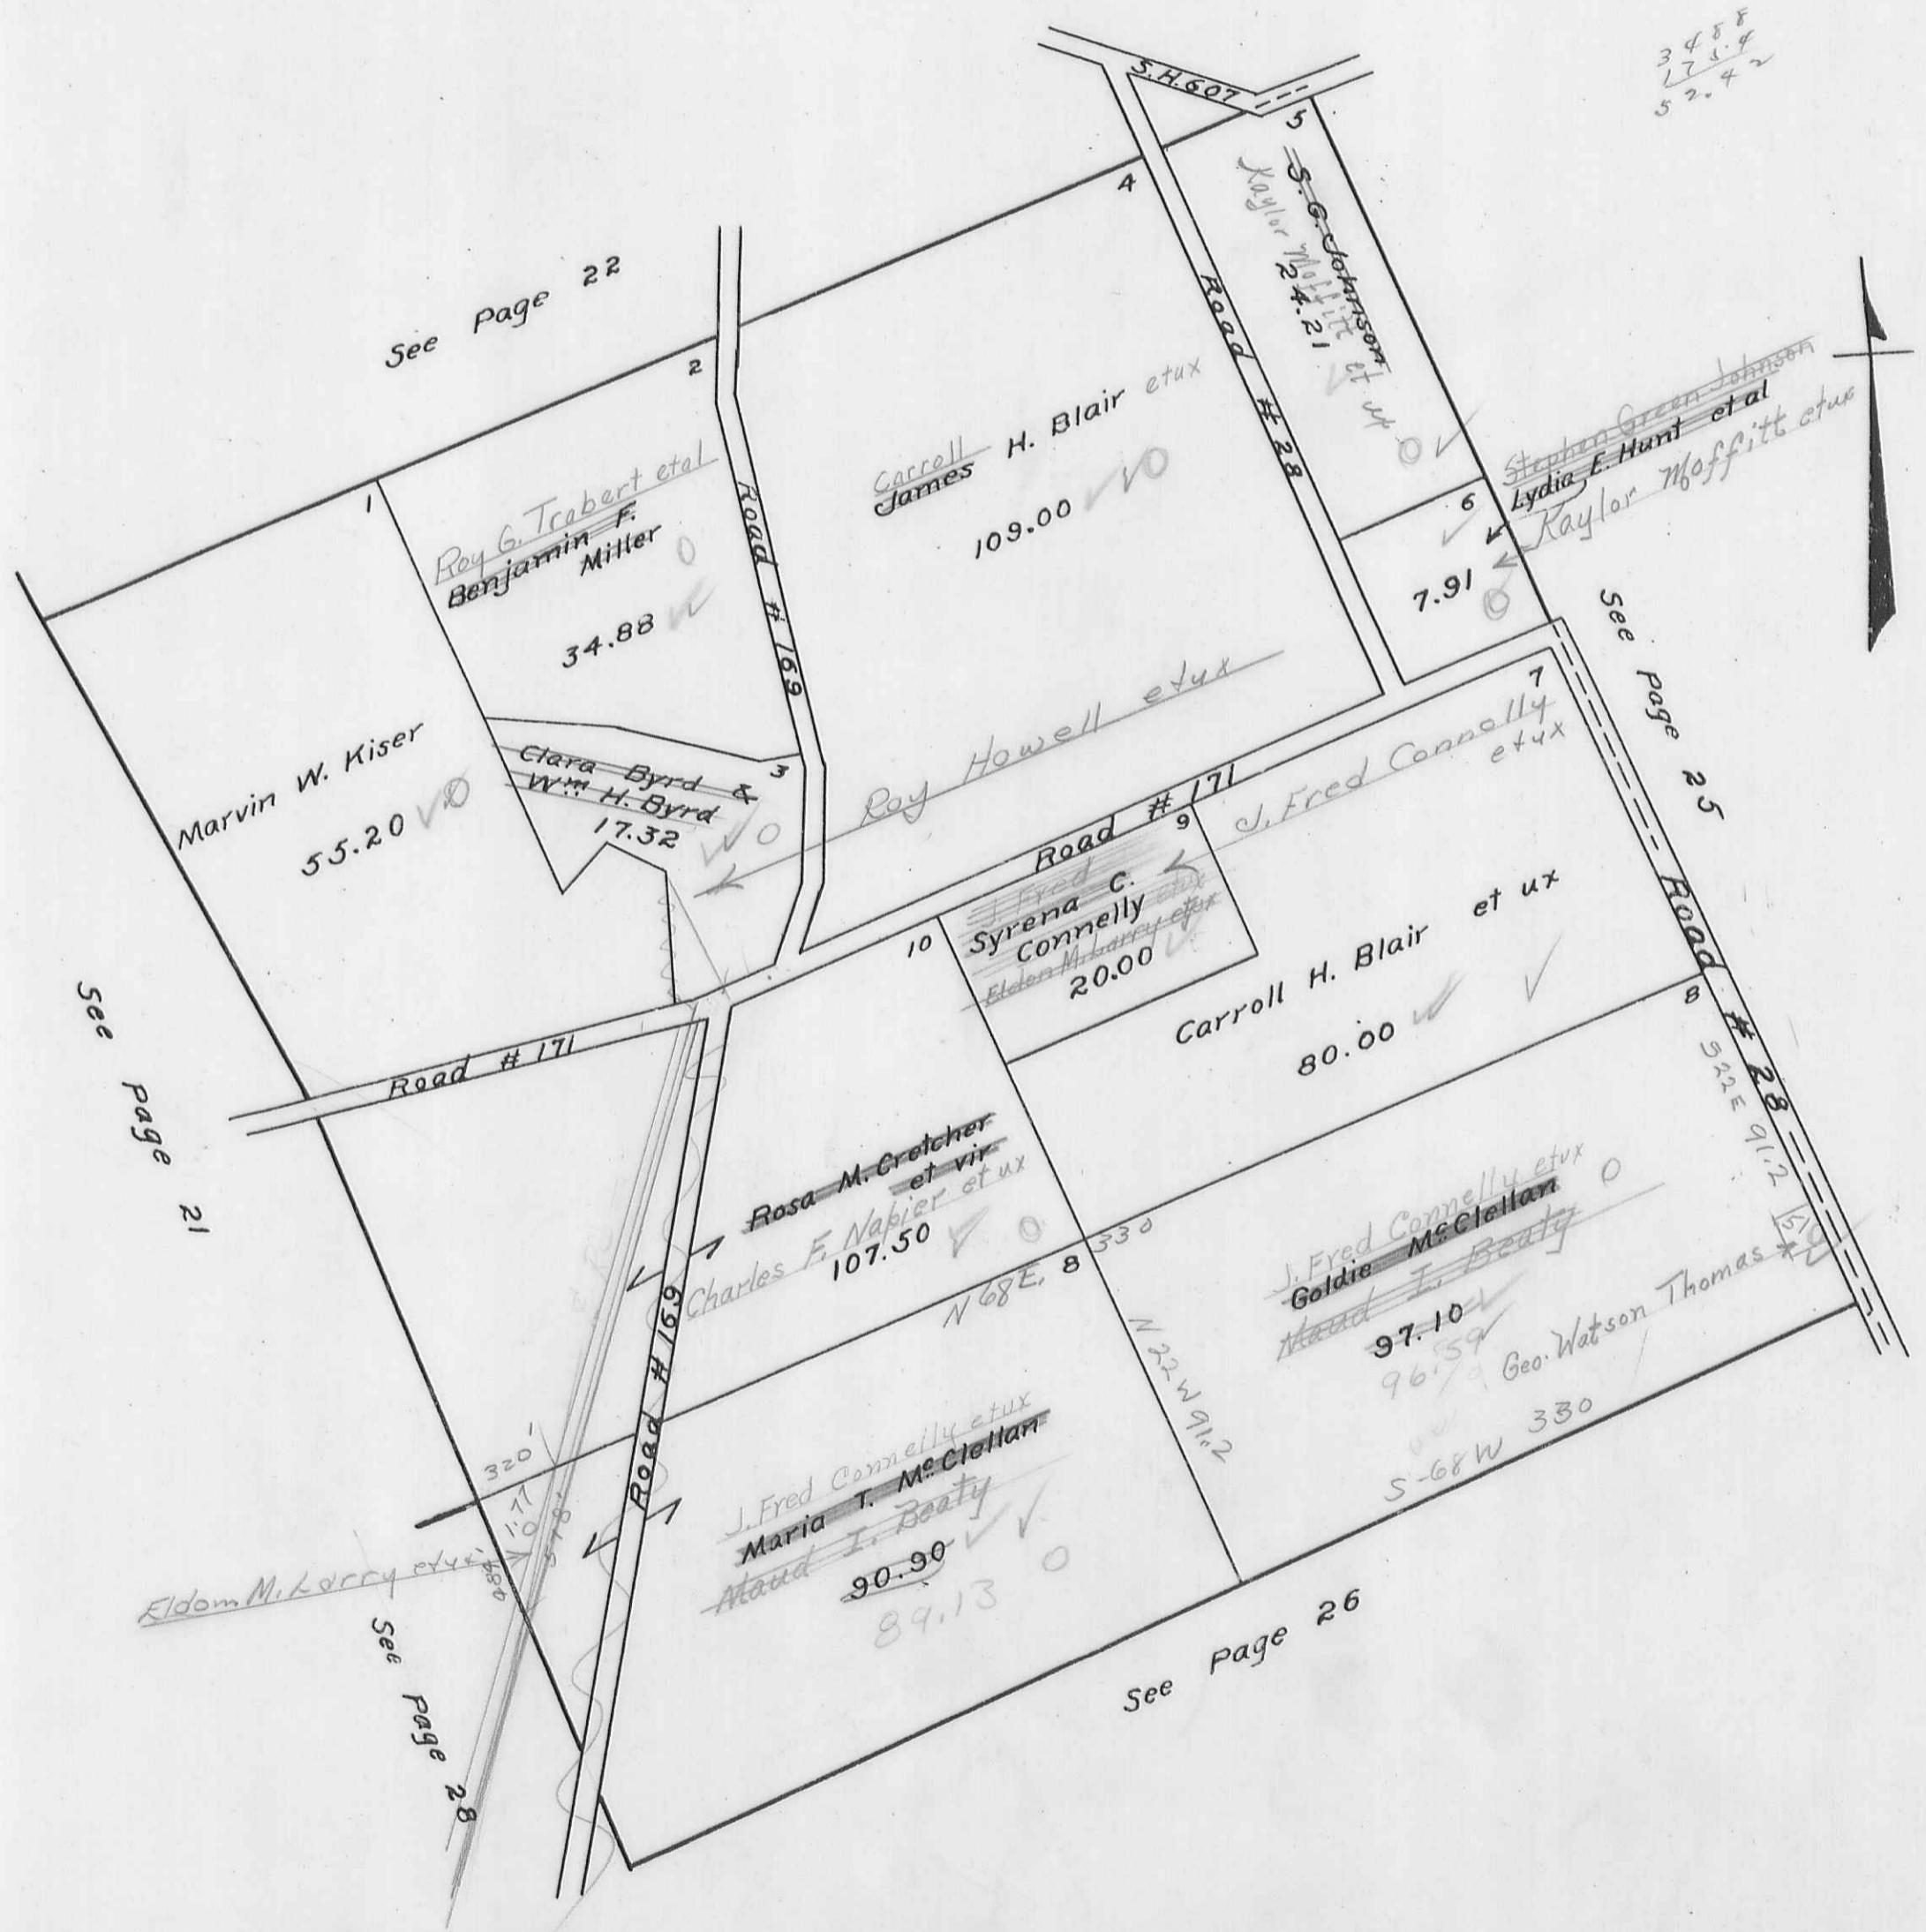


MONROE TOWNSHIP

PAGE 25

VIRGINIA MILITARY SURVEYS

3228
9679

SCALE 10 CHAINS TO THE INCH

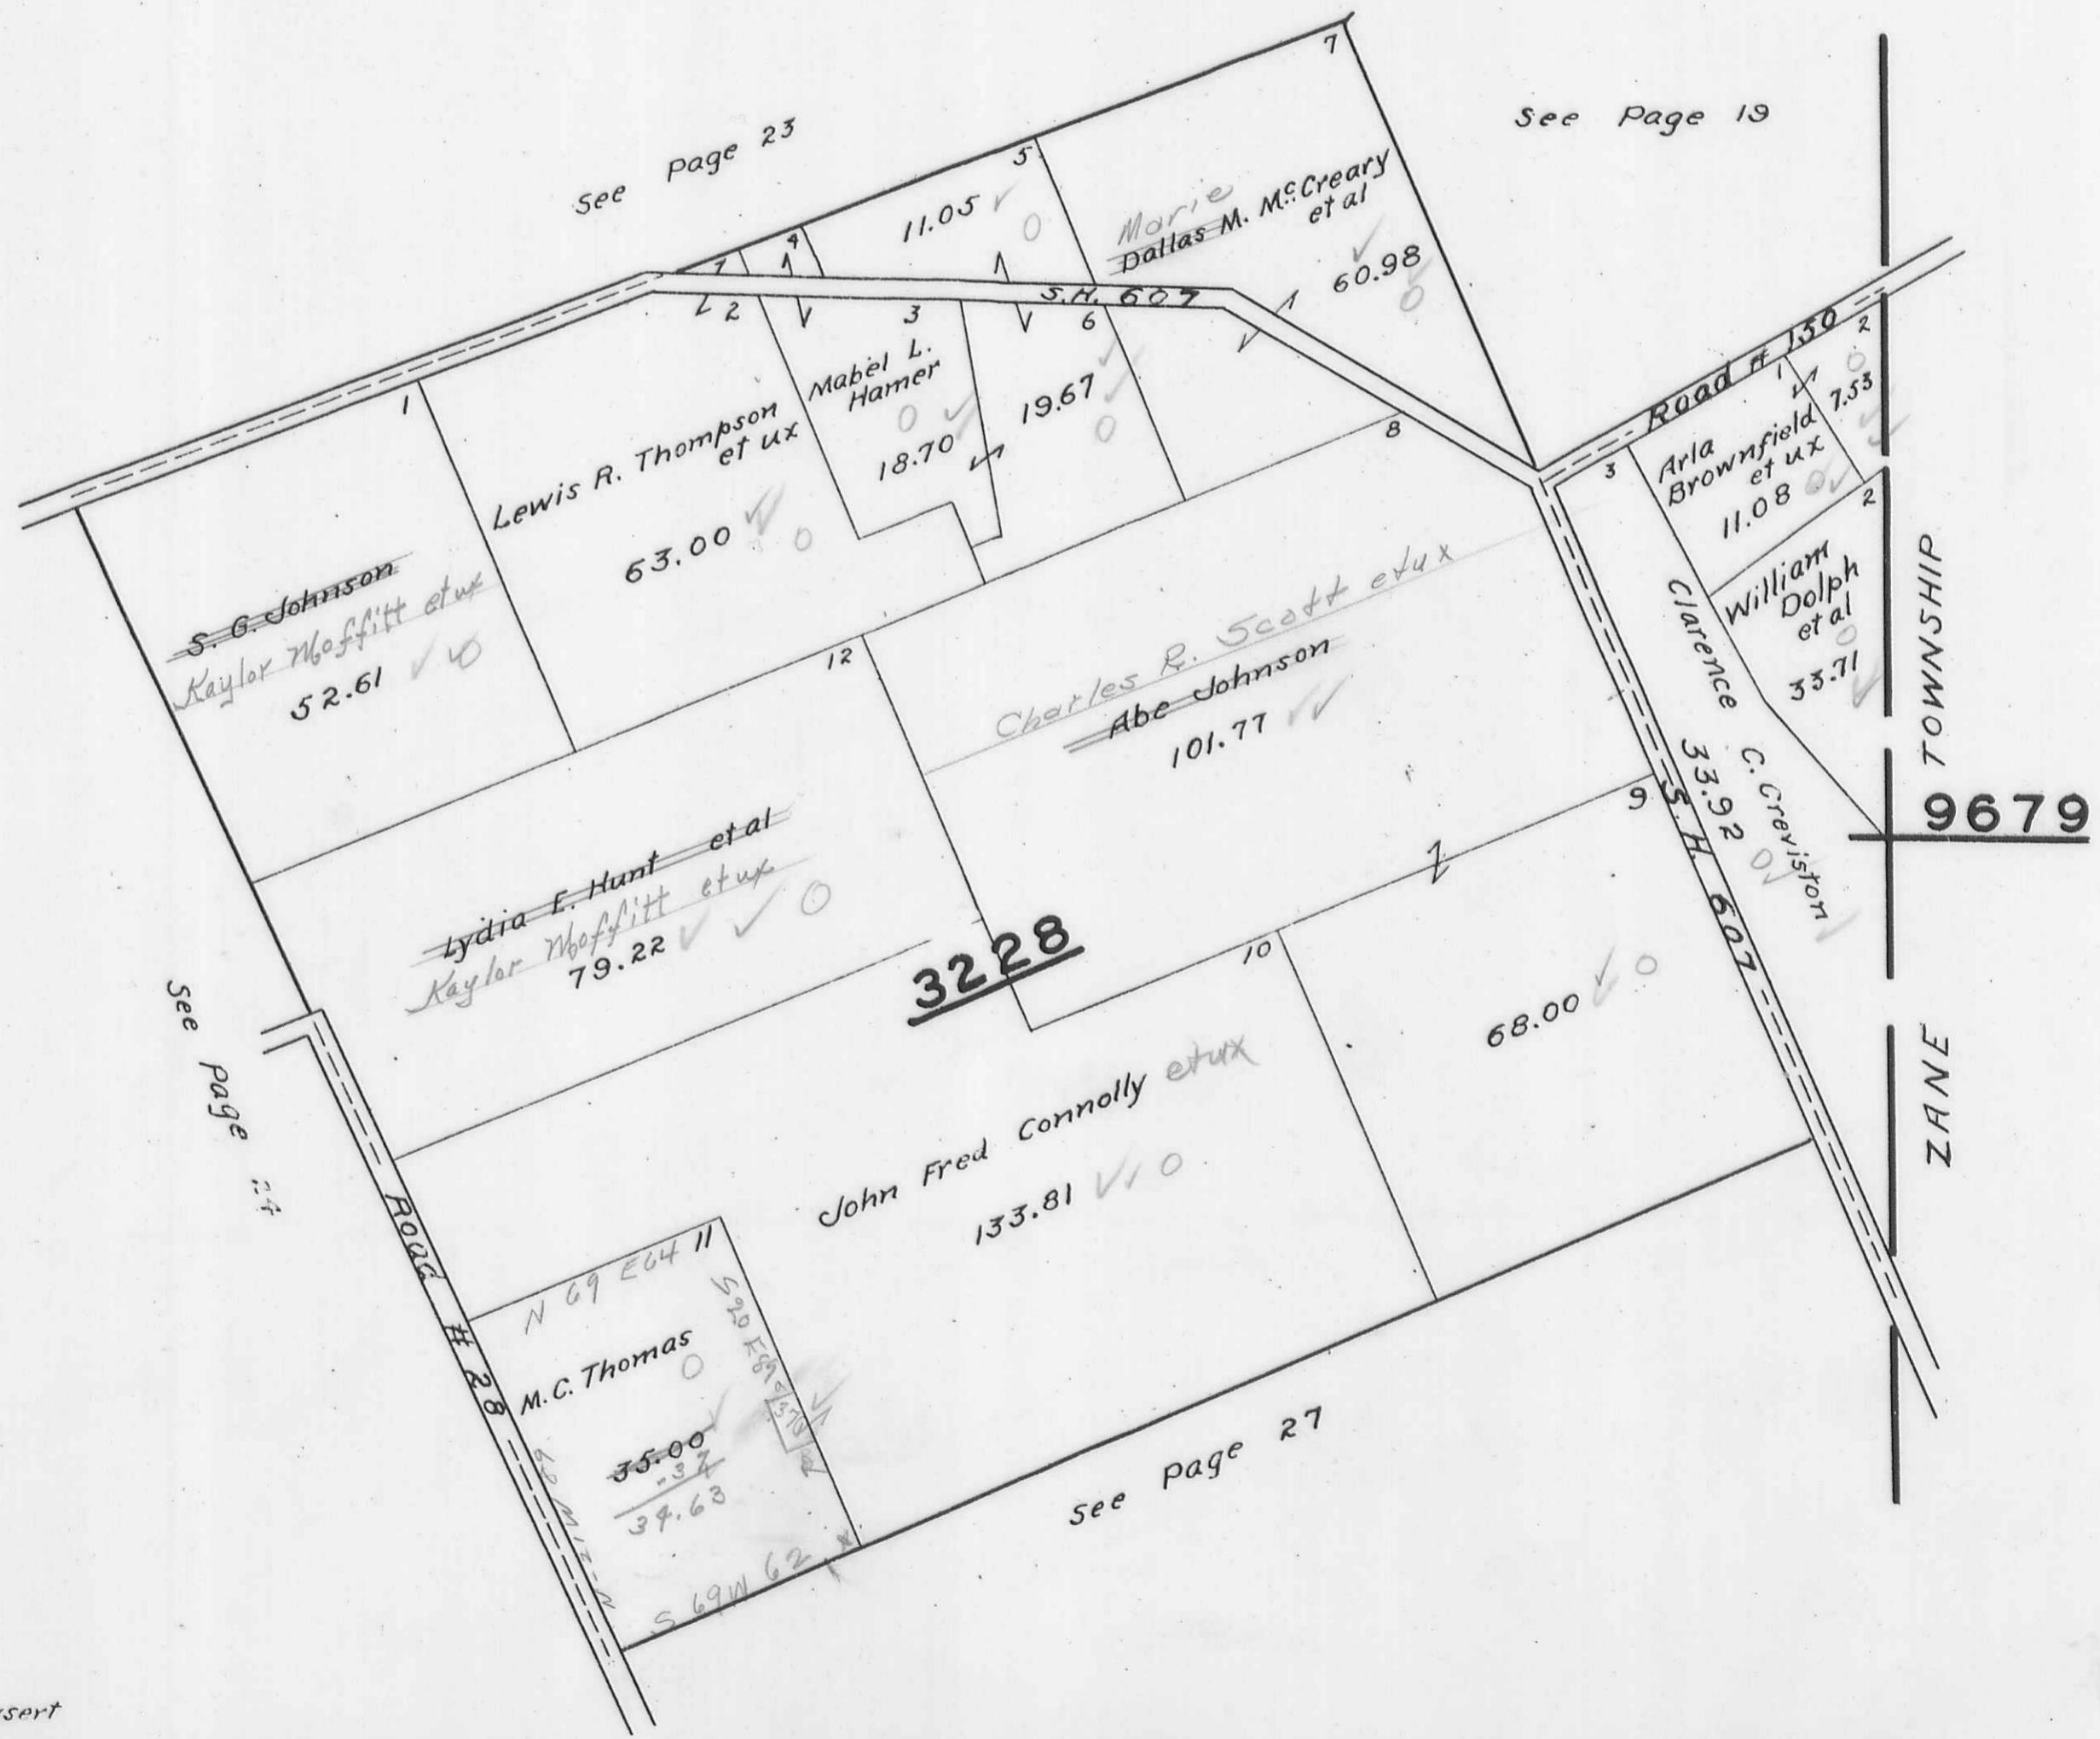


MONROE

TOWNSHIP

PAGE 26

VIRGINIA MILITARY SURVEY 3229

SCALE 10 CHAINS TO THE INCH

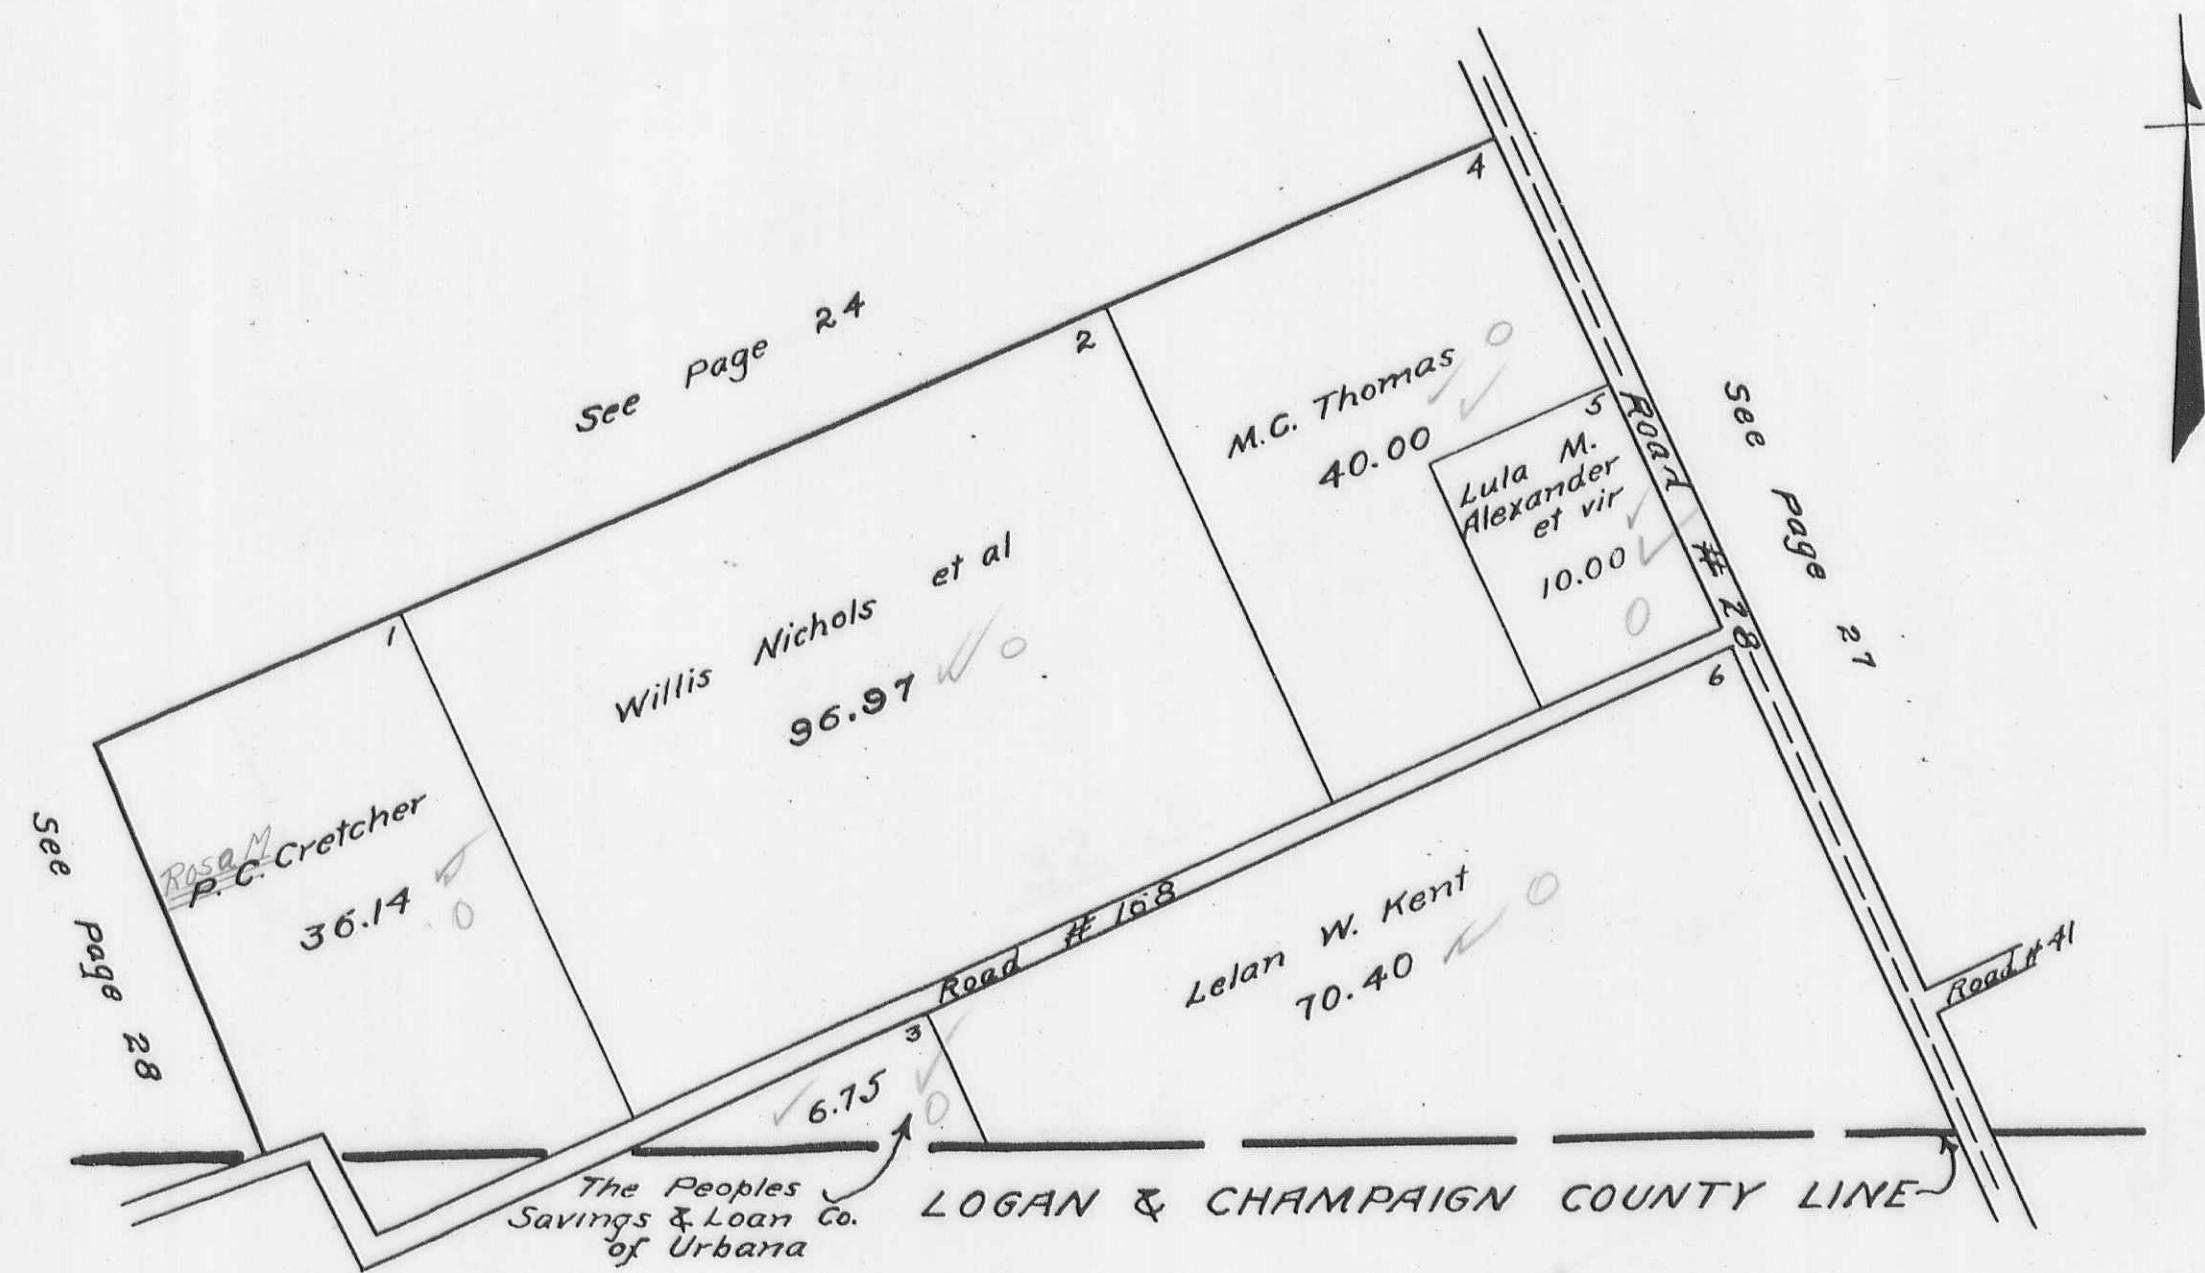


MONROE

TOWNSHIP

PAGE 27

VIRGINIA MILITARY SURVEY 3230

SCALE 10 CHAINS TO THE INCH

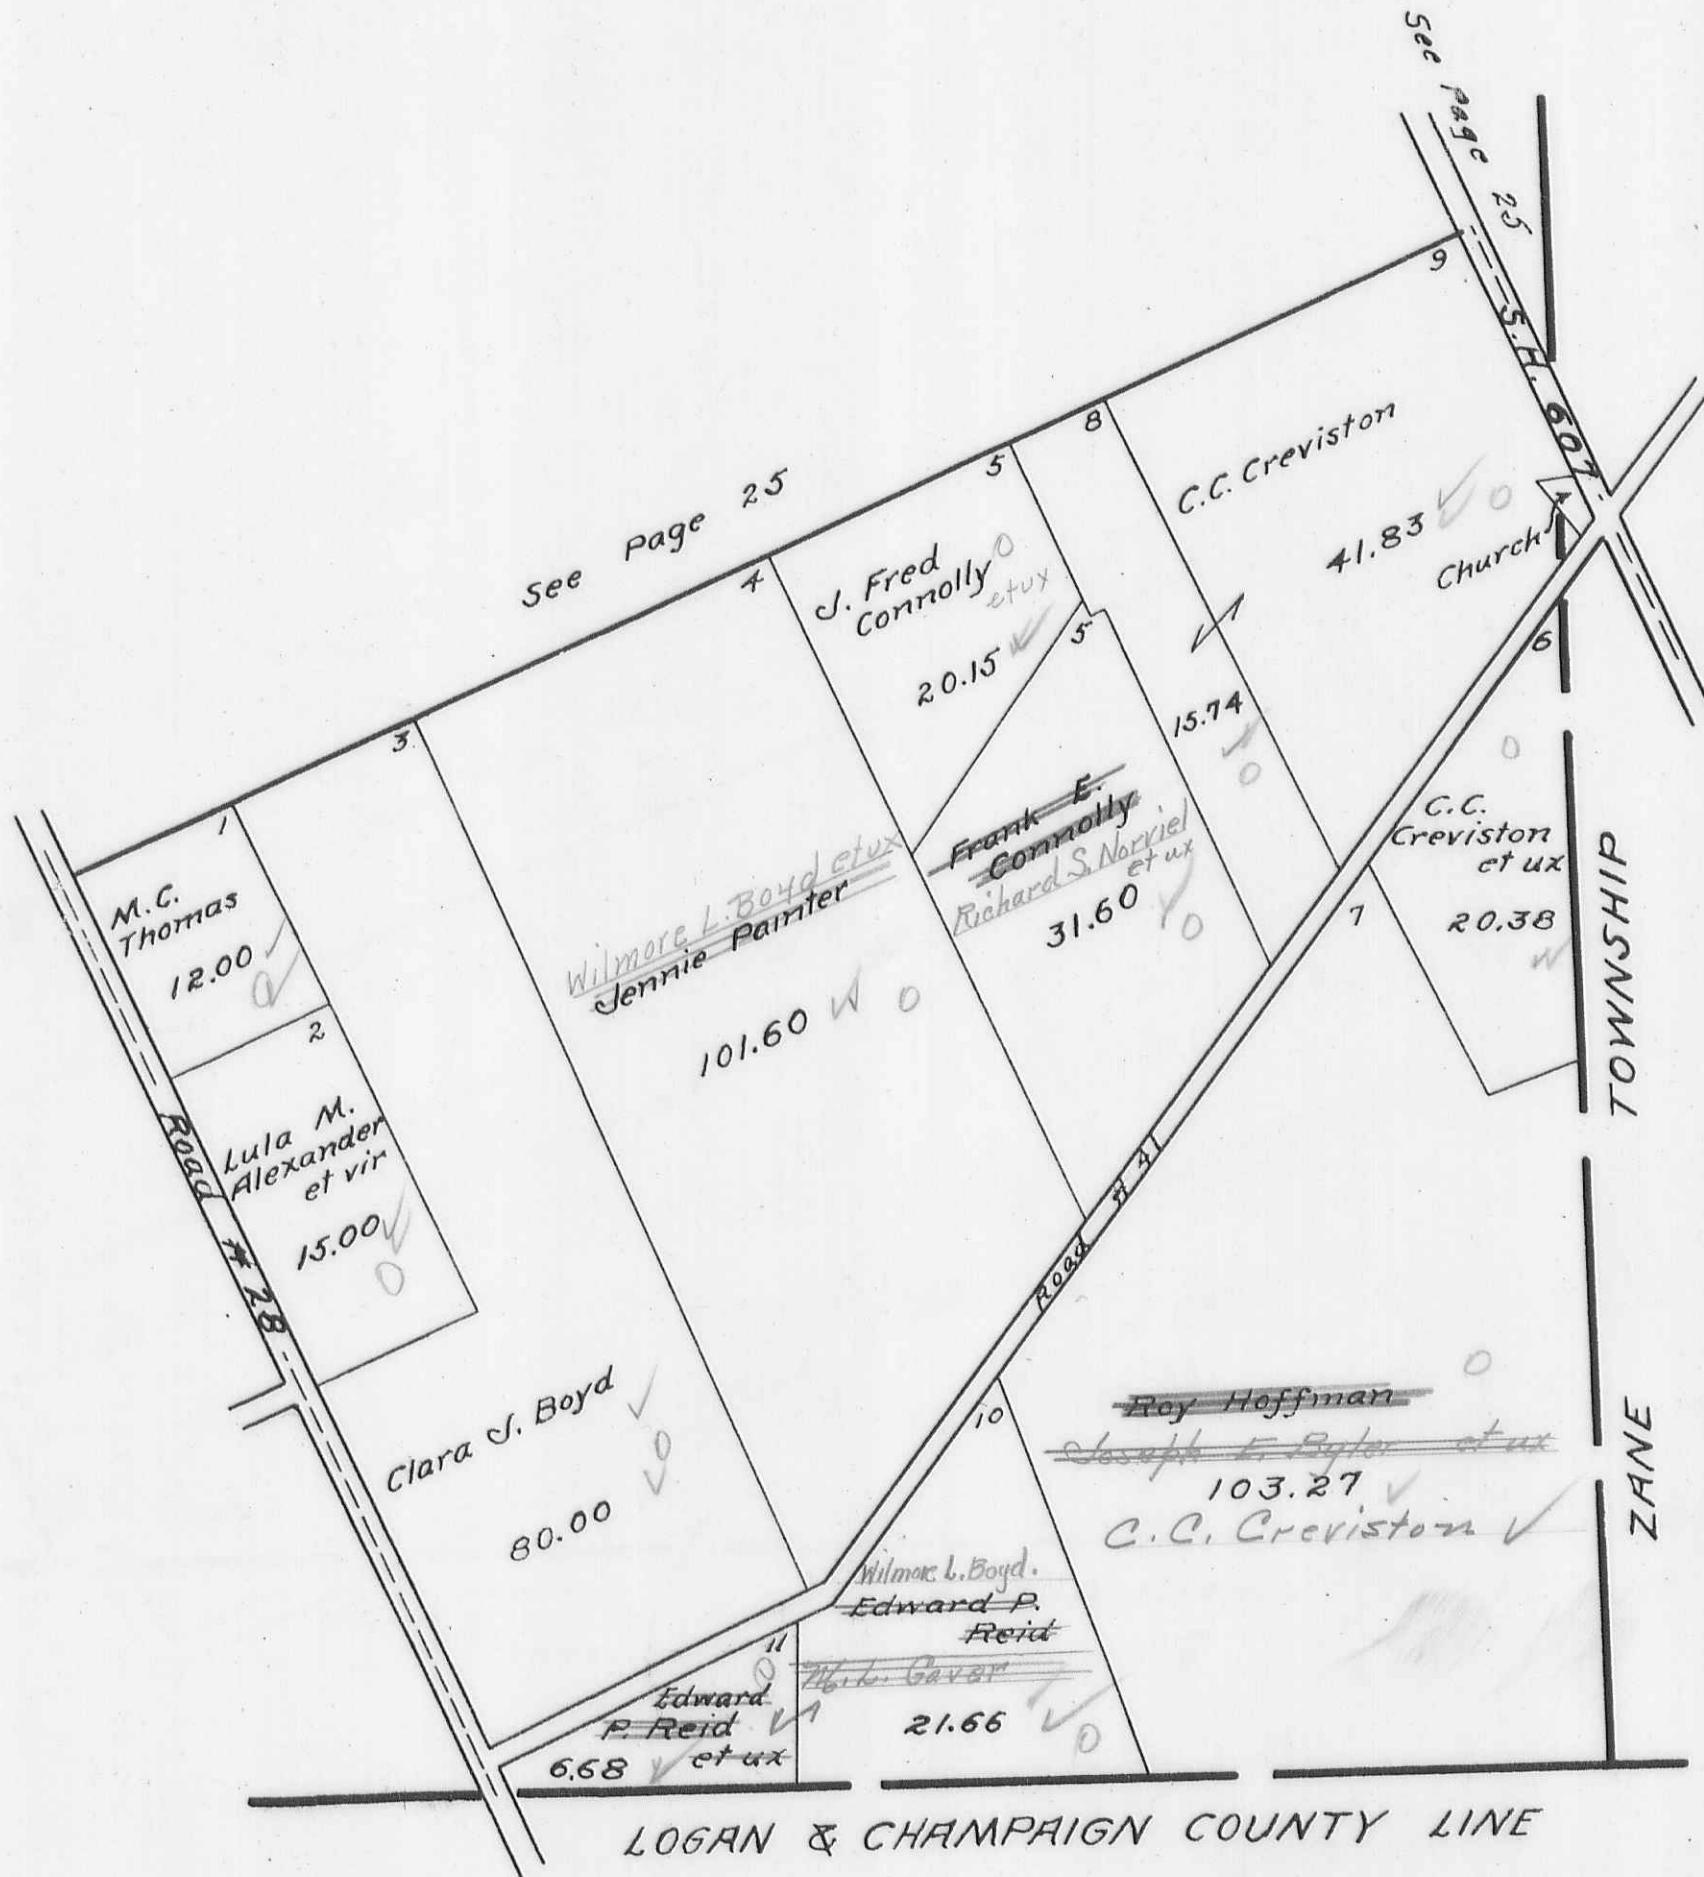


MONROE TOWNSHIP
VIRGINIA MILITARY SURVEYS

PAGE 28

5042
5044

SCALE 10 CHAINS TO THE INCH


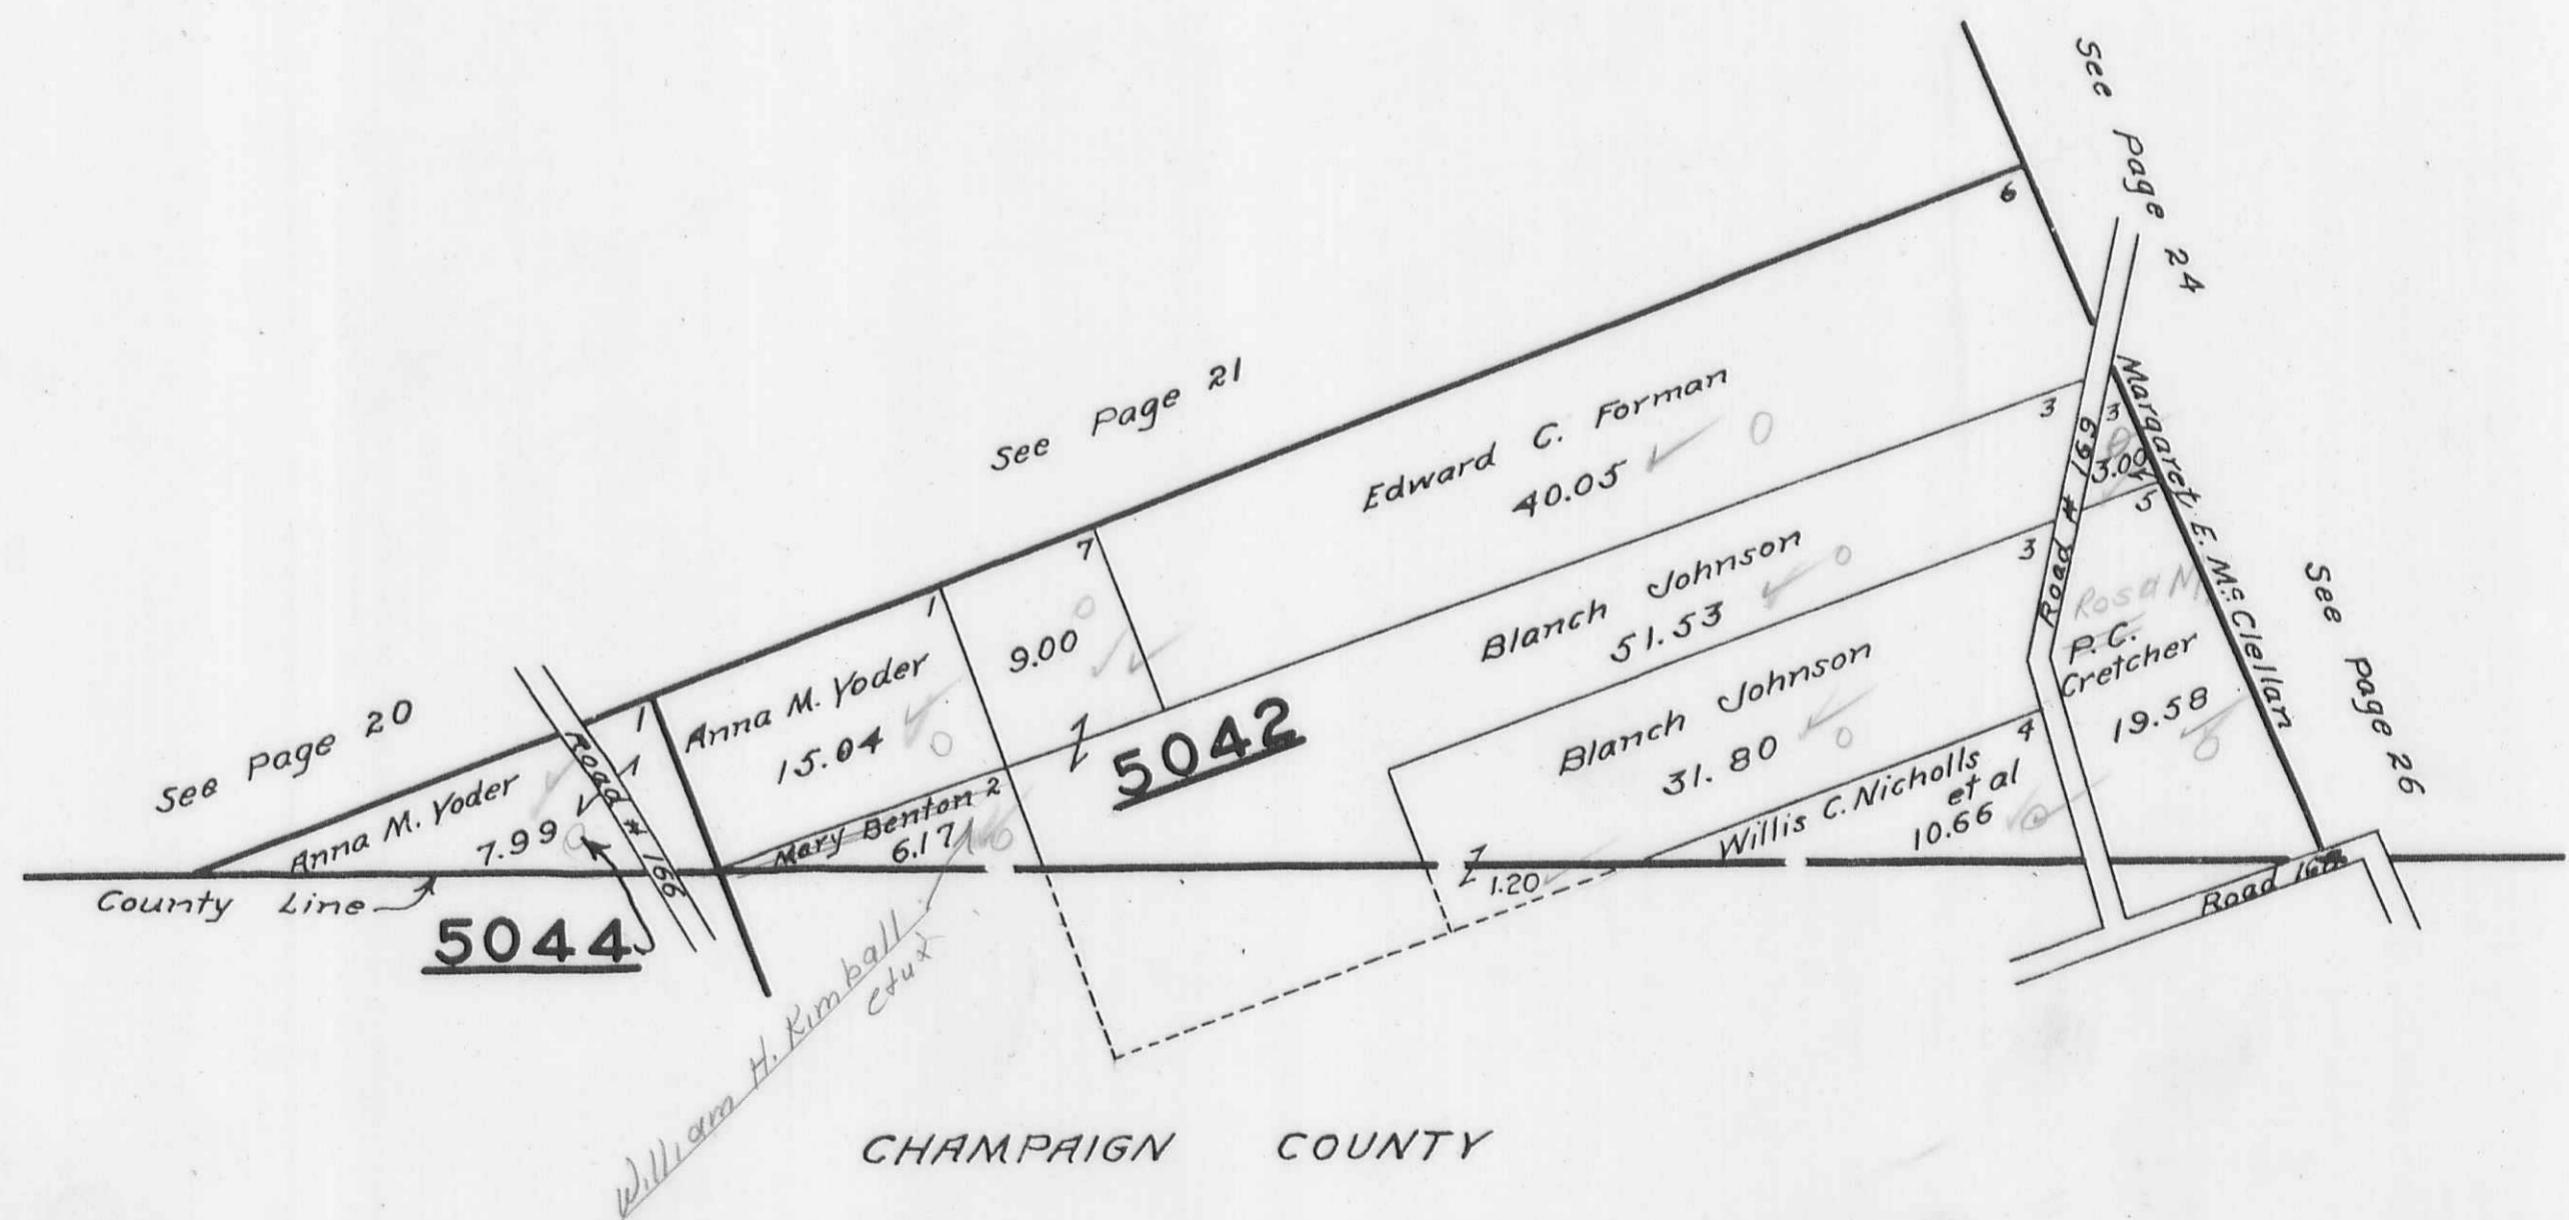


MONROE TOWNSHIP

PAGE 29

SECTION 19 TOWN 4 RANGE 14
SECTION 24 TOWN 5 RANGE 13

SCALE 10 CHAINS TO THE INCH

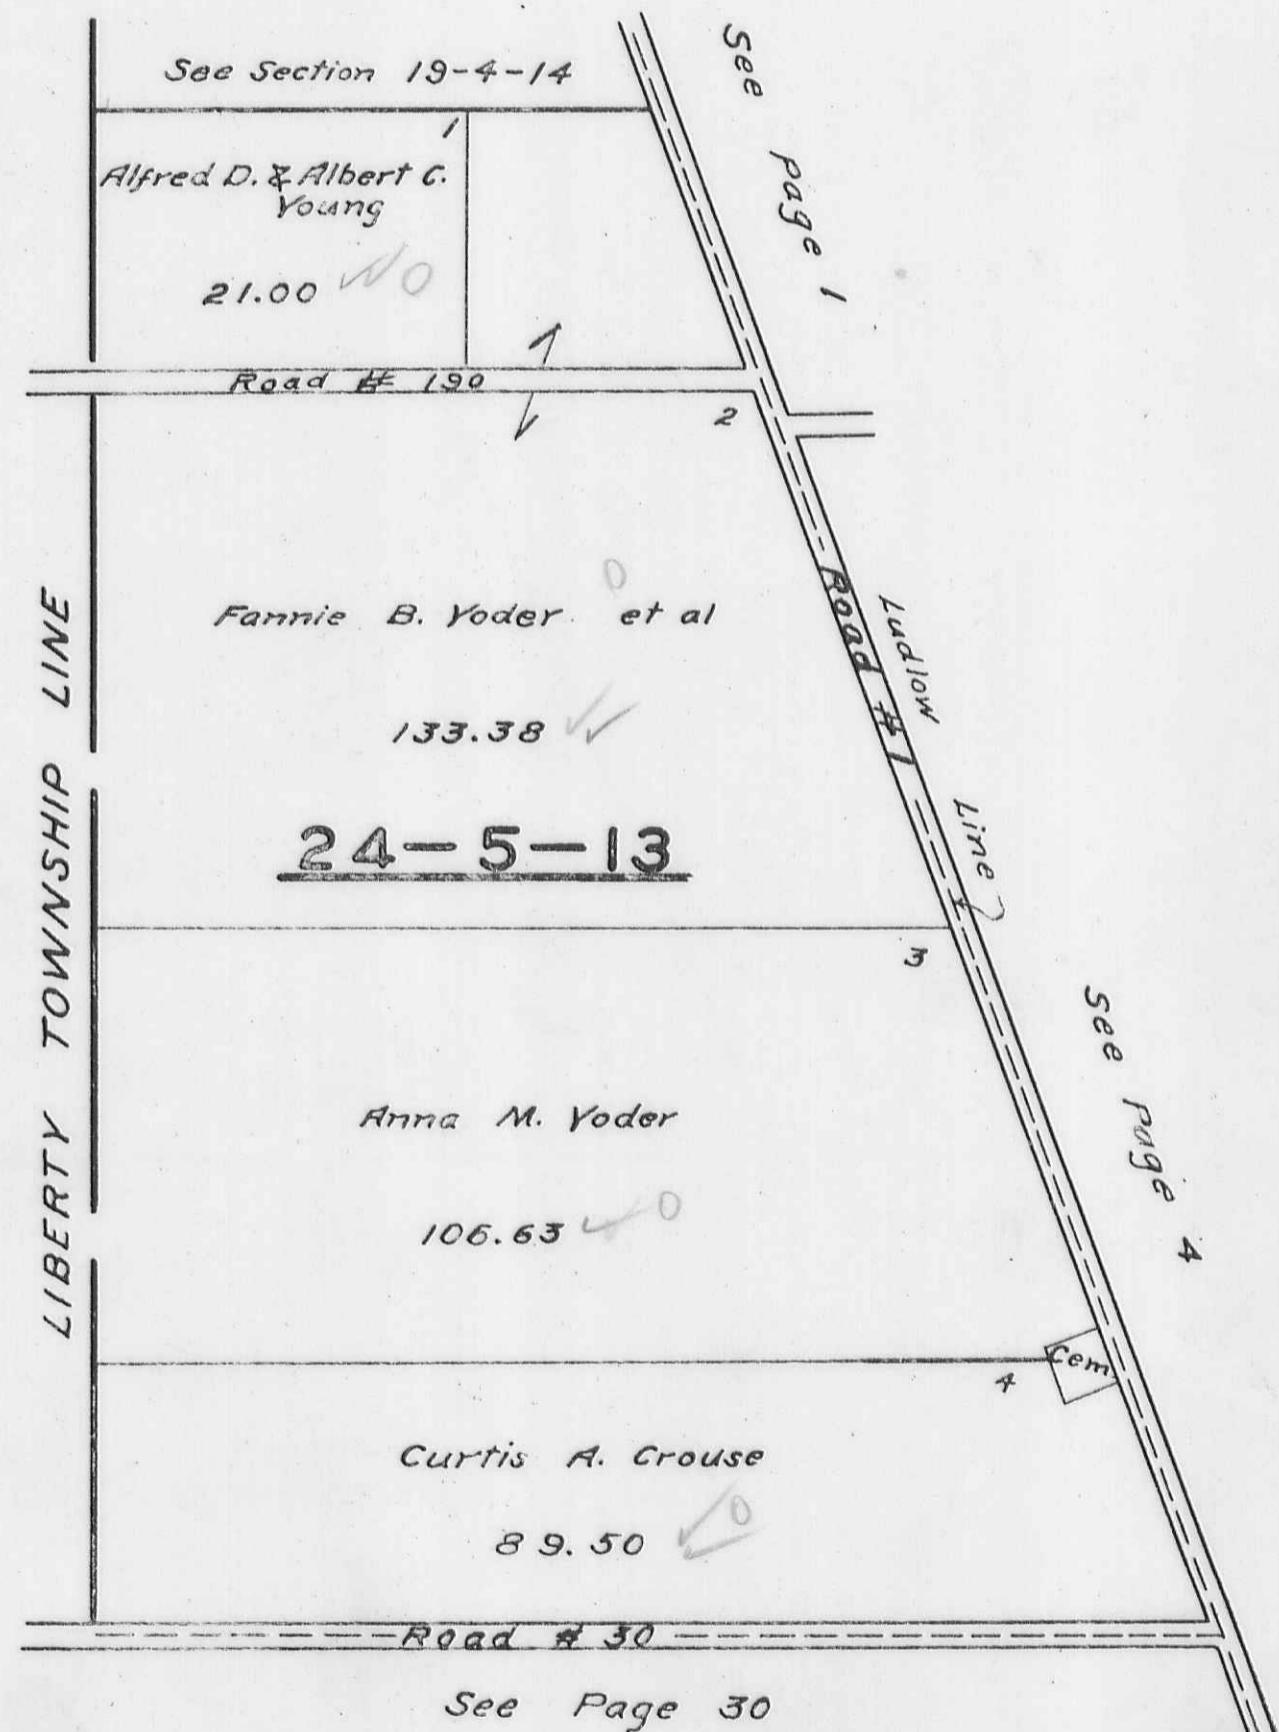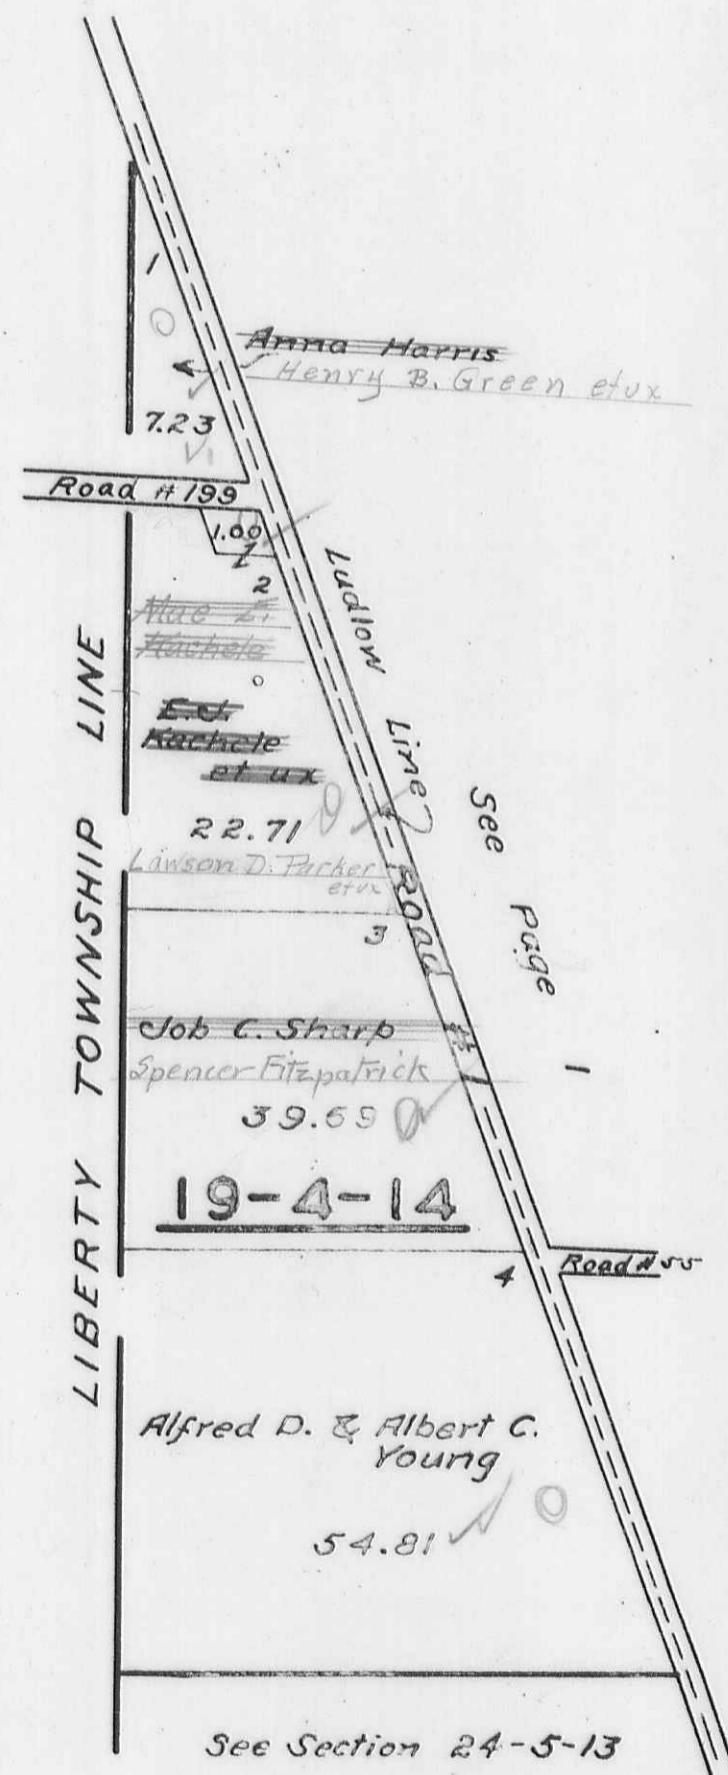


MONROE TOWNSHIP

PAGE 30

SECTION 17 TOWN 5 RANGE 13
SECTION 23 TOWN 5 RANGE 13

SCALE 1 CHAINS TO THE INCH

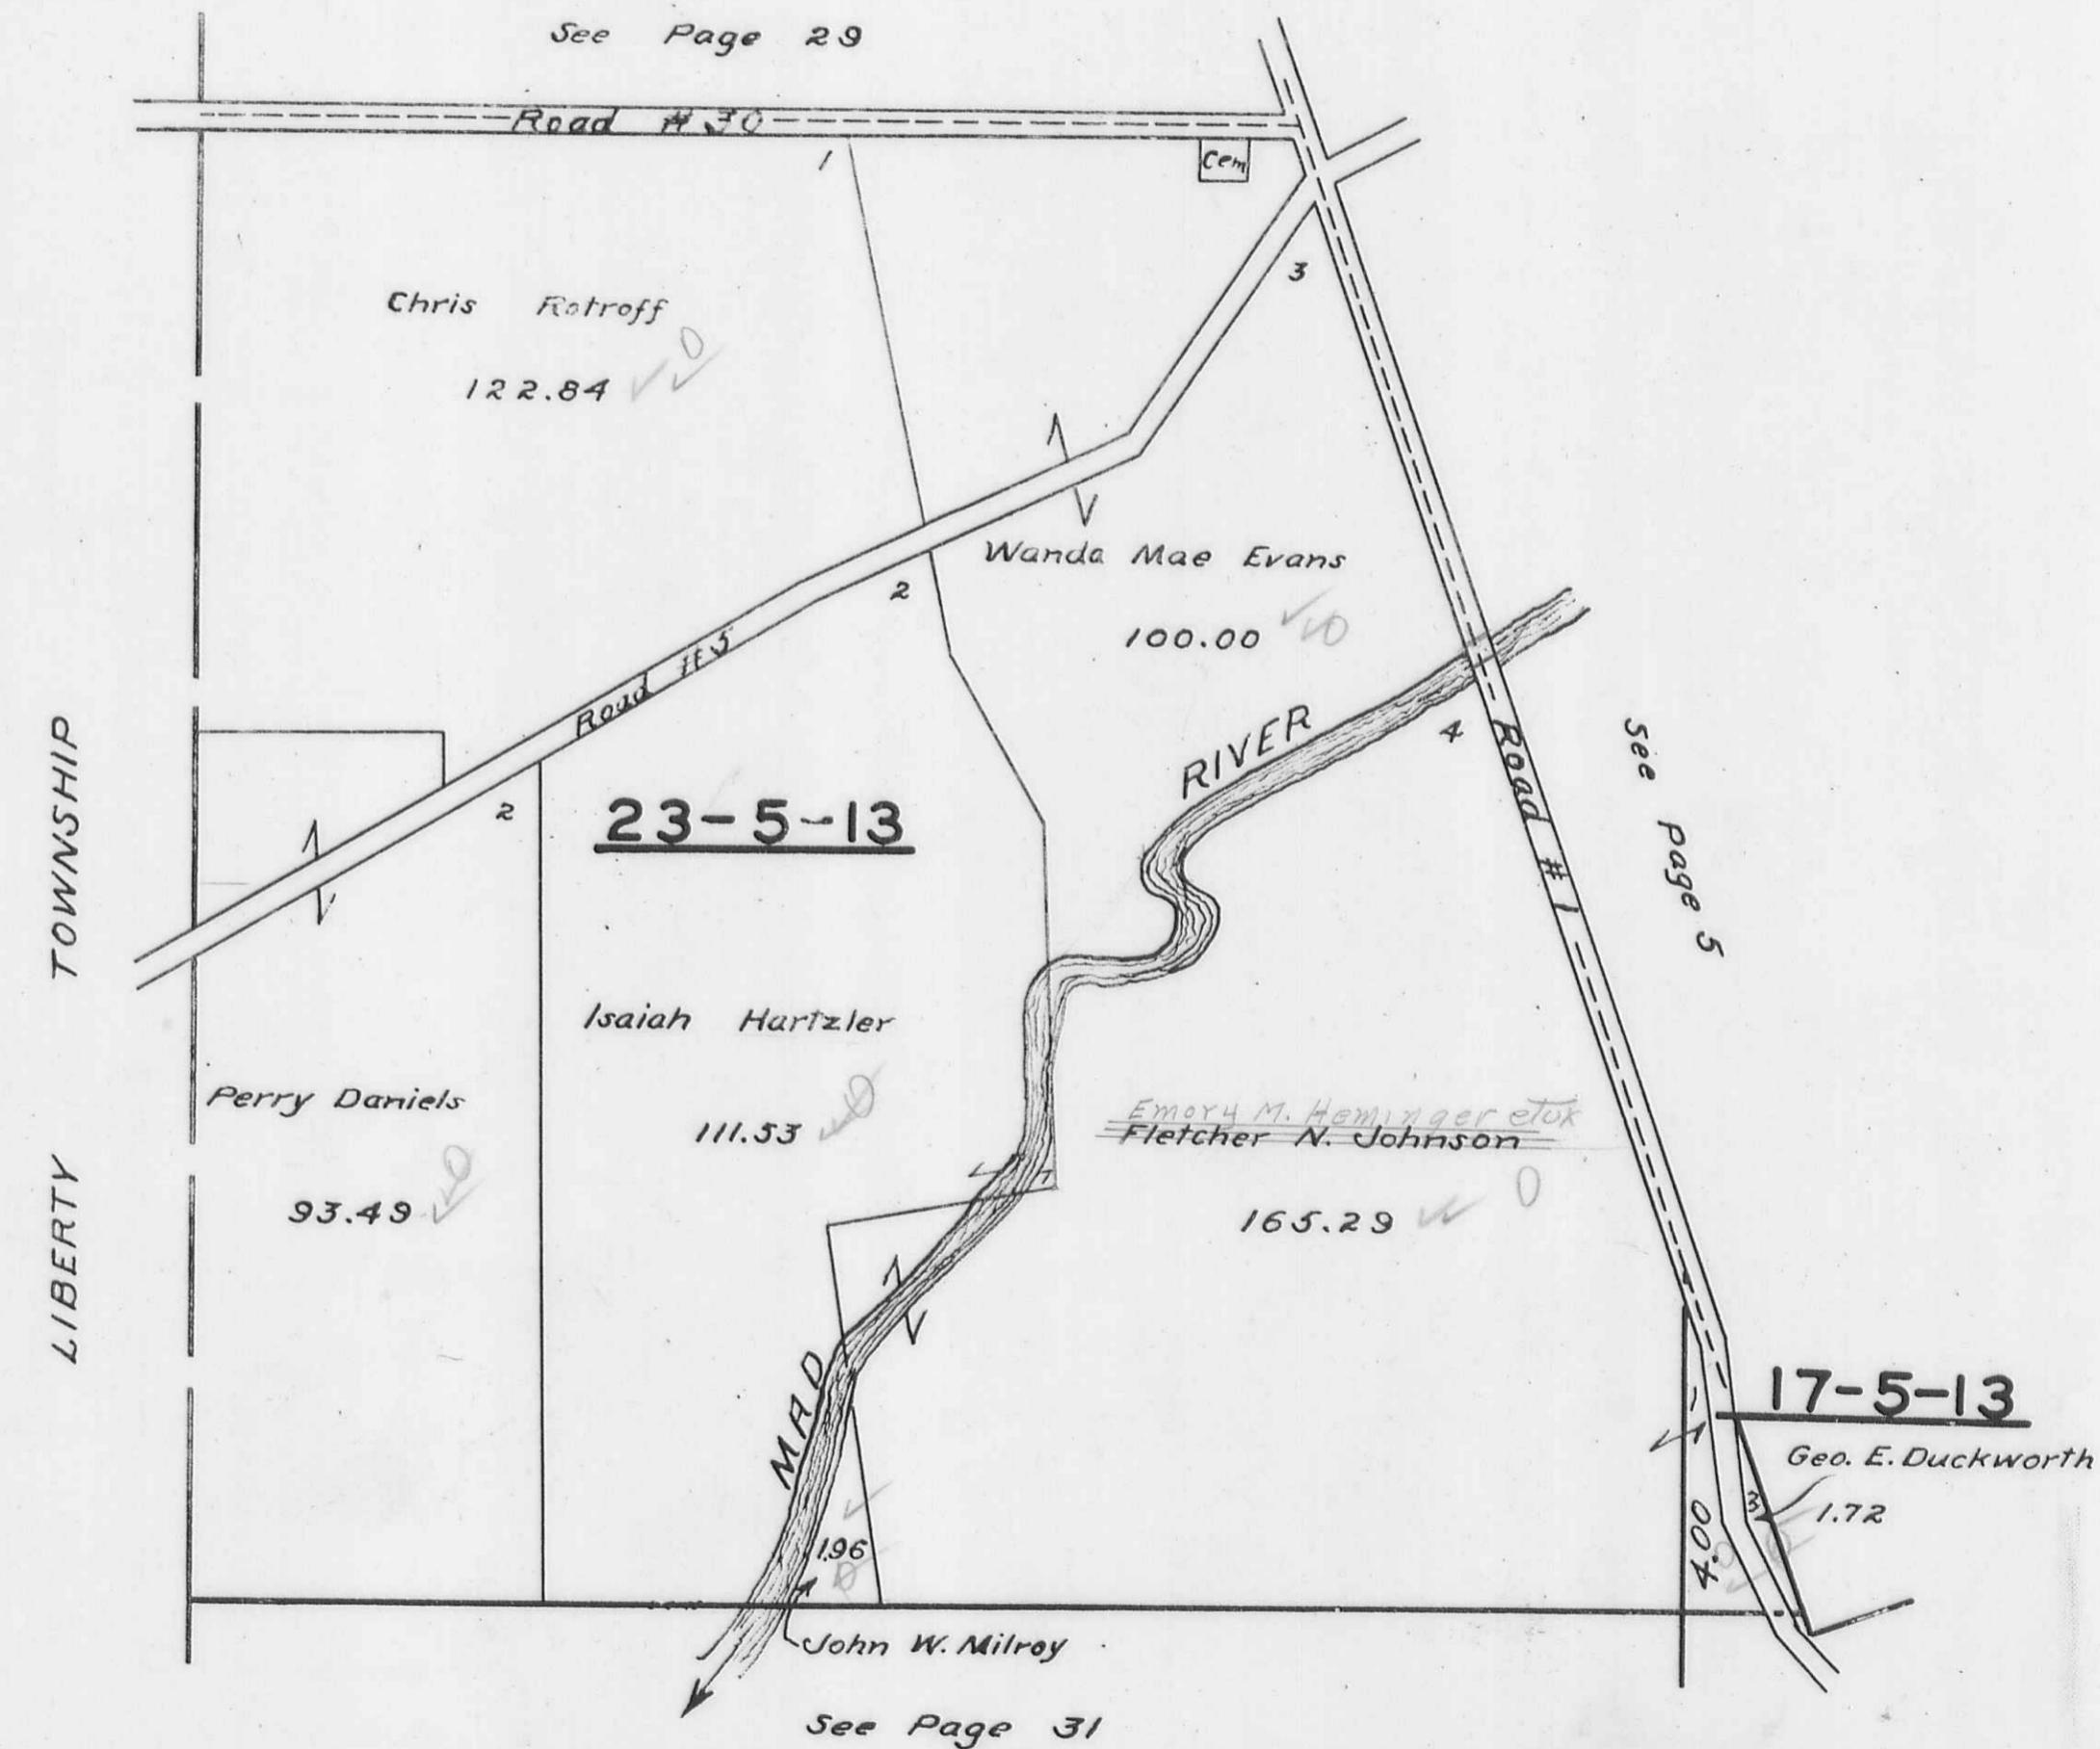


MONROE

TOWNSHIP

PAGE 31

SECTION 22 TOWN 5 RANGE 13
SECTION 16 TOWN 5 RANGE 13


SCALE 10 CHAINS TO THE INCH

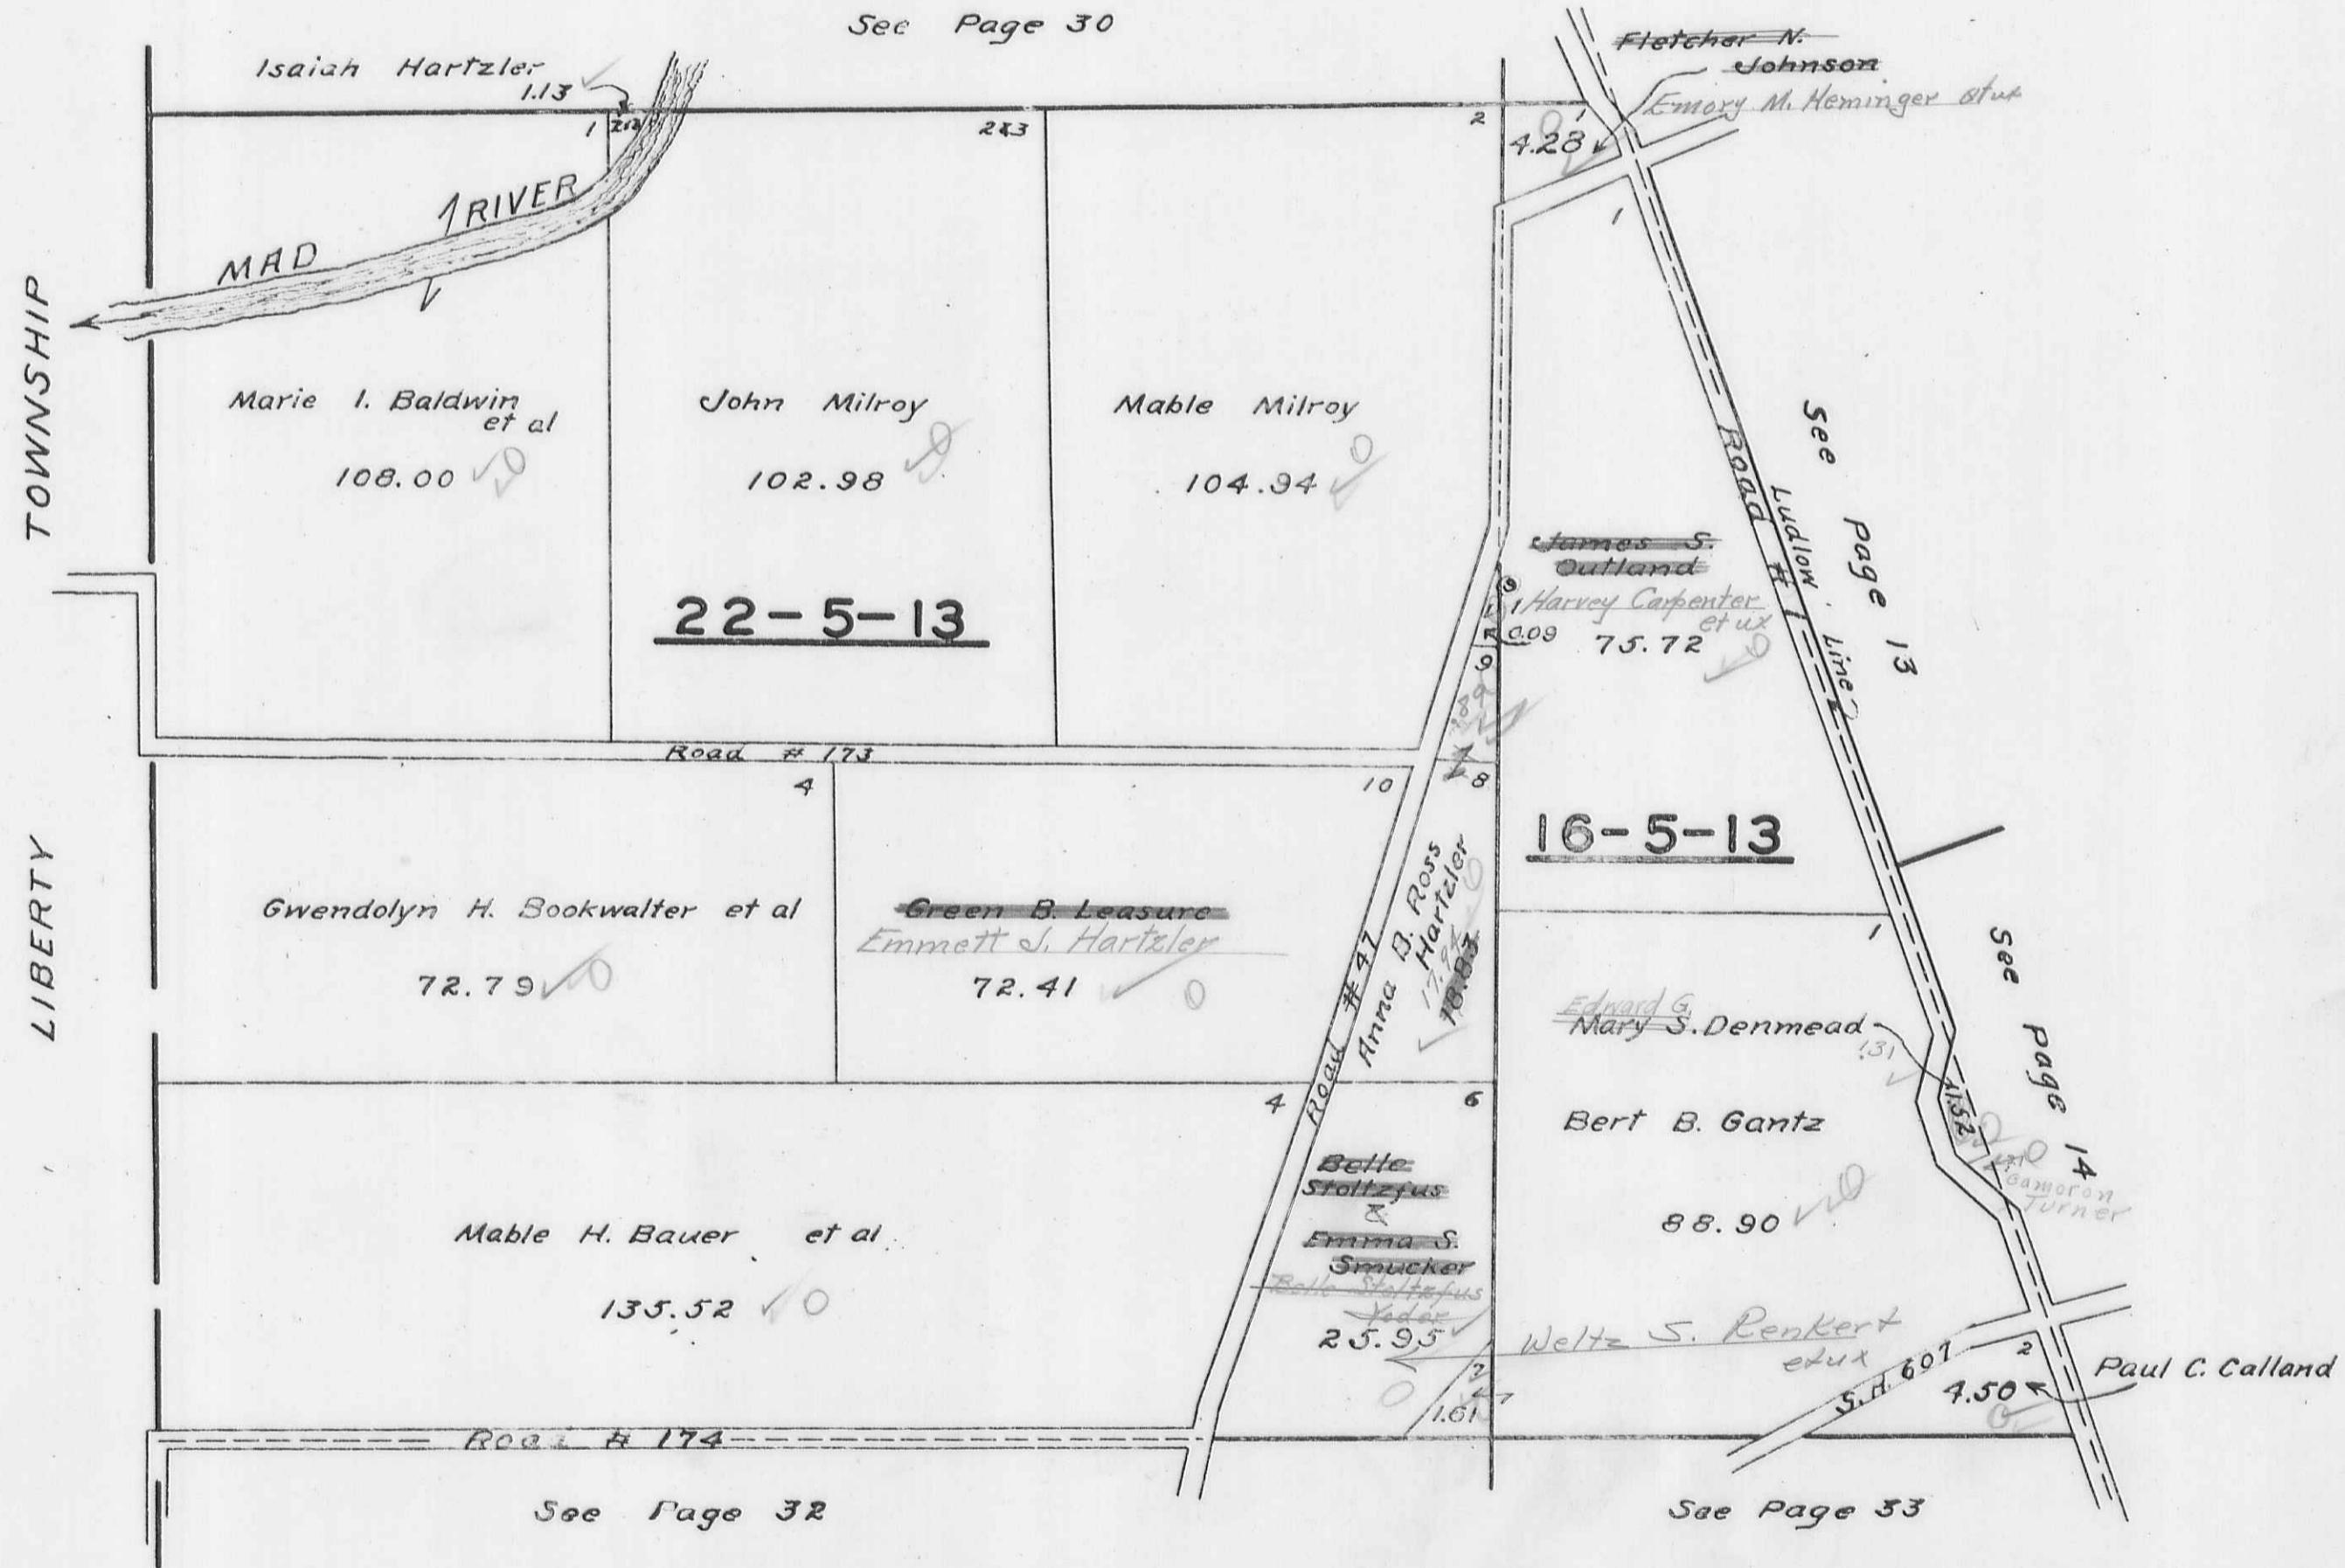

MONROE TOWNSHIP
SECTION 21 TOWN 5 RANGE 13

PAGE 32


SCALE 10 CHAINS TO THE INCH

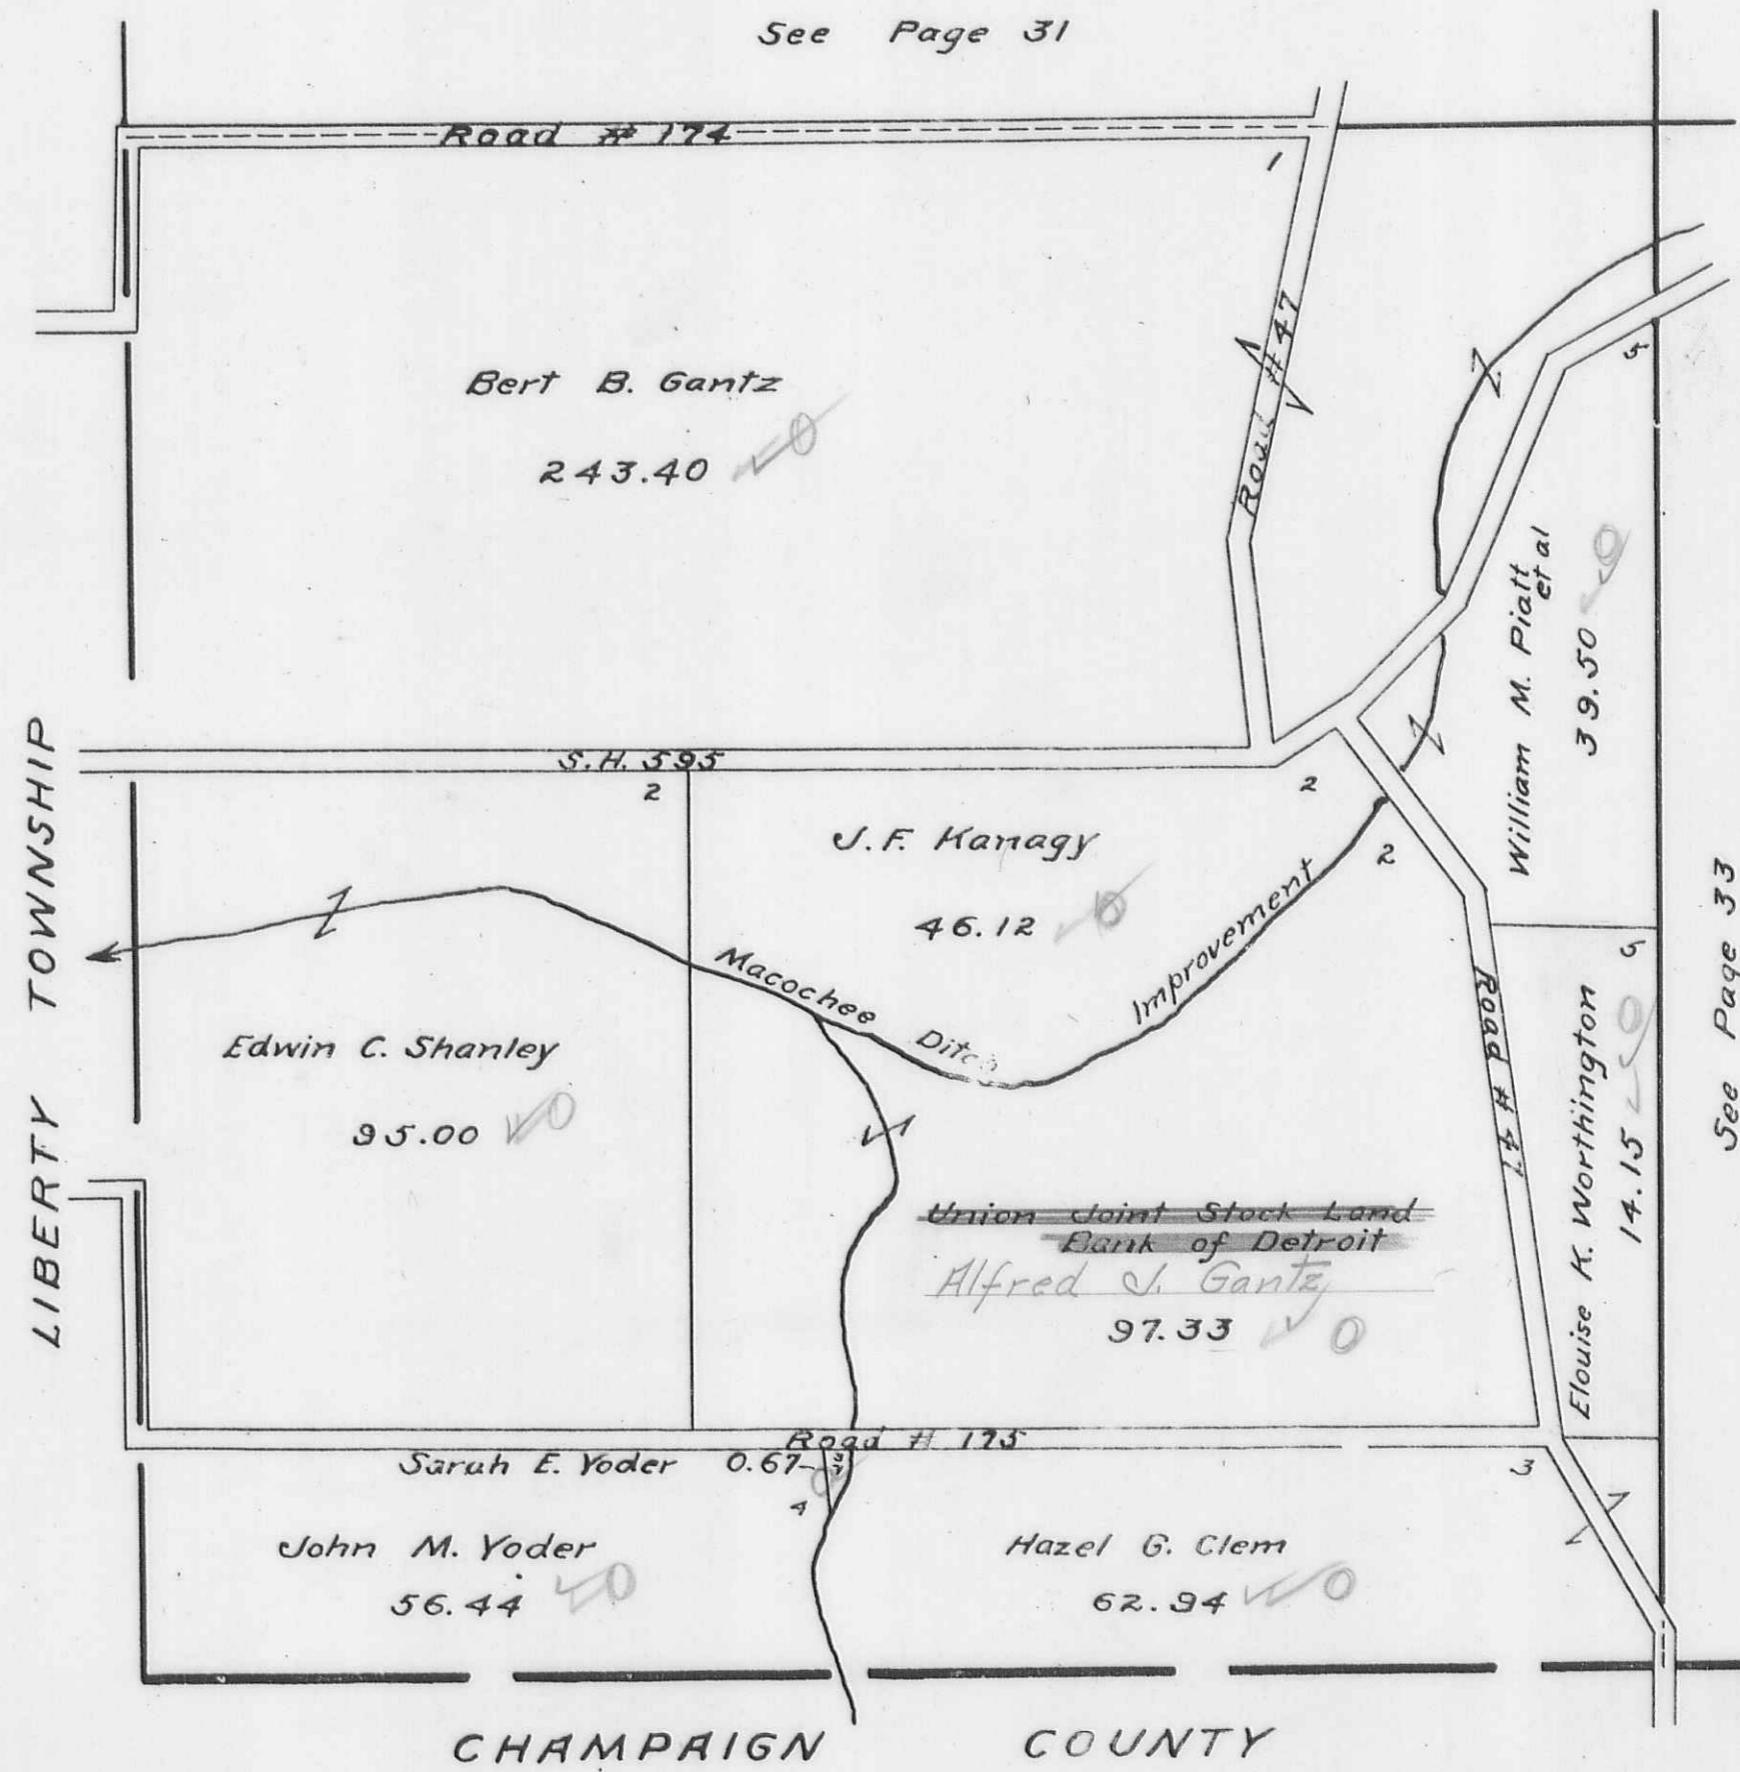

MONROE TOWNSHIP
SECTION 15 TOWN 5 RANGE 13

PAGE 33

SCALE 10 CHAINS TO THE INCH

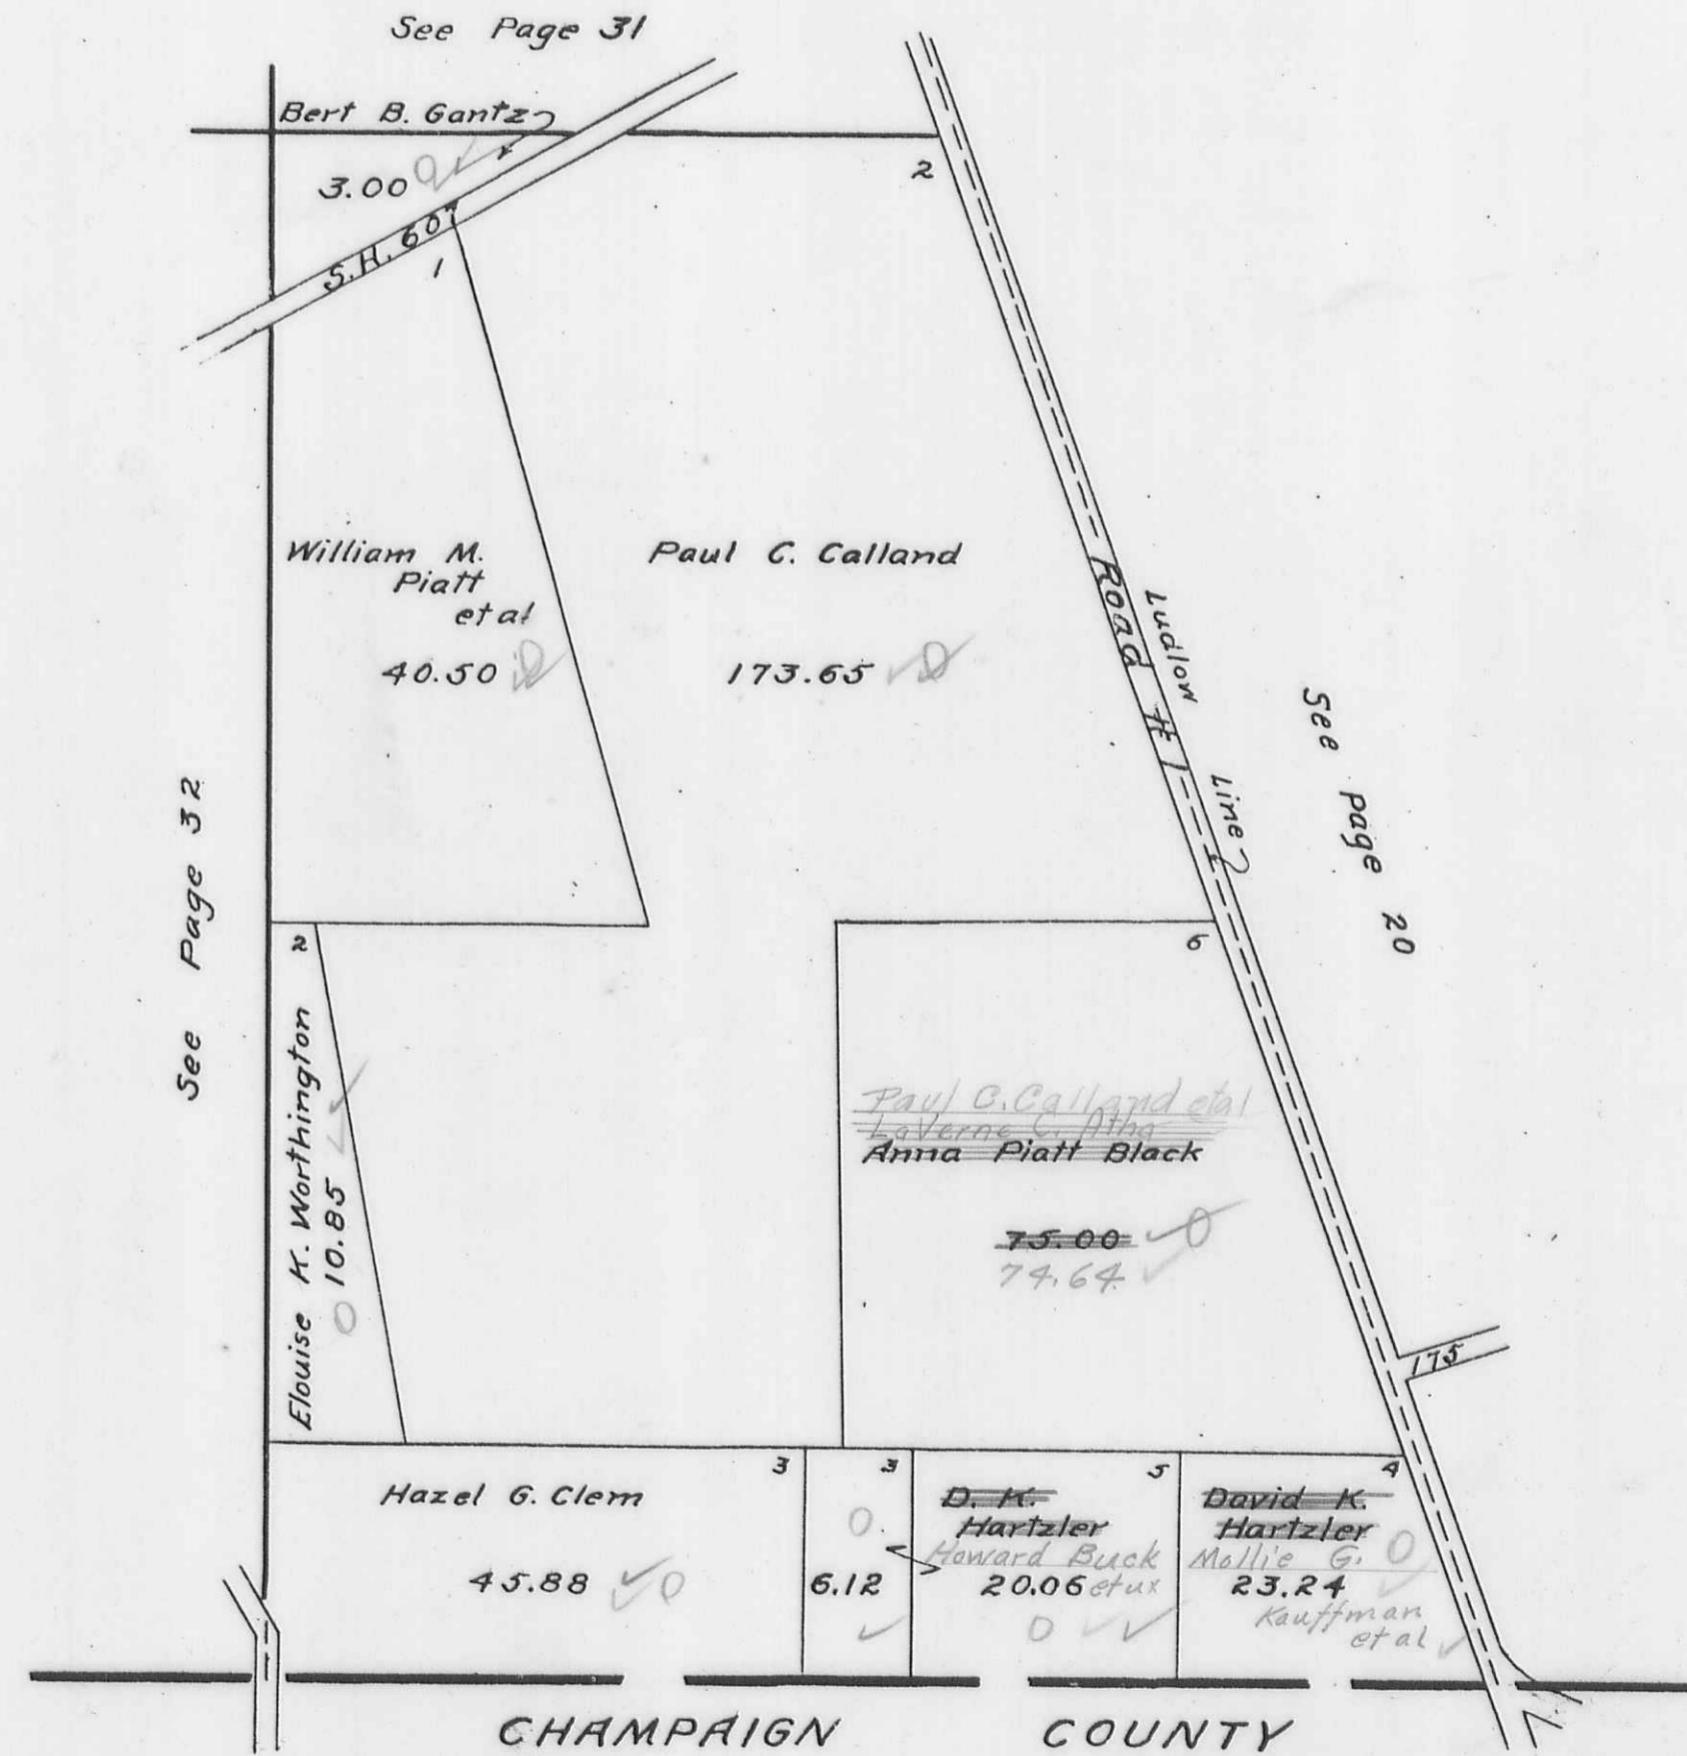

MONROE TOWNSHIP
PICKRELLTOWN

PAGE 34

SCALE 100 FEET TO THE INCH

3221

