

R

**P E R R Y  
T O W N S H I P**

**1 9 4 2**

## PERRY

## TOWNSHIP

PAGE A

## INDEX

VIRGINIA  
MILITARY  
SURVEYS

PAGE

842	1
5288	1
5209	2
{ 775	3
6155	3
13068	3
3436	4
5089	4
4210	5
5092 N. PART	6
5092 S. PART	7
4995	7
5091	8
13432	9
13529	9
14894	9
{ 12103	10
13528	10
13557	10
13558	10
4813	11
4815	11
5088	12
9198	12
9370	12
9372	12
5875	13
5883	13
7288	13

VIRGINIA  
MILITARY  
SURVEYS

PAGE

3159	14
3161	14
3753	14
4661	14
4676	14
4682	14
{ 9371	14
12174	14
9676	14
4655	15
3164	16
4689	17
4810	18
6232	19
3154	20
4811	21
5275	22
12283	23
14755	23
545	24
{ 12399	24
12404	24
12395	24
12427	24
12428	24

PAGE

WEST MANSFIELD CORPORATION	25
EAST LIBERTY NORTH EAST PART	26
EAST LIBERTY NORTH WEST PART	27
EAST LIBERTY SOUTH PART	28
GREENFIELD LOTS	29

PERRY  
INDEX

TOWNSHIP  
MAP

PAGE

0


UNION COUNTY

BOKE SCREEK TOWNSHIP

RUSHCREEK  
TOWNSHIP

JEFFERSON TOWNSHIP

ZANE TOWNSHIP

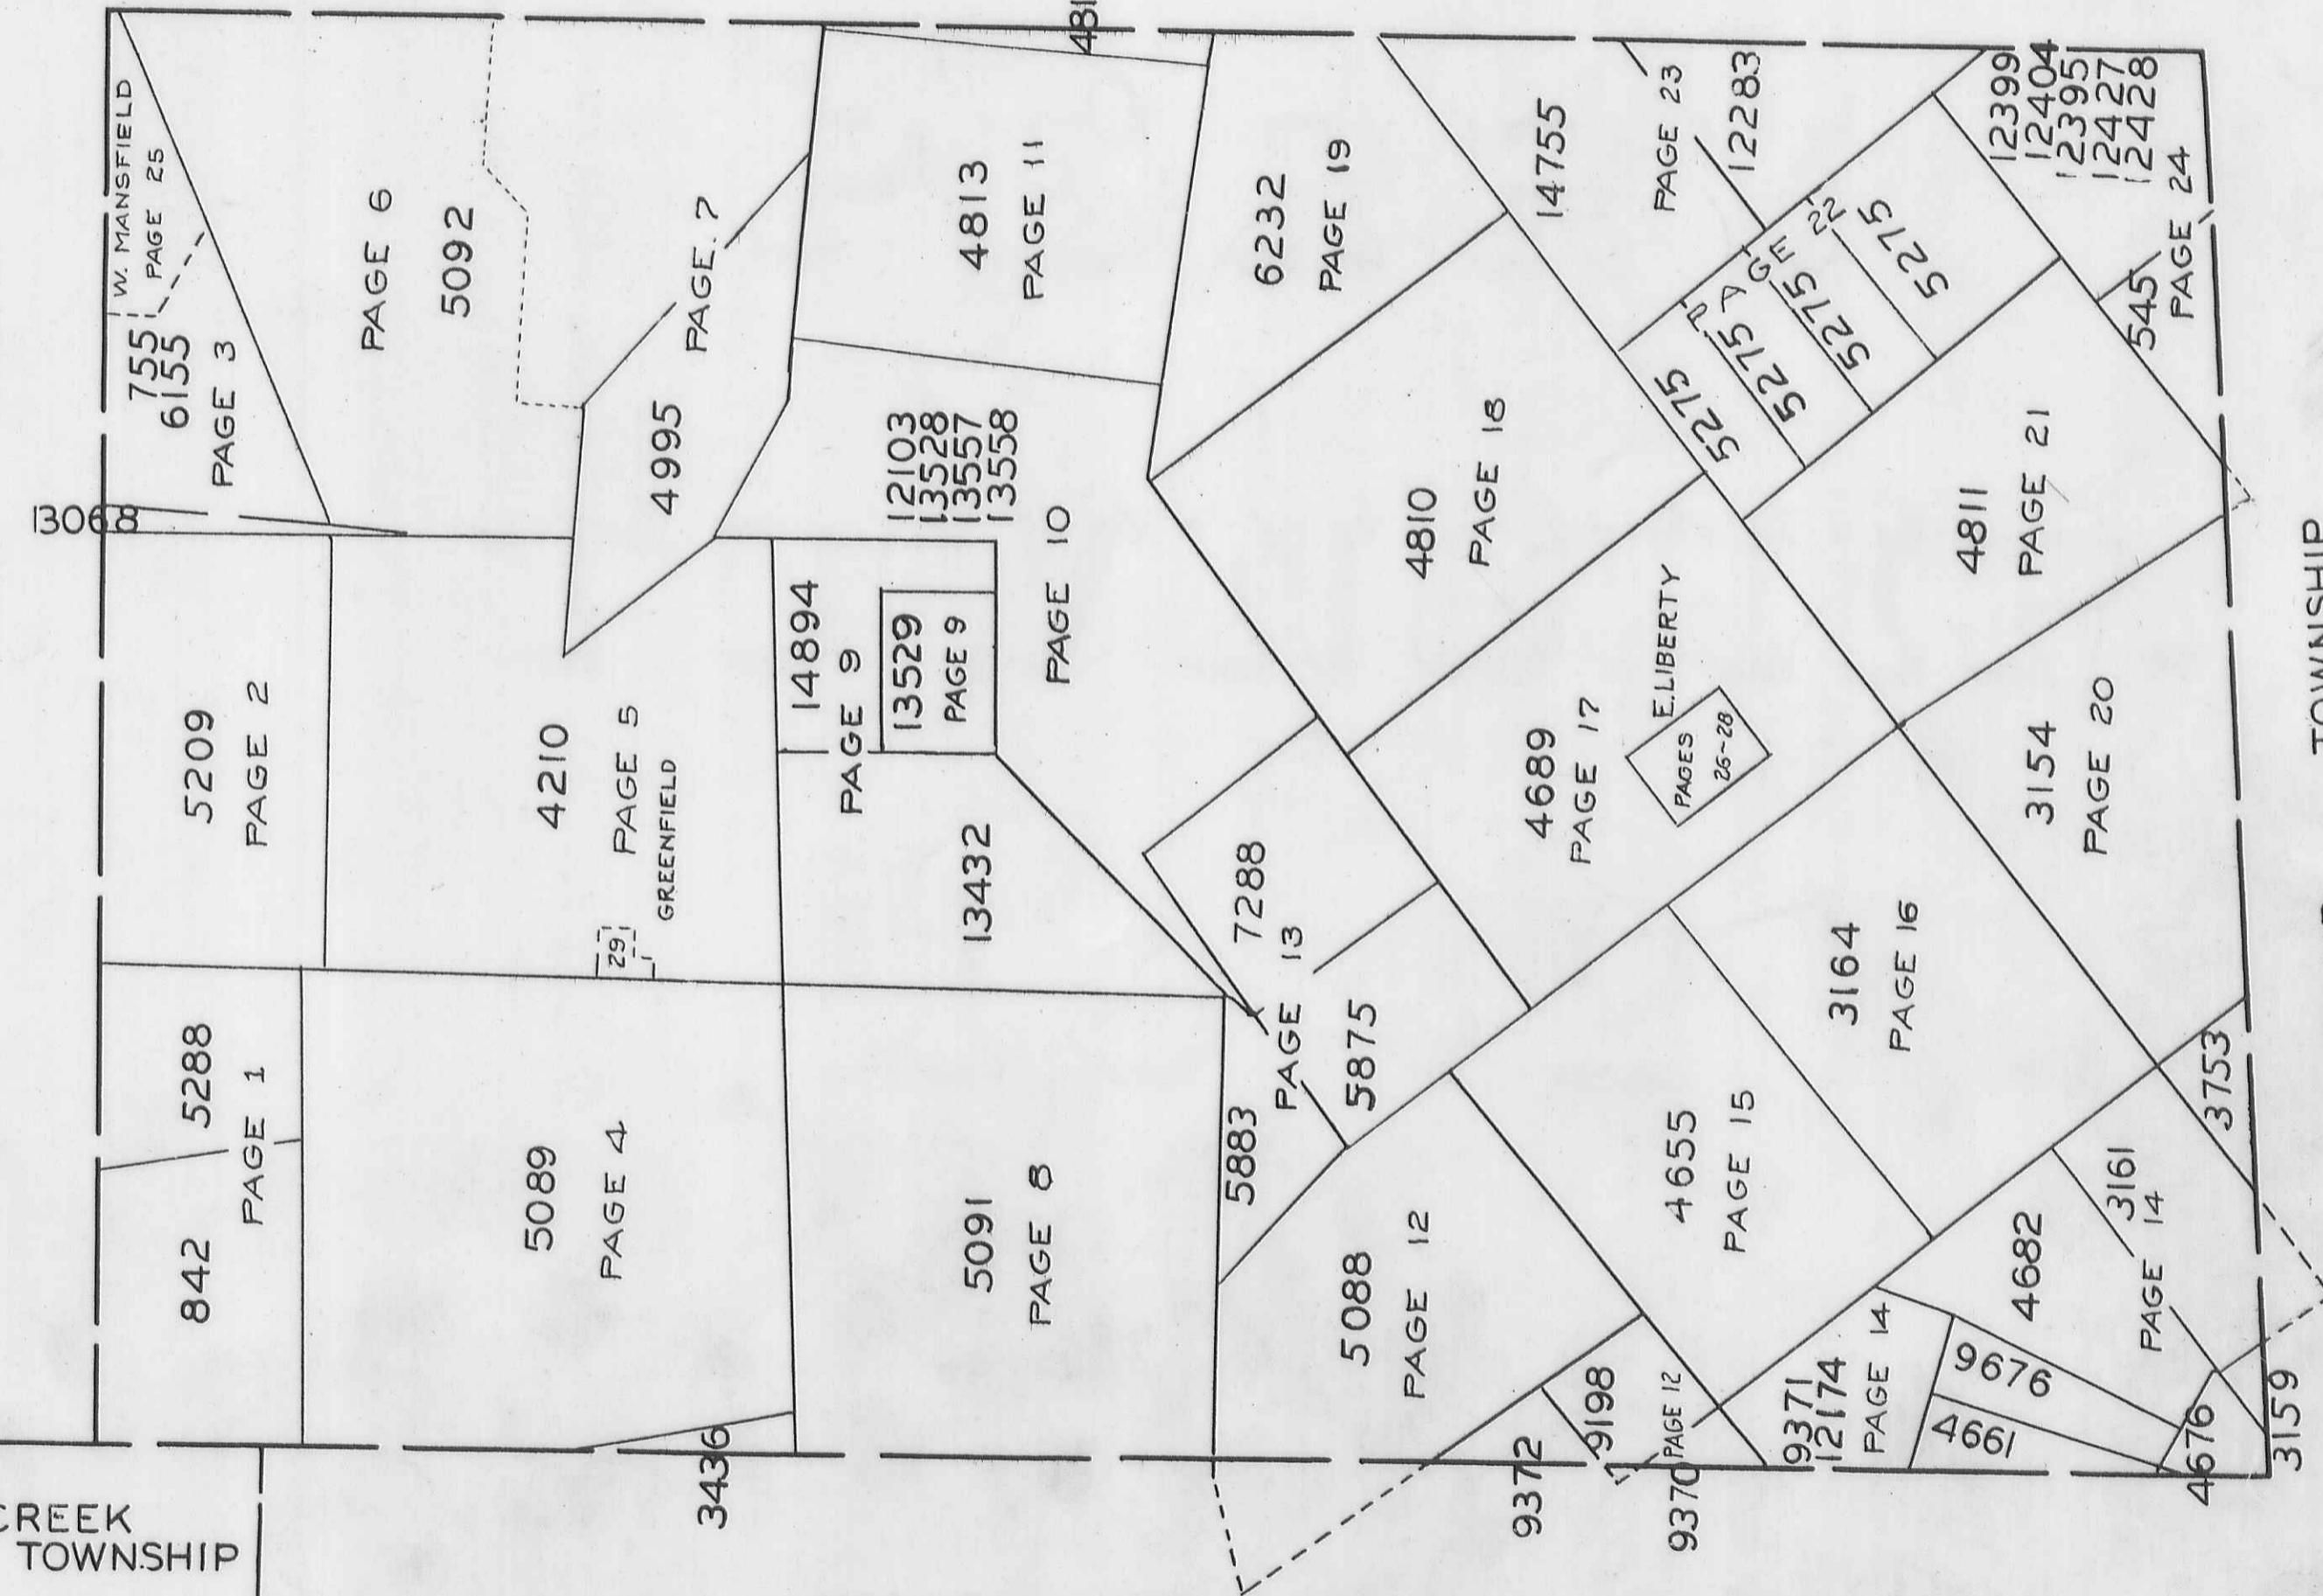


PERRY TOWNSHIP  
VIRGINIA MILITARY SURVEYS 842  
5288

SCALE 10 CHAINS TO THE INCH

PAGE 1

BOKESCREEN TOWNSHIP

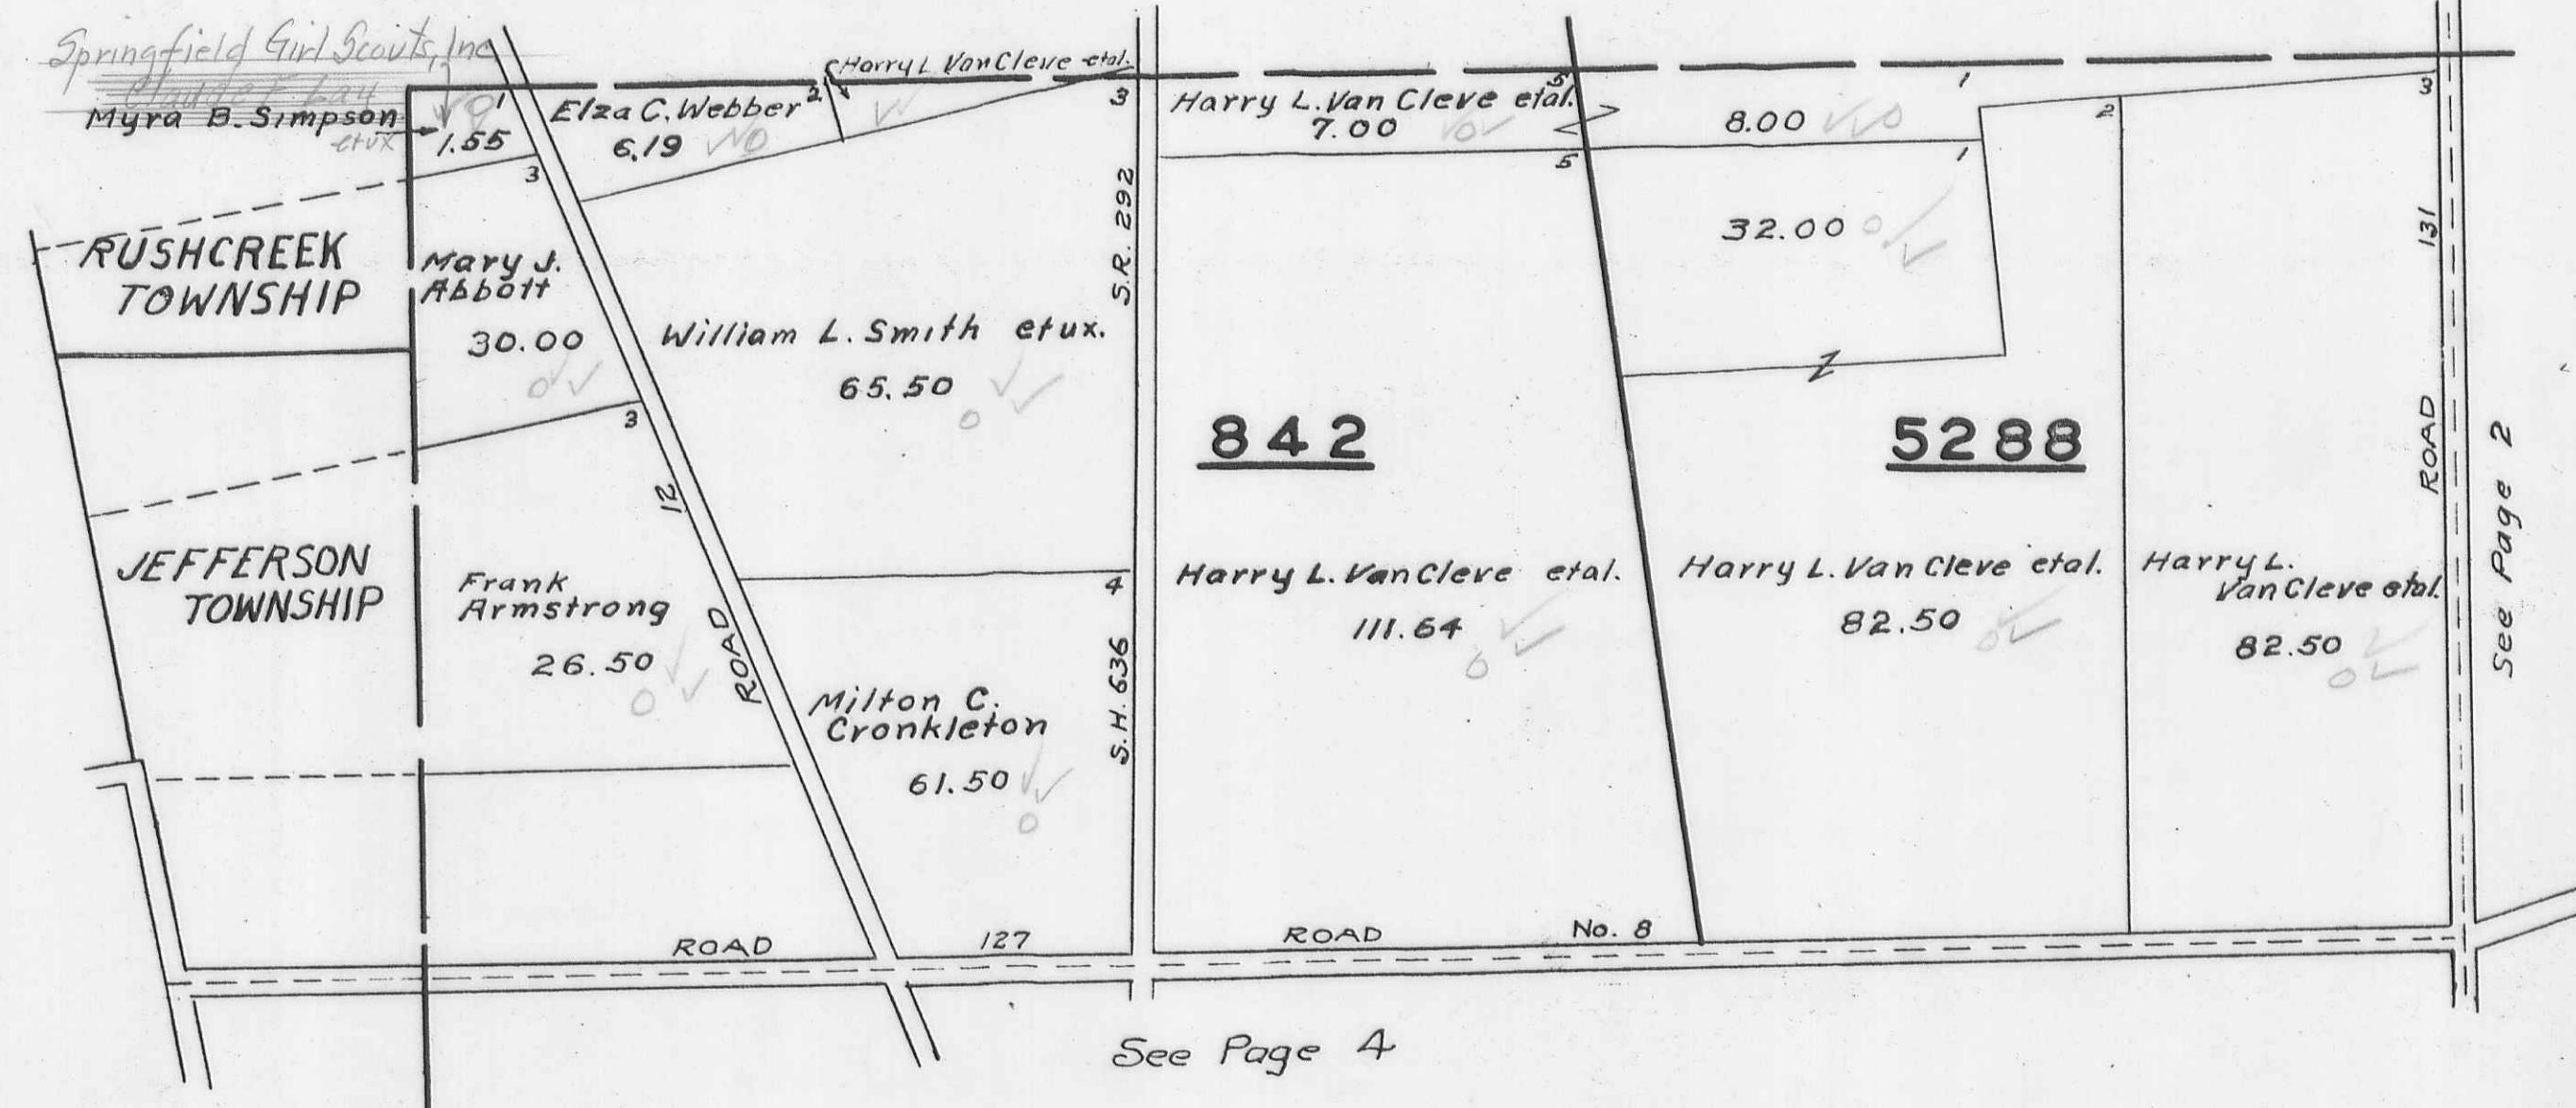


VIRGINIA

MILITARY SURVEY 5209

SCALE 10 CHAINS TO THE INCH

## BOKESCREEK TOWNSHIP

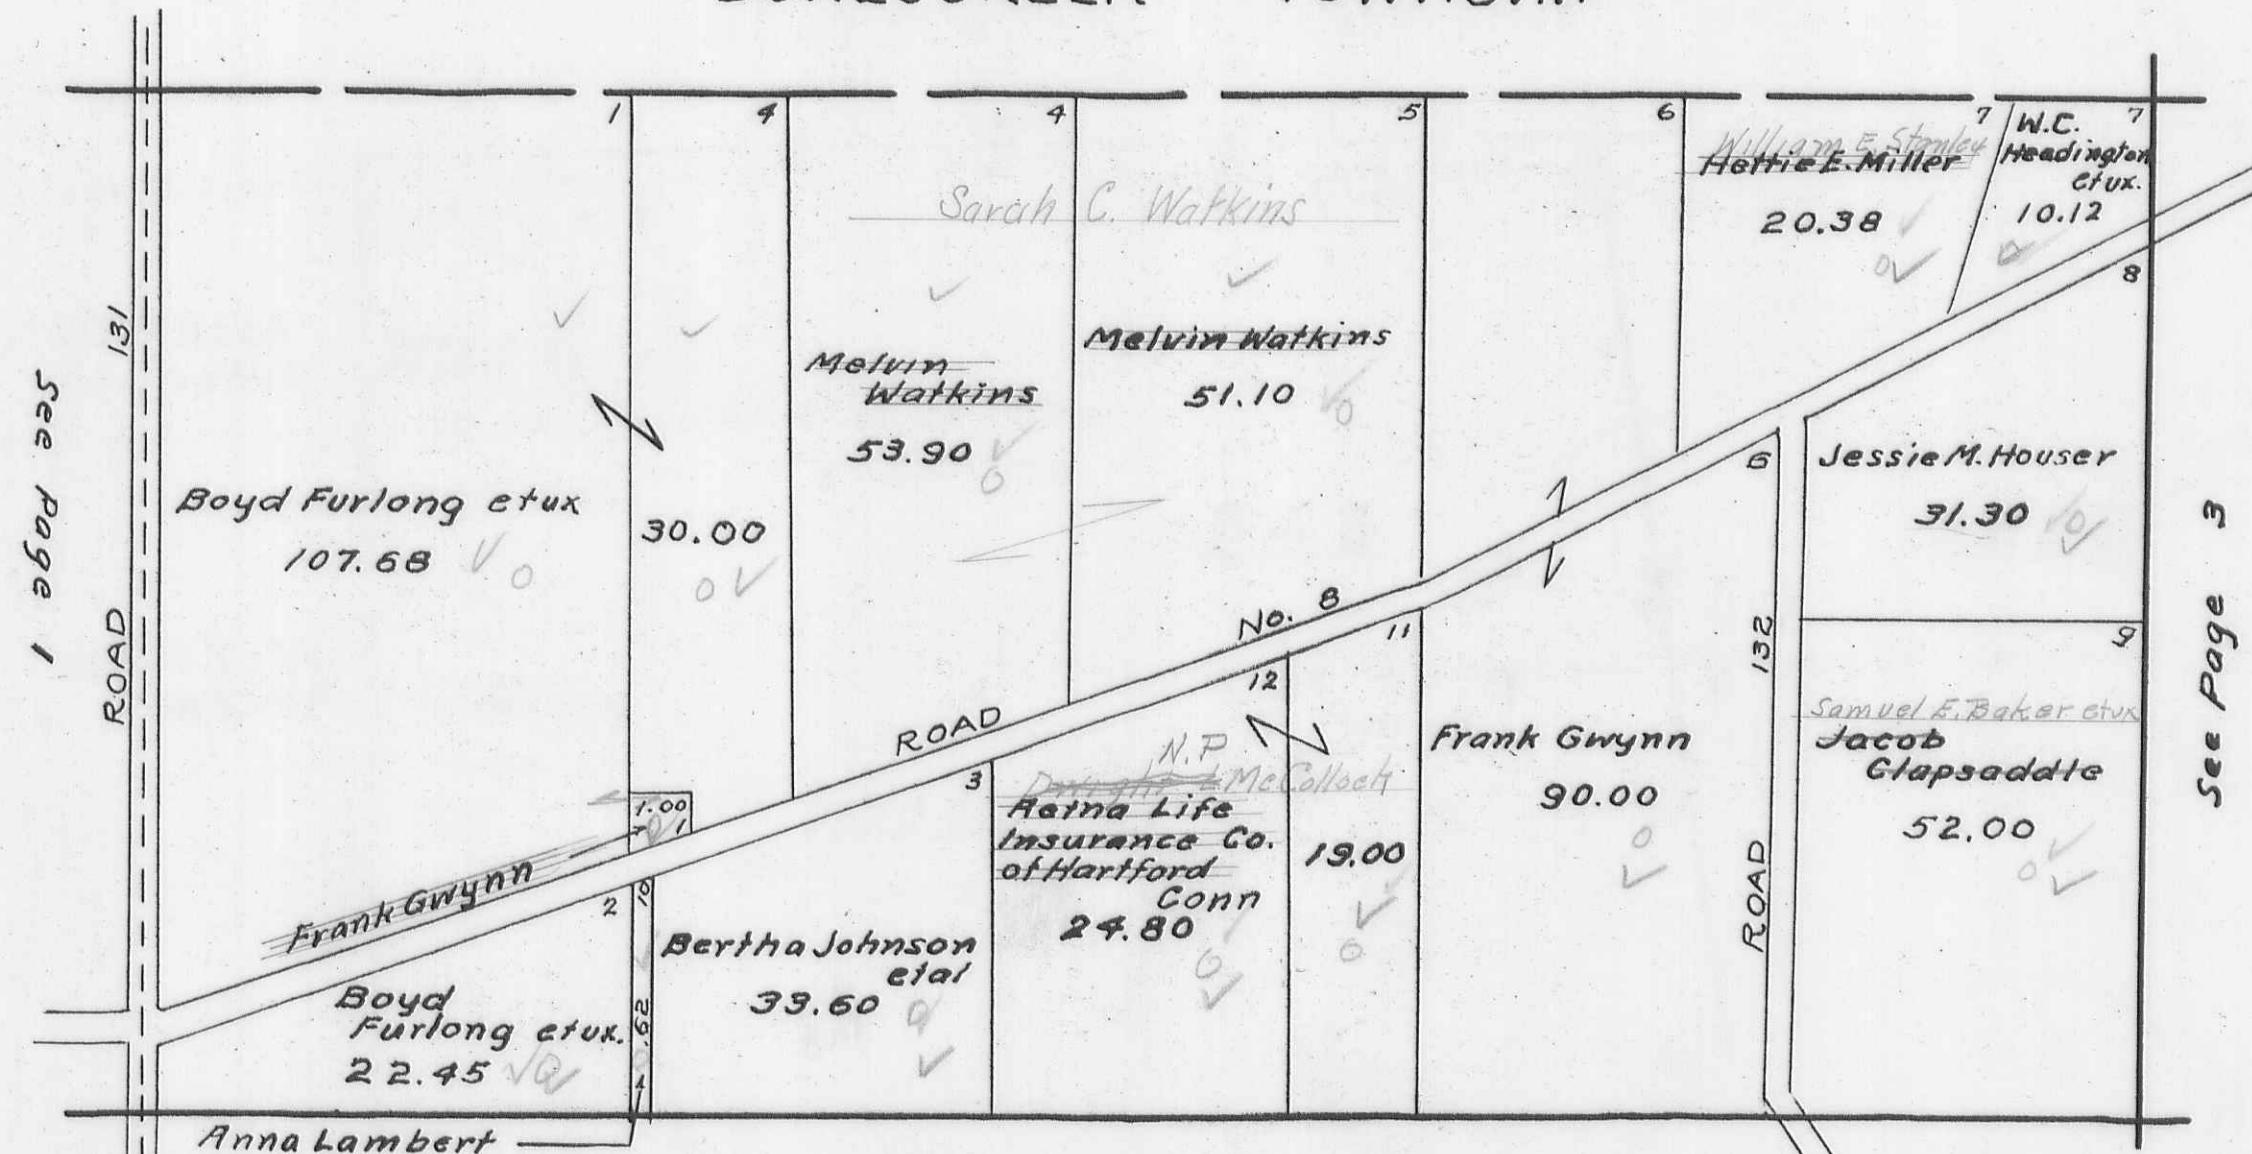

See Page 5

See Page 3


PERRY TOWNSHIP  
VIRGINIA MILITARY SURVEYS  
SCALE 10 CHAINS TO THE INCH

{ 775  
6155  
13068

PAGE

3

BOKESCREEK TOWNSHIP

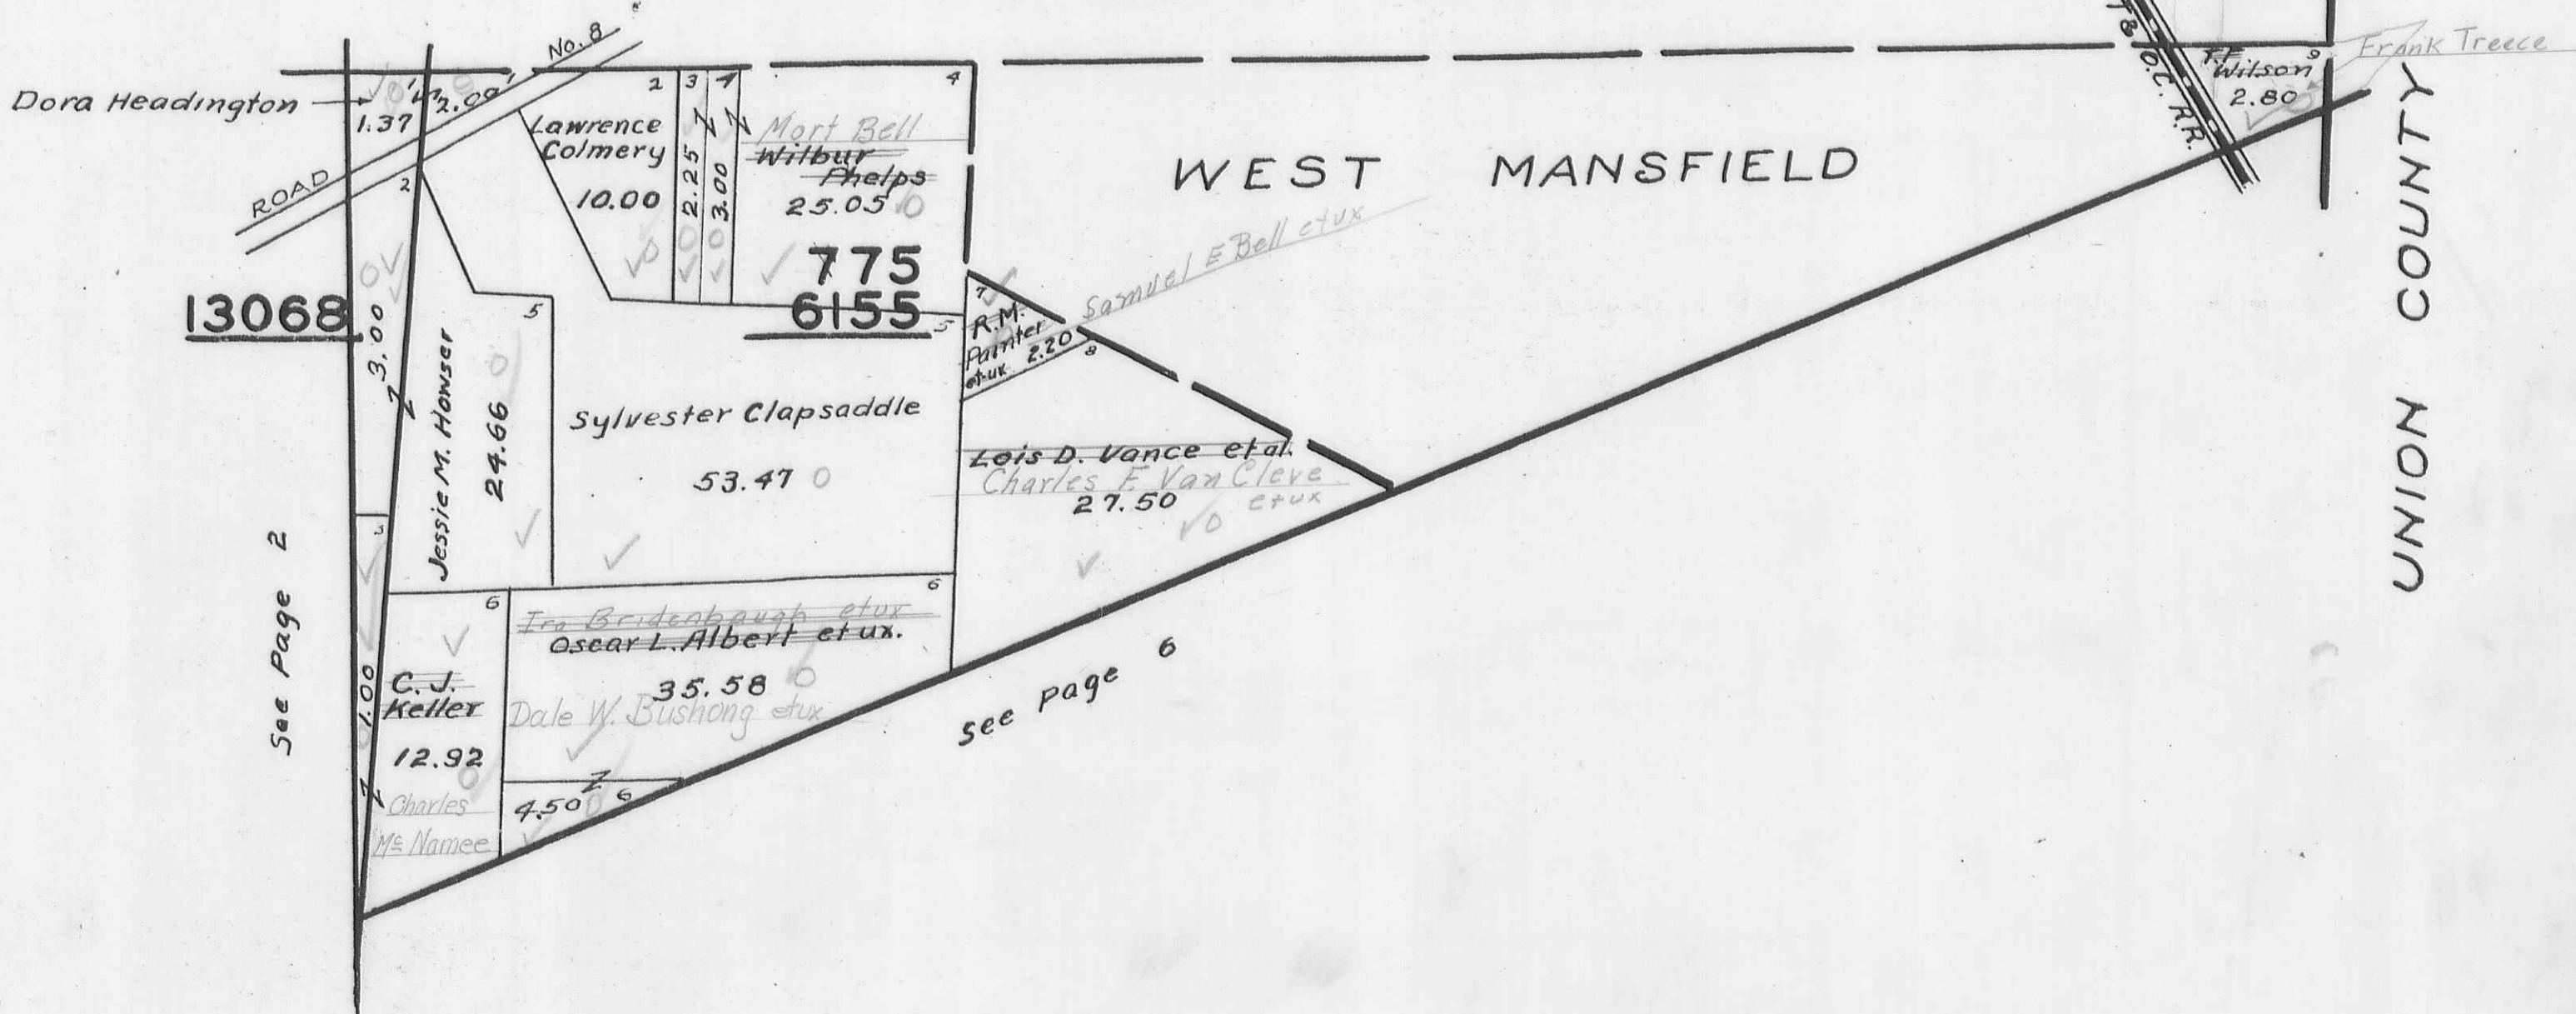

PERRY

TOWNSHIP

VIRGINIA

MILITARY SURVEYS

3436  
5089


PAGE

4

see Page 1  
ROAD 127

SCALE 10 CHAINS TO THE INCH

ROAD NO. 8

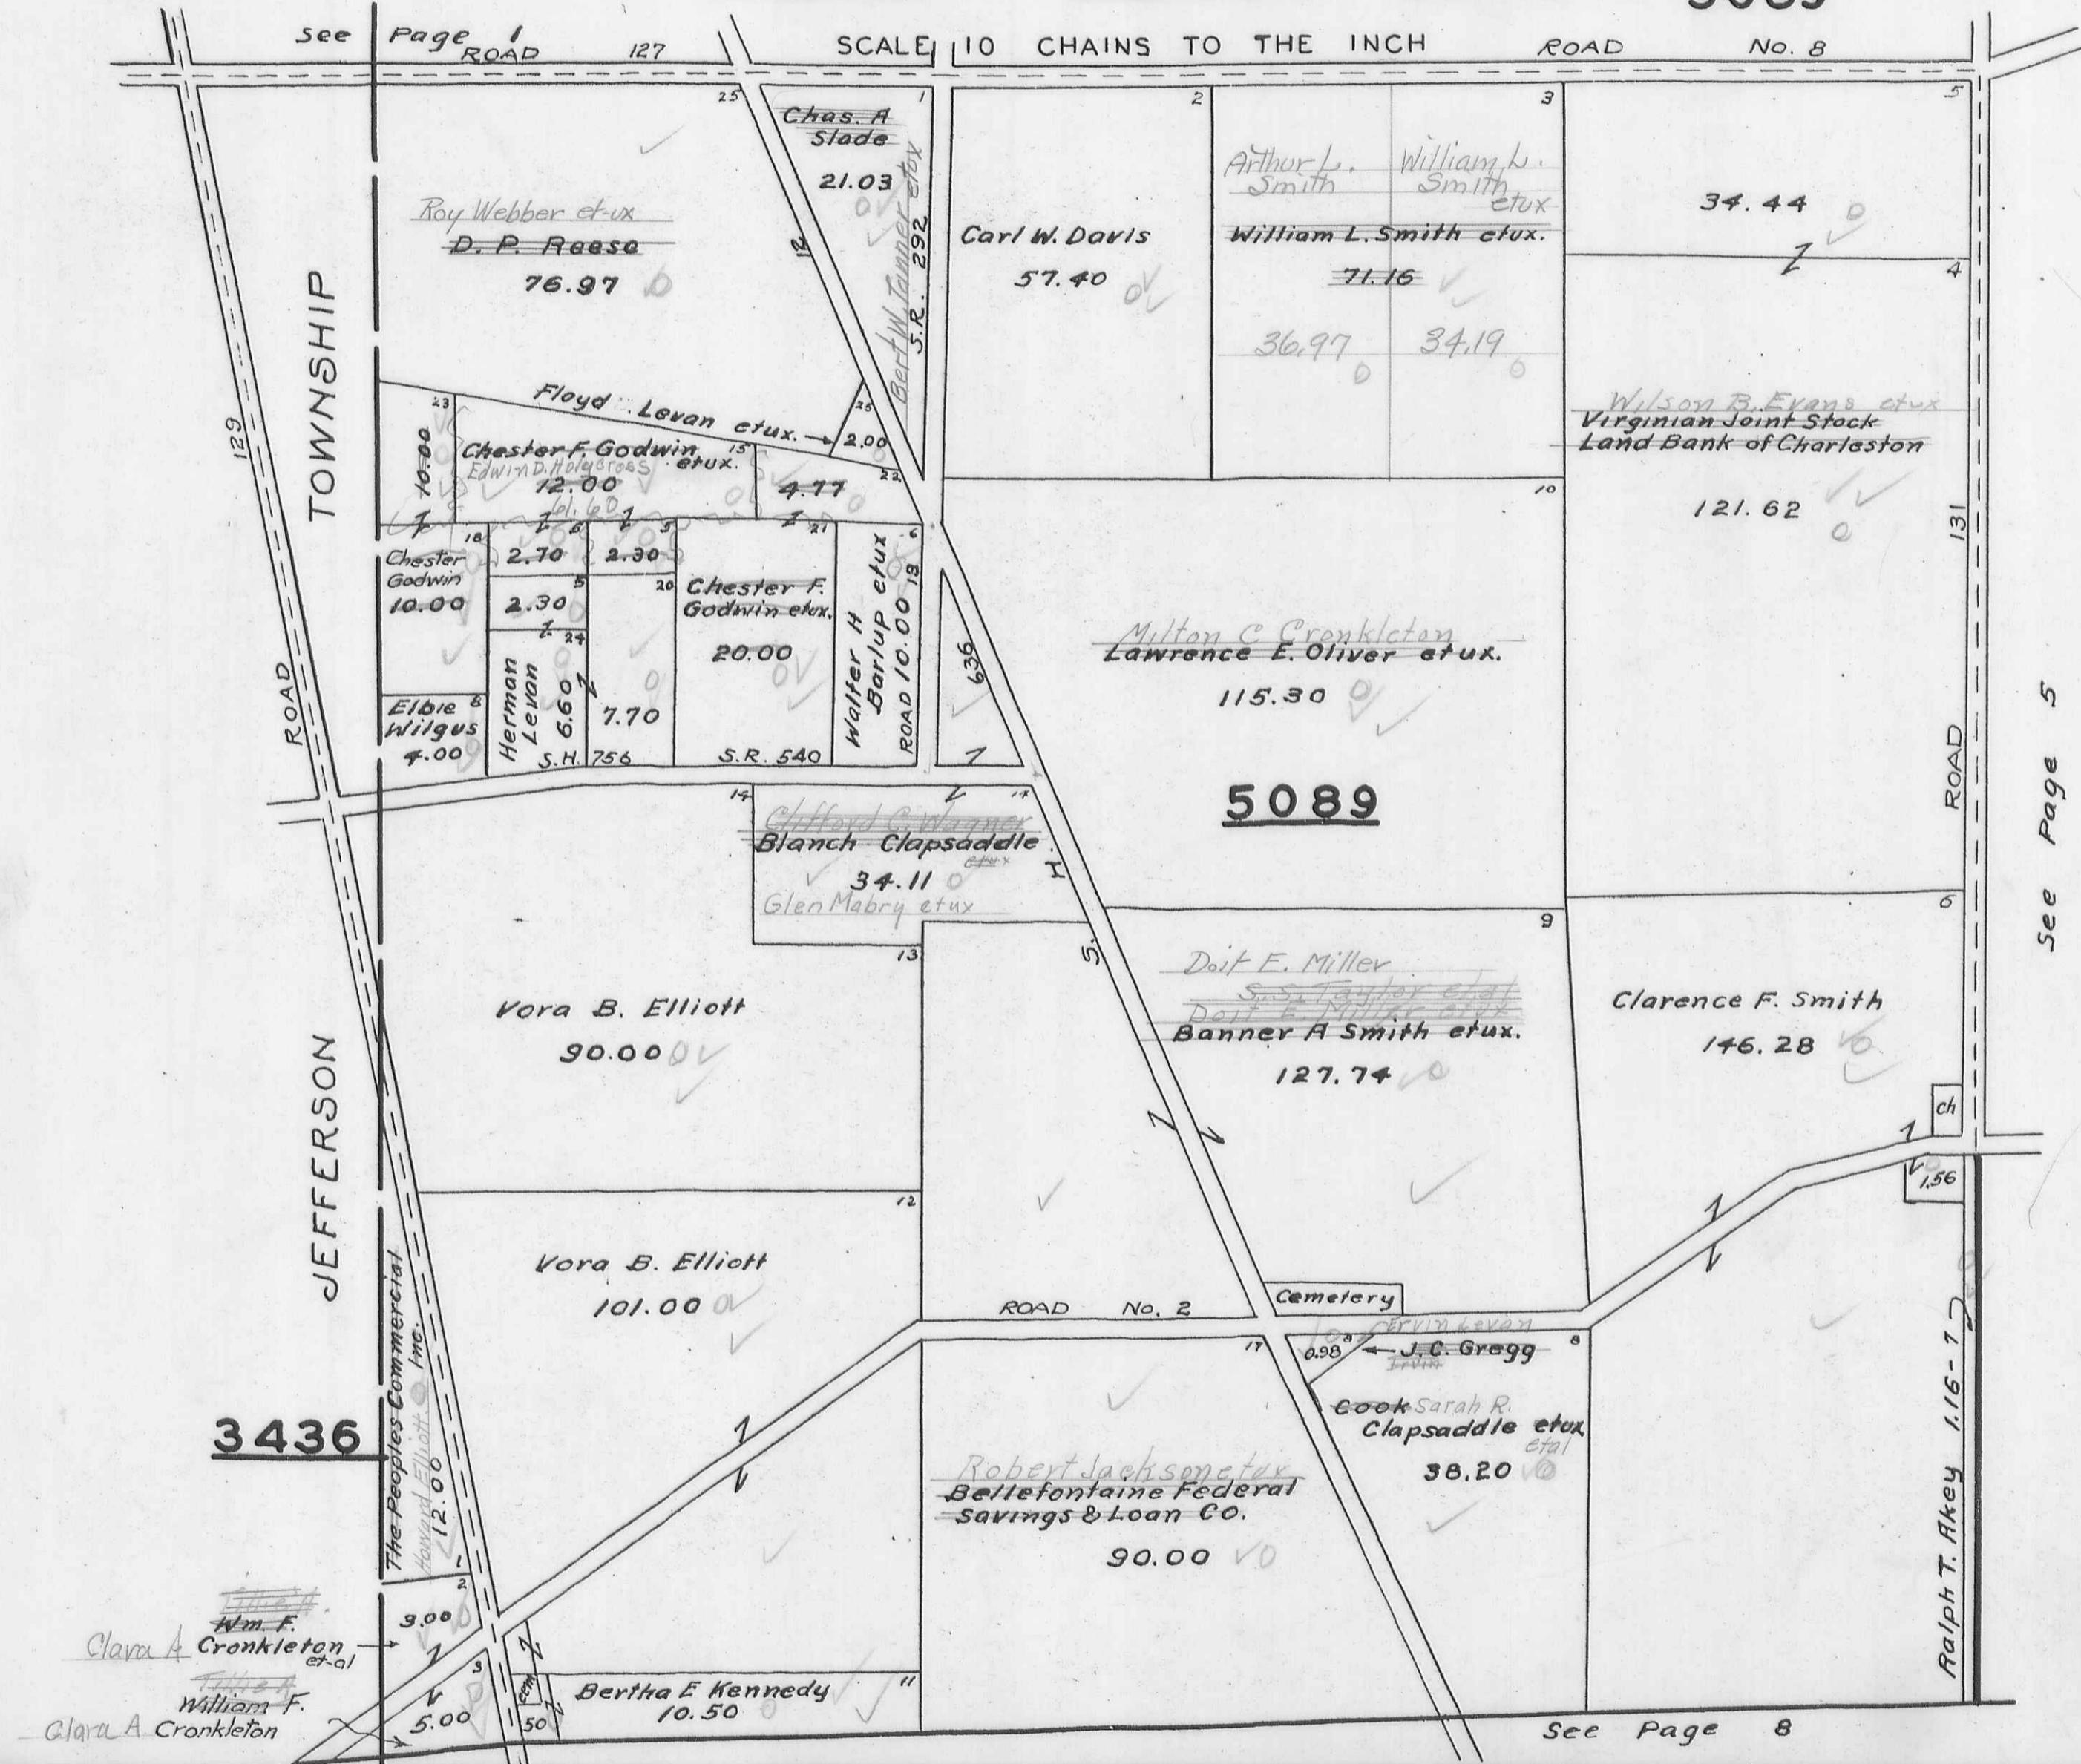

PERRY

TOWNSHIP


PAGE

5

VIRGINIA MILITARY SURVEYS 4210  
4995

SCALE 10 CHAINS TO THE INCH

See Page 2

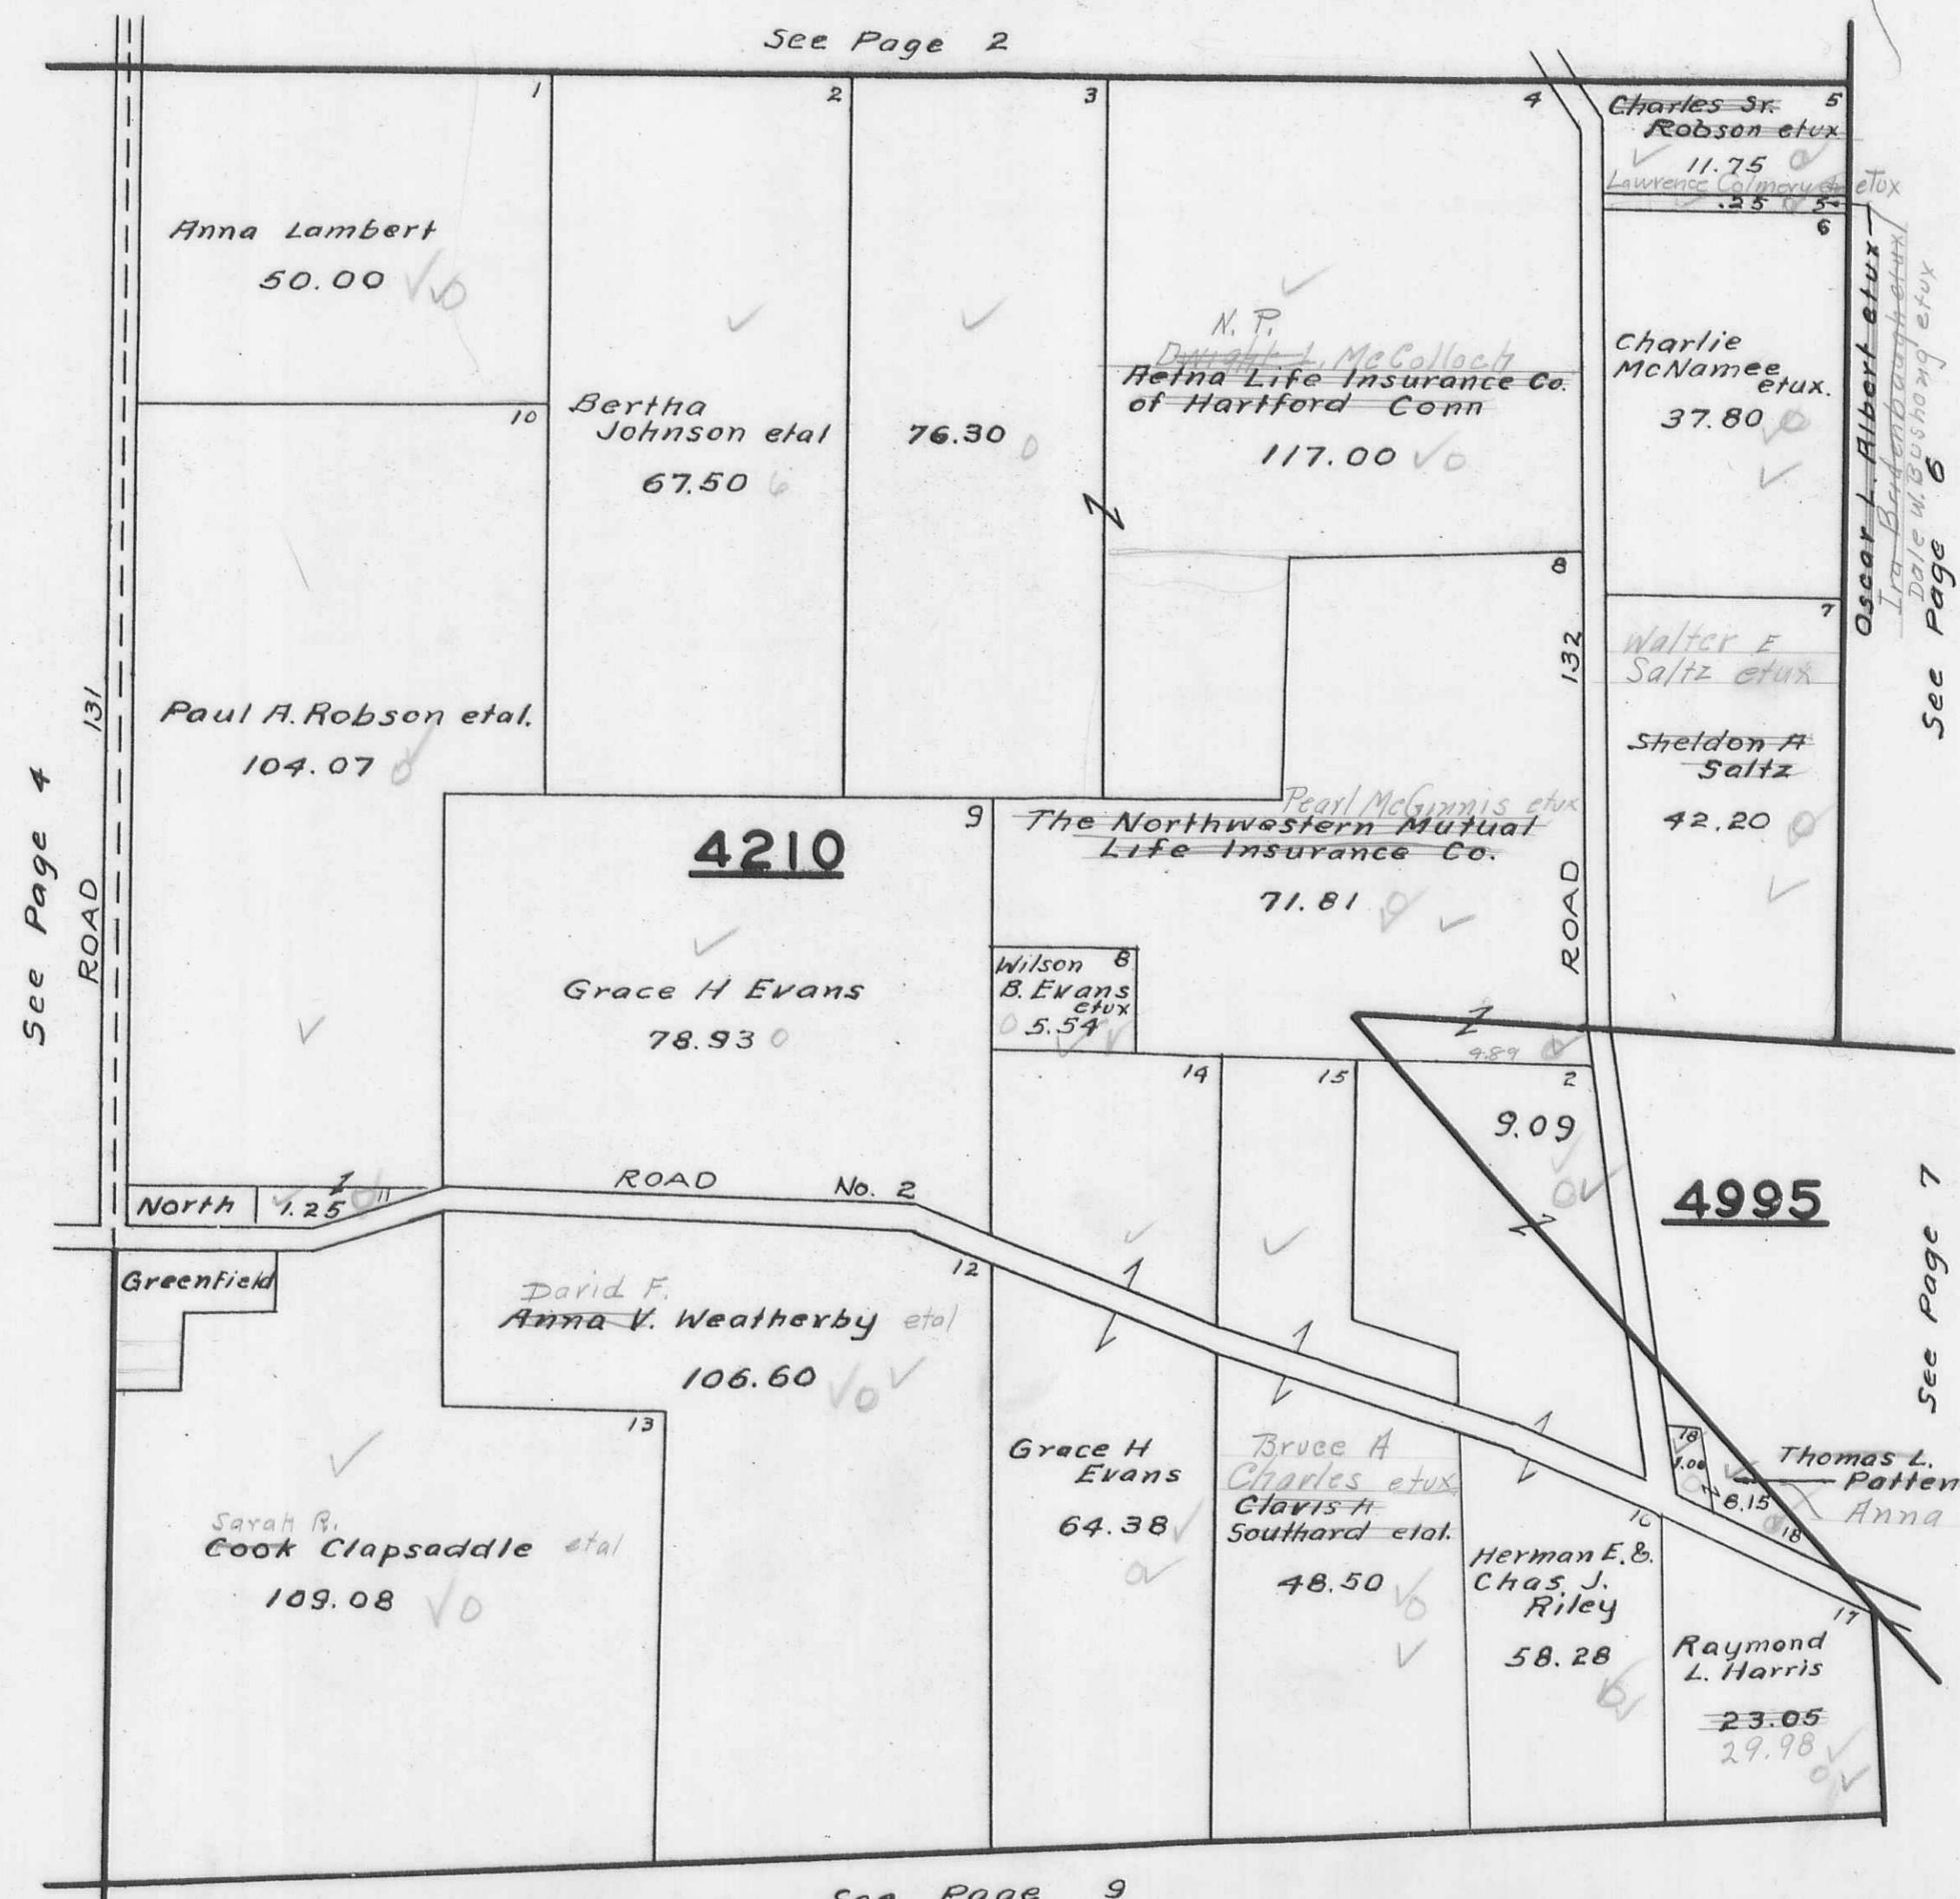


PERRY

## TOWNSHIP

PAGE 6

VIRGINIA MILITARY SURVEY N.PART 5092

SCALE 10 CHAINS TO THE INCH

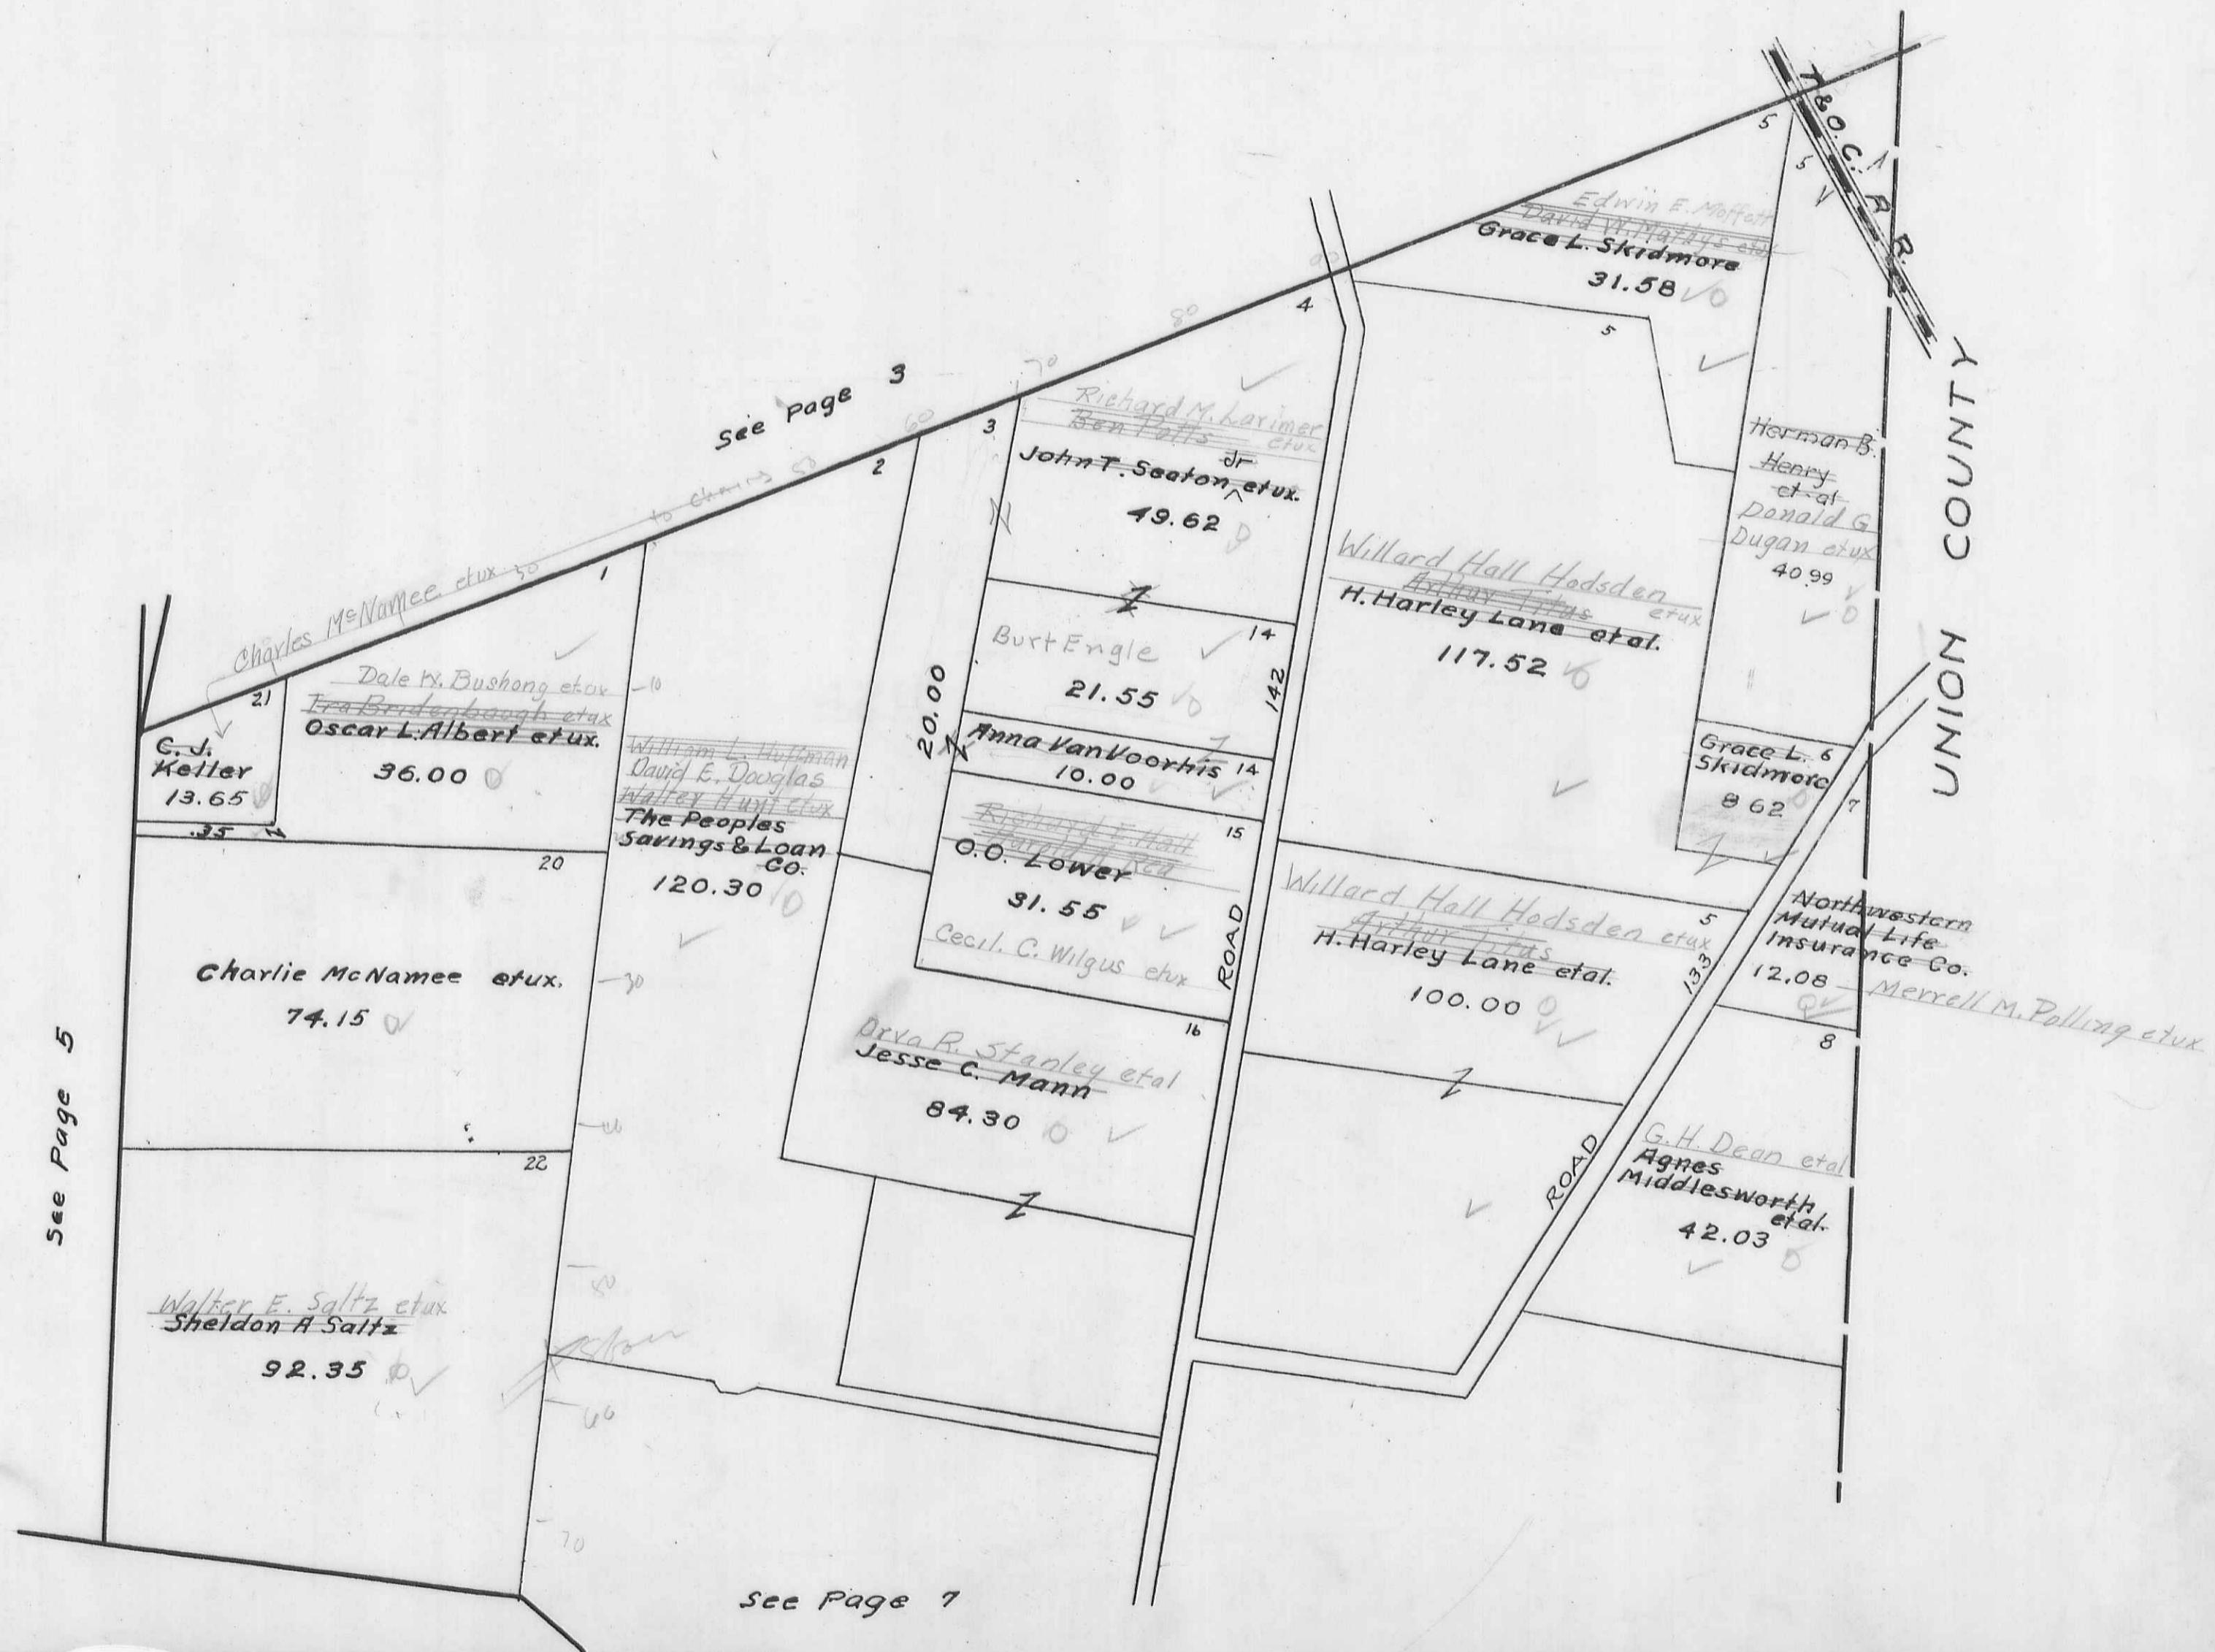

PERRY TOWNSHIP PAGE 7  
VIRGINIA MILITARY SURVEYS 4995  
S.PART 5092  
SCALE 10 CHAINS TO THE INCH

SCALE 10 CHAINS TO THE INCH

**4995  
S.PART 5092**

PAGE

7

See Page 6

See Page 5

See Page 10

See Page 11

PERRY

## TOWNSHIP


PAGE E

8

VIRGINIA MILITARY SURVEY 5091

SCALE 10 CHAINS TO THE INCH

See Page 4

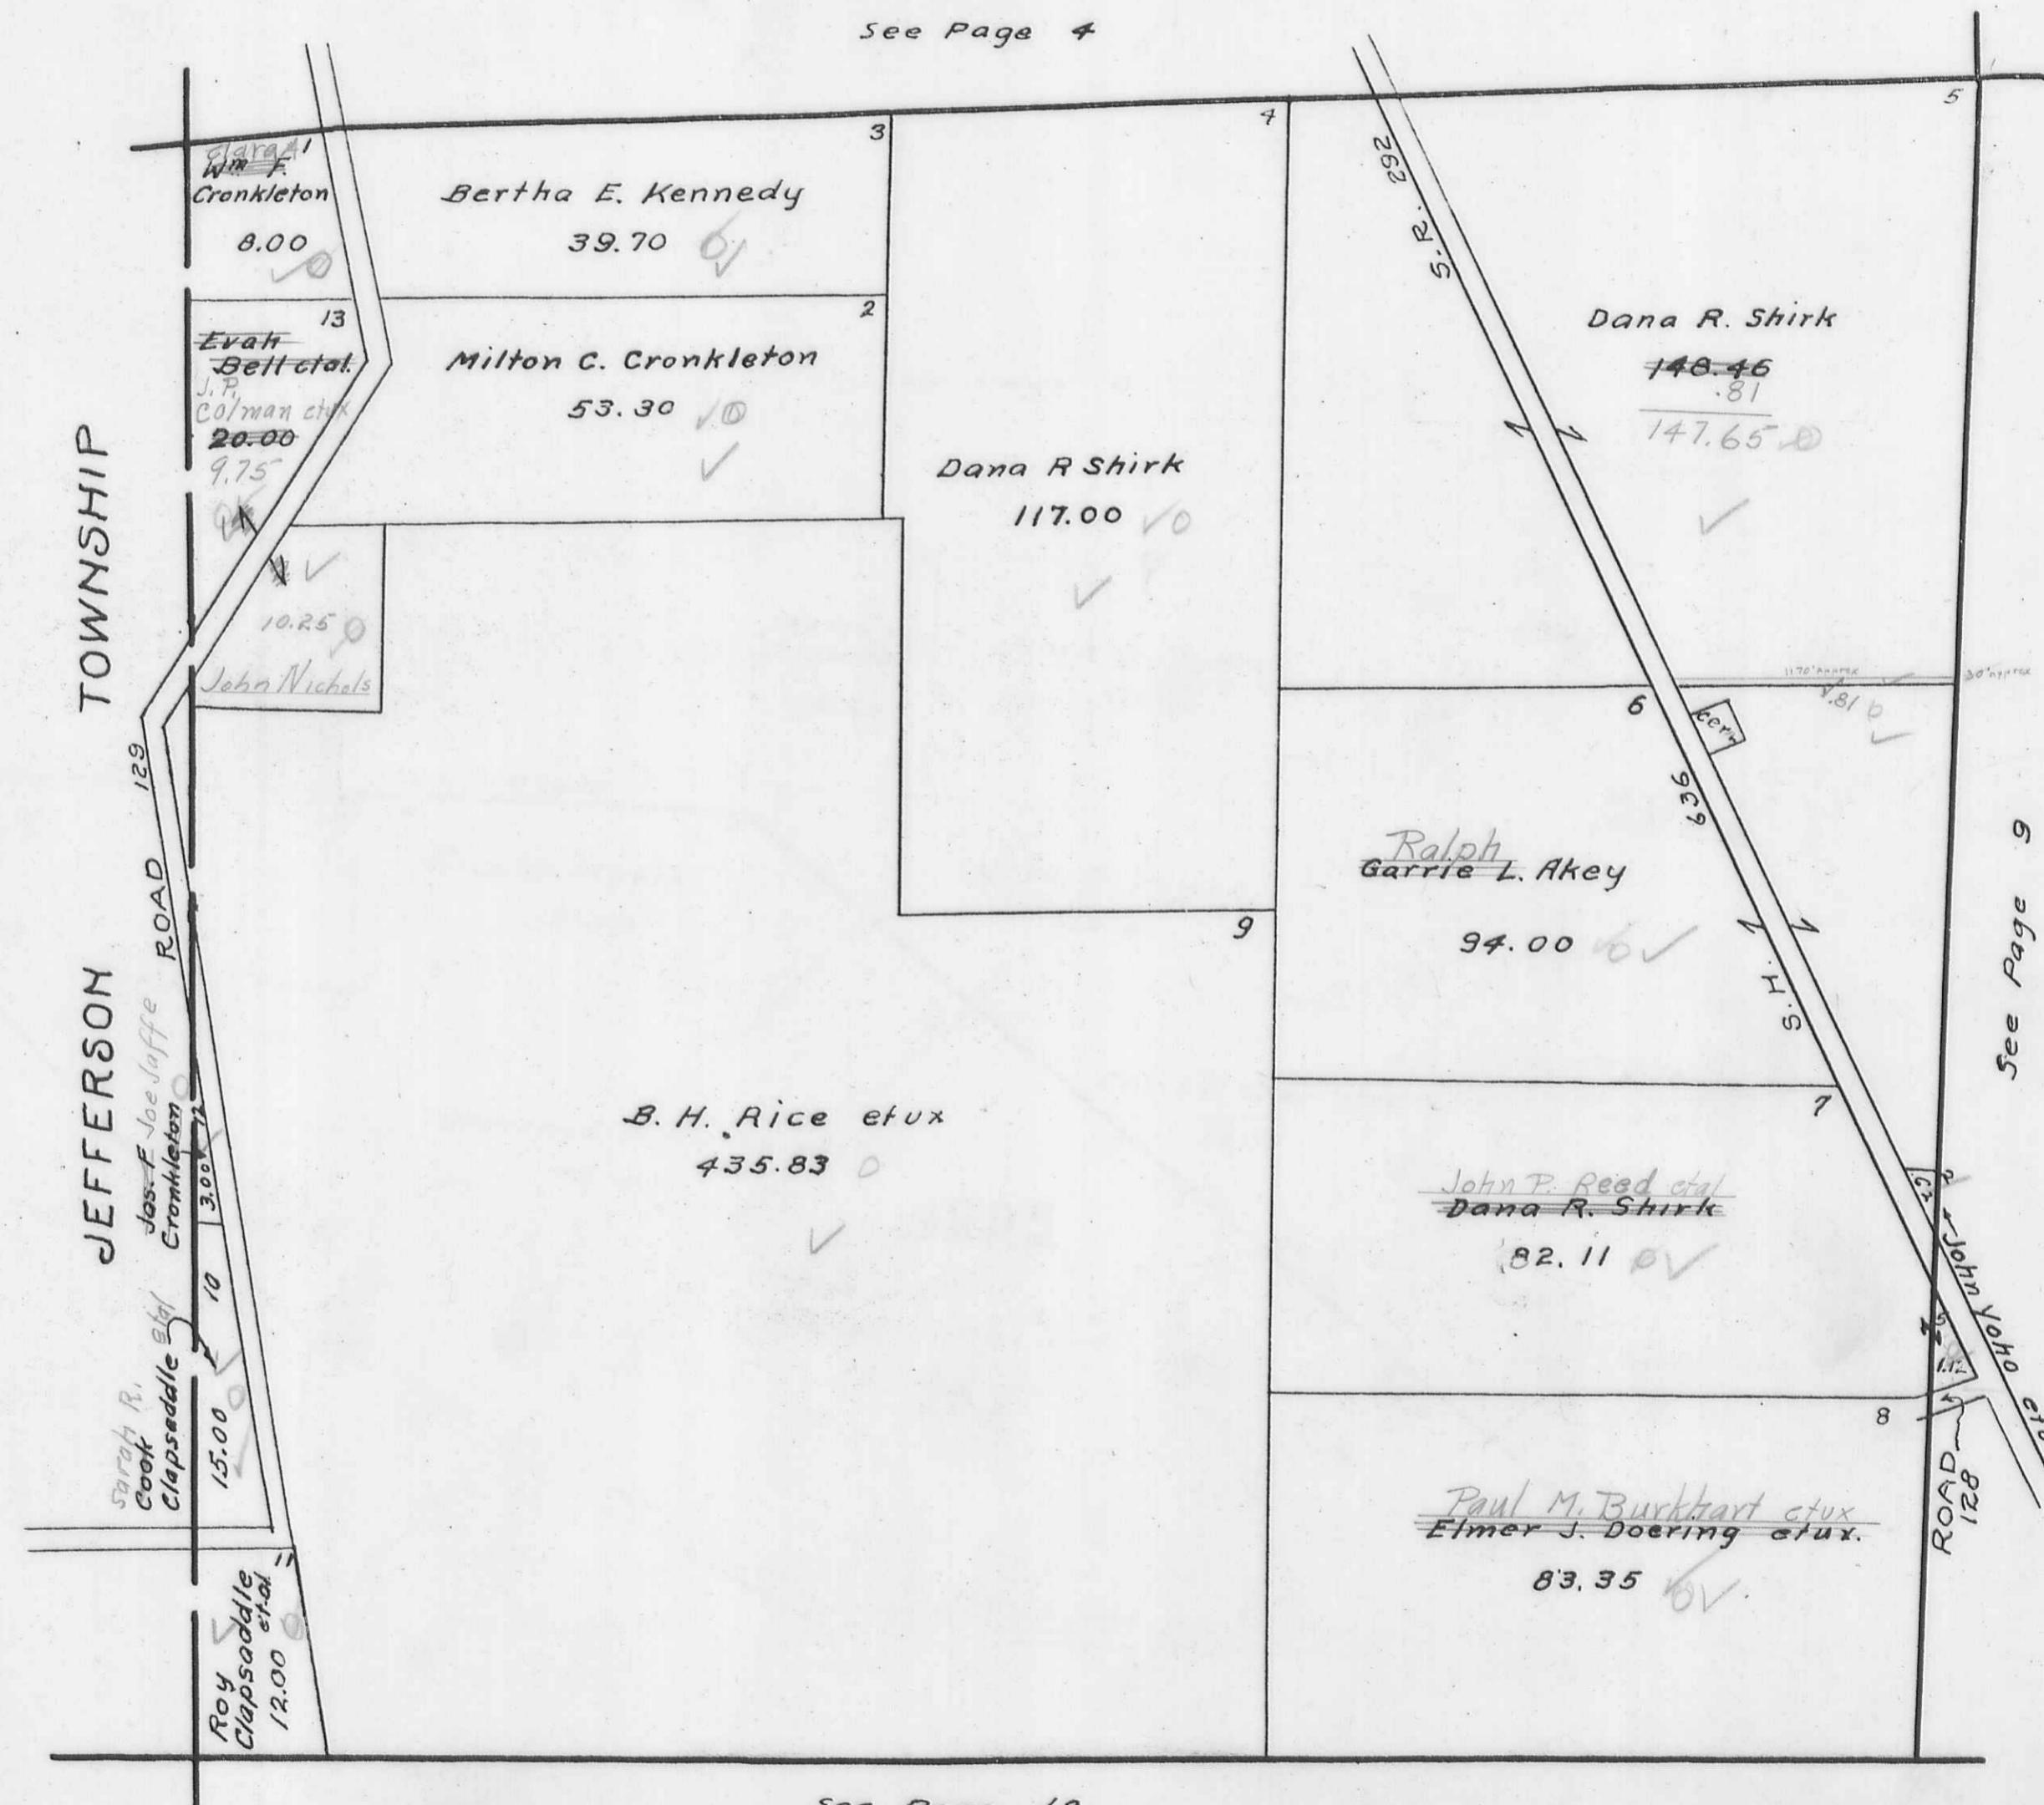

PERRY TOWNSHIP  
VIRGINIA MILITARY SURVEYS

SCALE 10 CHAINS TO THE INCH

13432  
13529  
14894

PAGE

9

See Page 5

Ralph T. Akey

102.17 ✓

13432

Ralph L. Akey

102.17 ✓

Herman E. & Charlie J. Riley

73.00 ✓

33.20 ✓

Raymond L. Harris

40.30

35.15 ✓

✓

14894

13529

John Yoho etux.

57.50 ✓

W. P. Haynes et al.

52.10 ✓

22.17 ✓


See Page 10

See Page 8

Dana R. Shirk  
John P. Read et al  
15.00 ✓

John Yoho etut.  
76.18 ✓

See Page 10

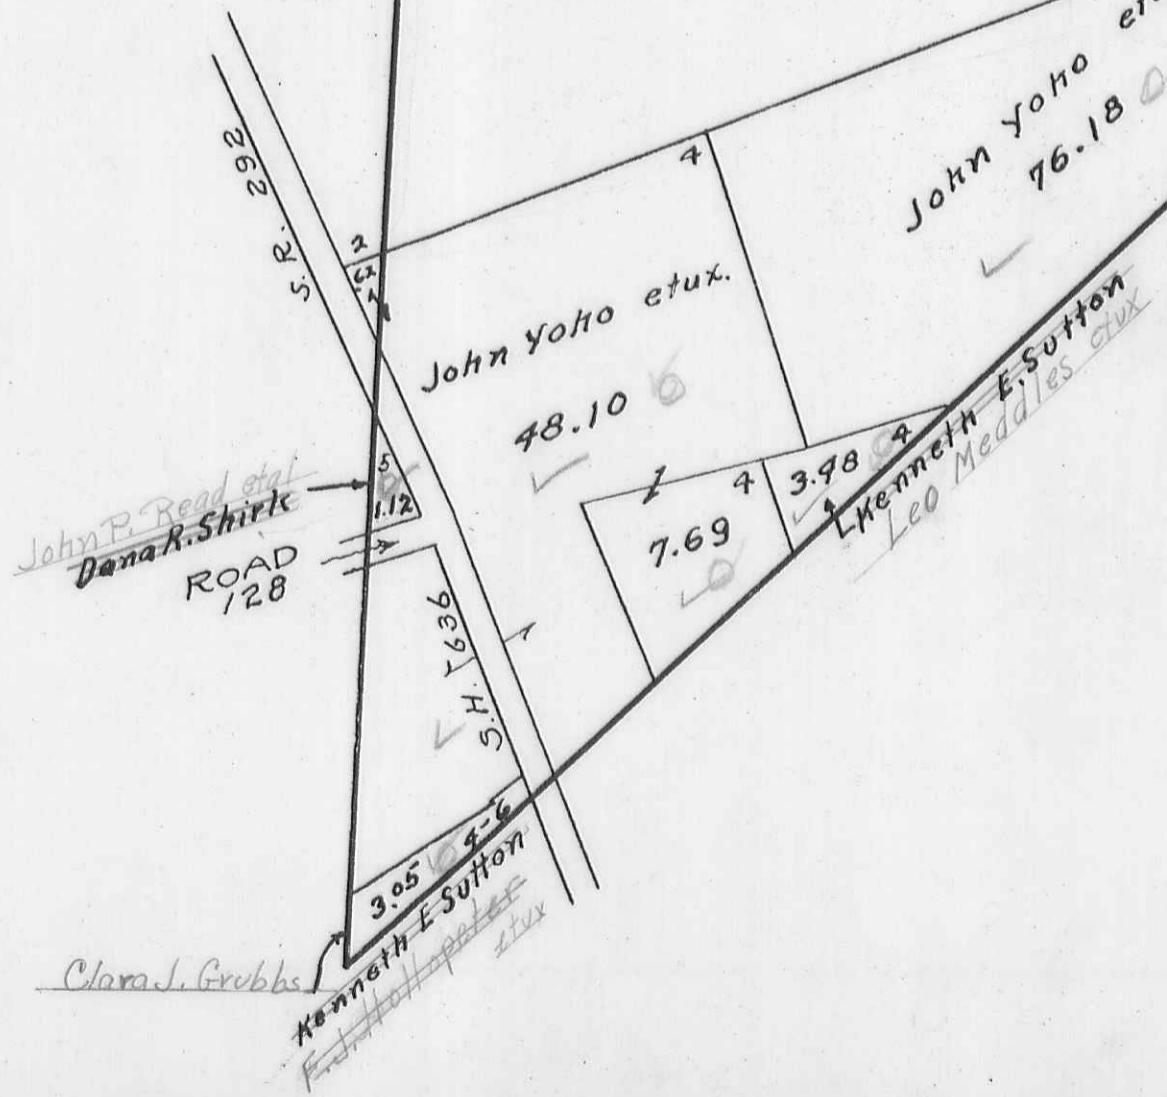

See Page 7

12103  
13528  
13557  
13558

**SCALES 10 CHAINS TO THE INCH  

PERRY


See page 6

PERRY

# TOWNSHIP

PAGE 10

## VIRGINIA

MILITARY SURVEYS 4813  
4815

SCALE 10 CHAINS TO THE INCH

See Page 7

ROAD 2

See Page 10

See Page 19


PERRY TOWNSHIP  
VIRGINIA MILITARY SURVEYS

SCALE 10 CHAINS TO THE INCH

5088  
9198  
9370  
9372

PAGE


12

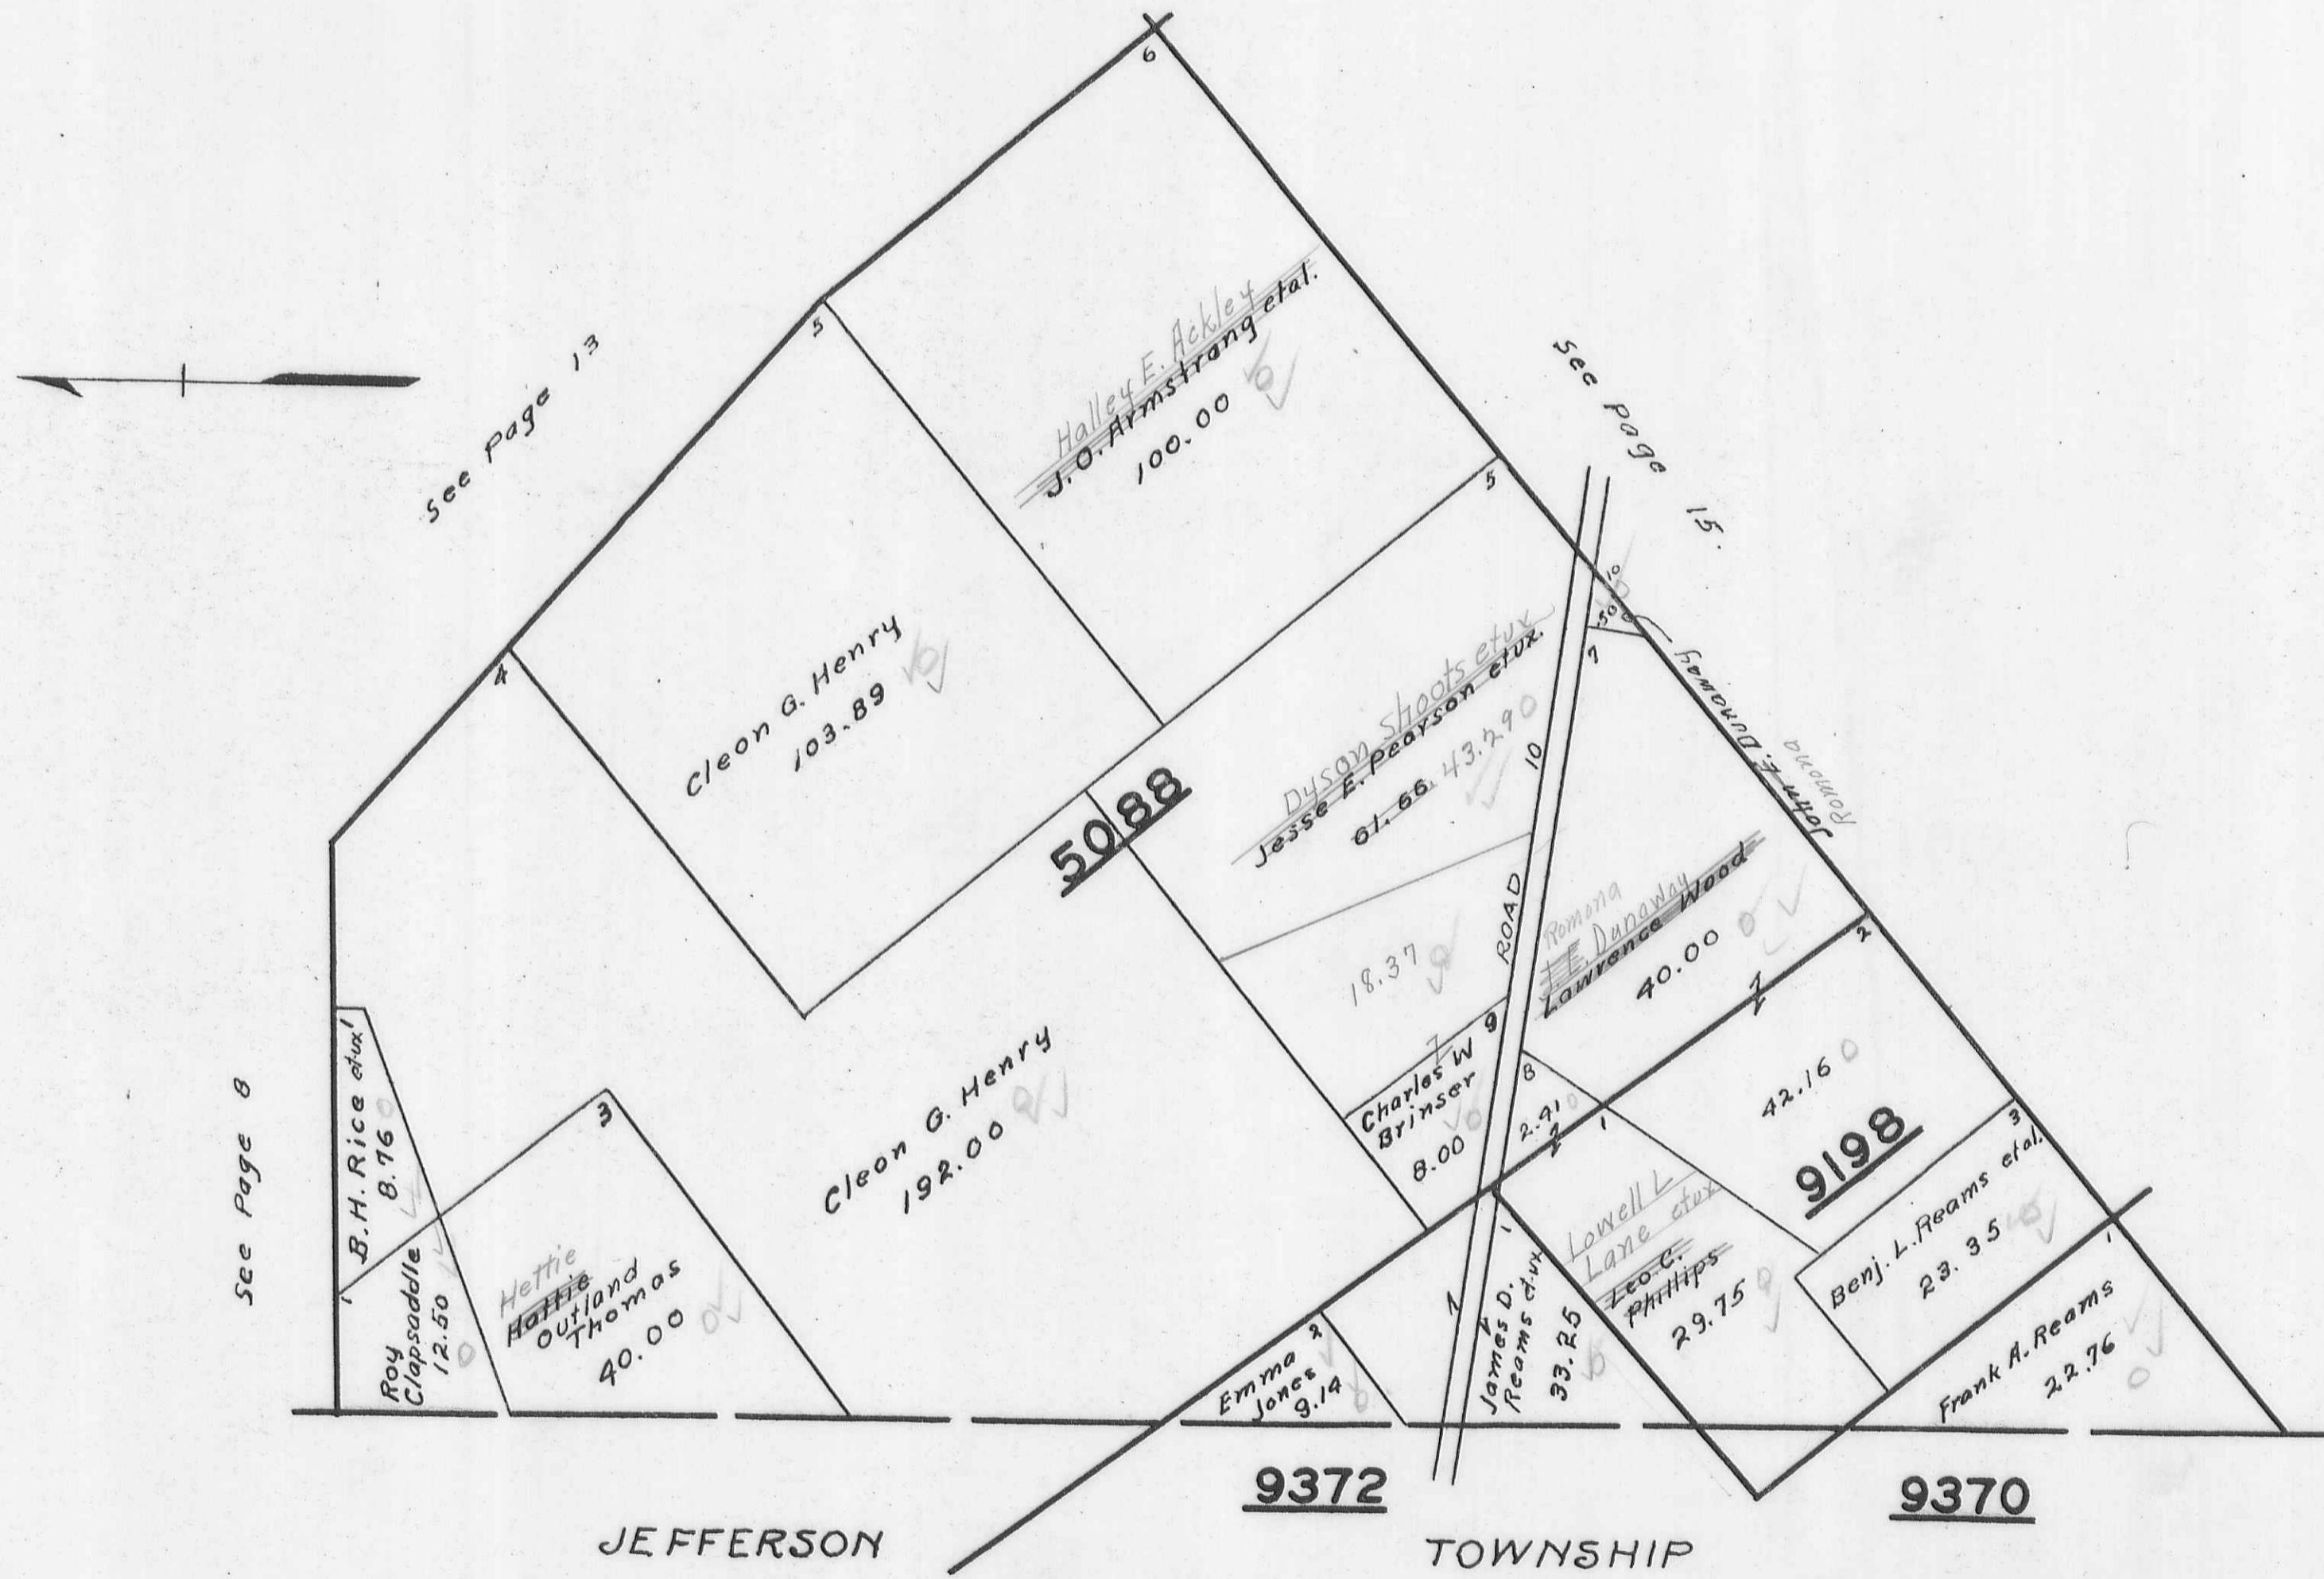

PERRY TOWNSHIP  
VIRGINIA MILITARY SURVEYS  
SCALE 10 CHAINS TO THE INCH


5883  
5875  
7288

PAGE 13

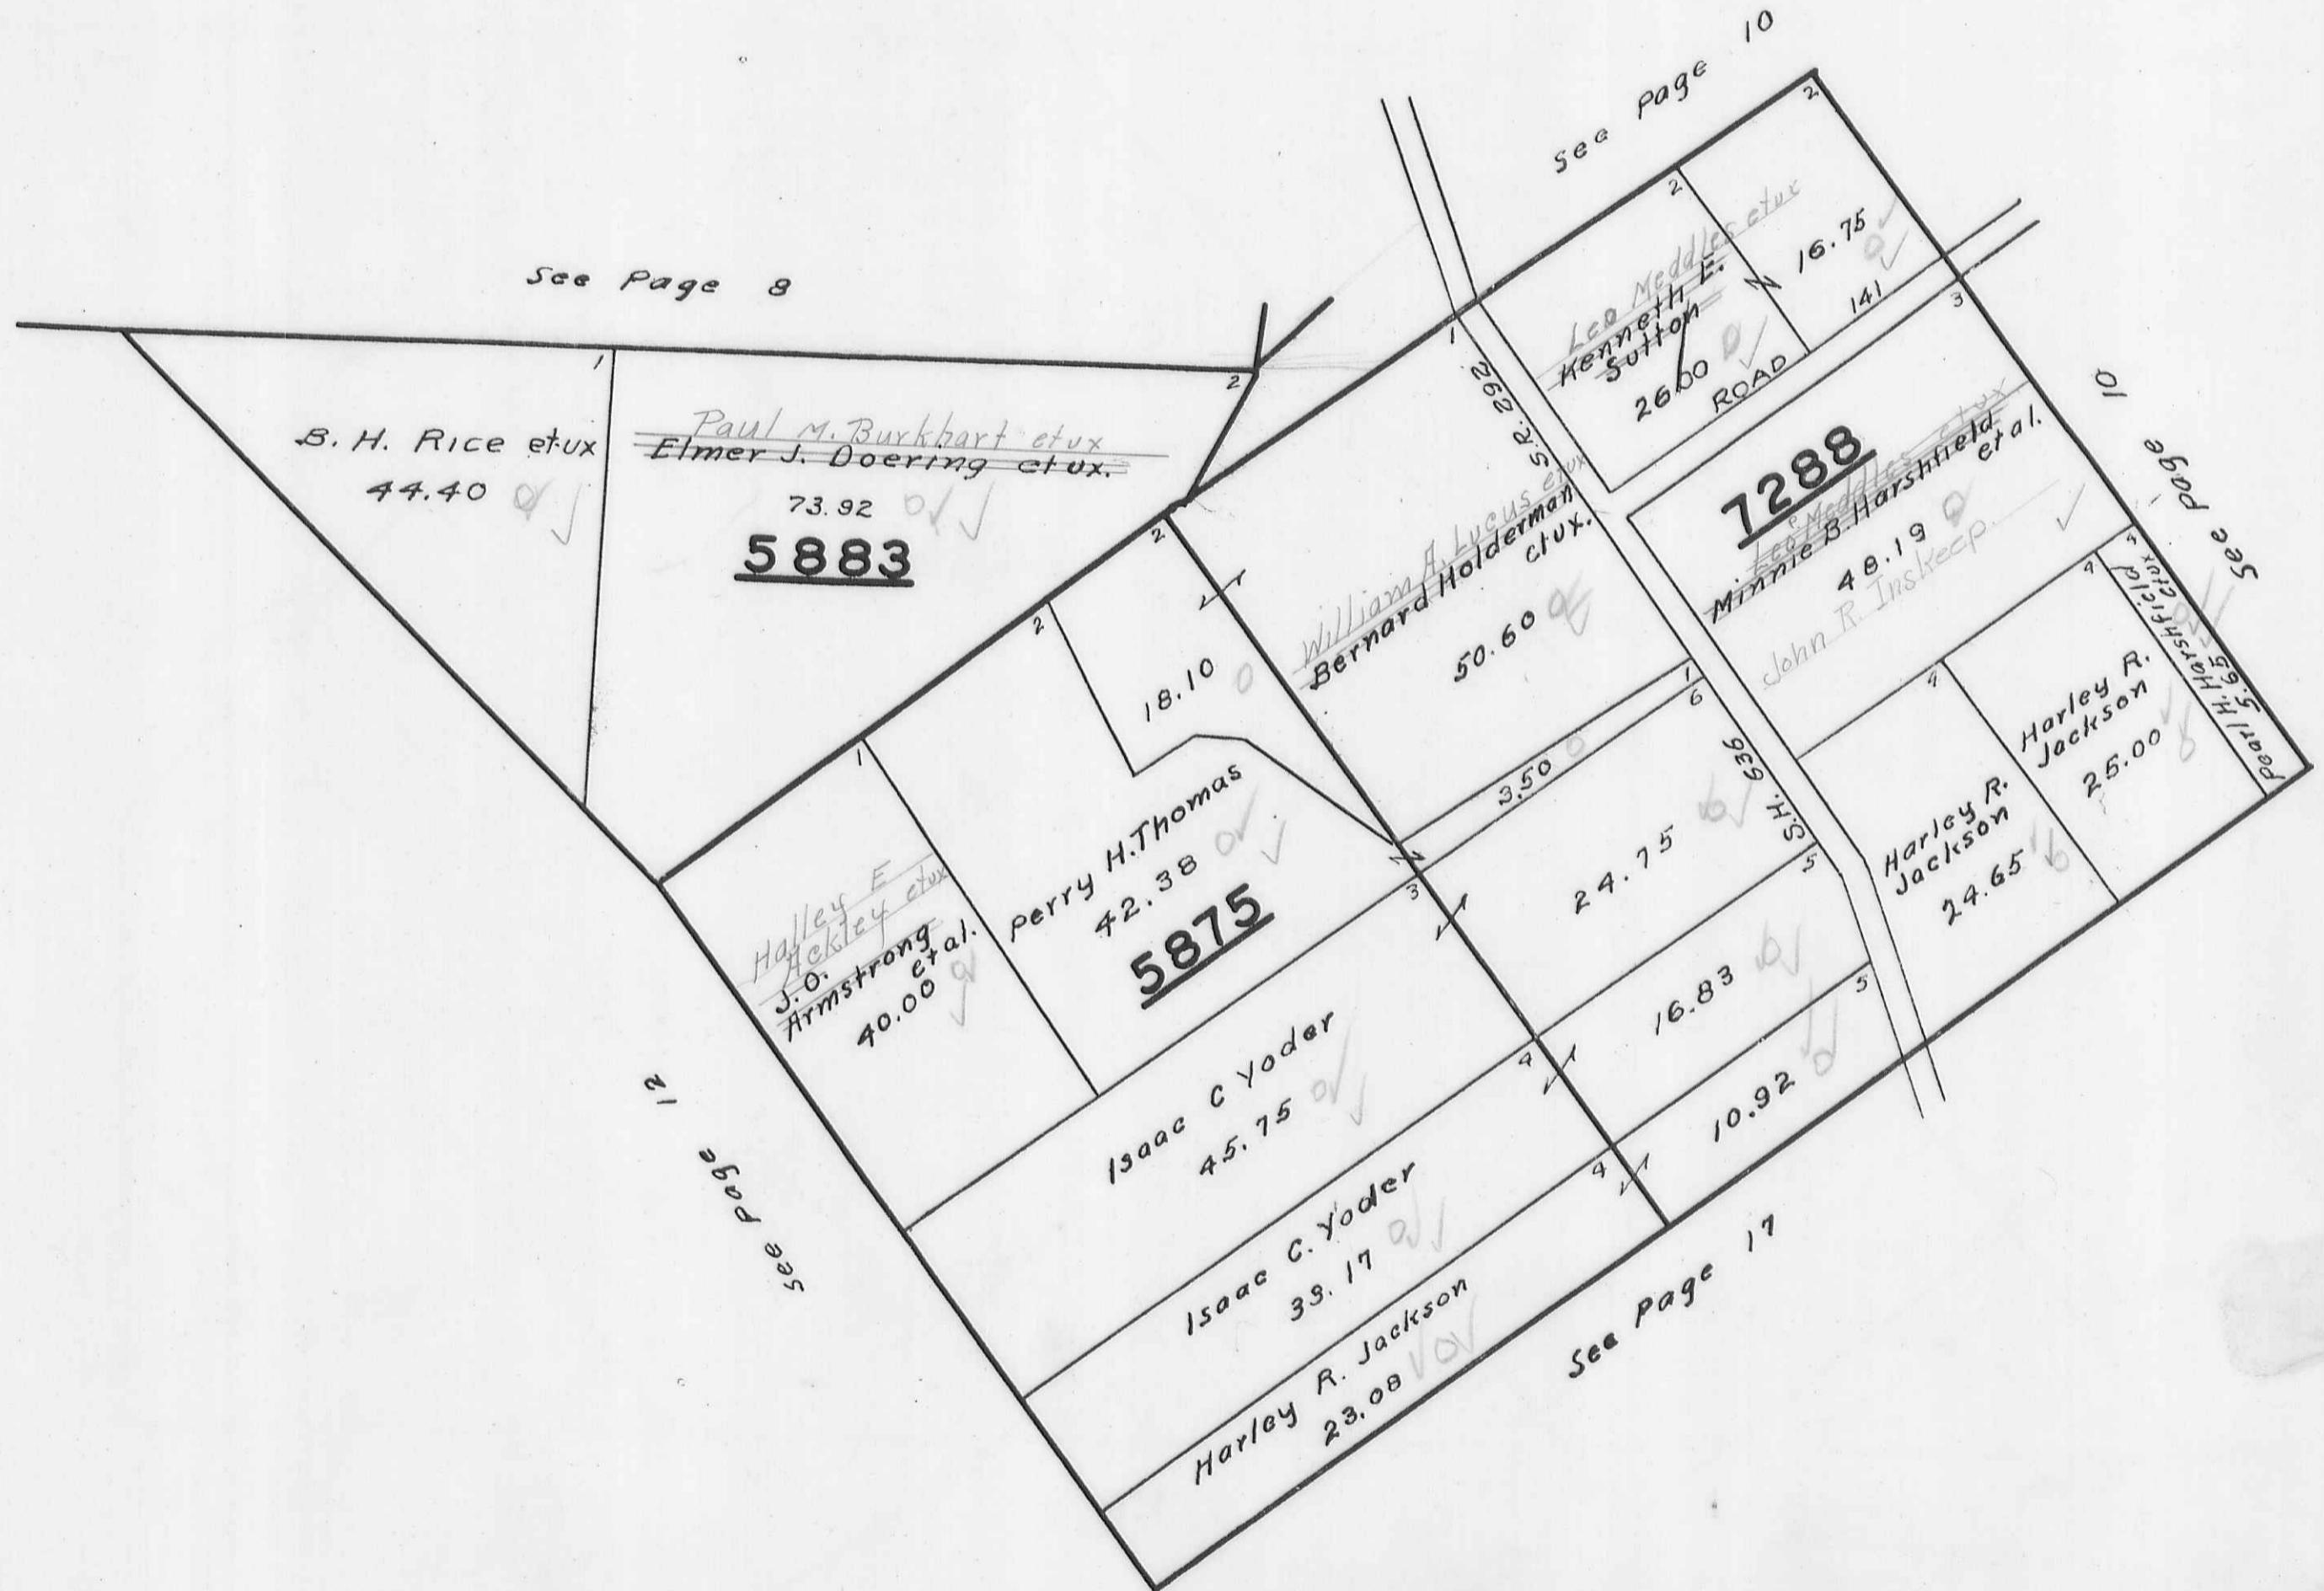

PERRY TOWNSHIP  
VIRGINIA MILITARY SURVEYS  
SCALE 10 CHAINS TO THE INCH

PAGE 14  
3159 4661 9676  
3161 4676 12174  
3753 9371 4682

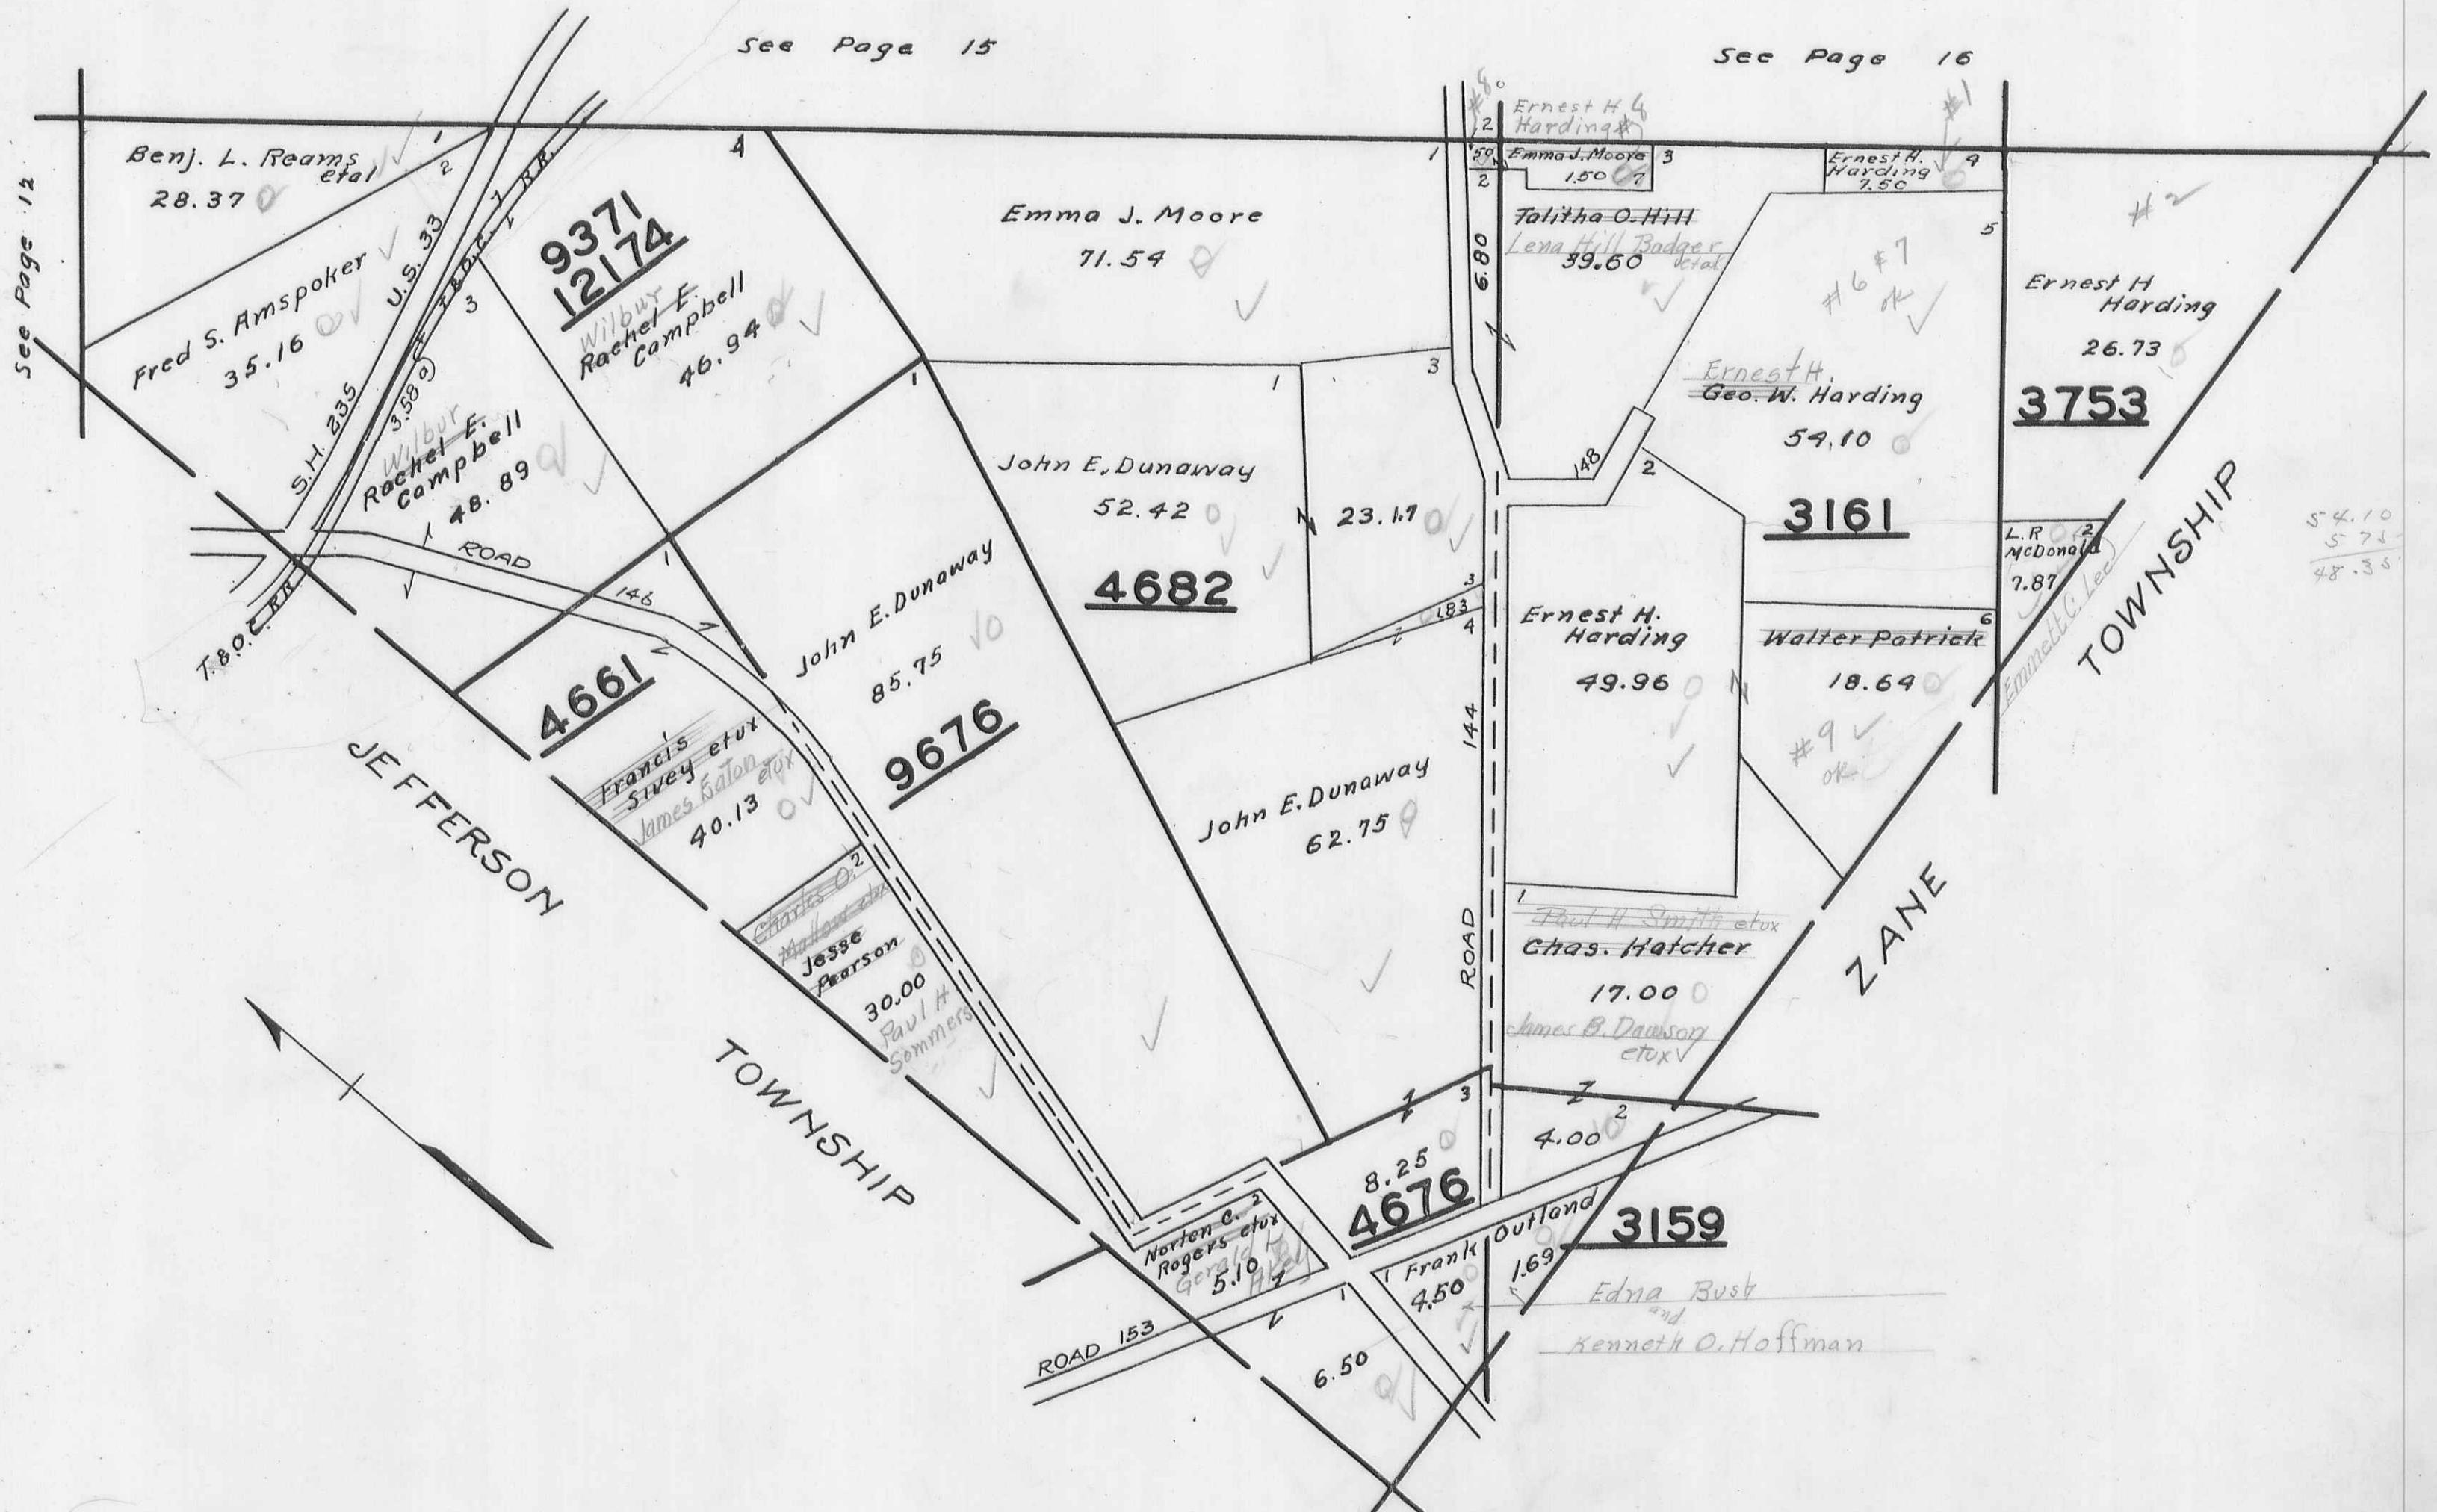

PERRY


TOWNSHIP

PAGE

15


VIRGINIA MILITARY SURVEY 4655

SCALE 10 CHAINS TO THE INCH

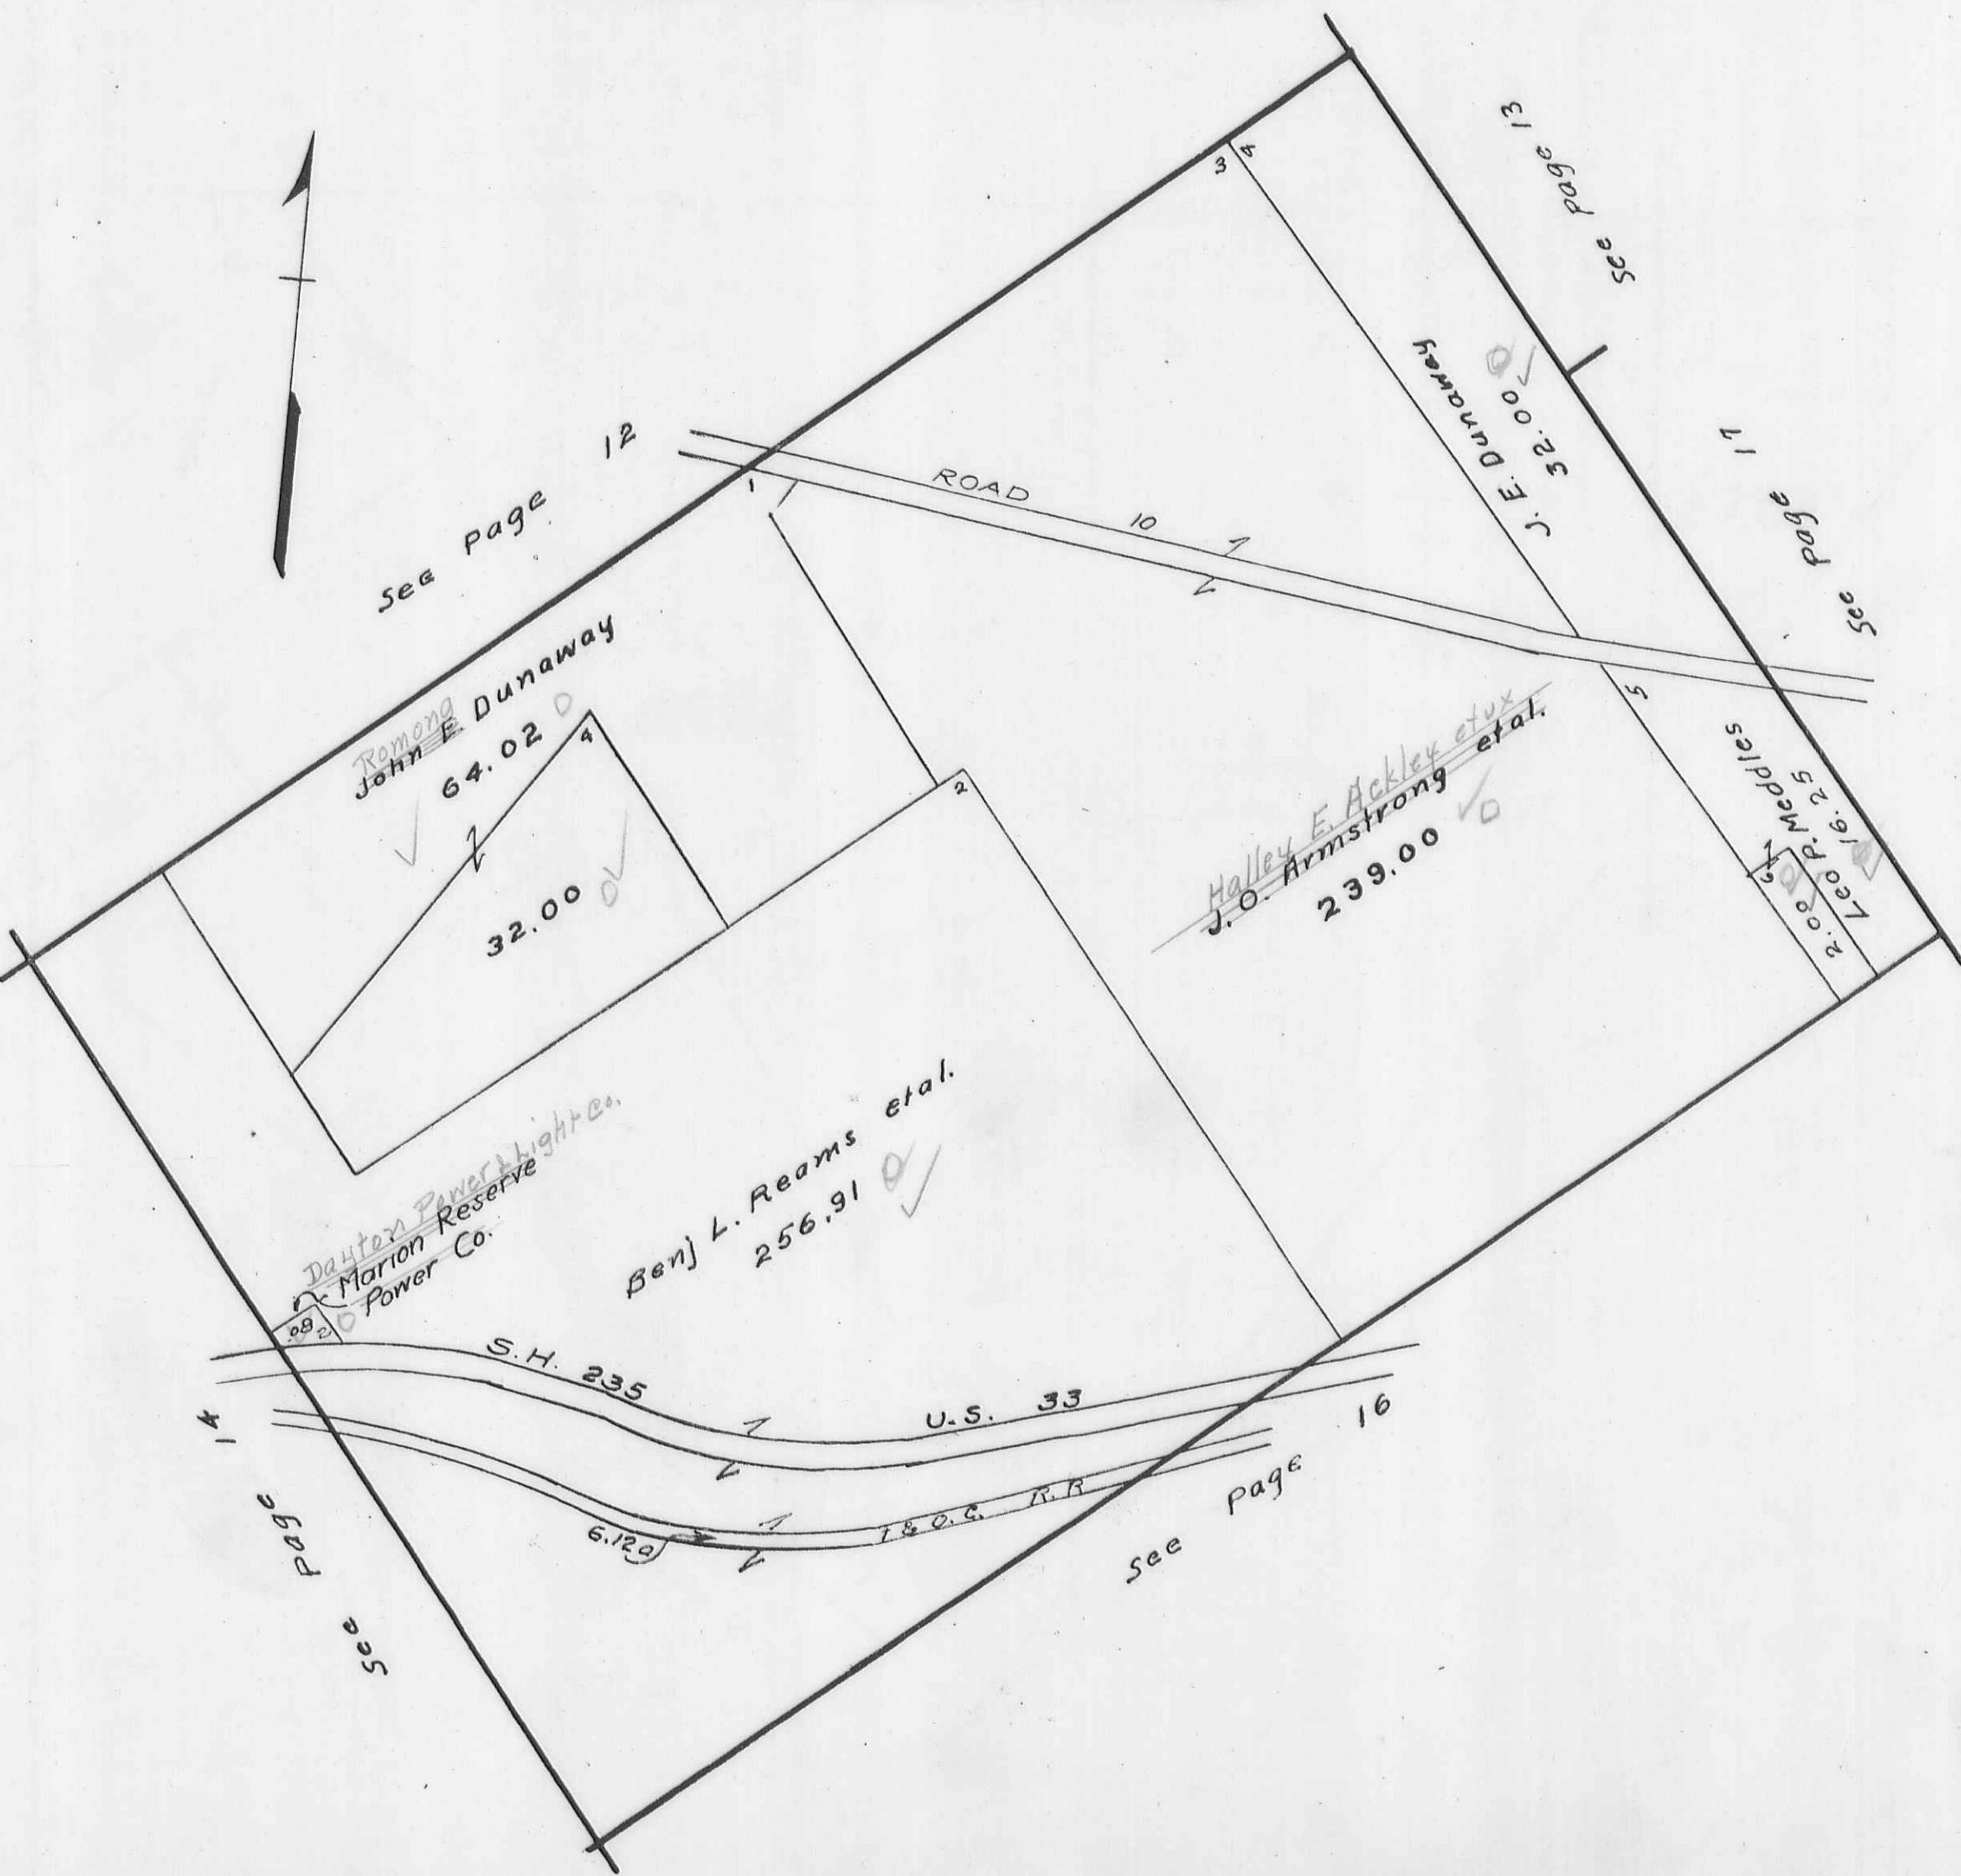

## VIRGINIA MILITARY SURVEY 3164

SCALE 10 CHAINS TO THE INCH

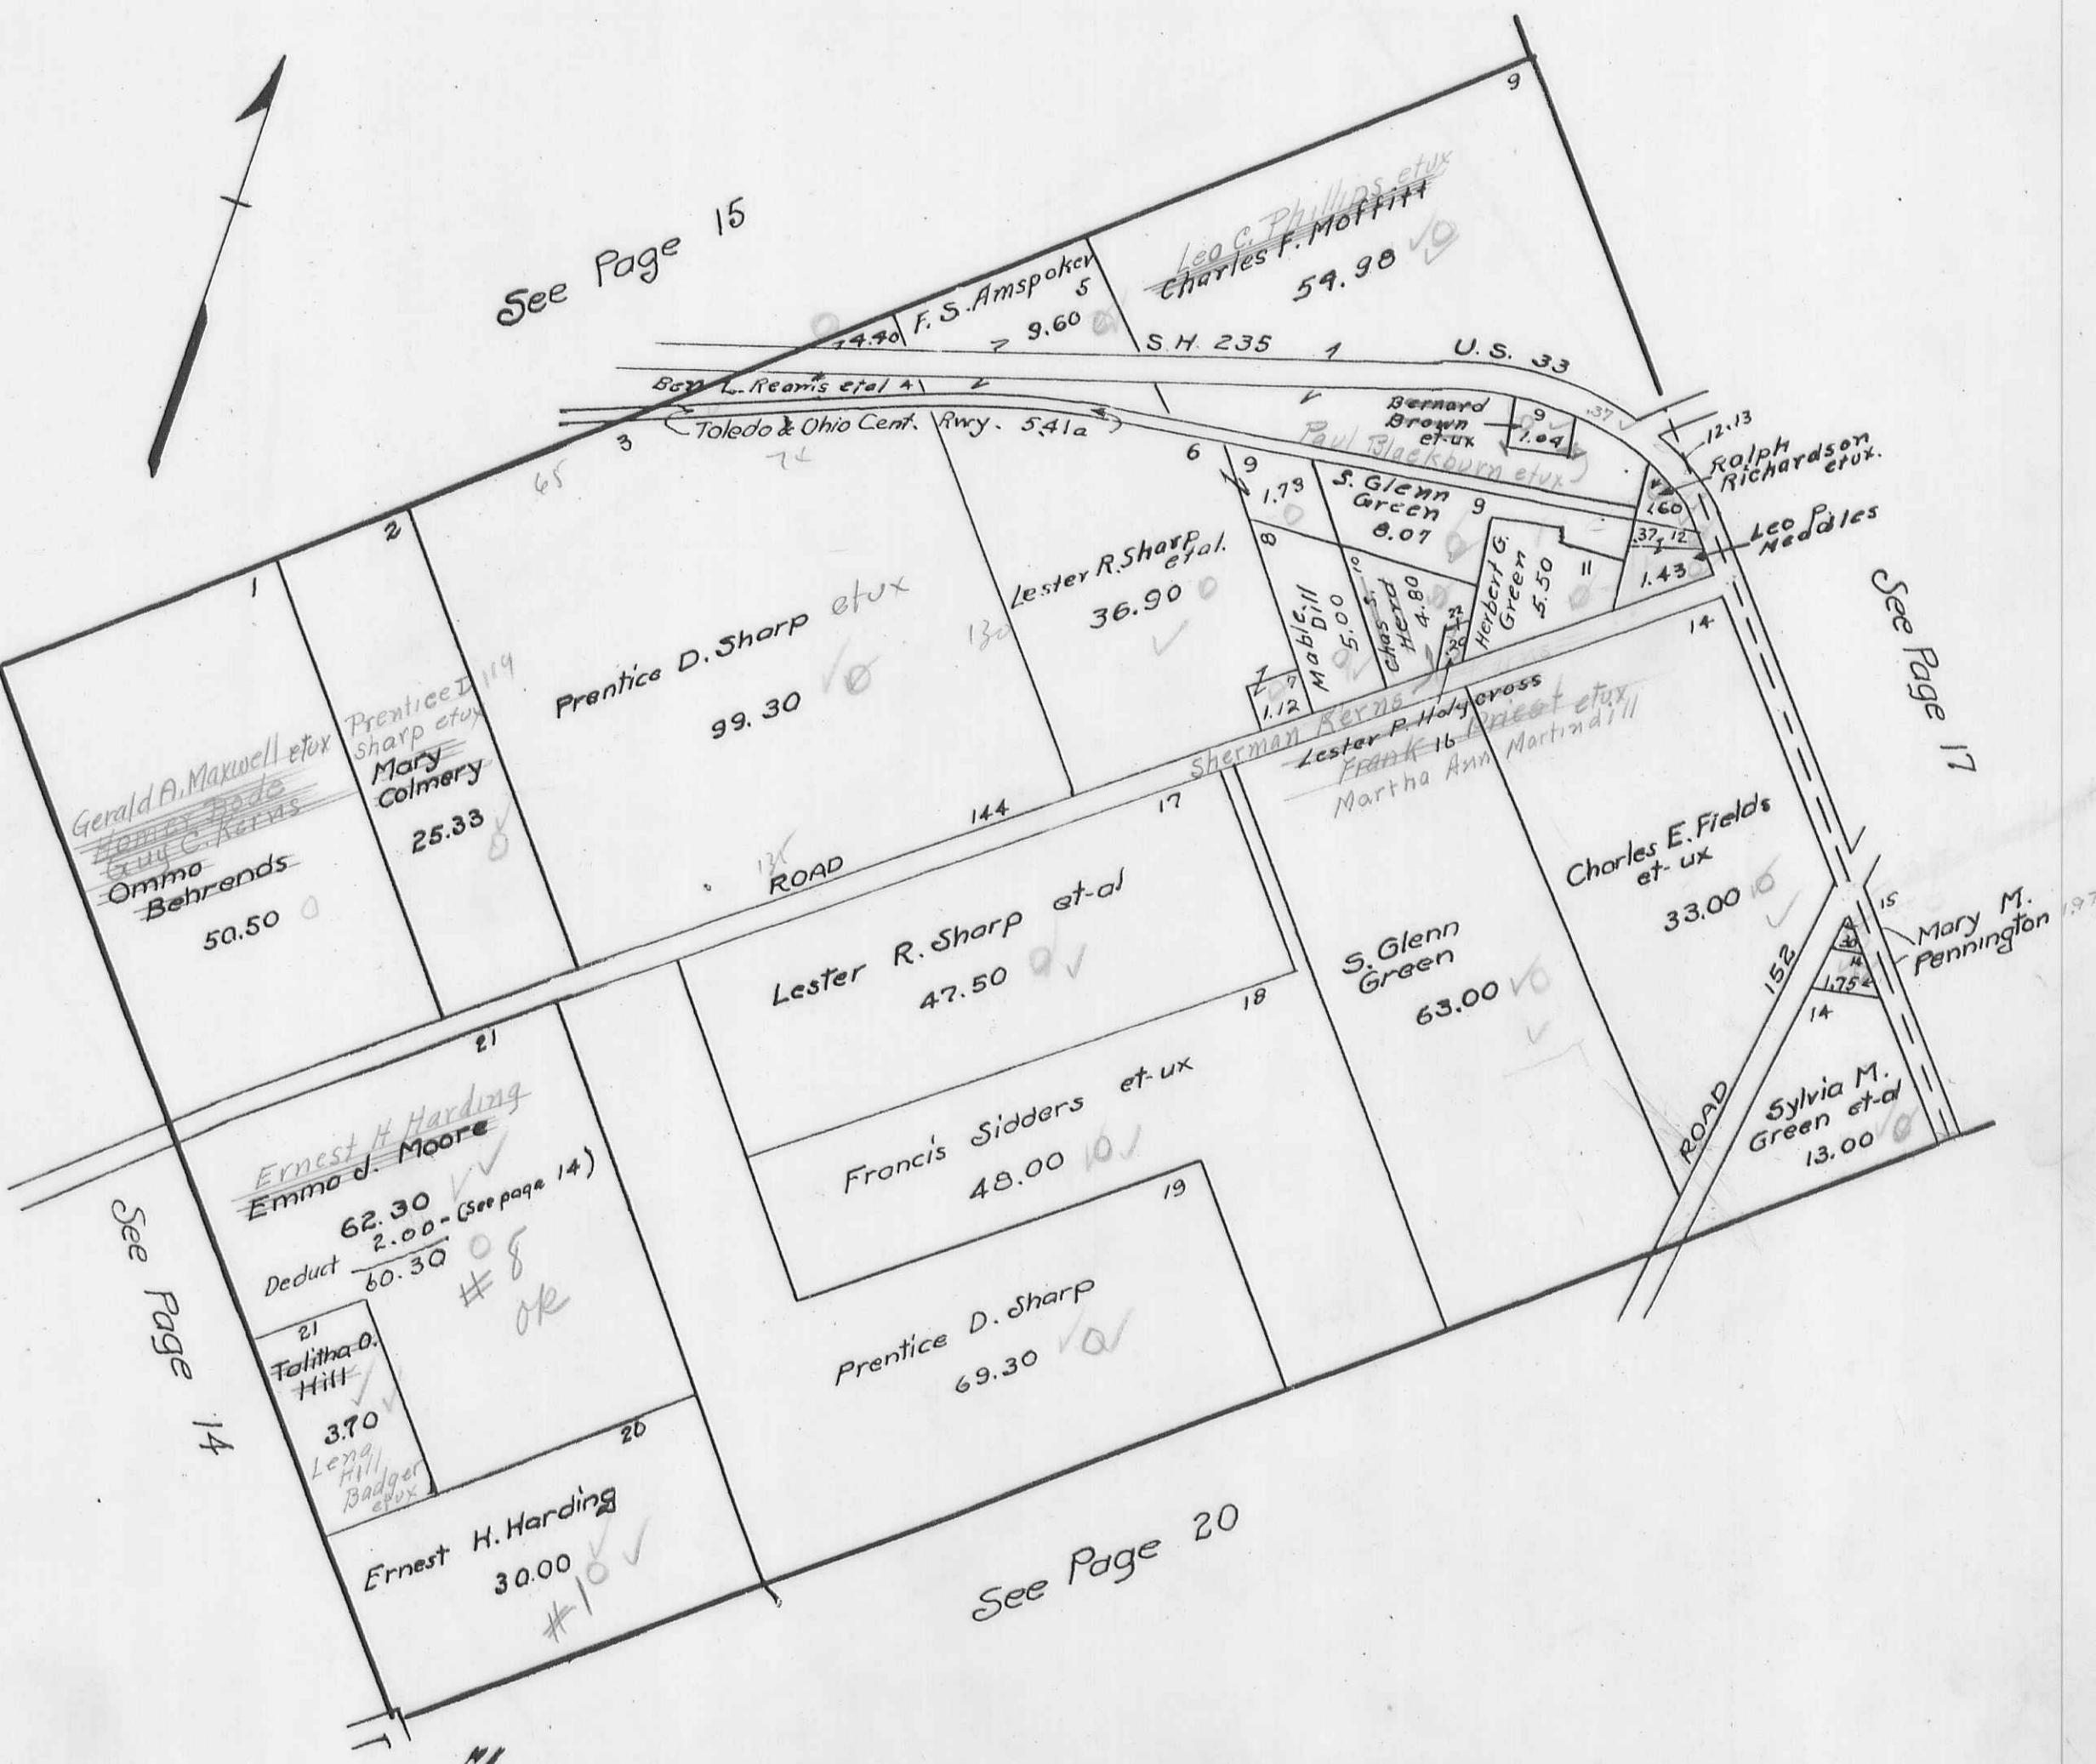


PERRY TOWNSHIP  
VIRGINIA MILITARY SURVEY 4689

PAGE 17

SCALE 10 CHAINS TO THE INCH

See Page 15

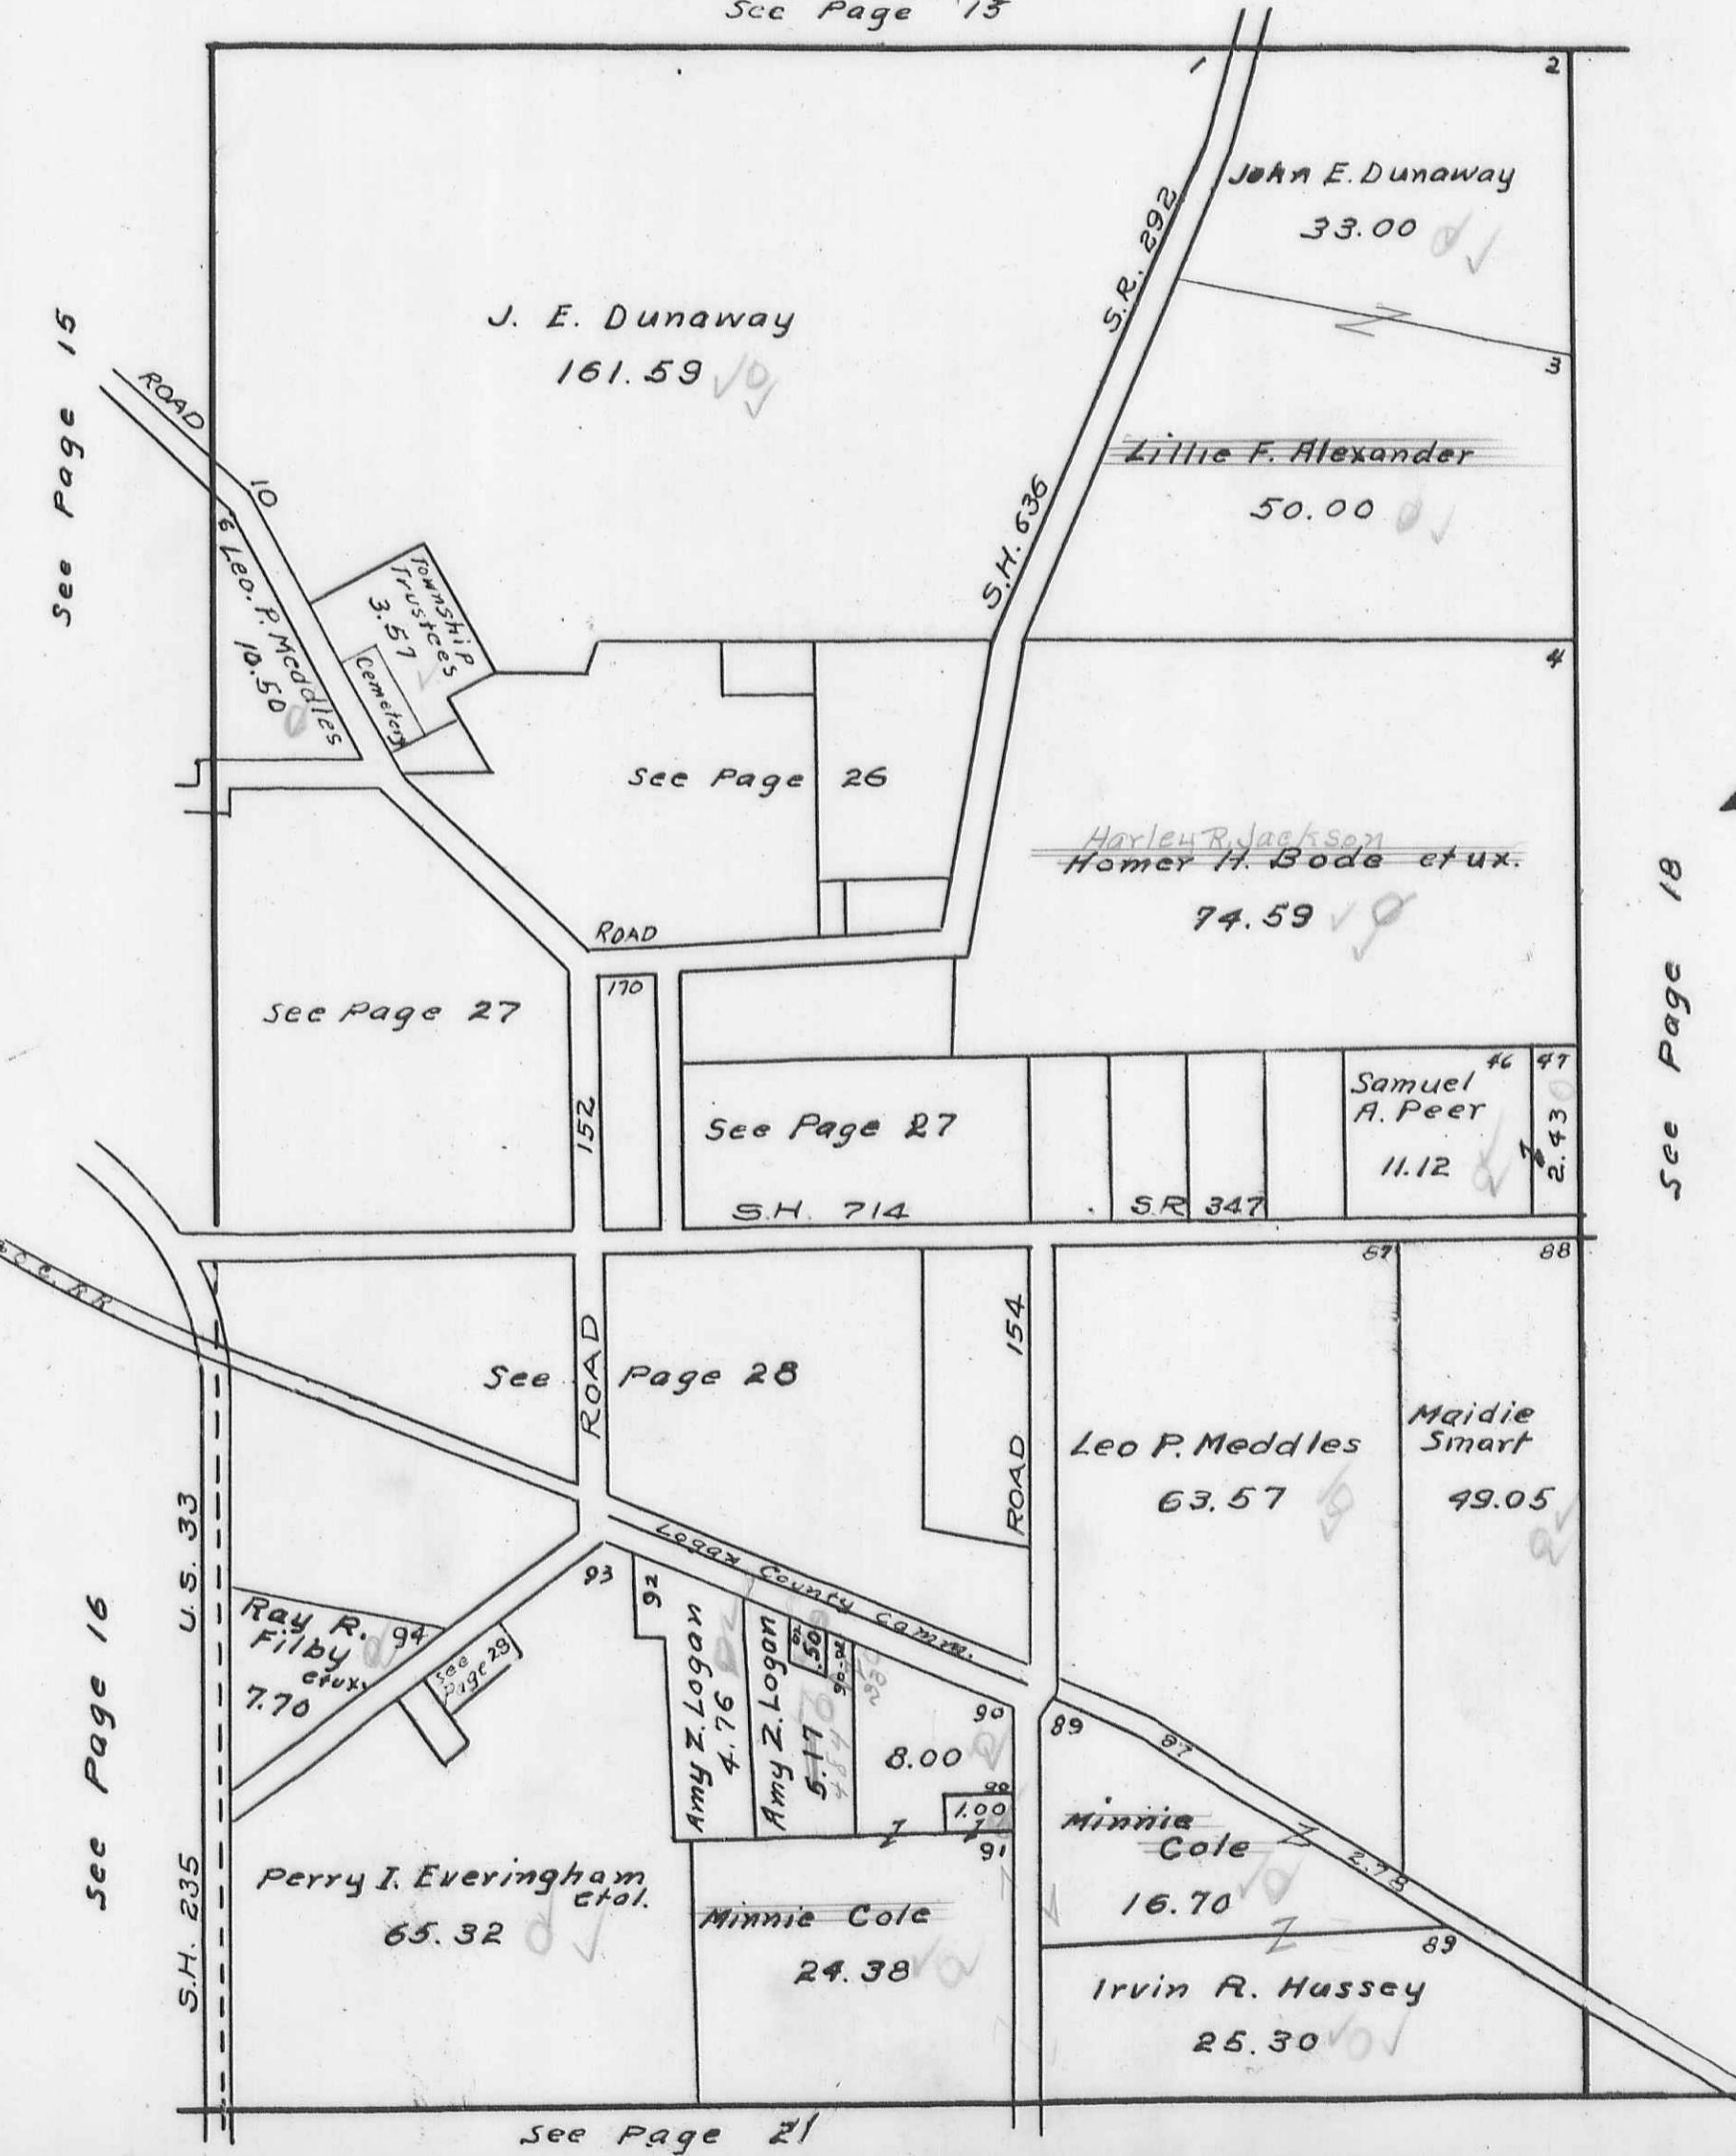

PERRY


TOWNSHIP

PAGE 18

## VIRGINIA MILITARY SURVEY 4810

SCALE 10 CHAINS TO THE INCH

See Page 19

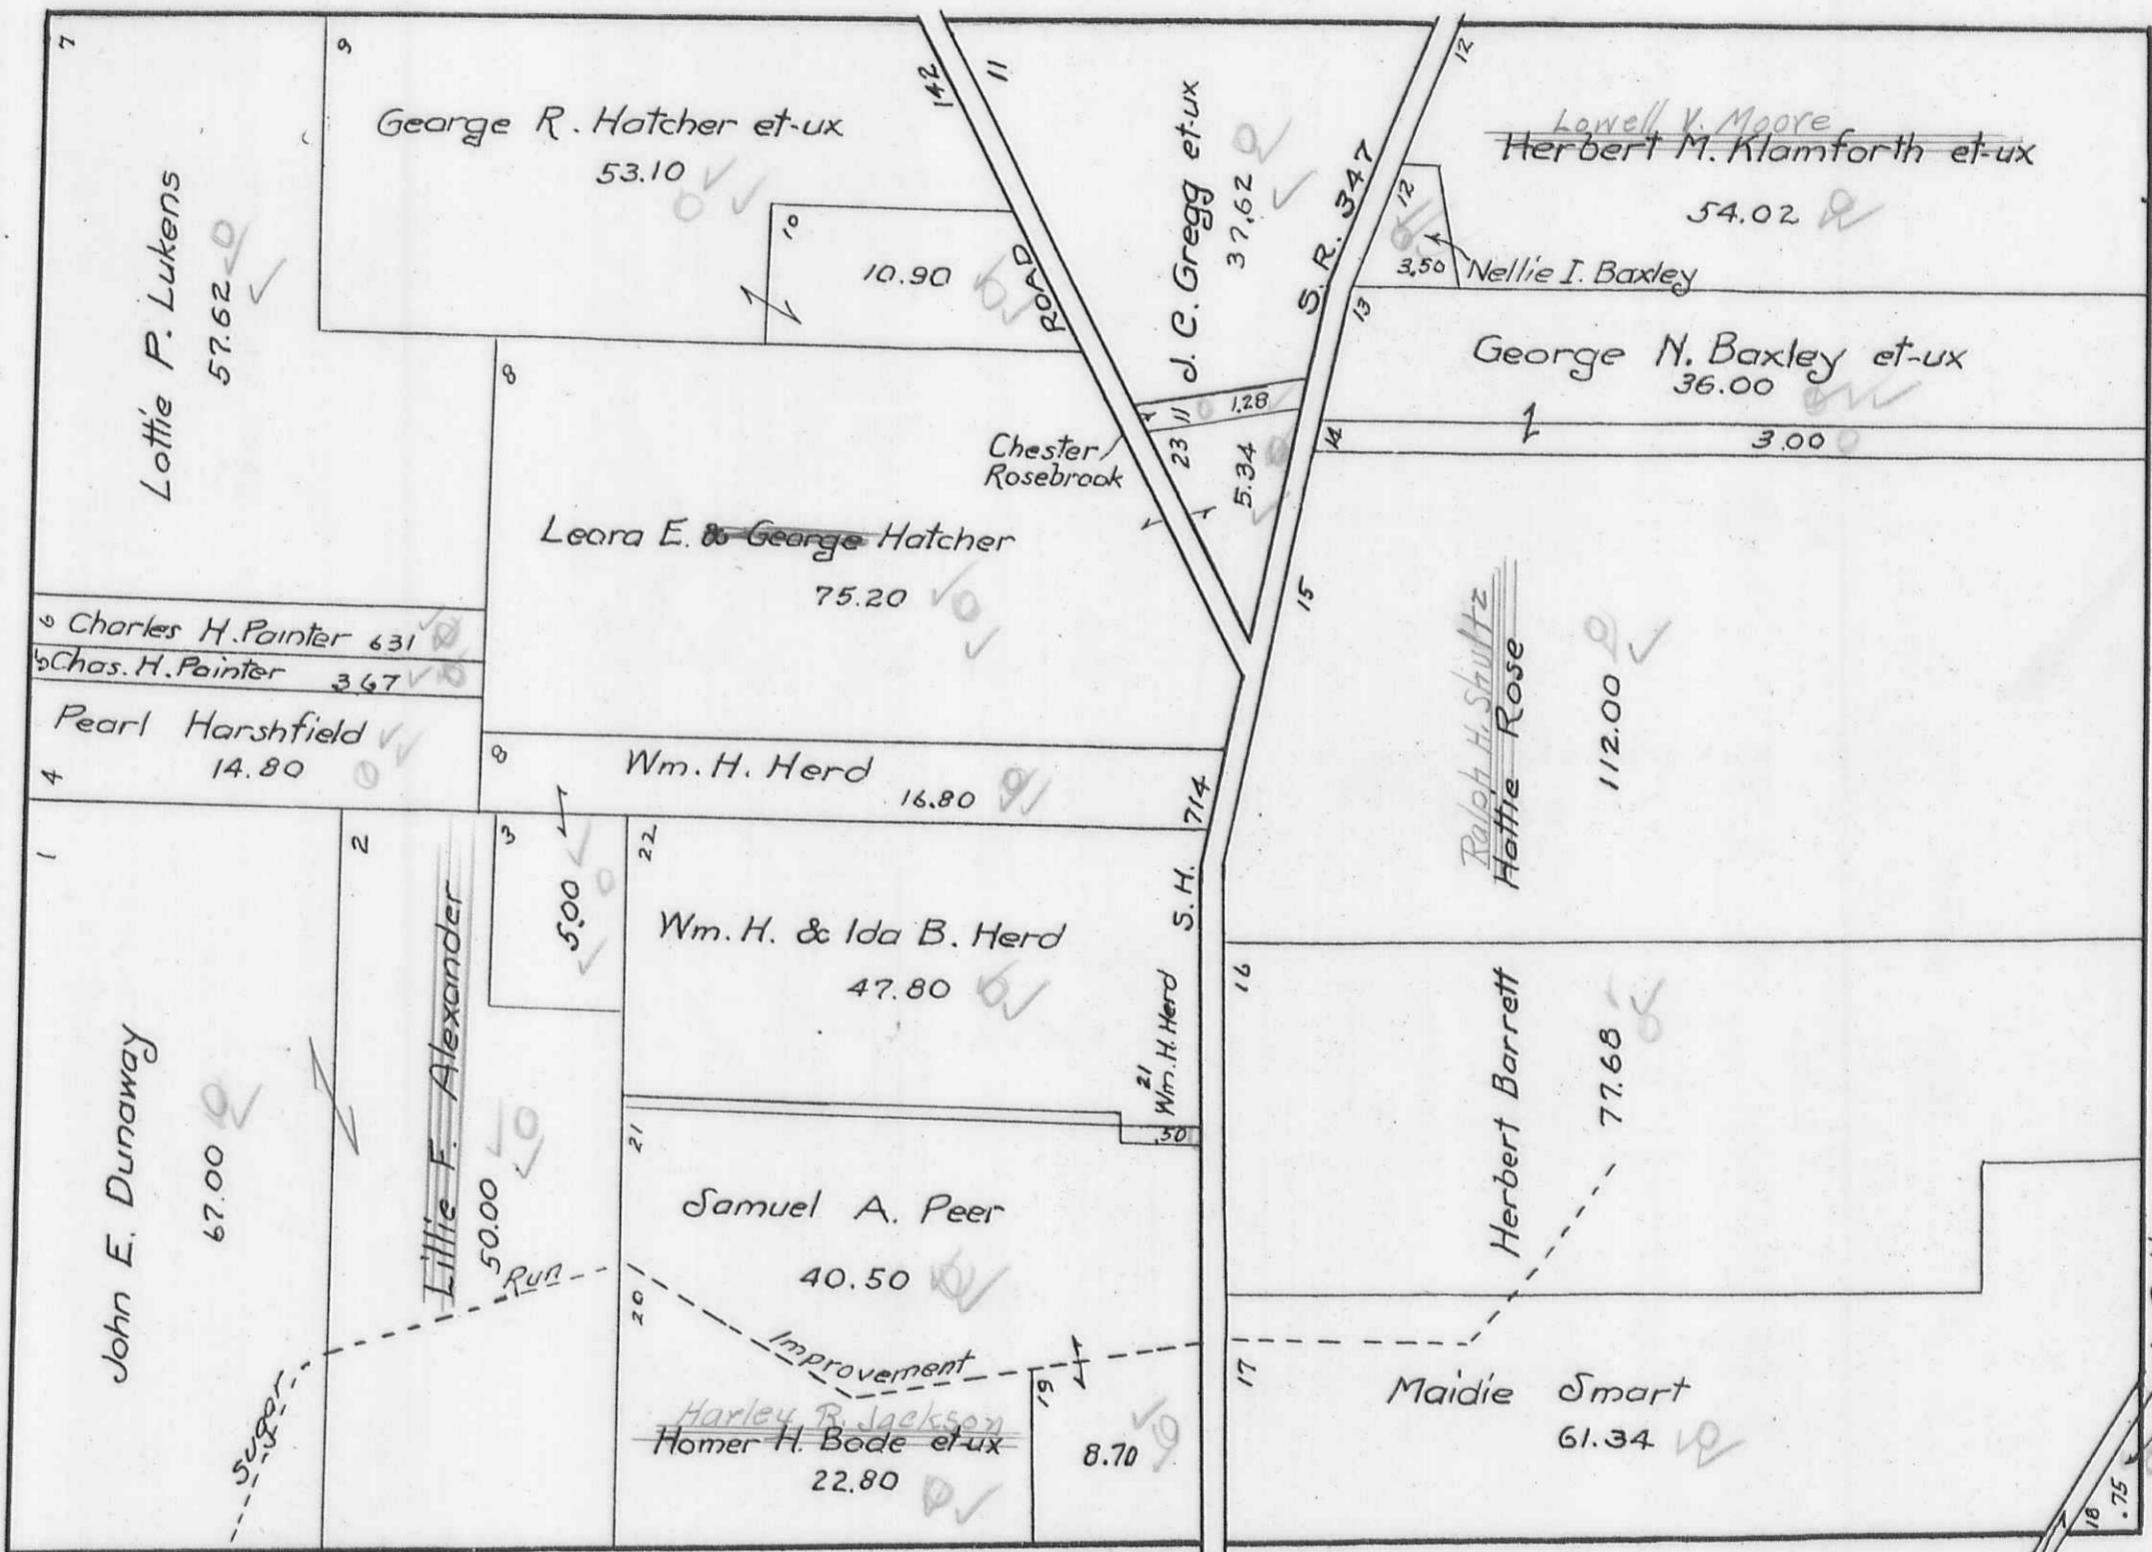


PERRY

TOWNSHIP

PAGE 19

VIRGINIA MILITARY SURVEY 6232

SCALE 10 CHAINS TO THE INCH

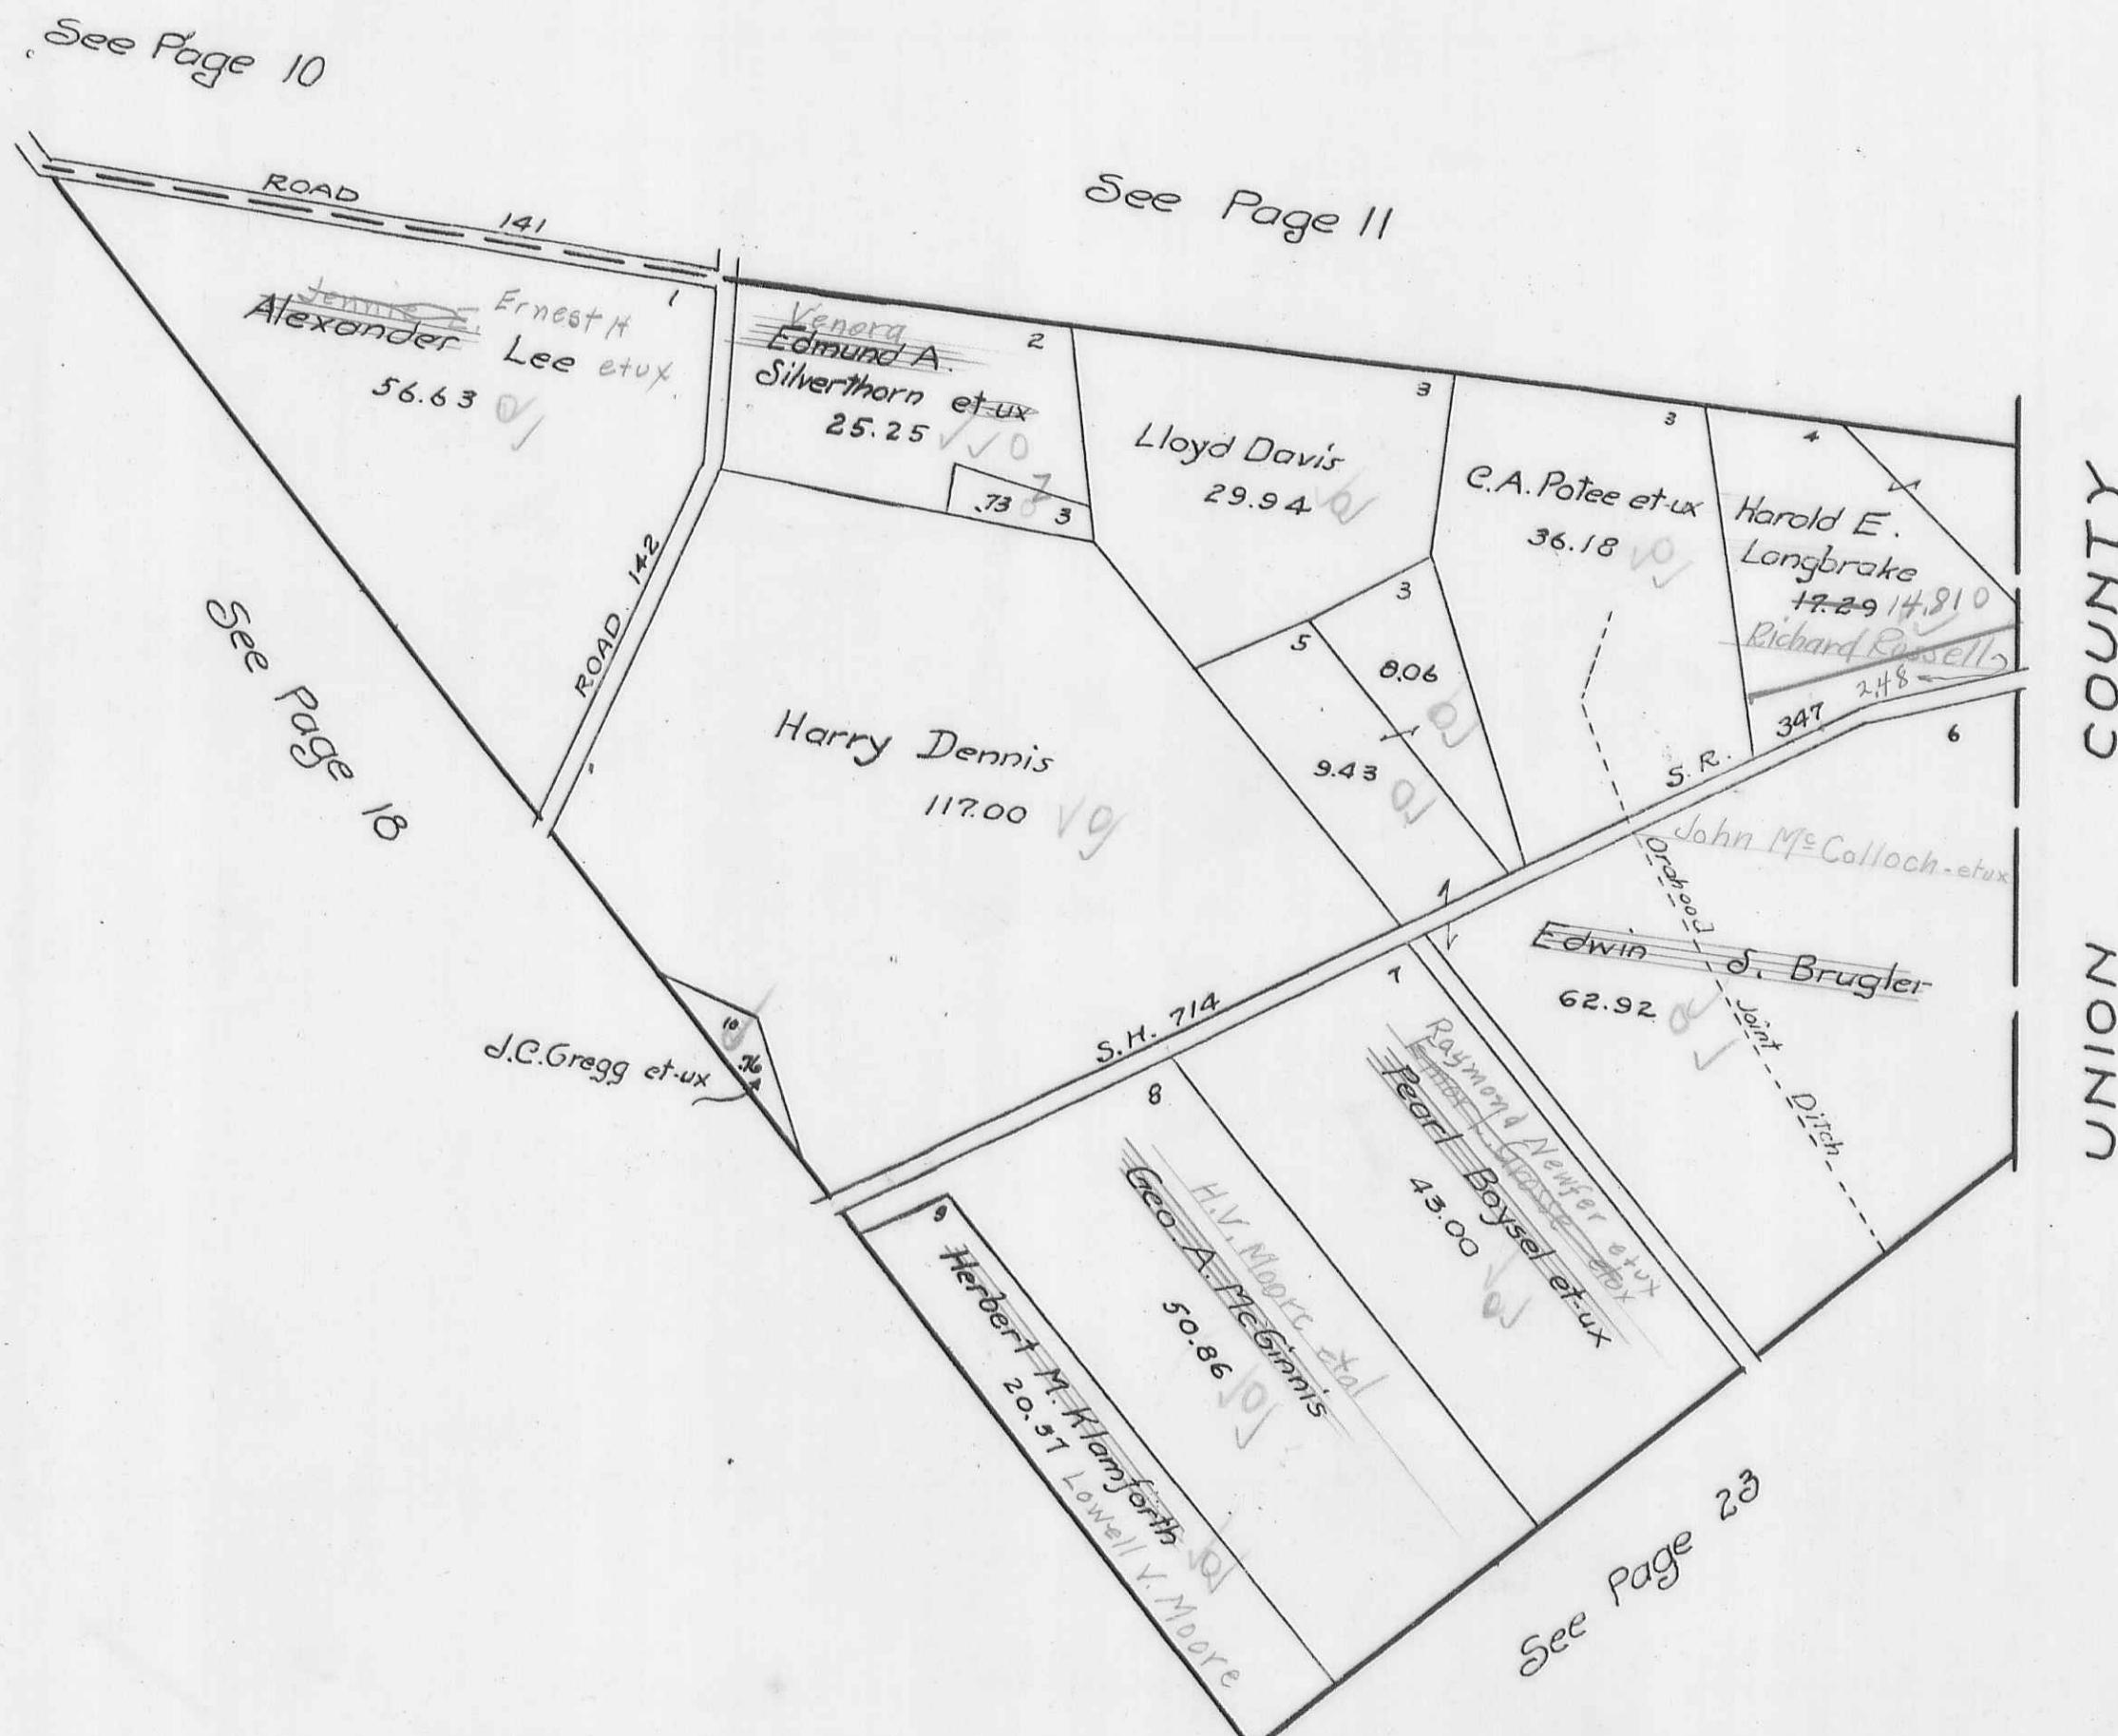


PERRY

TOWNSHIP

PAGE 20

VIRGINIA MILITARY SURVEY 3154

SCALE 10 CHAINS TO THE INCH

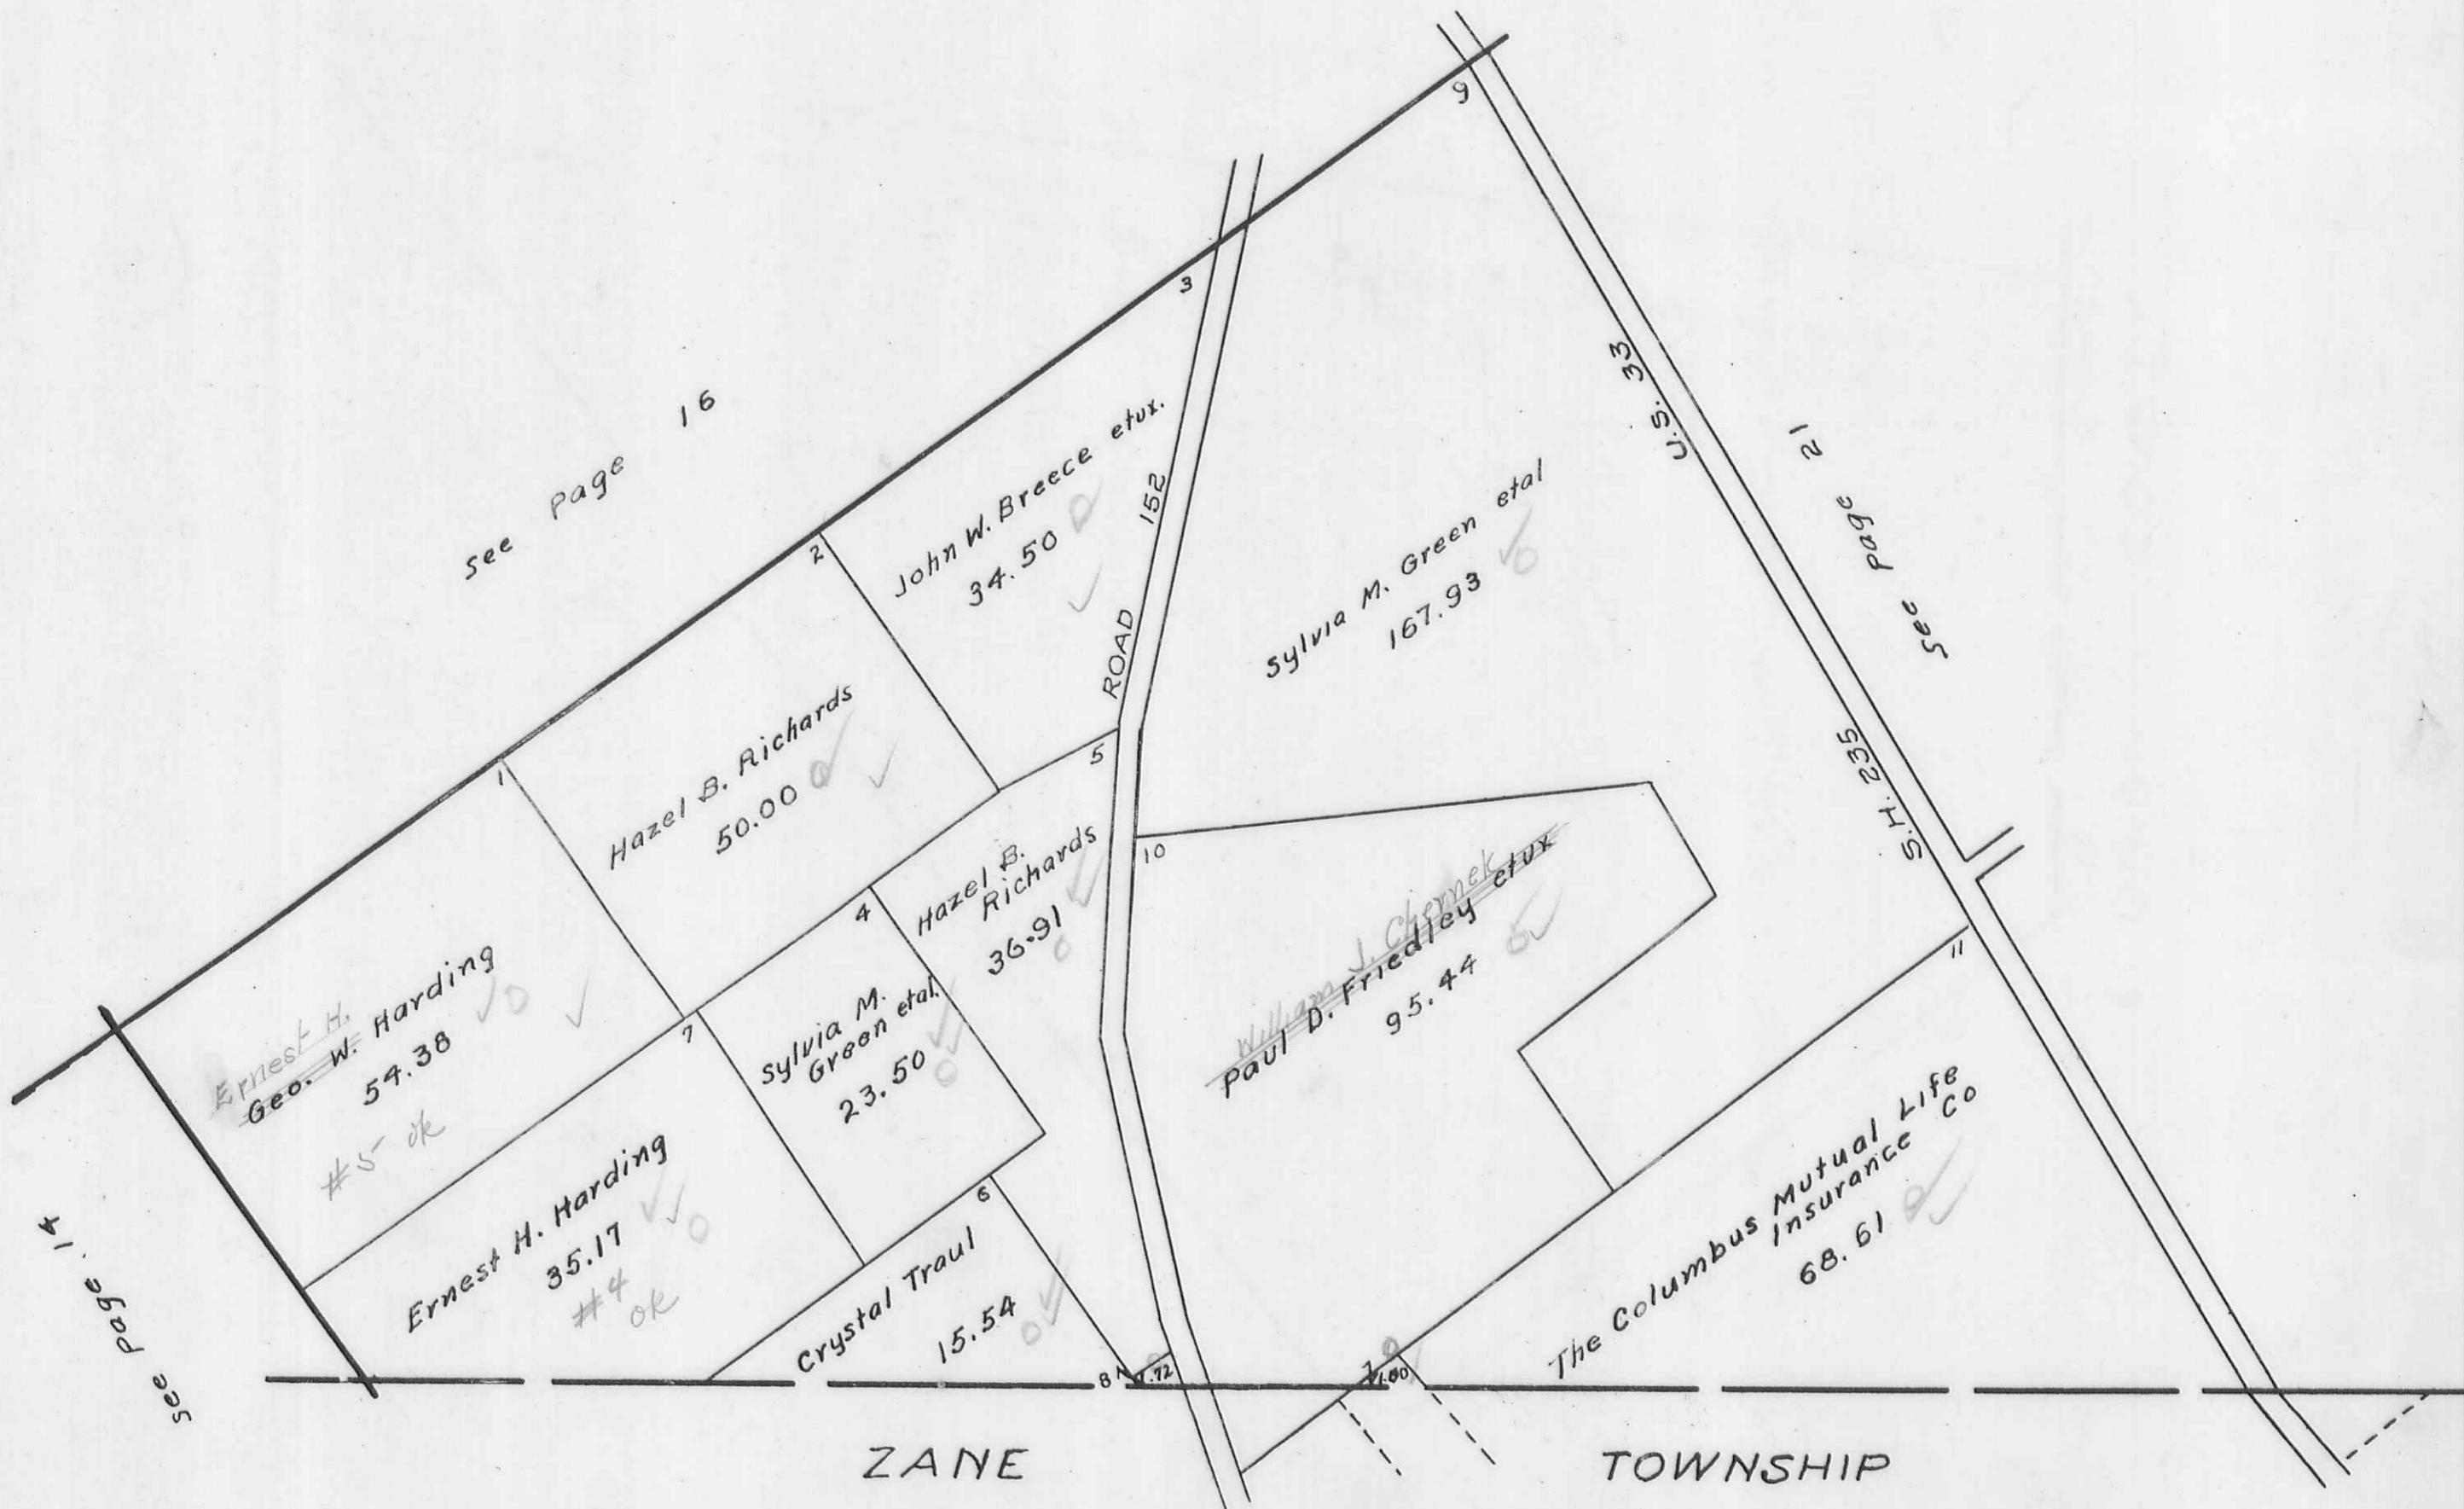


## VIRGINIA

## MILITARY

## SURVEY 4811

SCALE 10 CHAINS TO THE INCH

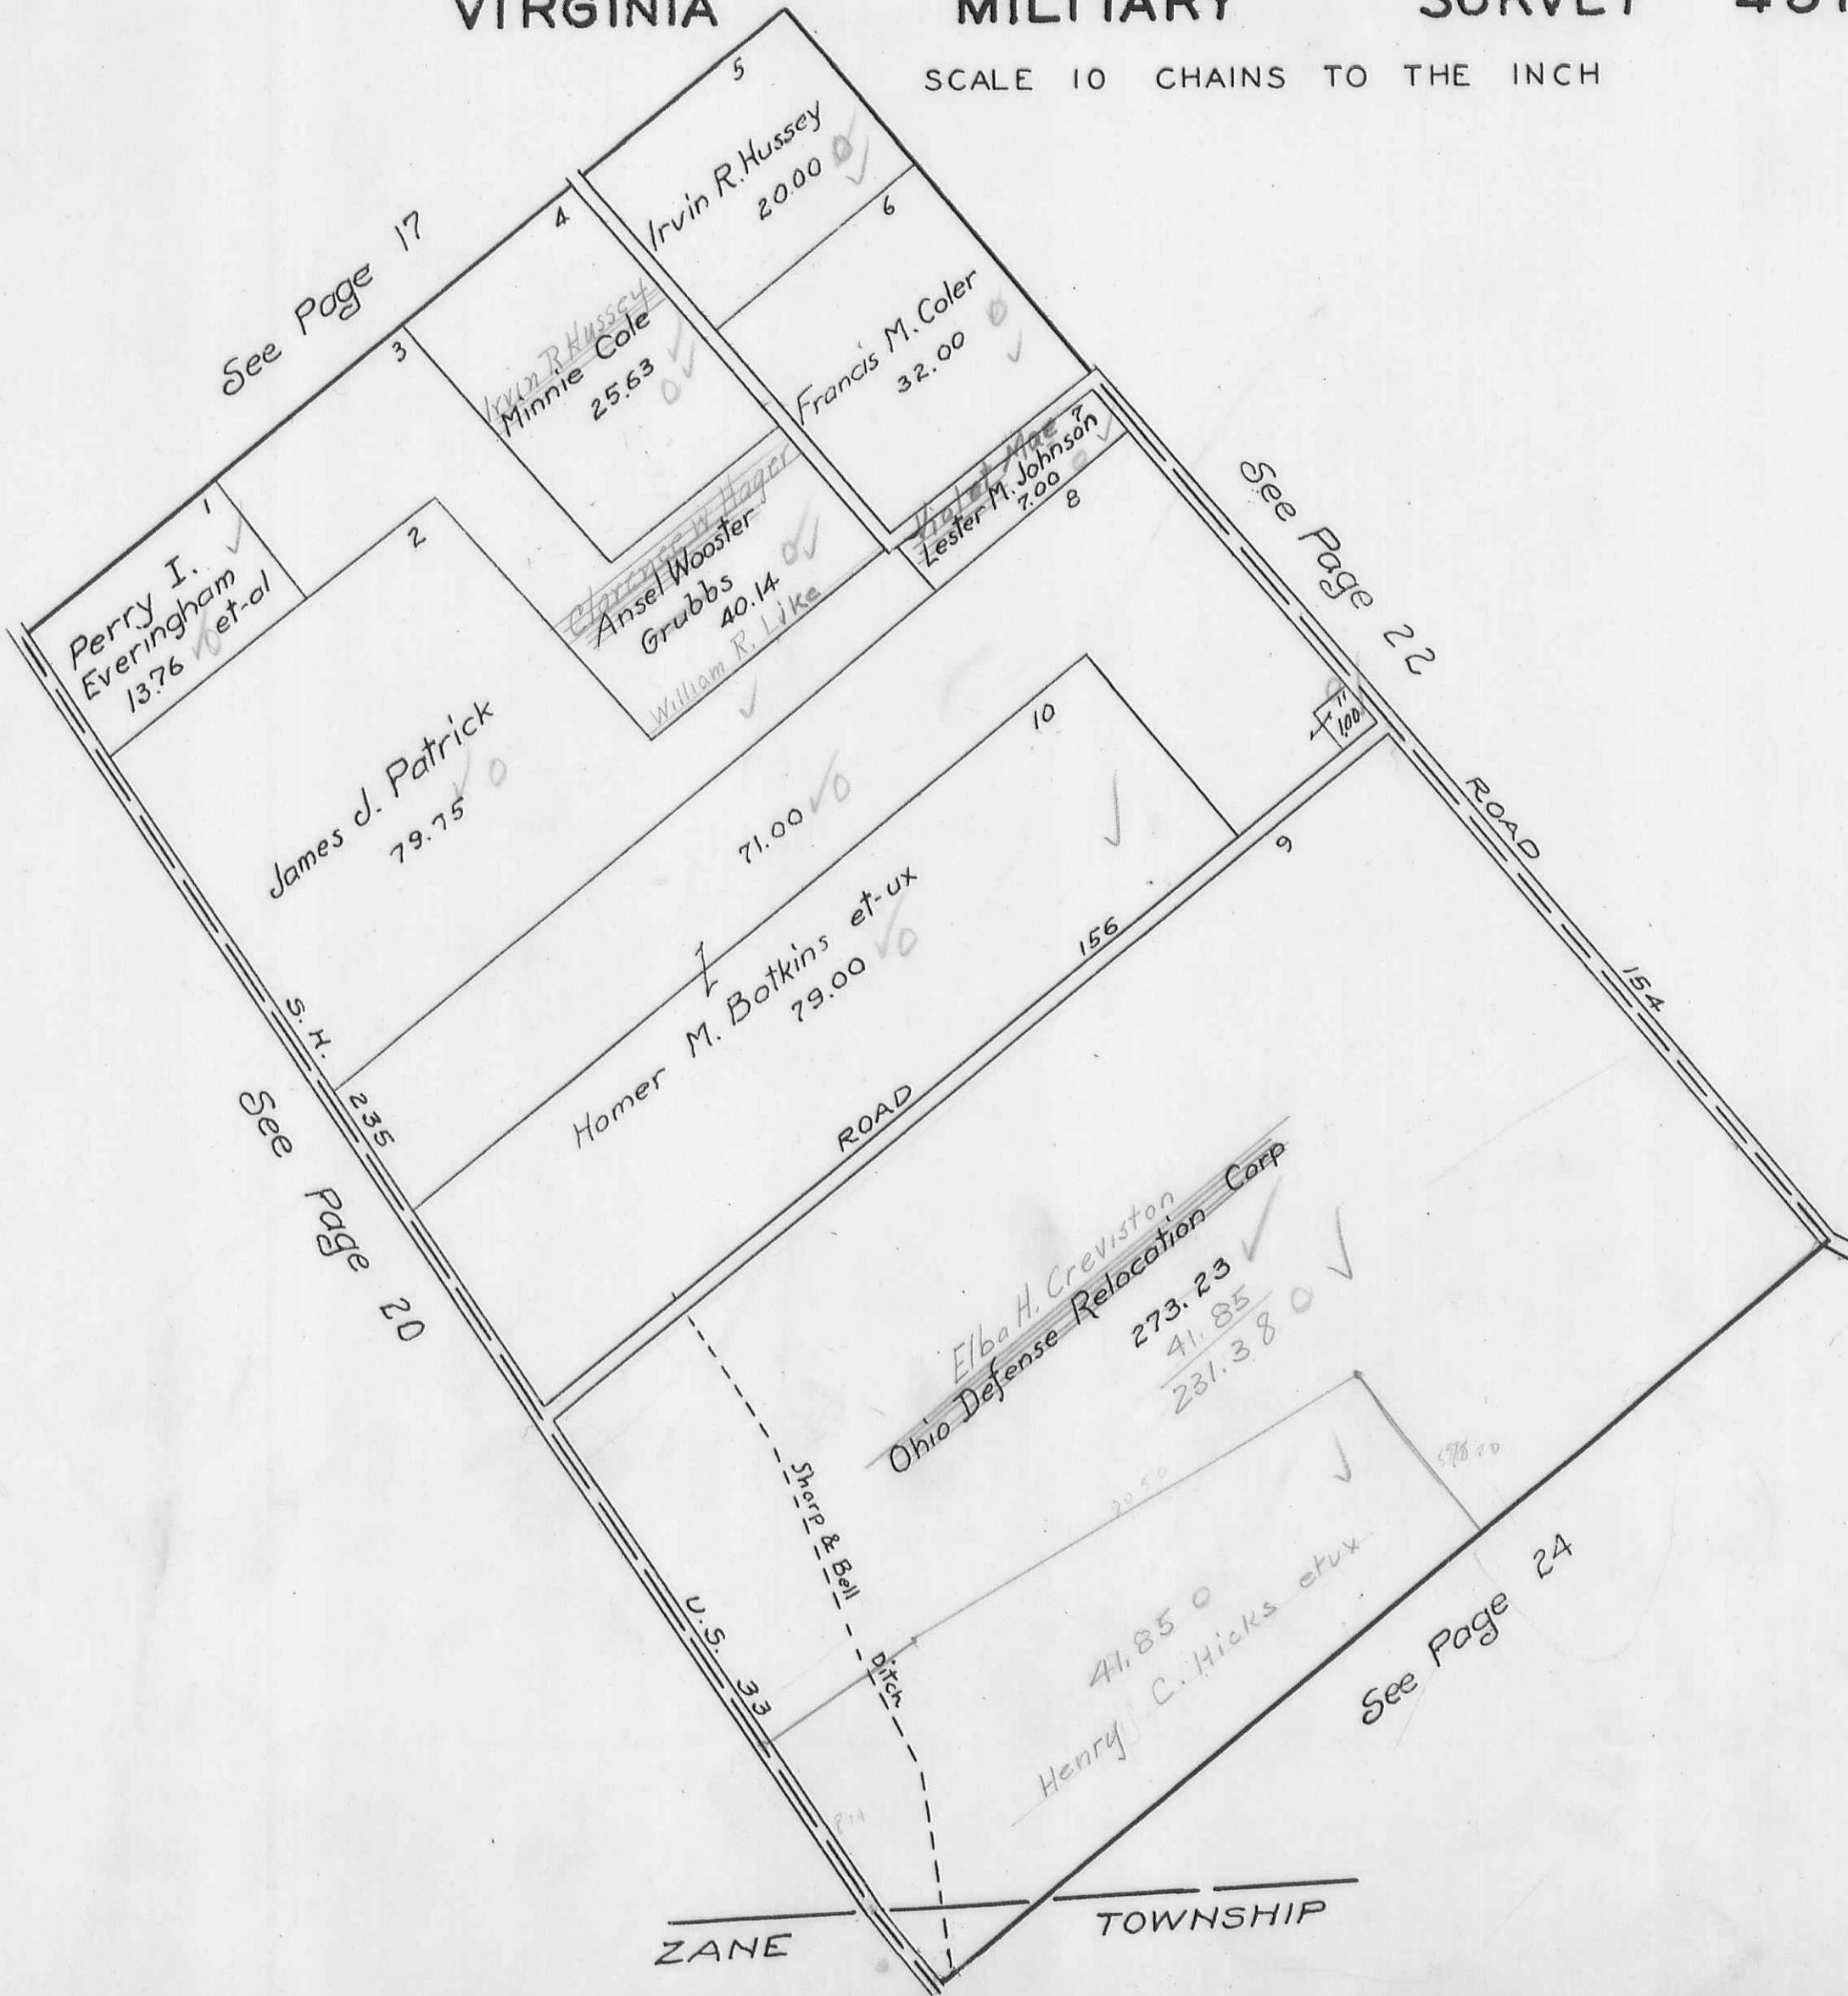


PERRY

TOWNSHIP

PAGE 22

VIRGINIA MILITARY SURVEY 5275


SCALE 10 CHAINS TO THE INCH

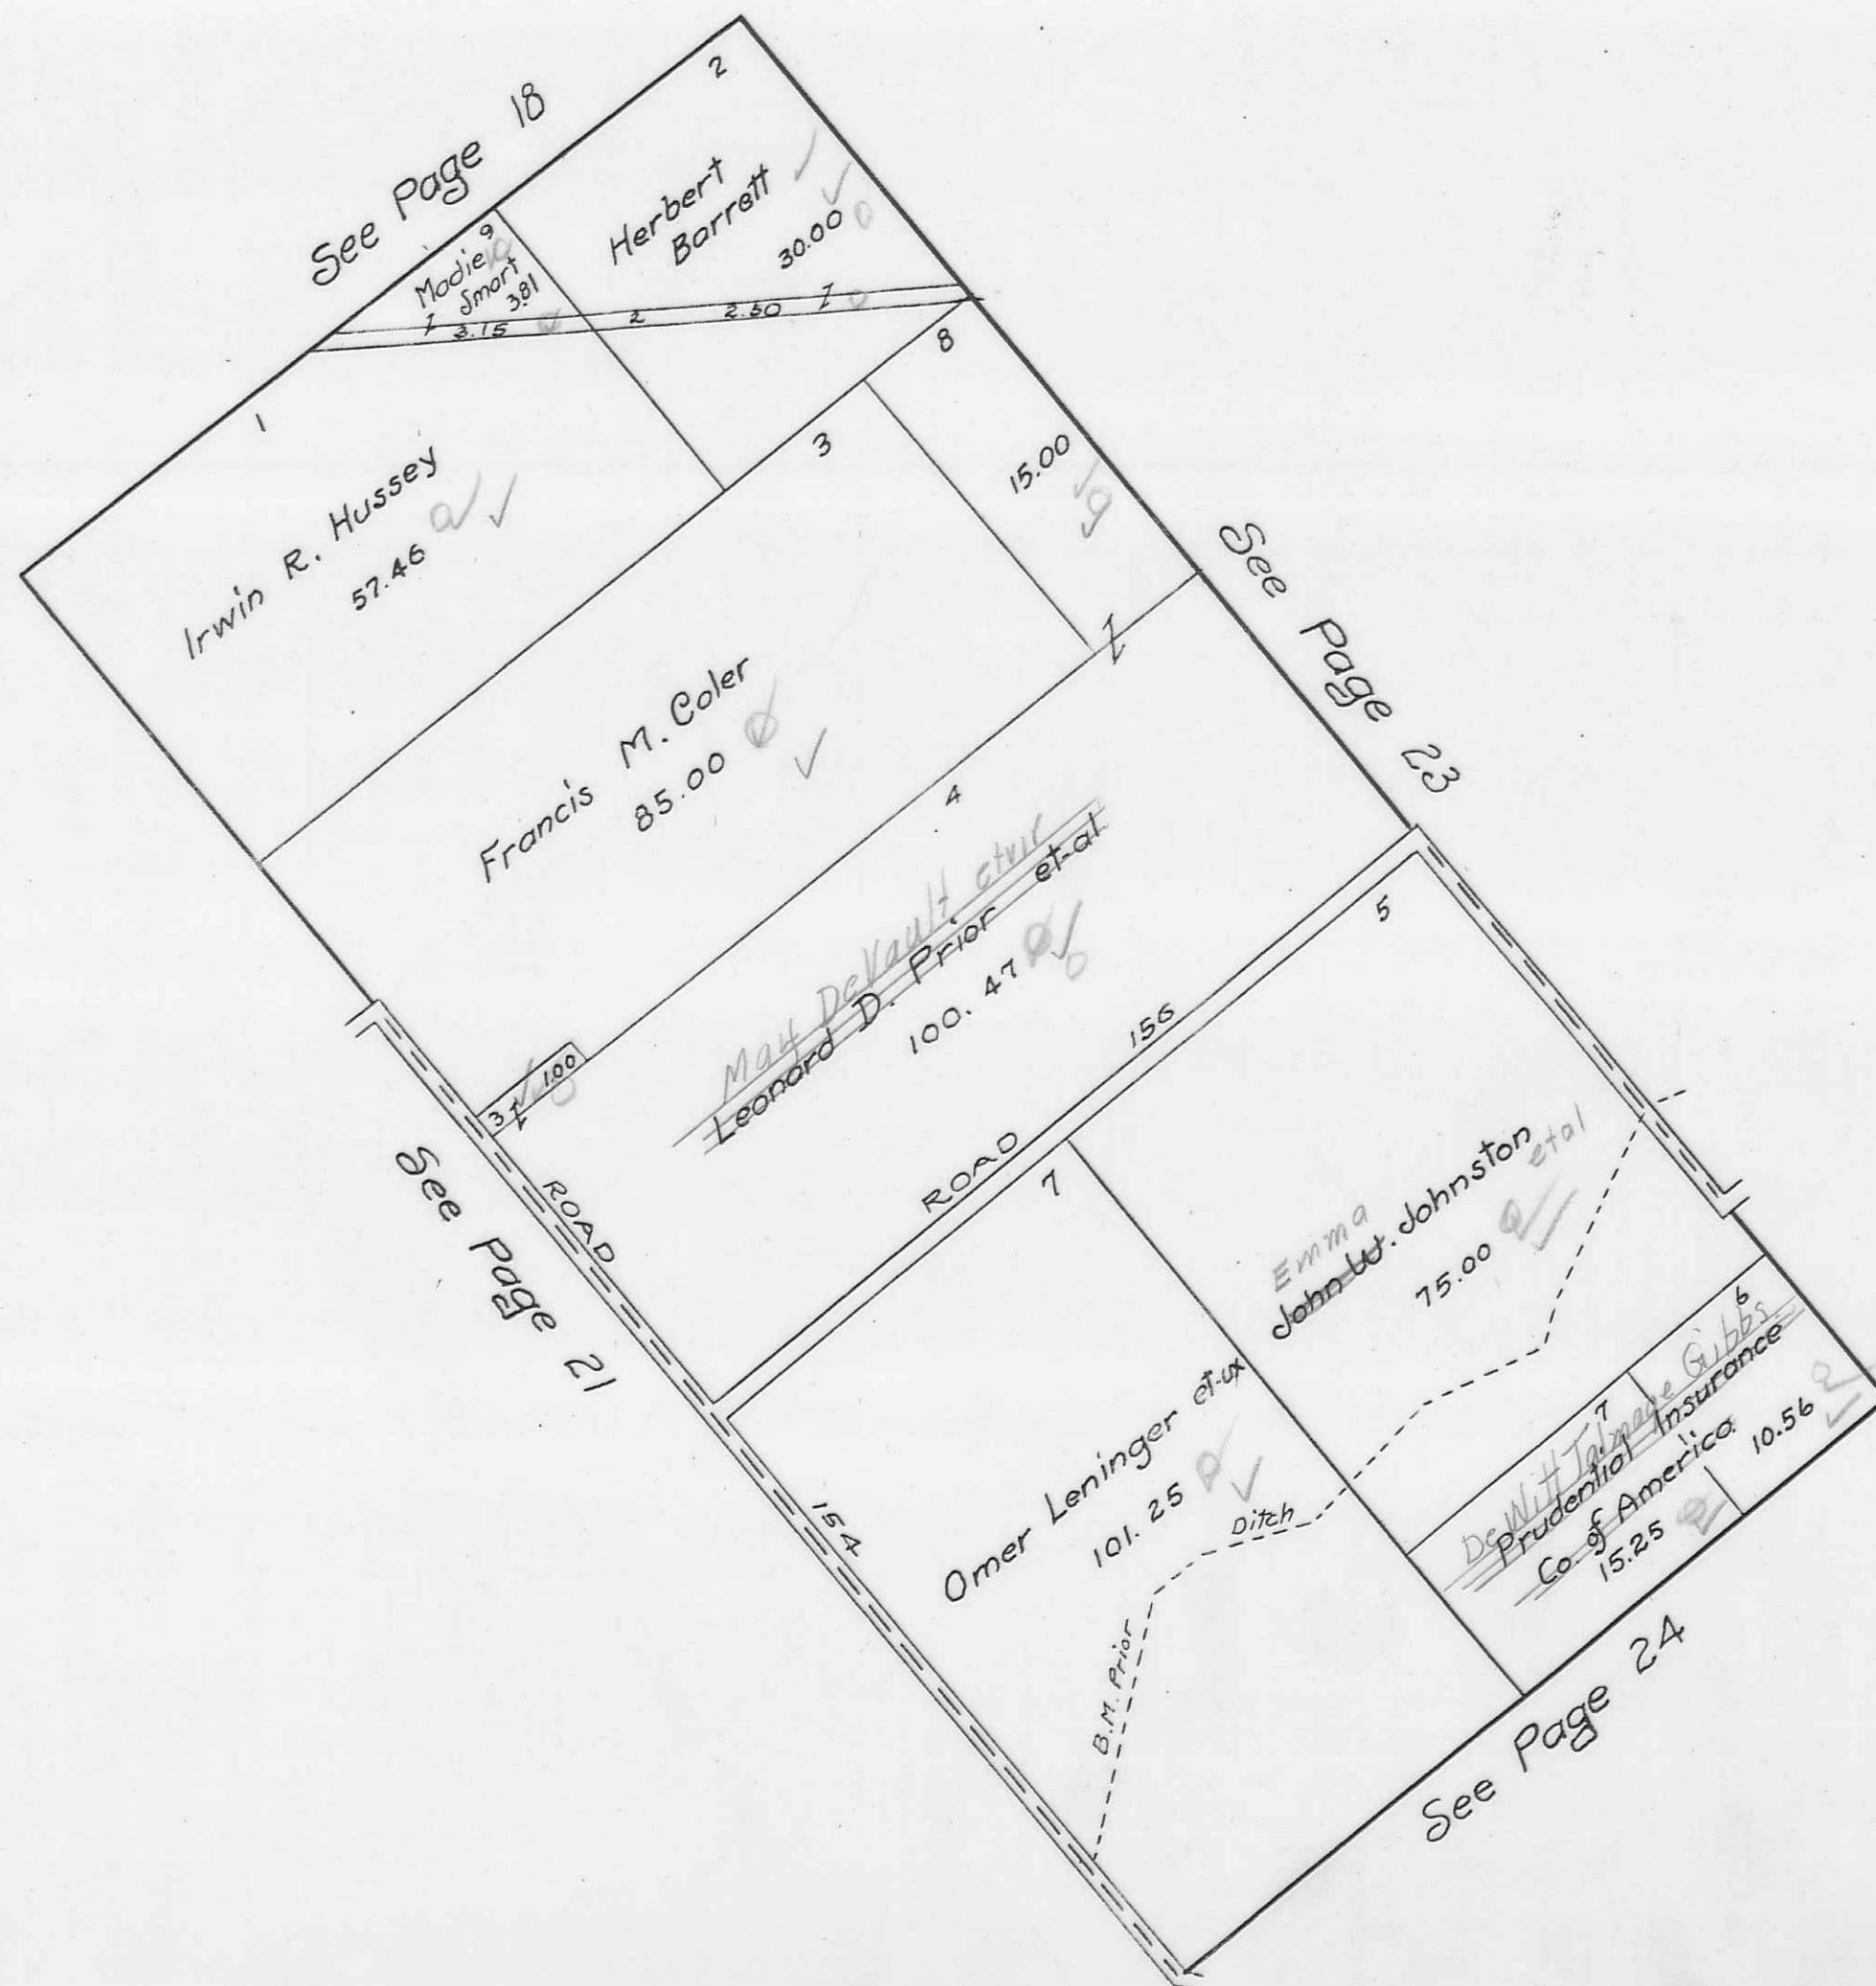

PERRY TOWNSHIP  
VIRGINIA MILITARY SURVEYS 12283  
14755

PAGE 23

SCALE 10 CHAINS TO THE INCH

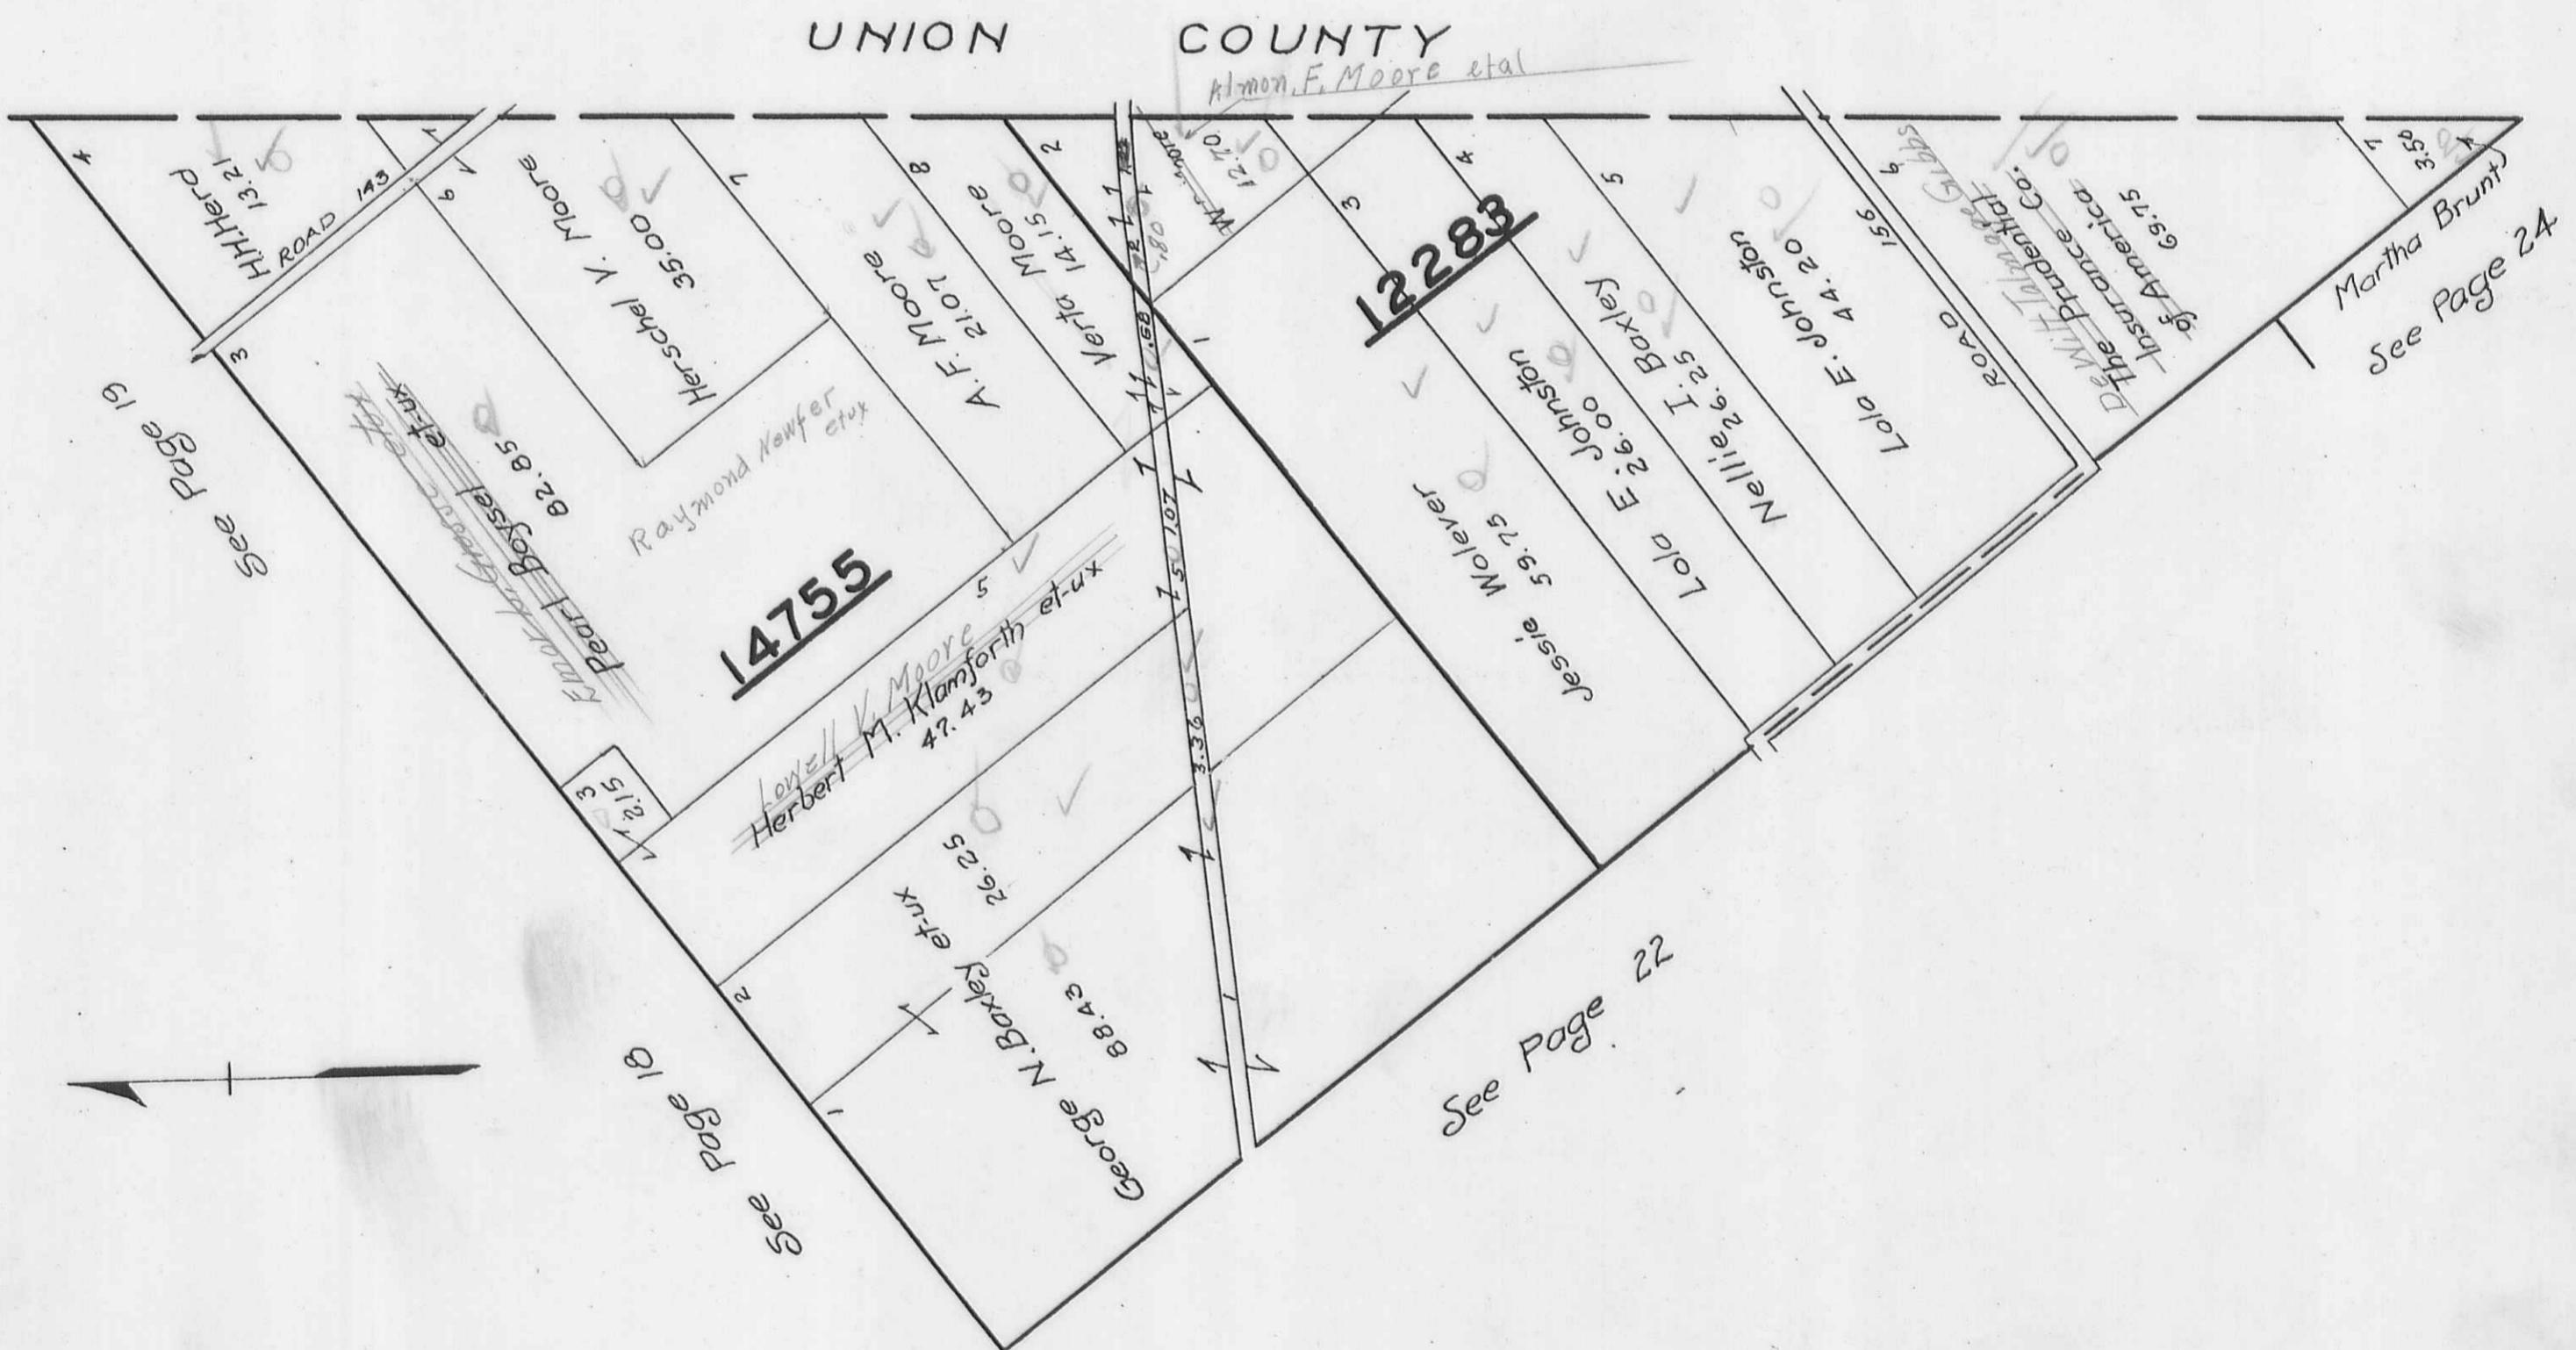

PERRY

TOWNSHIP


VIRGINIA

MILITARY SURVEYS

SCALE 10 CHAINS TO THE INCH


PAGE 24

545  
12399  
12404  
12395  
12427  
12428

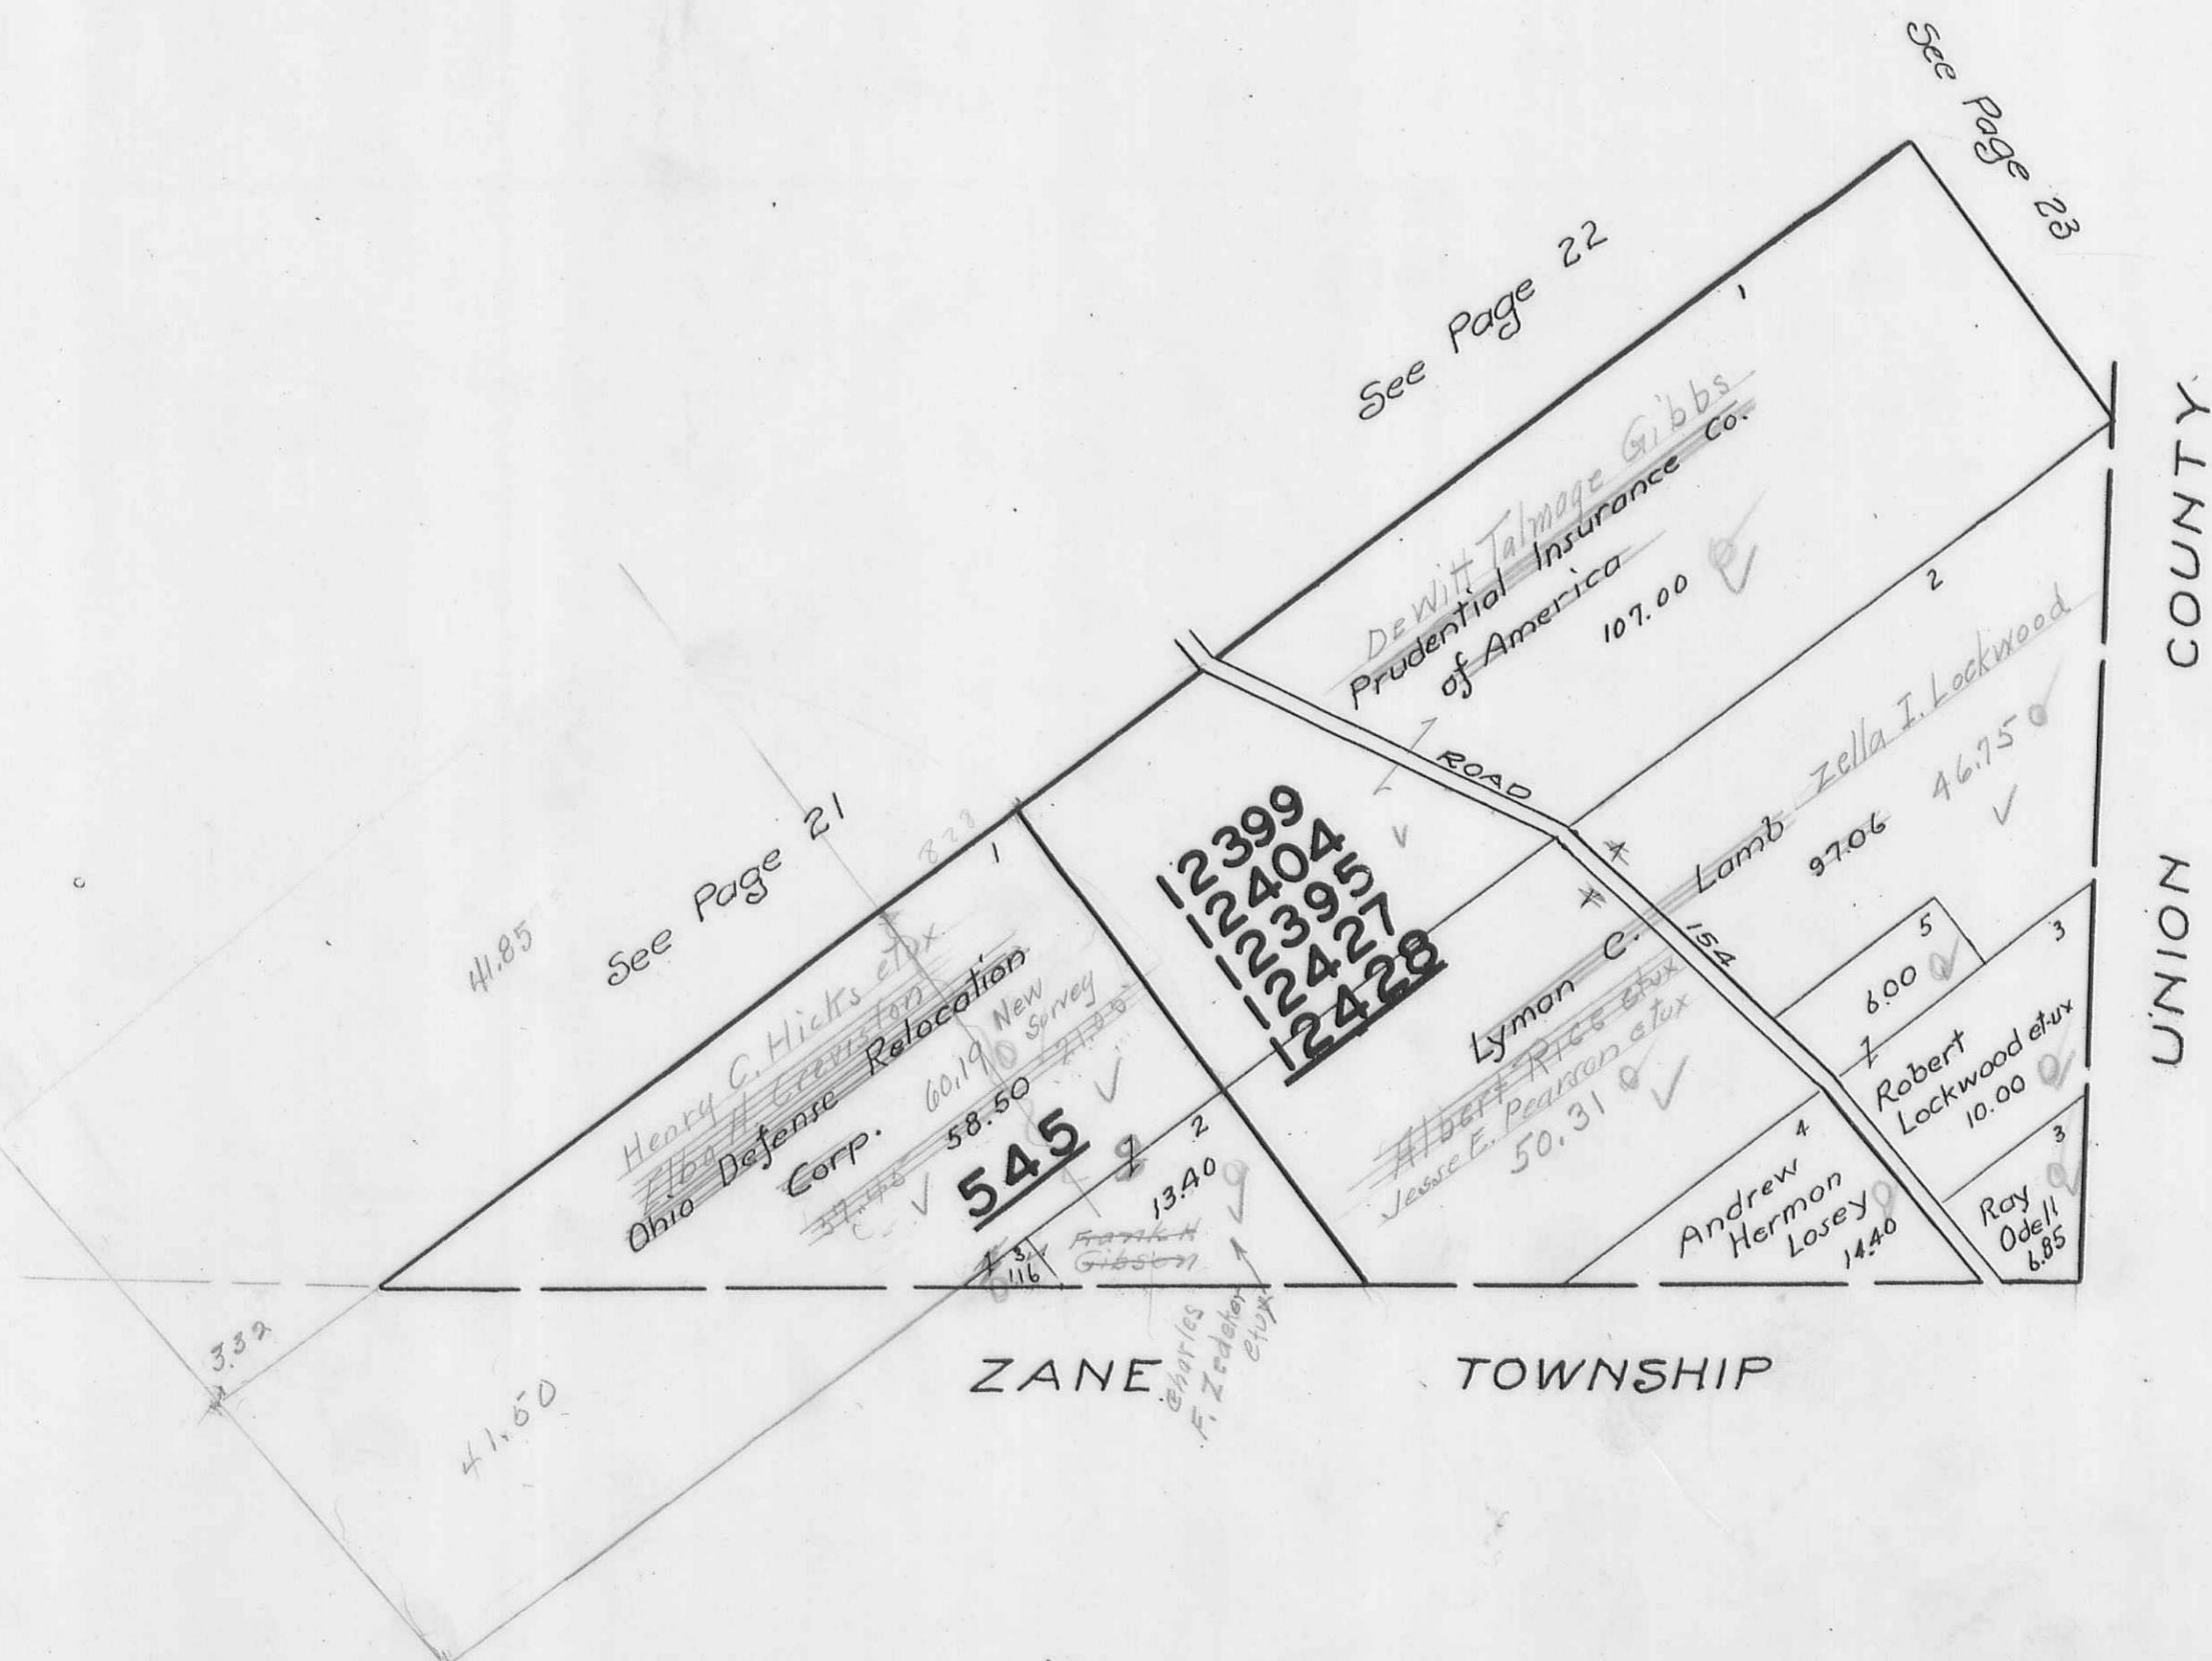

## WEST MANSFIELD CORPORATION

SCALE 300 FEET TO THE INCH

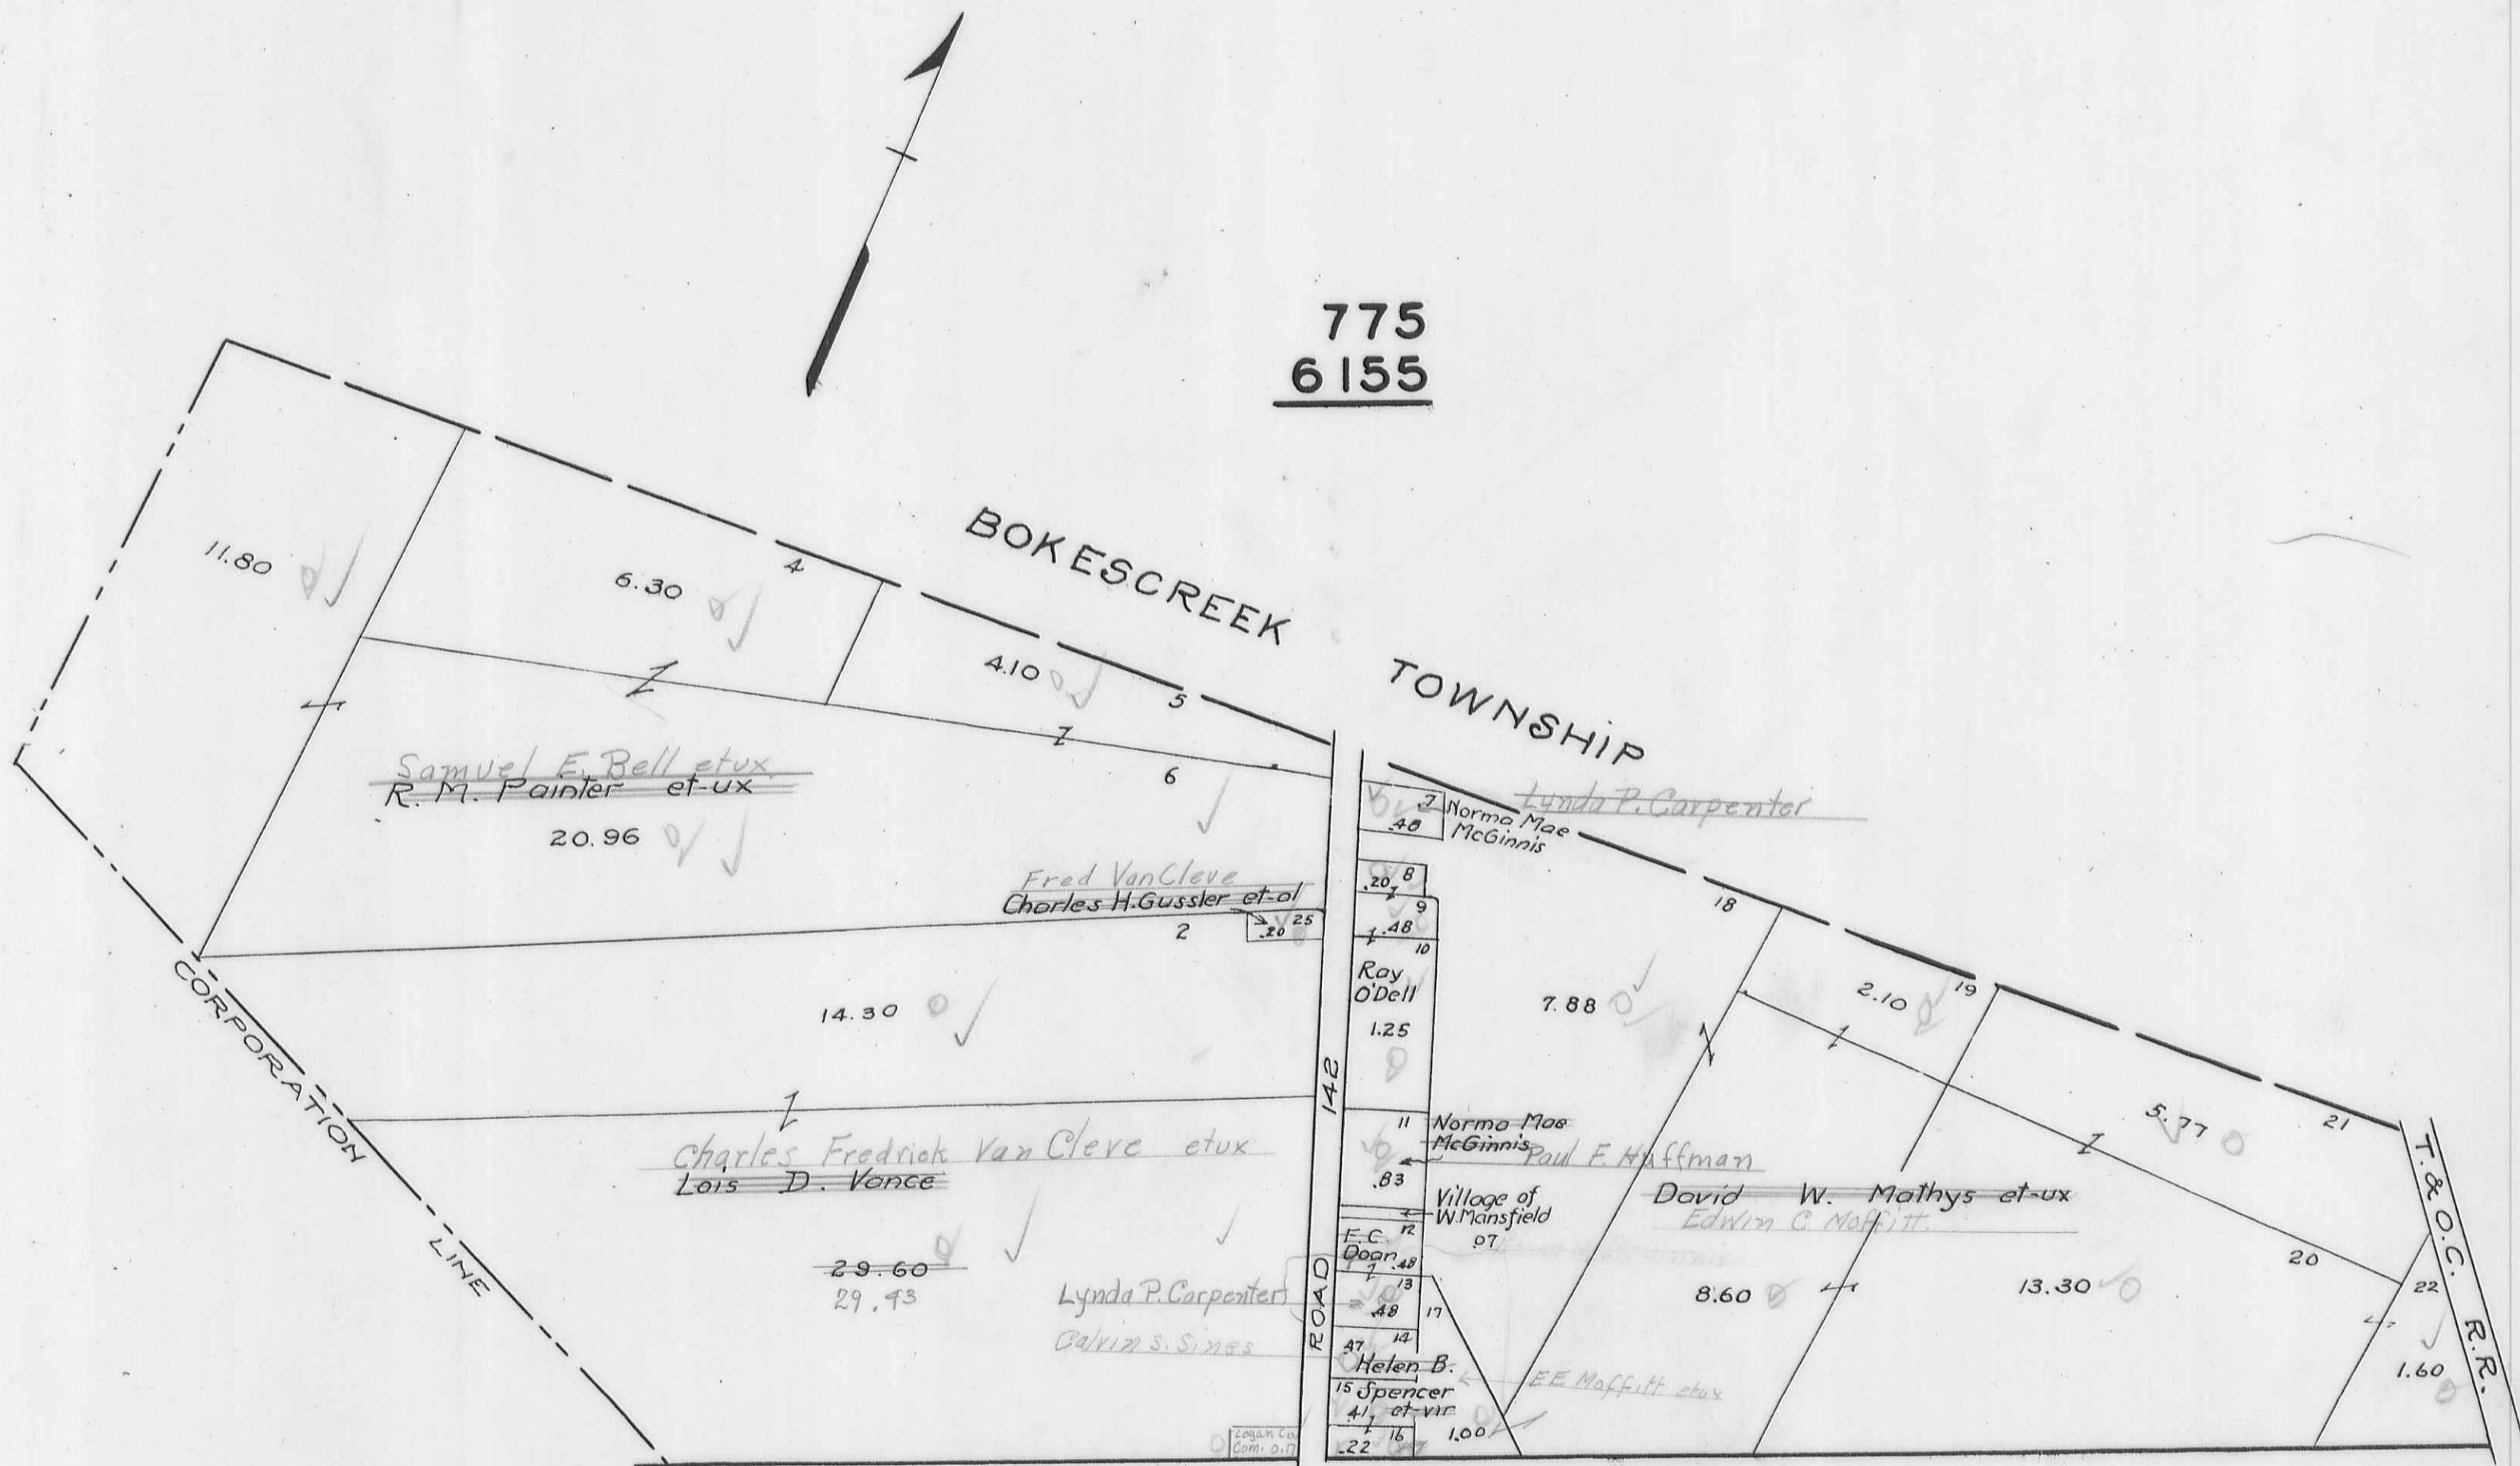


See Page 6



## NORTH WEST PART EAST LIBERTY

SCALE 200 FEET TO THE INCH

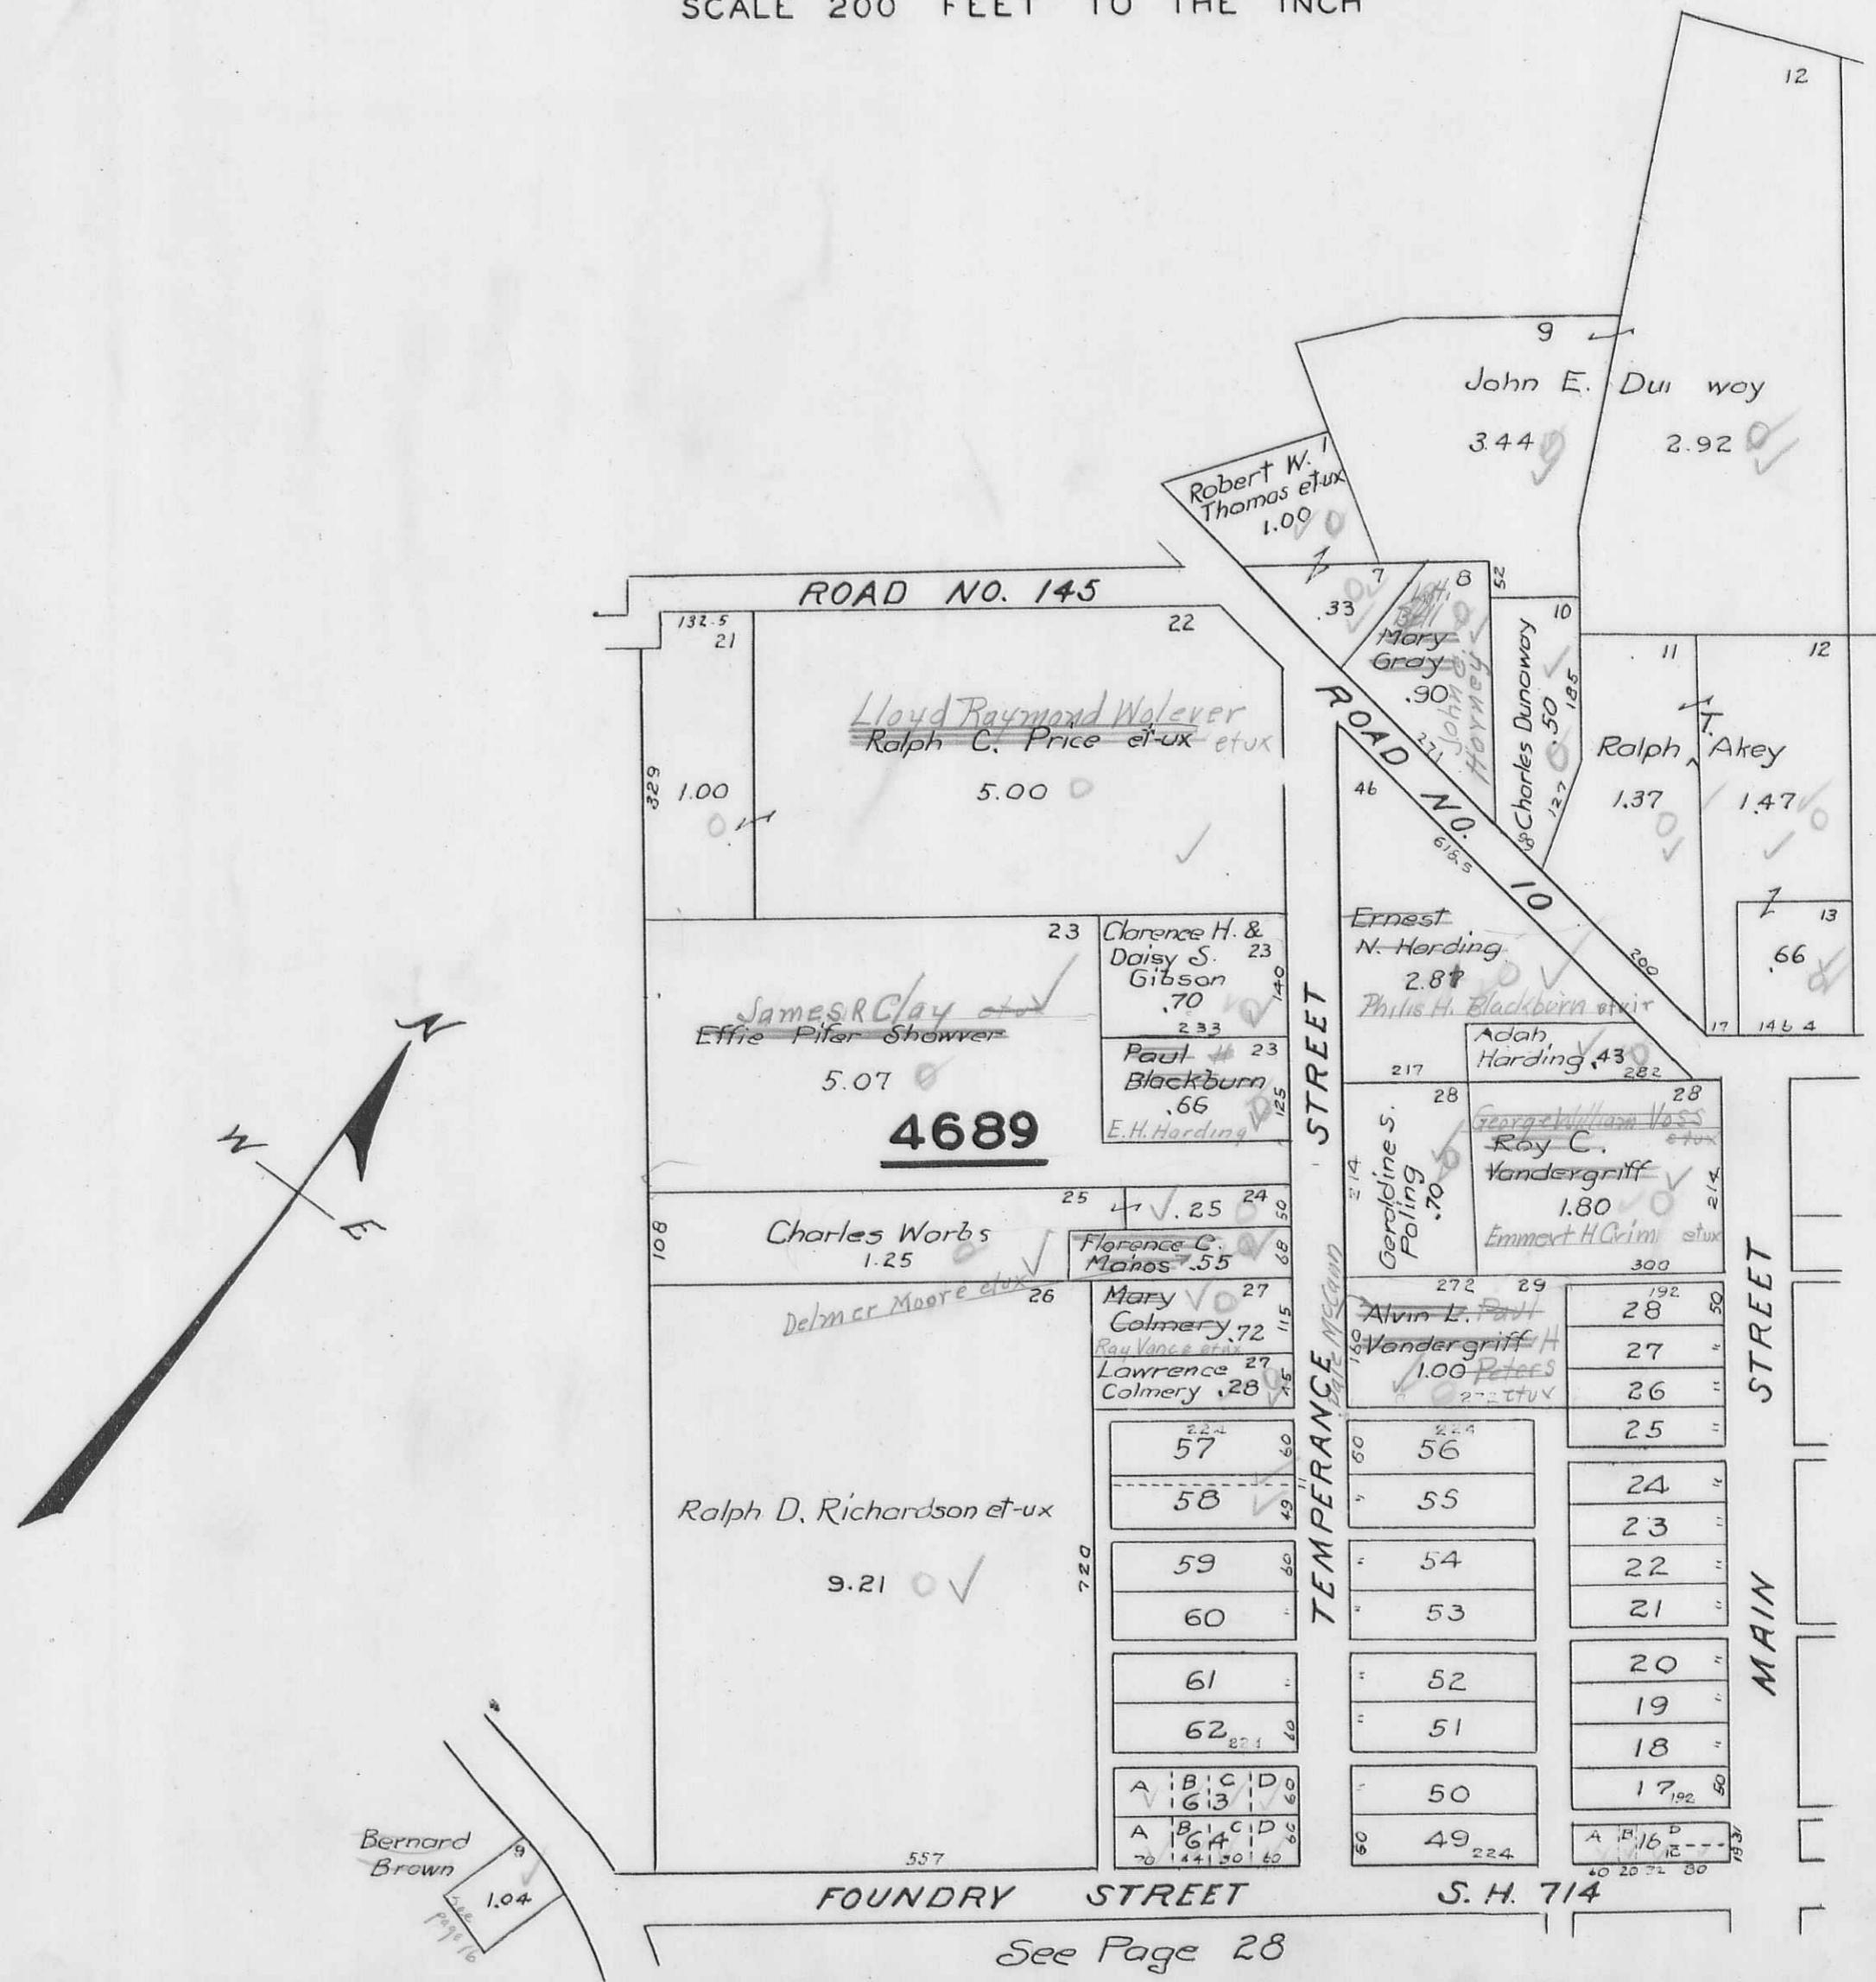

## PERRY

## TOWNSHIP


## SOUTH PART EAST LIBERTY

SCALE 200 FEET TO THE INCH

See Page 26

PAGE 28

See Page 27

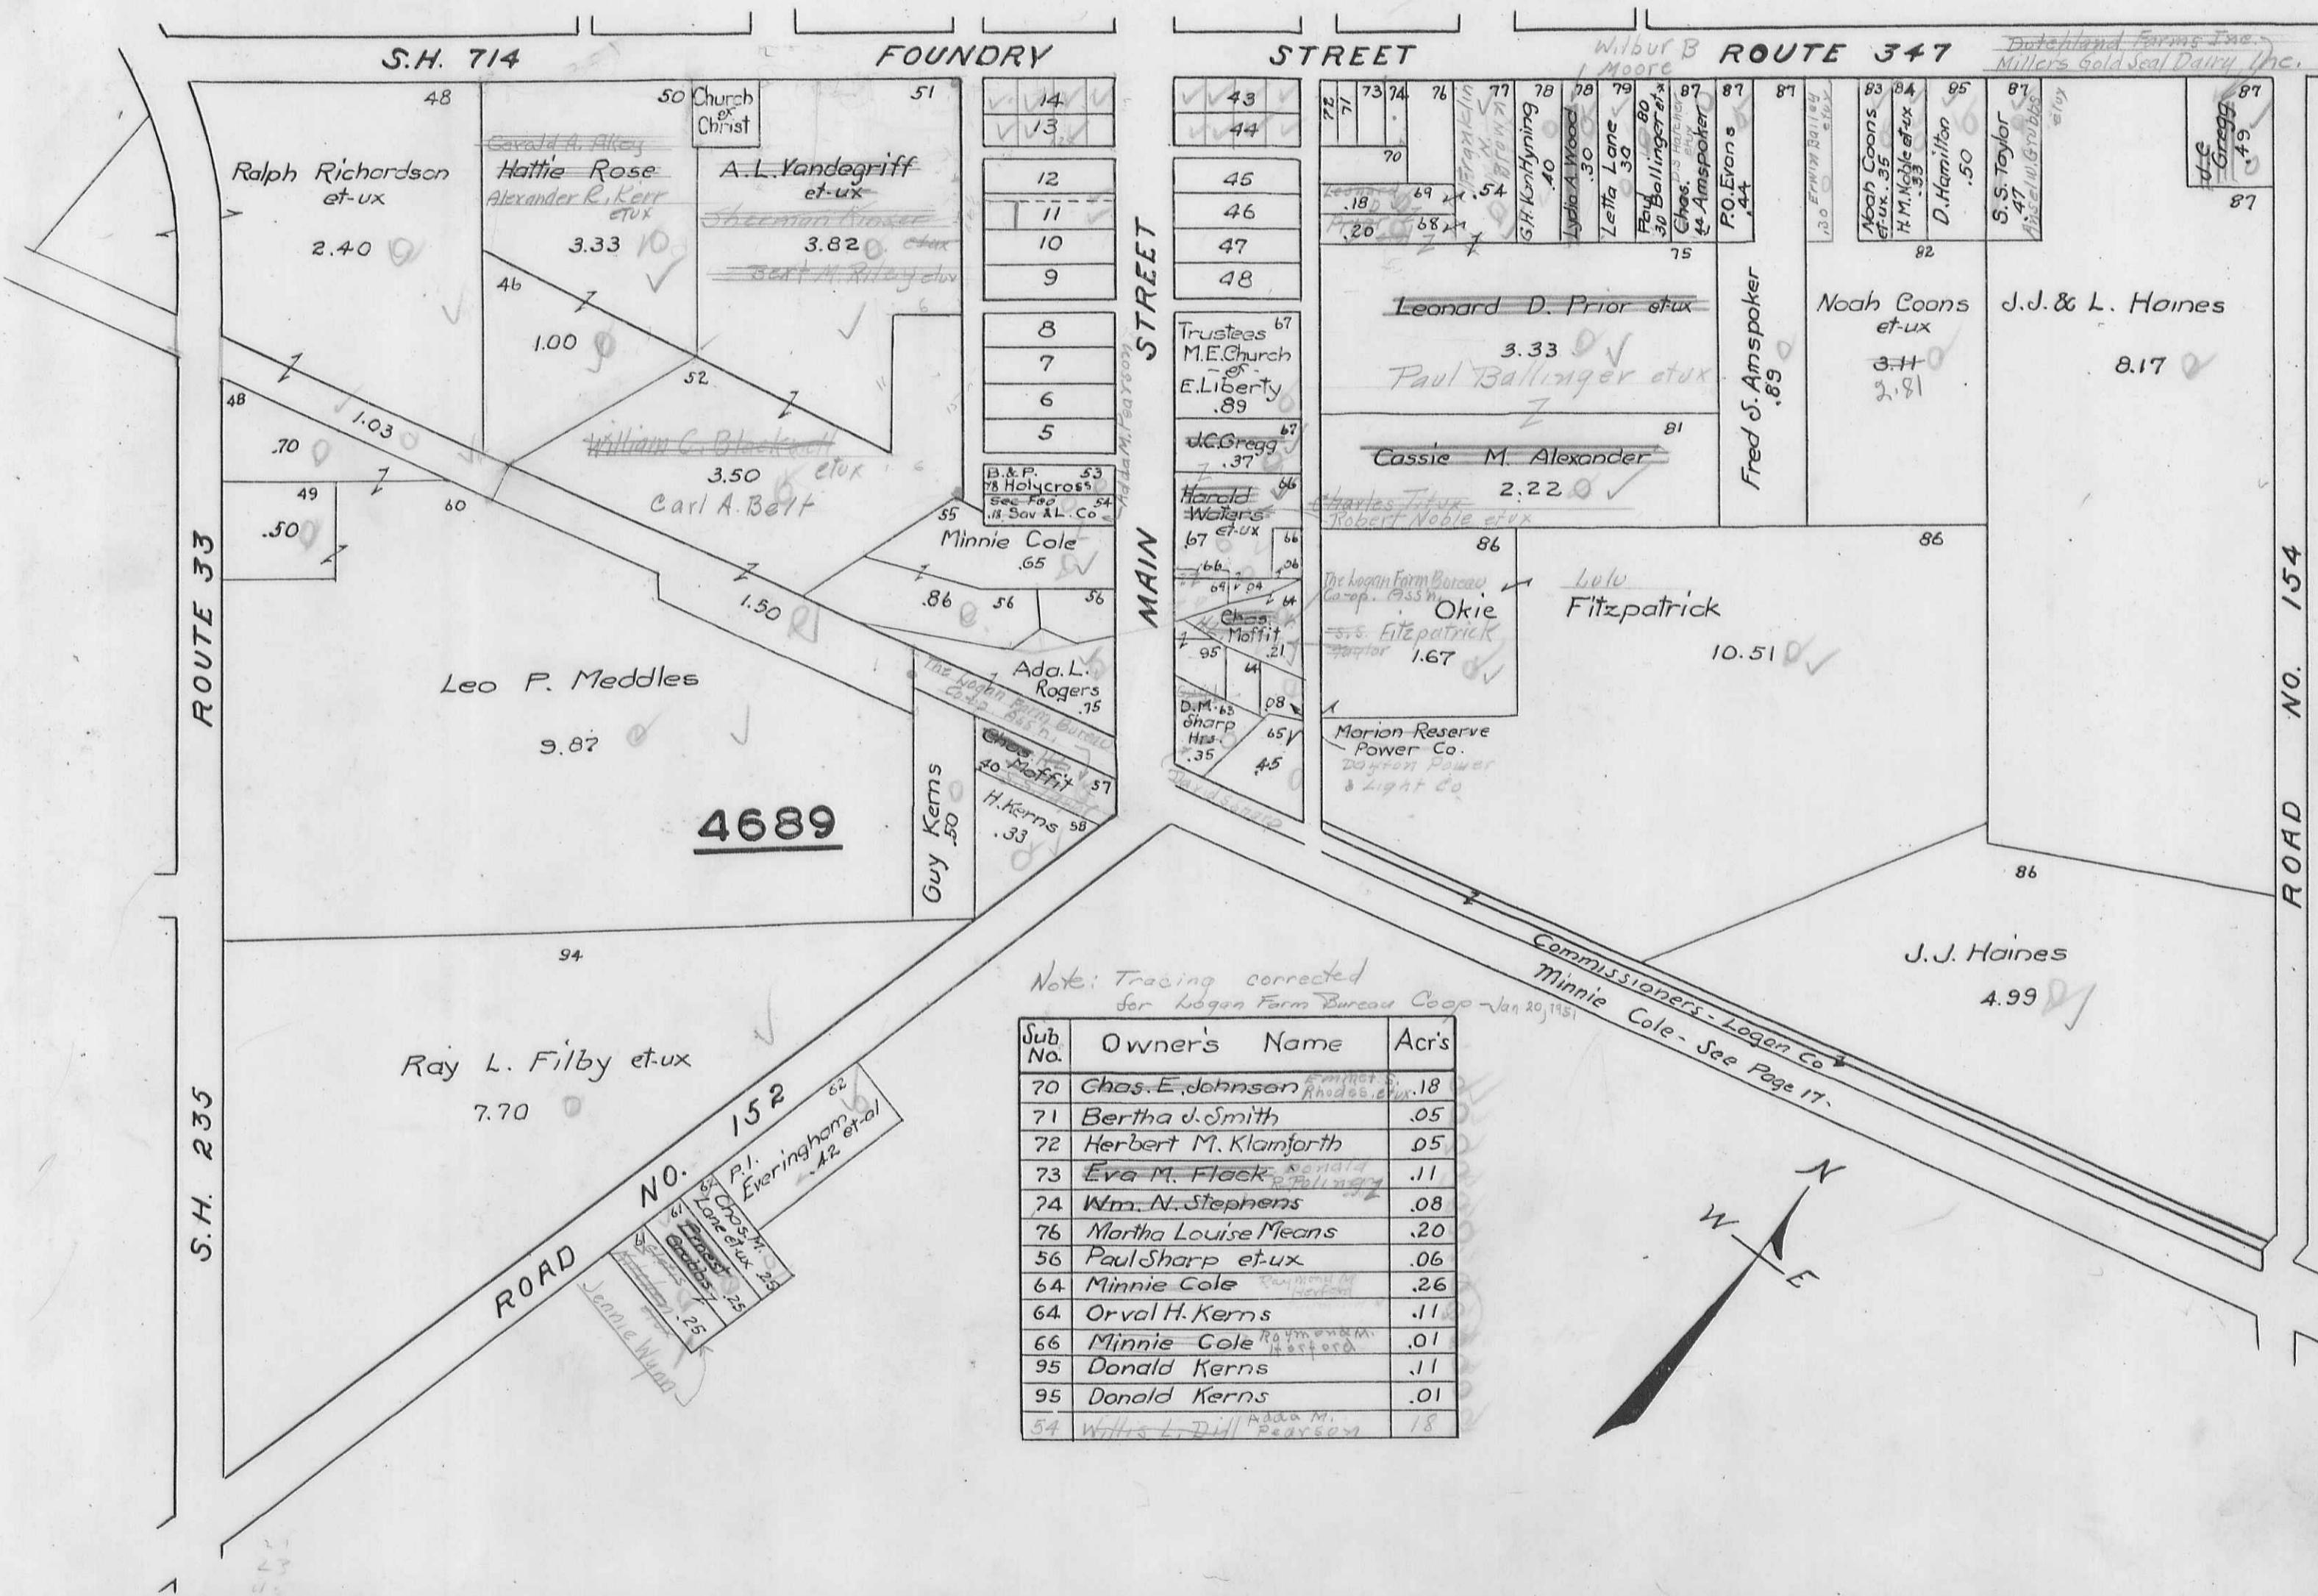

PERRY

TOWNSHIP

PAGE 29

VIRGINIA MILITARY SURVEY 4210  
GREENFIELD

SCALE 150 FEET TO THE INCH

