

BOKESCREEK

TOWNSHIP

1951

INDEX

MAP

VIRGINIA MILITARY SURVEYS	PAGE
9978	1
10239	2
10239	3
12280	3
10837	4
13593	4
14530	4
16070	4
10387	4
10388	4
9958	5
9959	6
9960	6
10042	6
9937	7
9938	8
10060	9
12112	10
7161	10
9912	11
9913	12
9914	13
9915	14
9890	15
9891	16
9892	17
9893	18
13646	19
3472	19
5288	19
5288	20
842	20
7995	21
6154	22
6154	23
6251	24
13068	24
6155	25
775	25
10239	26
10239	27
6155	28-29-30-31
755	28-29-30-31

BOKE SCREEK TOWNSHIP

VIRGINIA MILITARY SURVEYS


INDEX

MAP

CORRECTED TO
January 1, 1955
January 1, 1956
January 1, 1957
January 1, 1958




UNION COUNTY

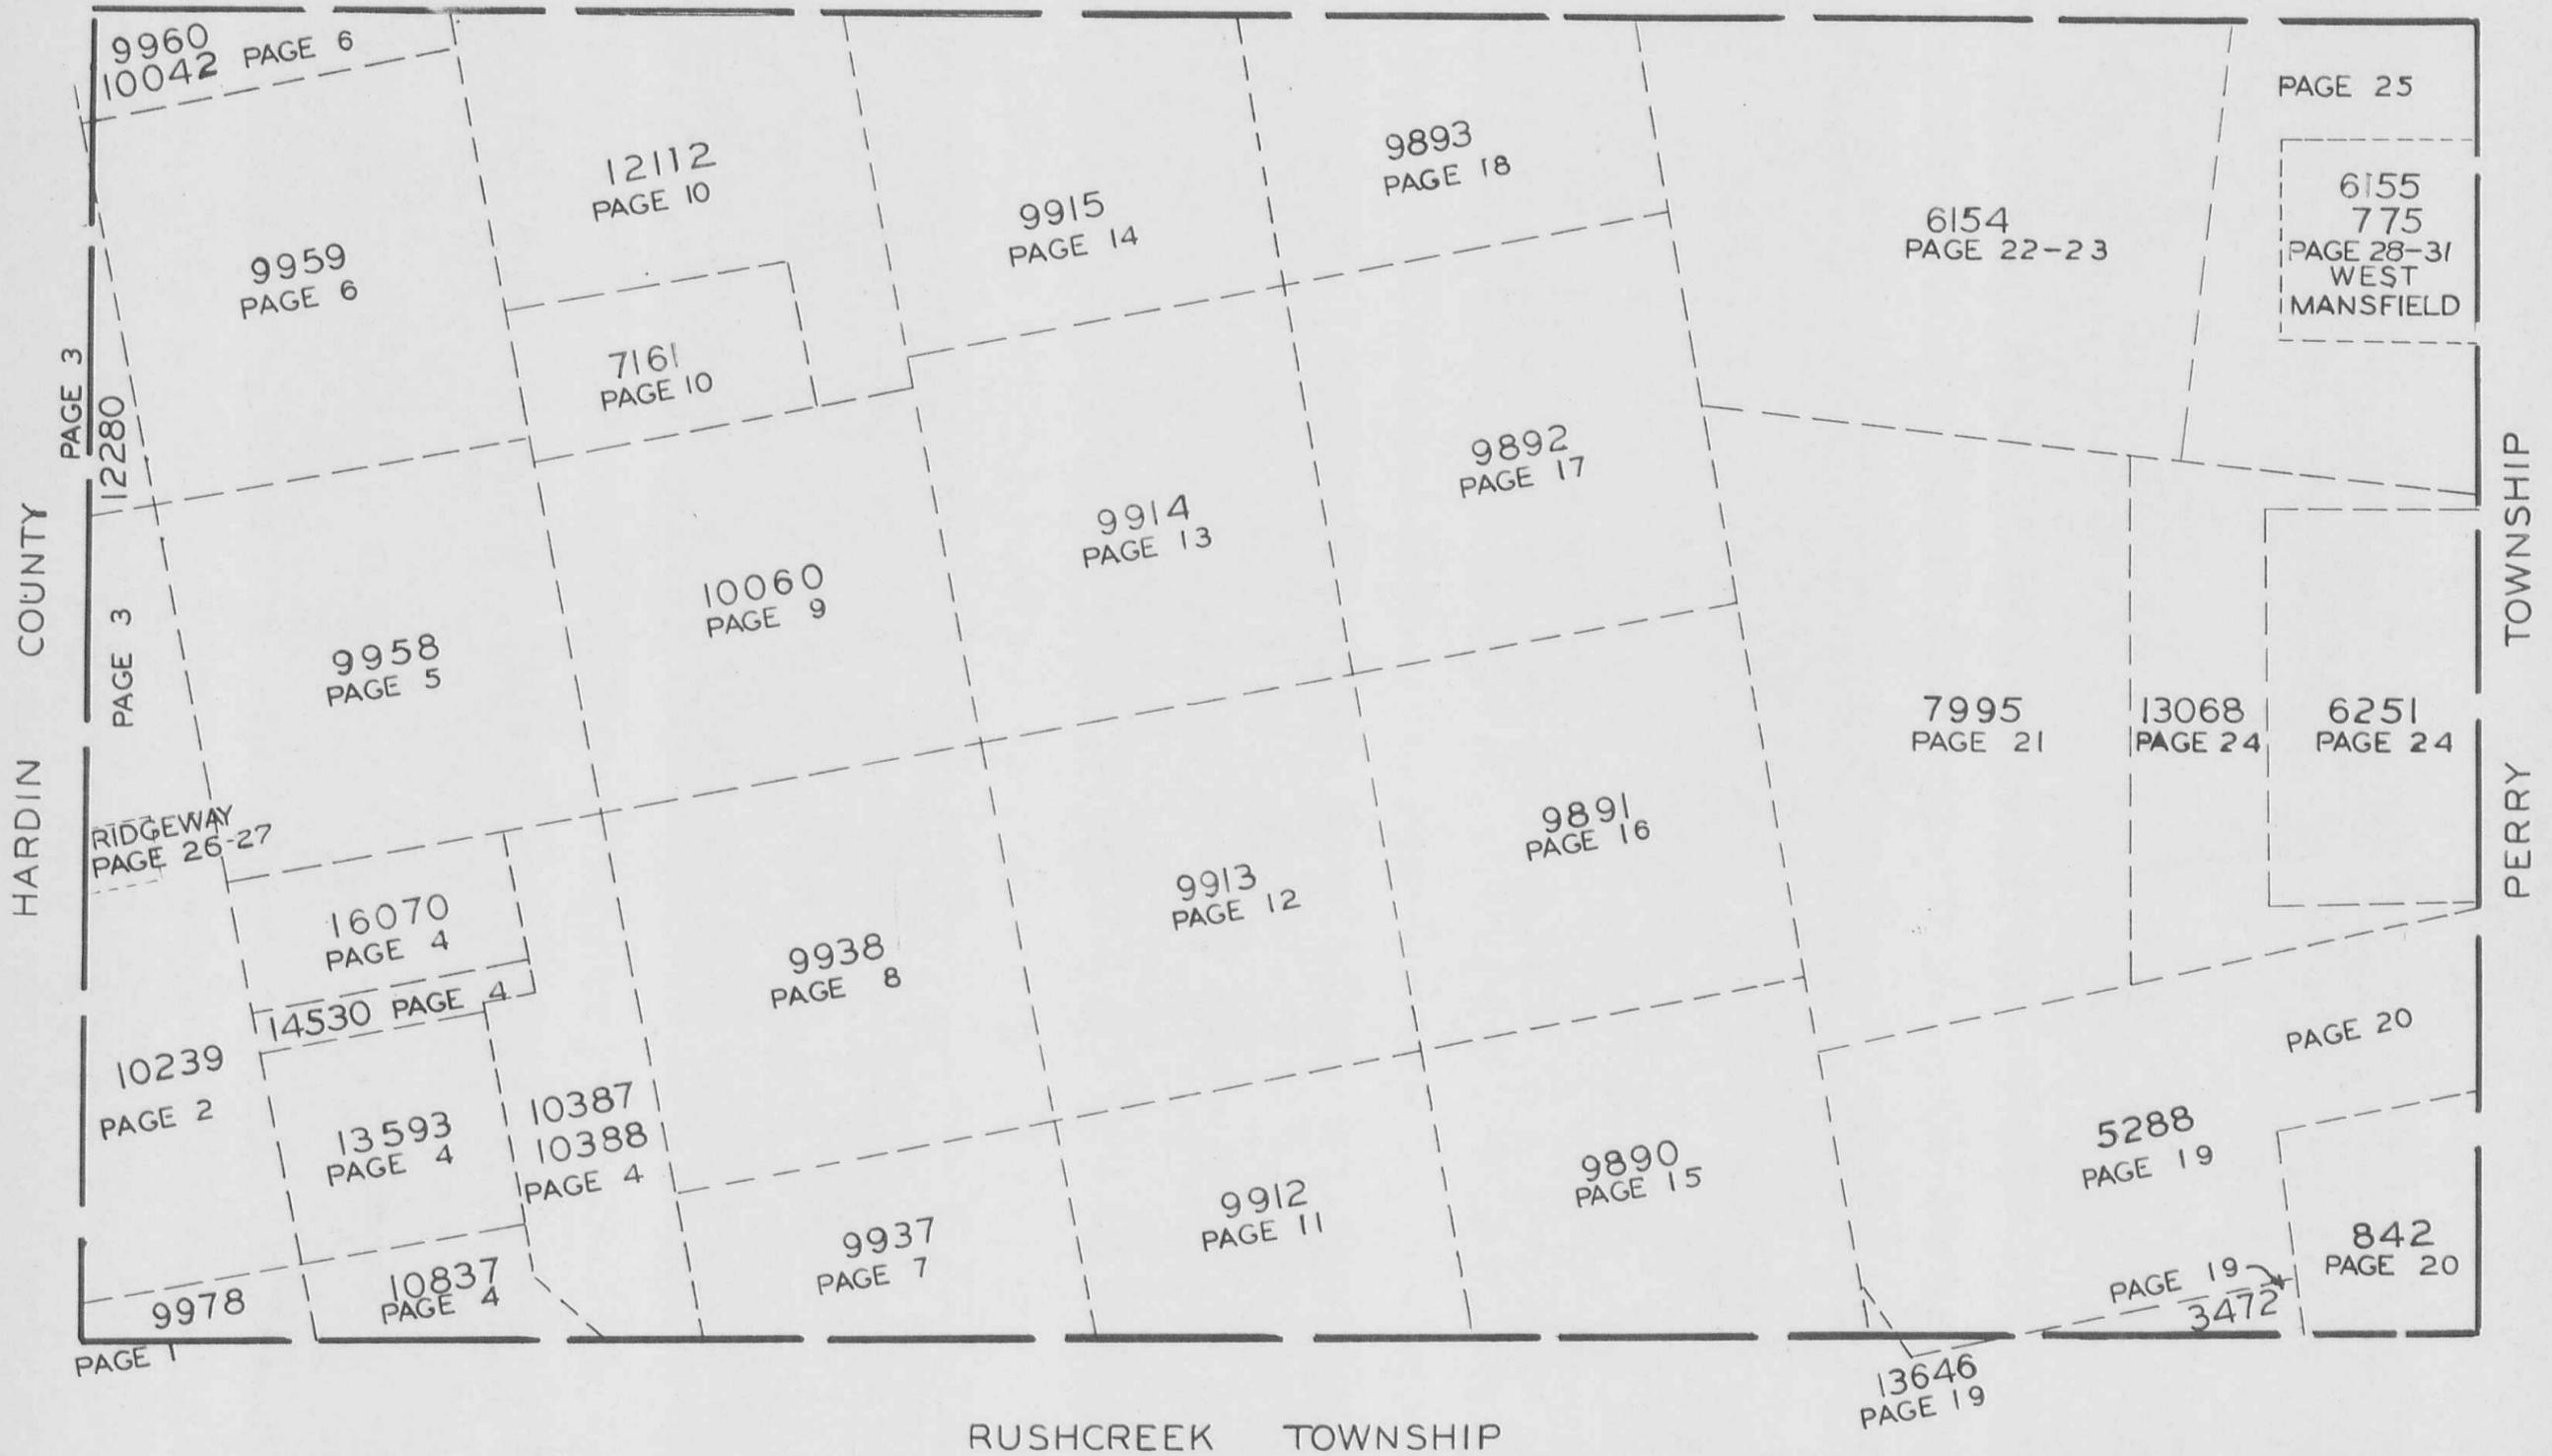

BOKESCREEK TOWNSHIP


VIRGINIA MILITARY SURVEY 9978

SCALE 10 CHAINS TO THE INCH

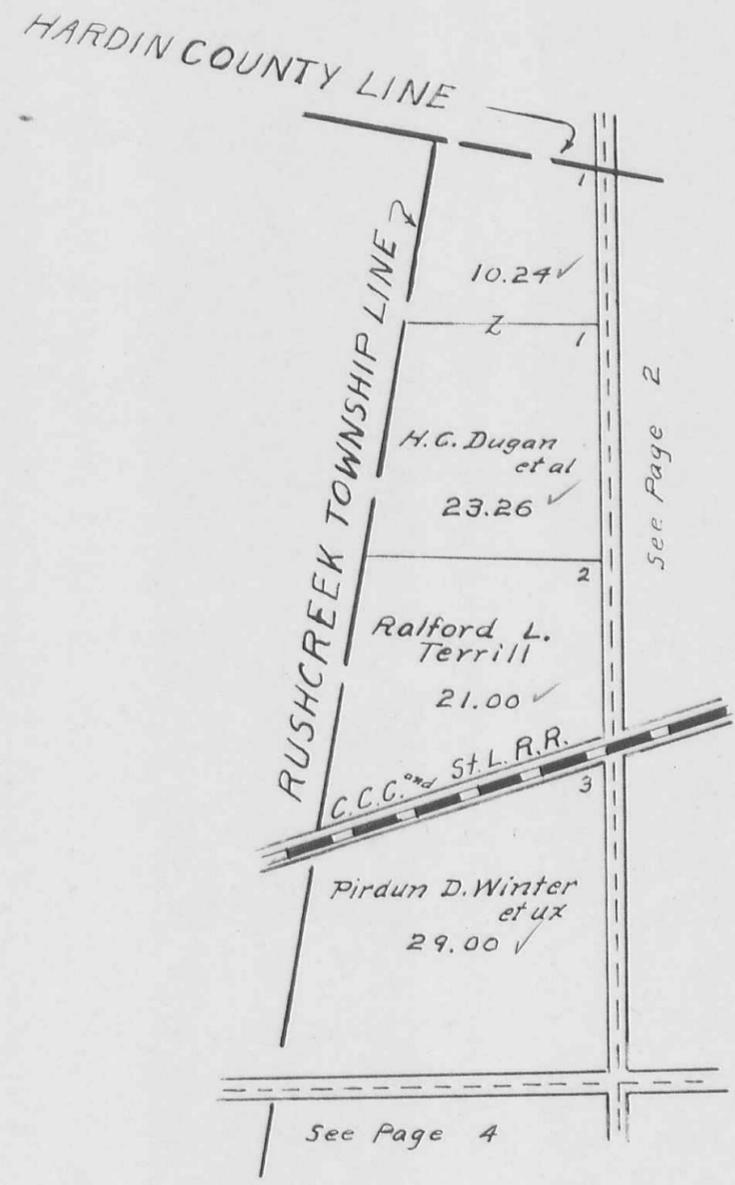


VIRGINIA MILITARY SURVEY 10239

SCALE 10 CHAINS TO THE INCH

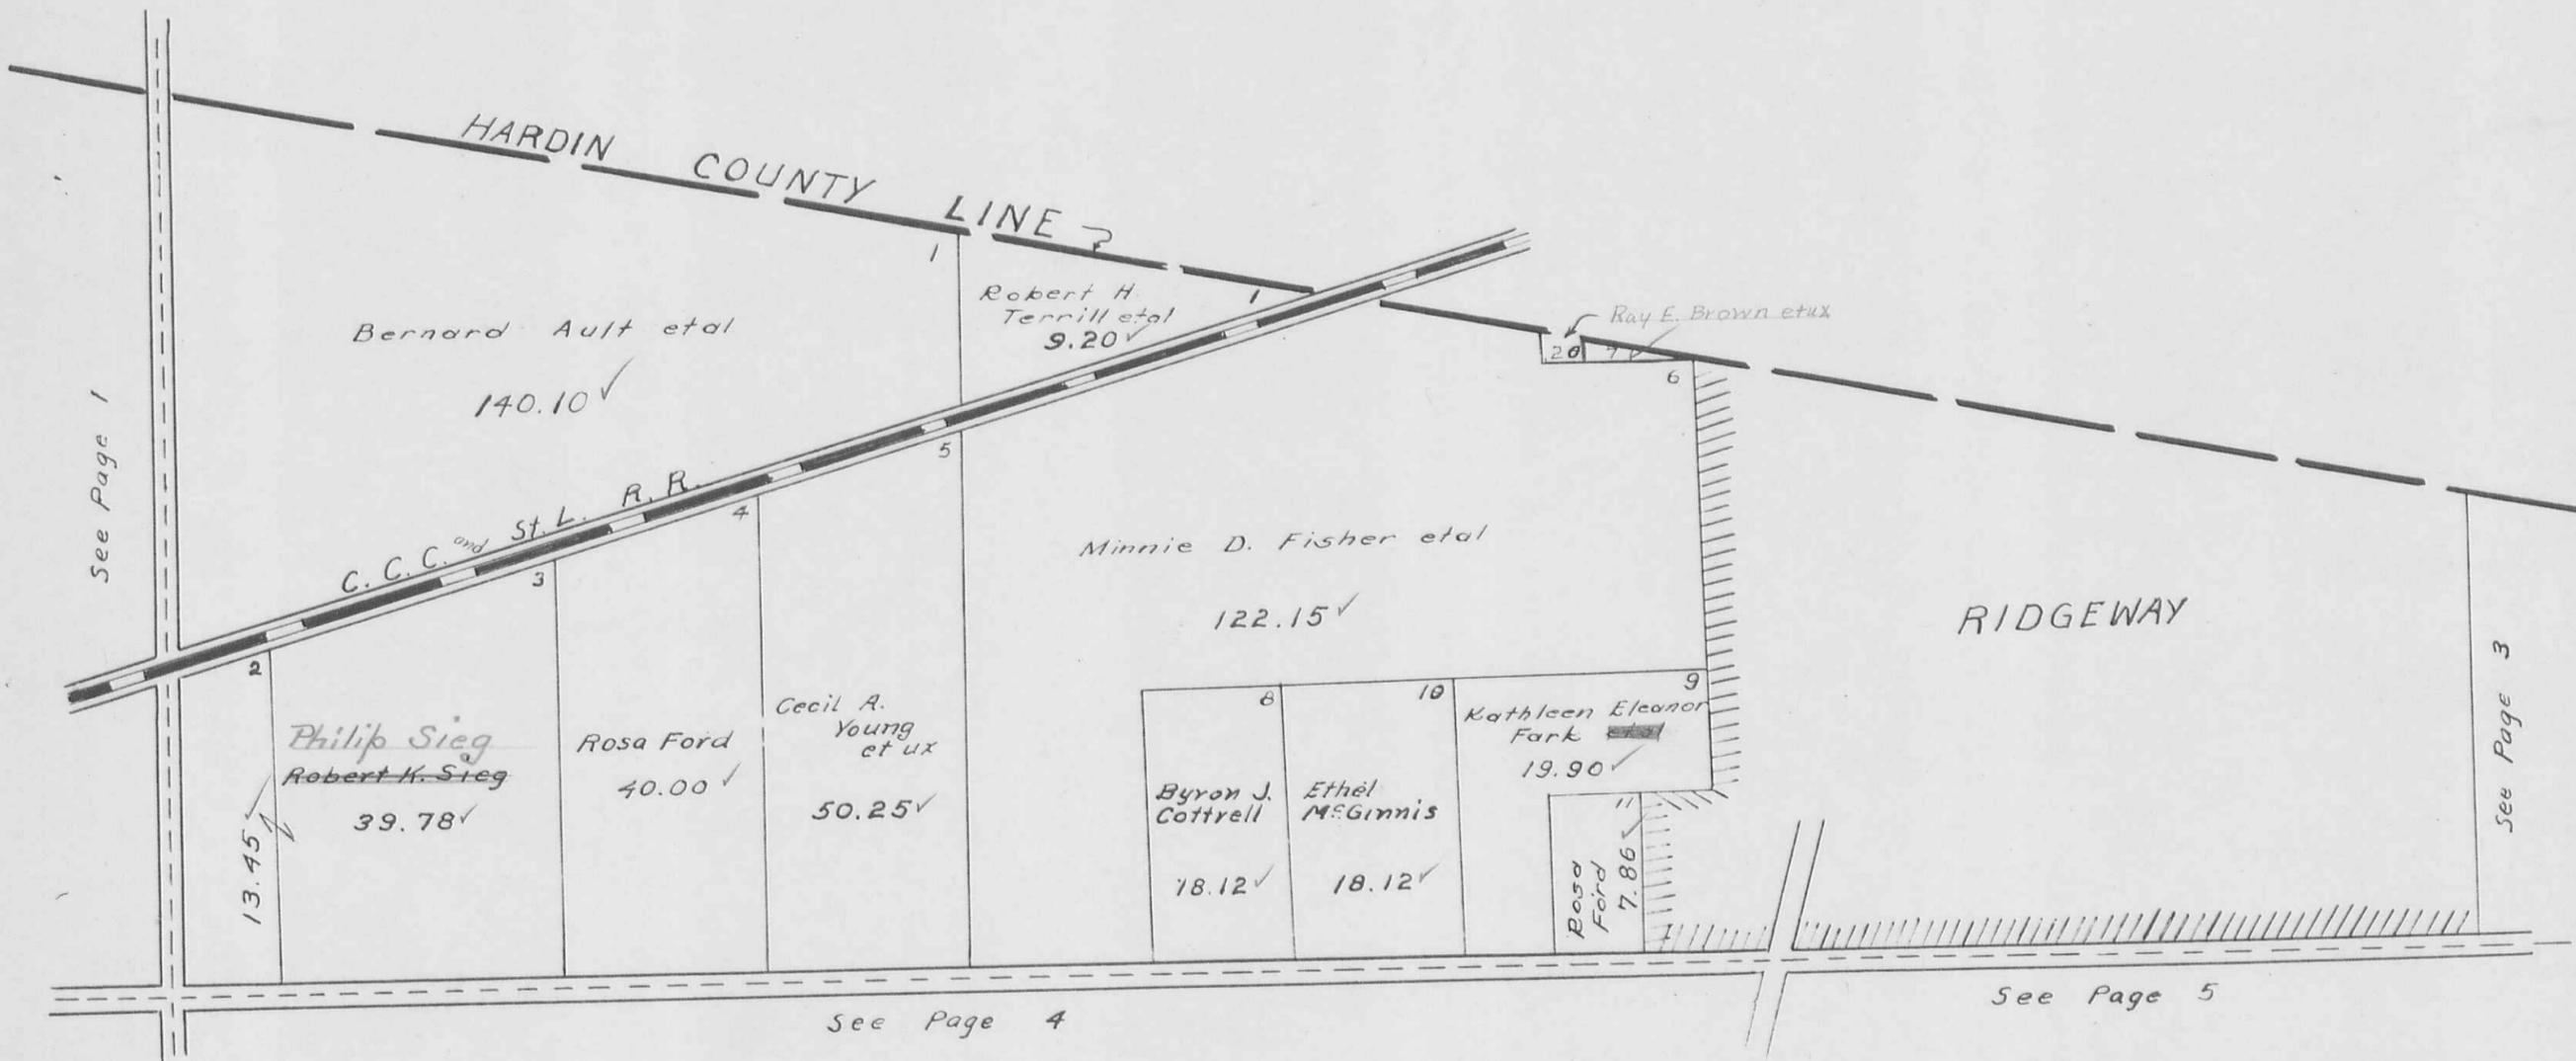

SCALE 10 CHAINS TO INCH

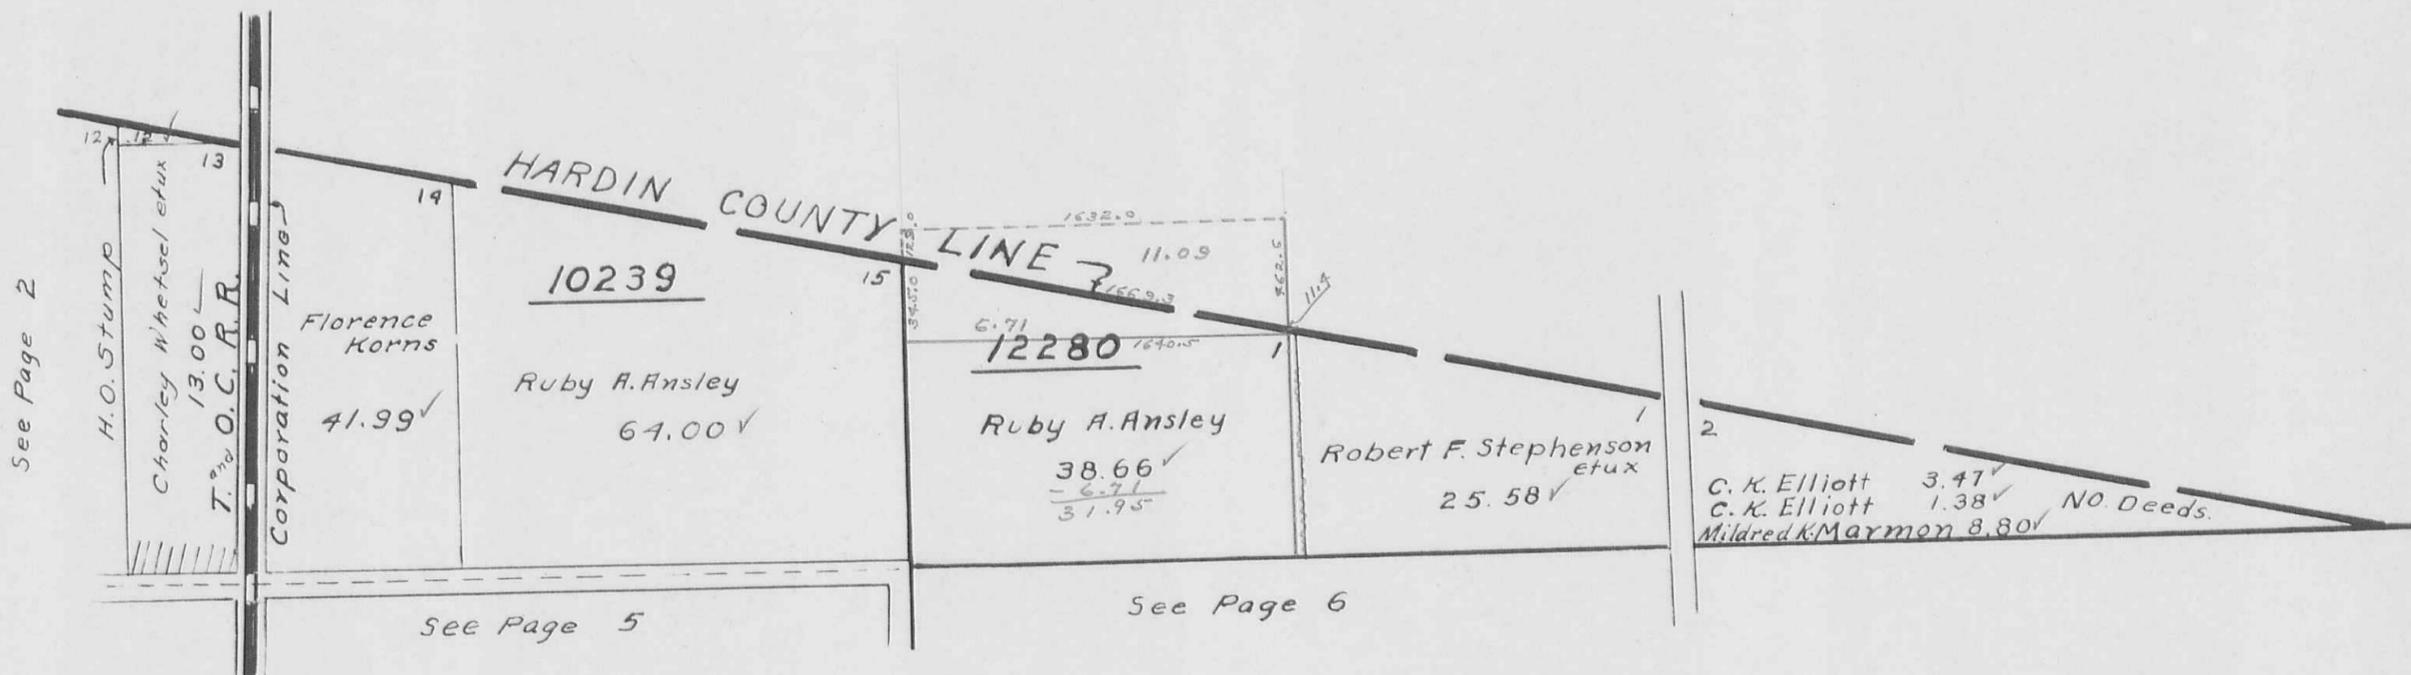

BOKESCREEK TOWNSHIP

VIRGINIA MILITARY SURVEYS




10837 16070
13593 10387
14530 10388

SCALE 10 CHAINS TO THE INCH

See Page 2

RUSHCREEK TOWNSHIP LINE

See Page 5

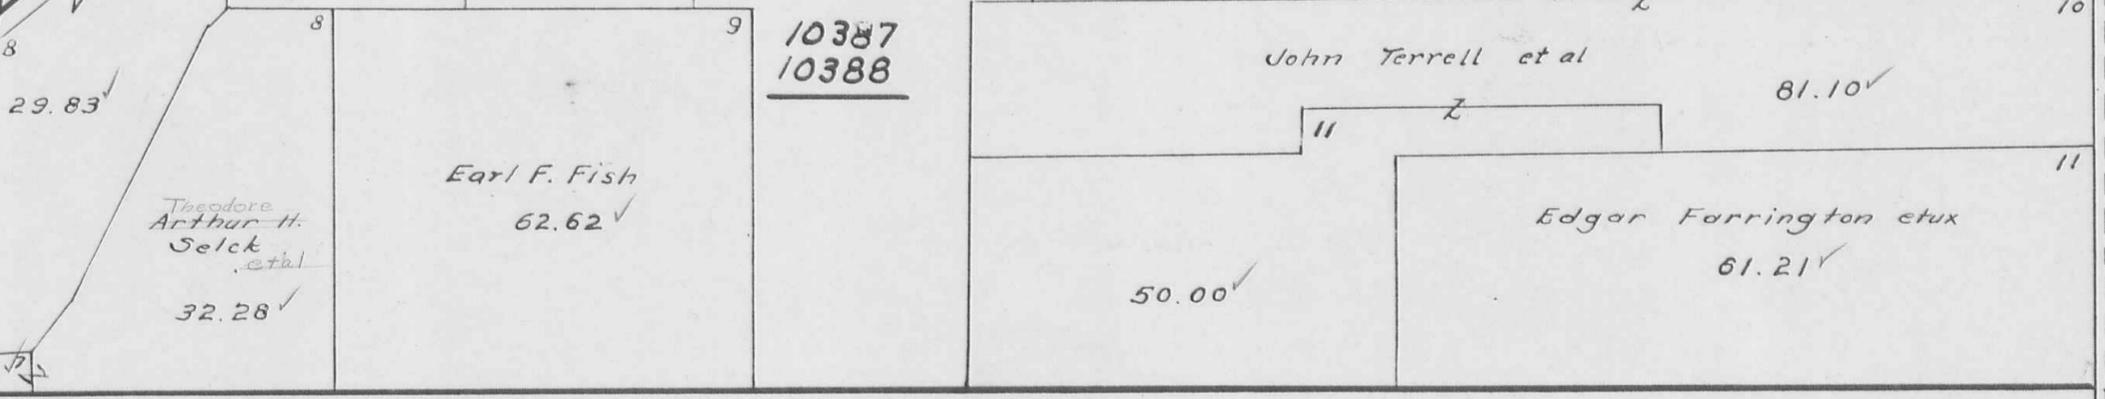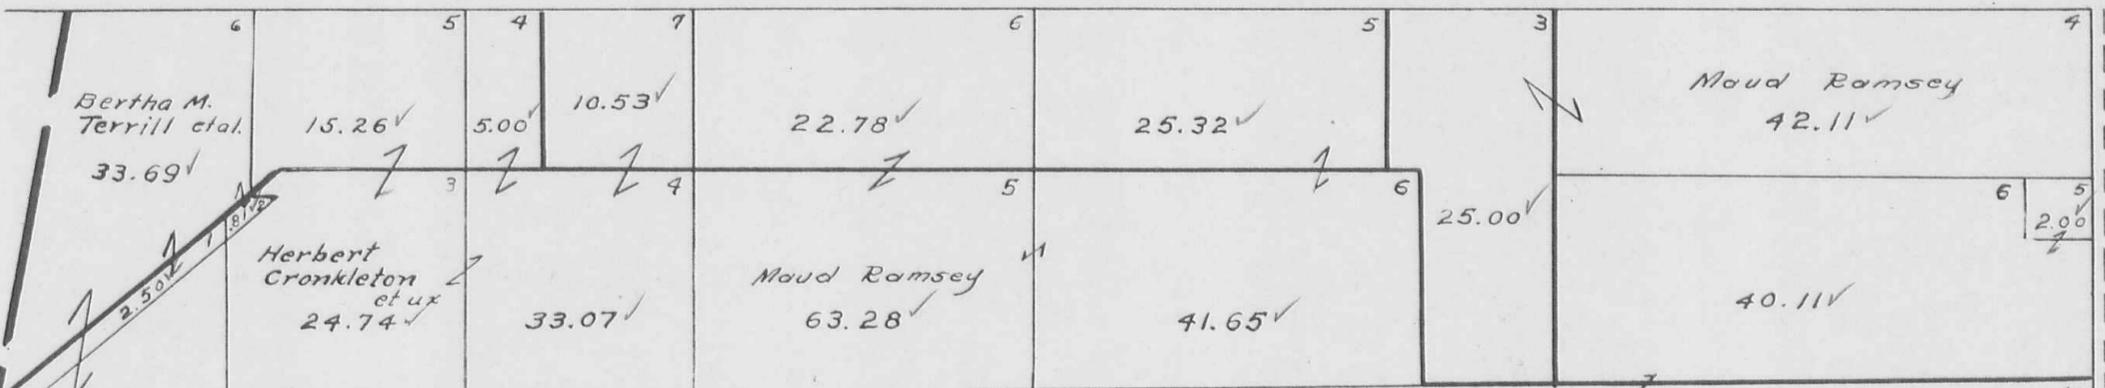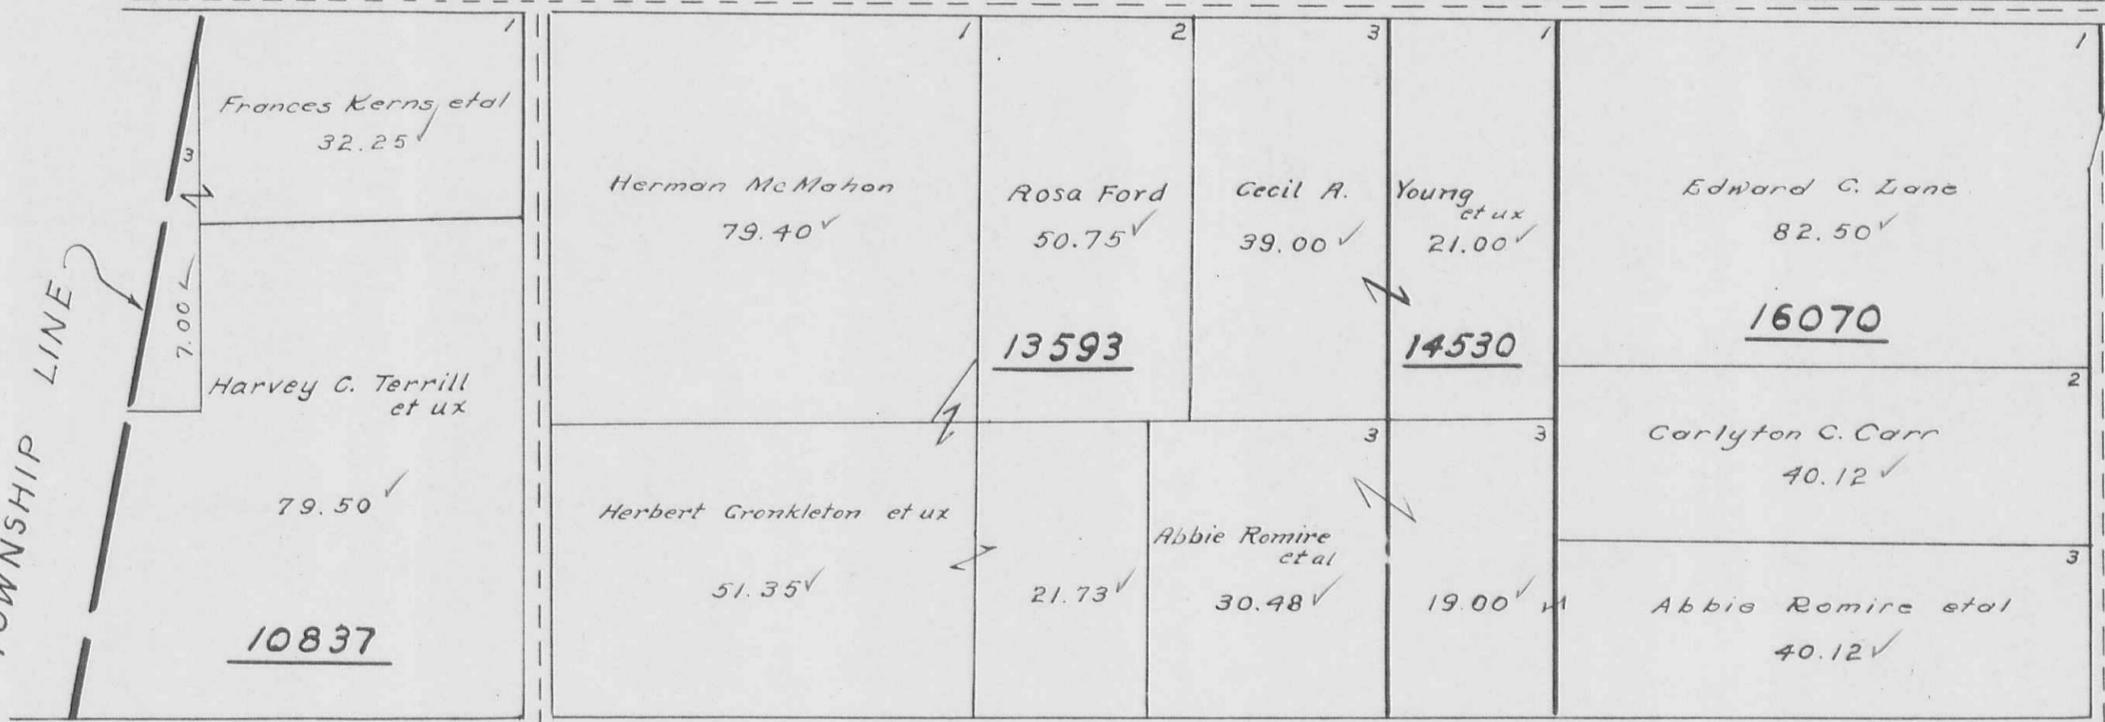


See Page 7

See Page 8

VIRGINIA MILITARY SURVEY 9958

SCALE 10 CHAINS TO INCH

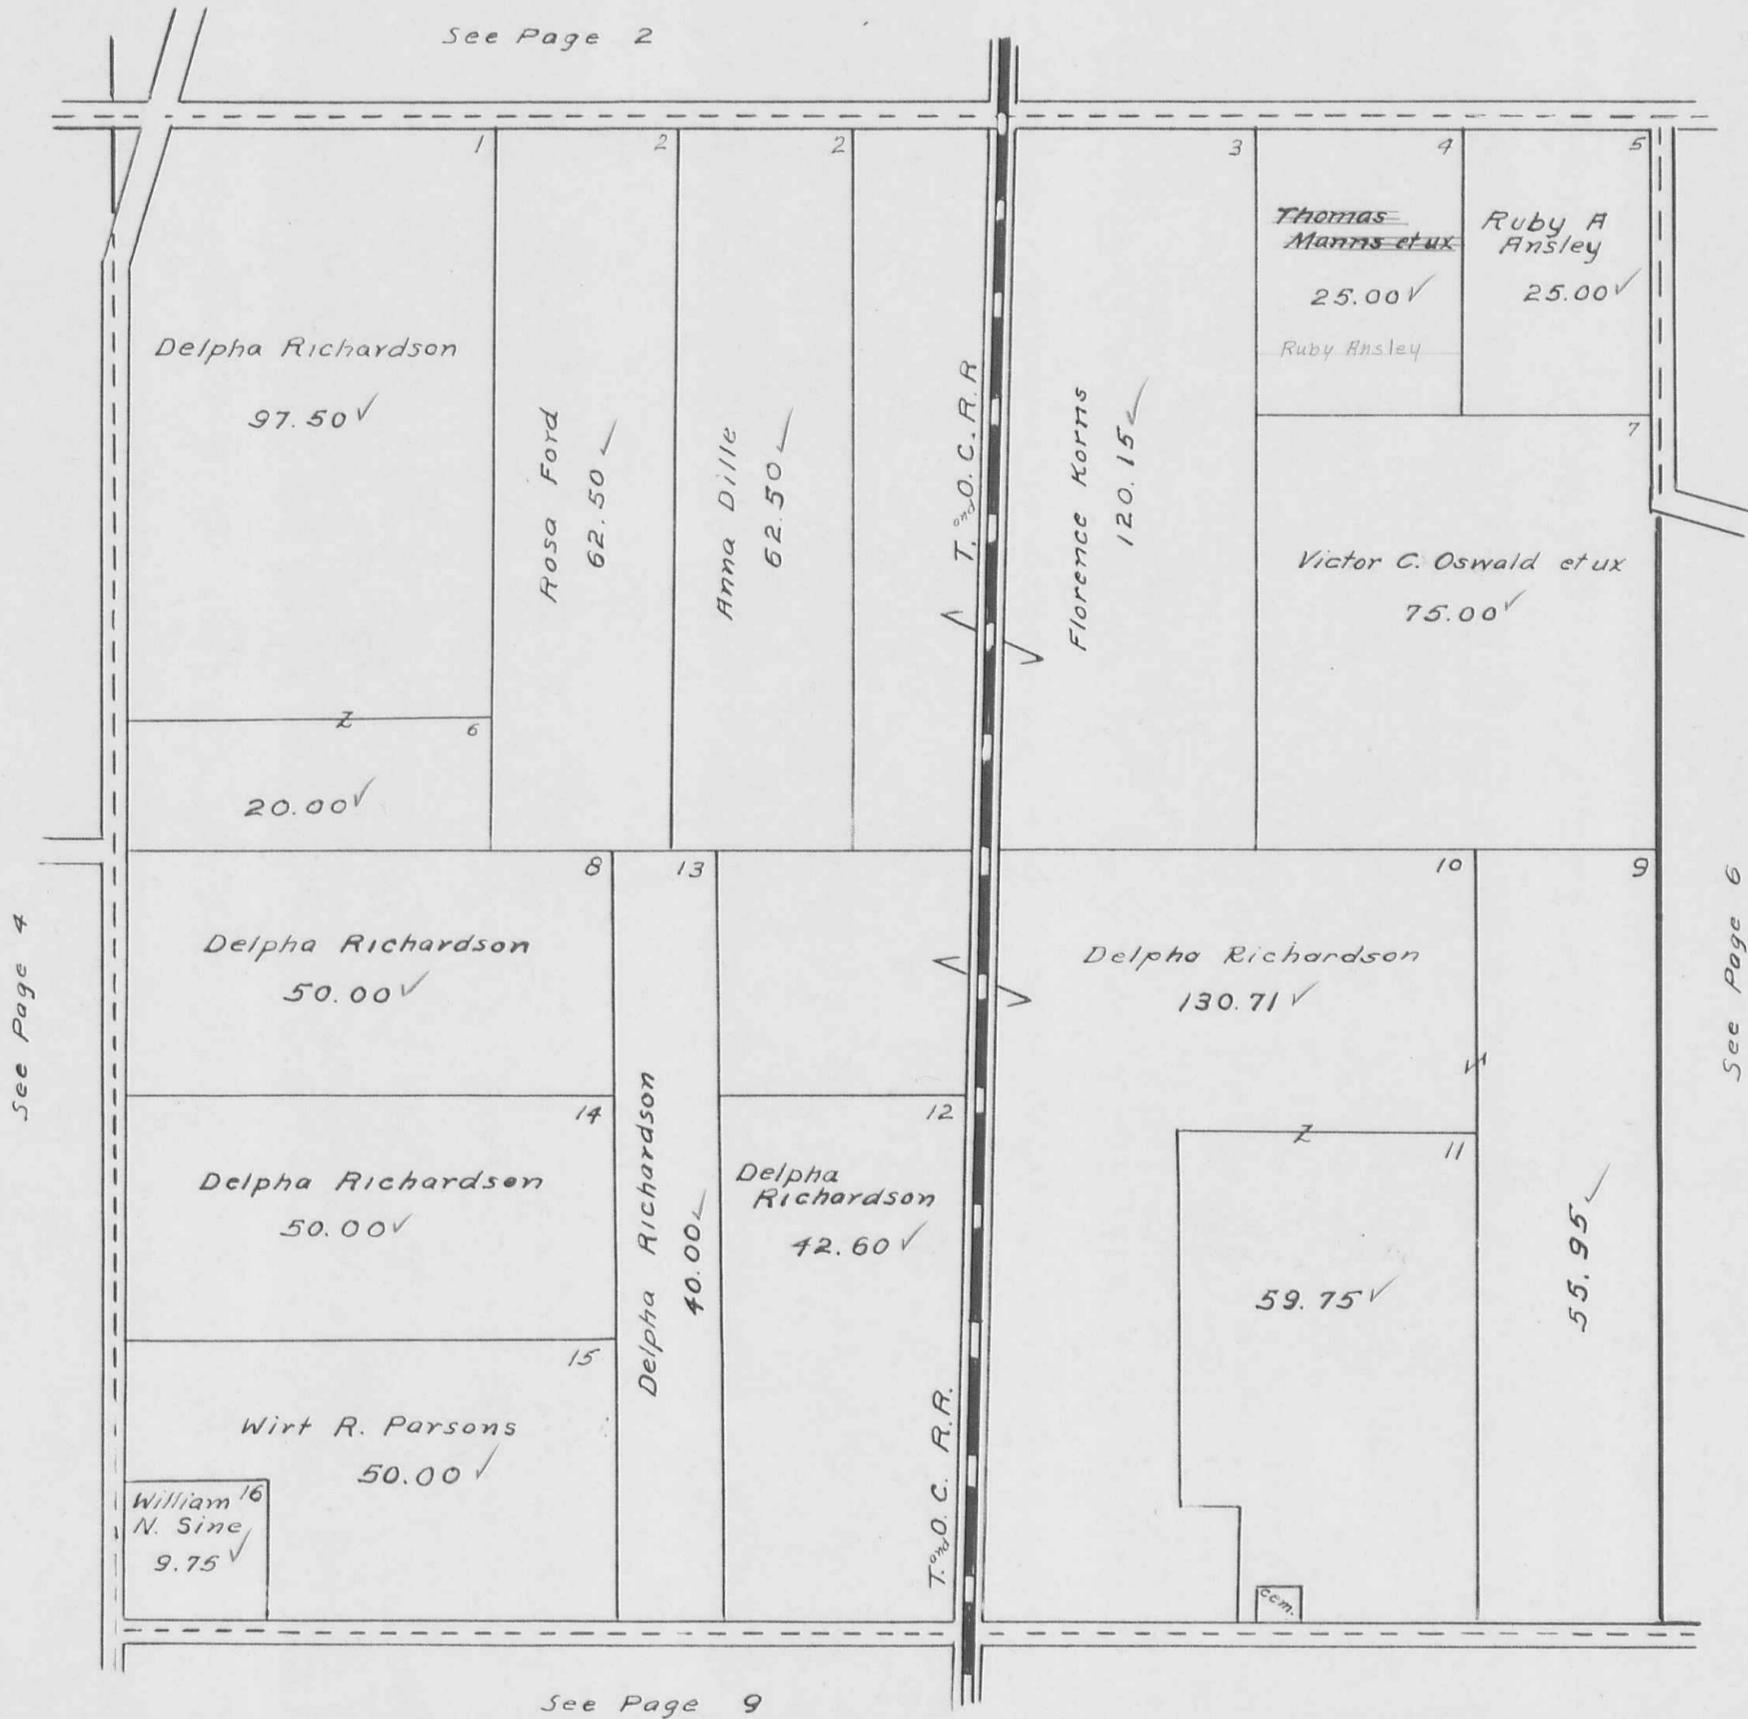


BOKESCREEK TOWNSHIP

VIRGINIA MILITARY SURVEYS

9959
9960
10042

SCALE 10 CHAINS TO THE INCH

See Page 3

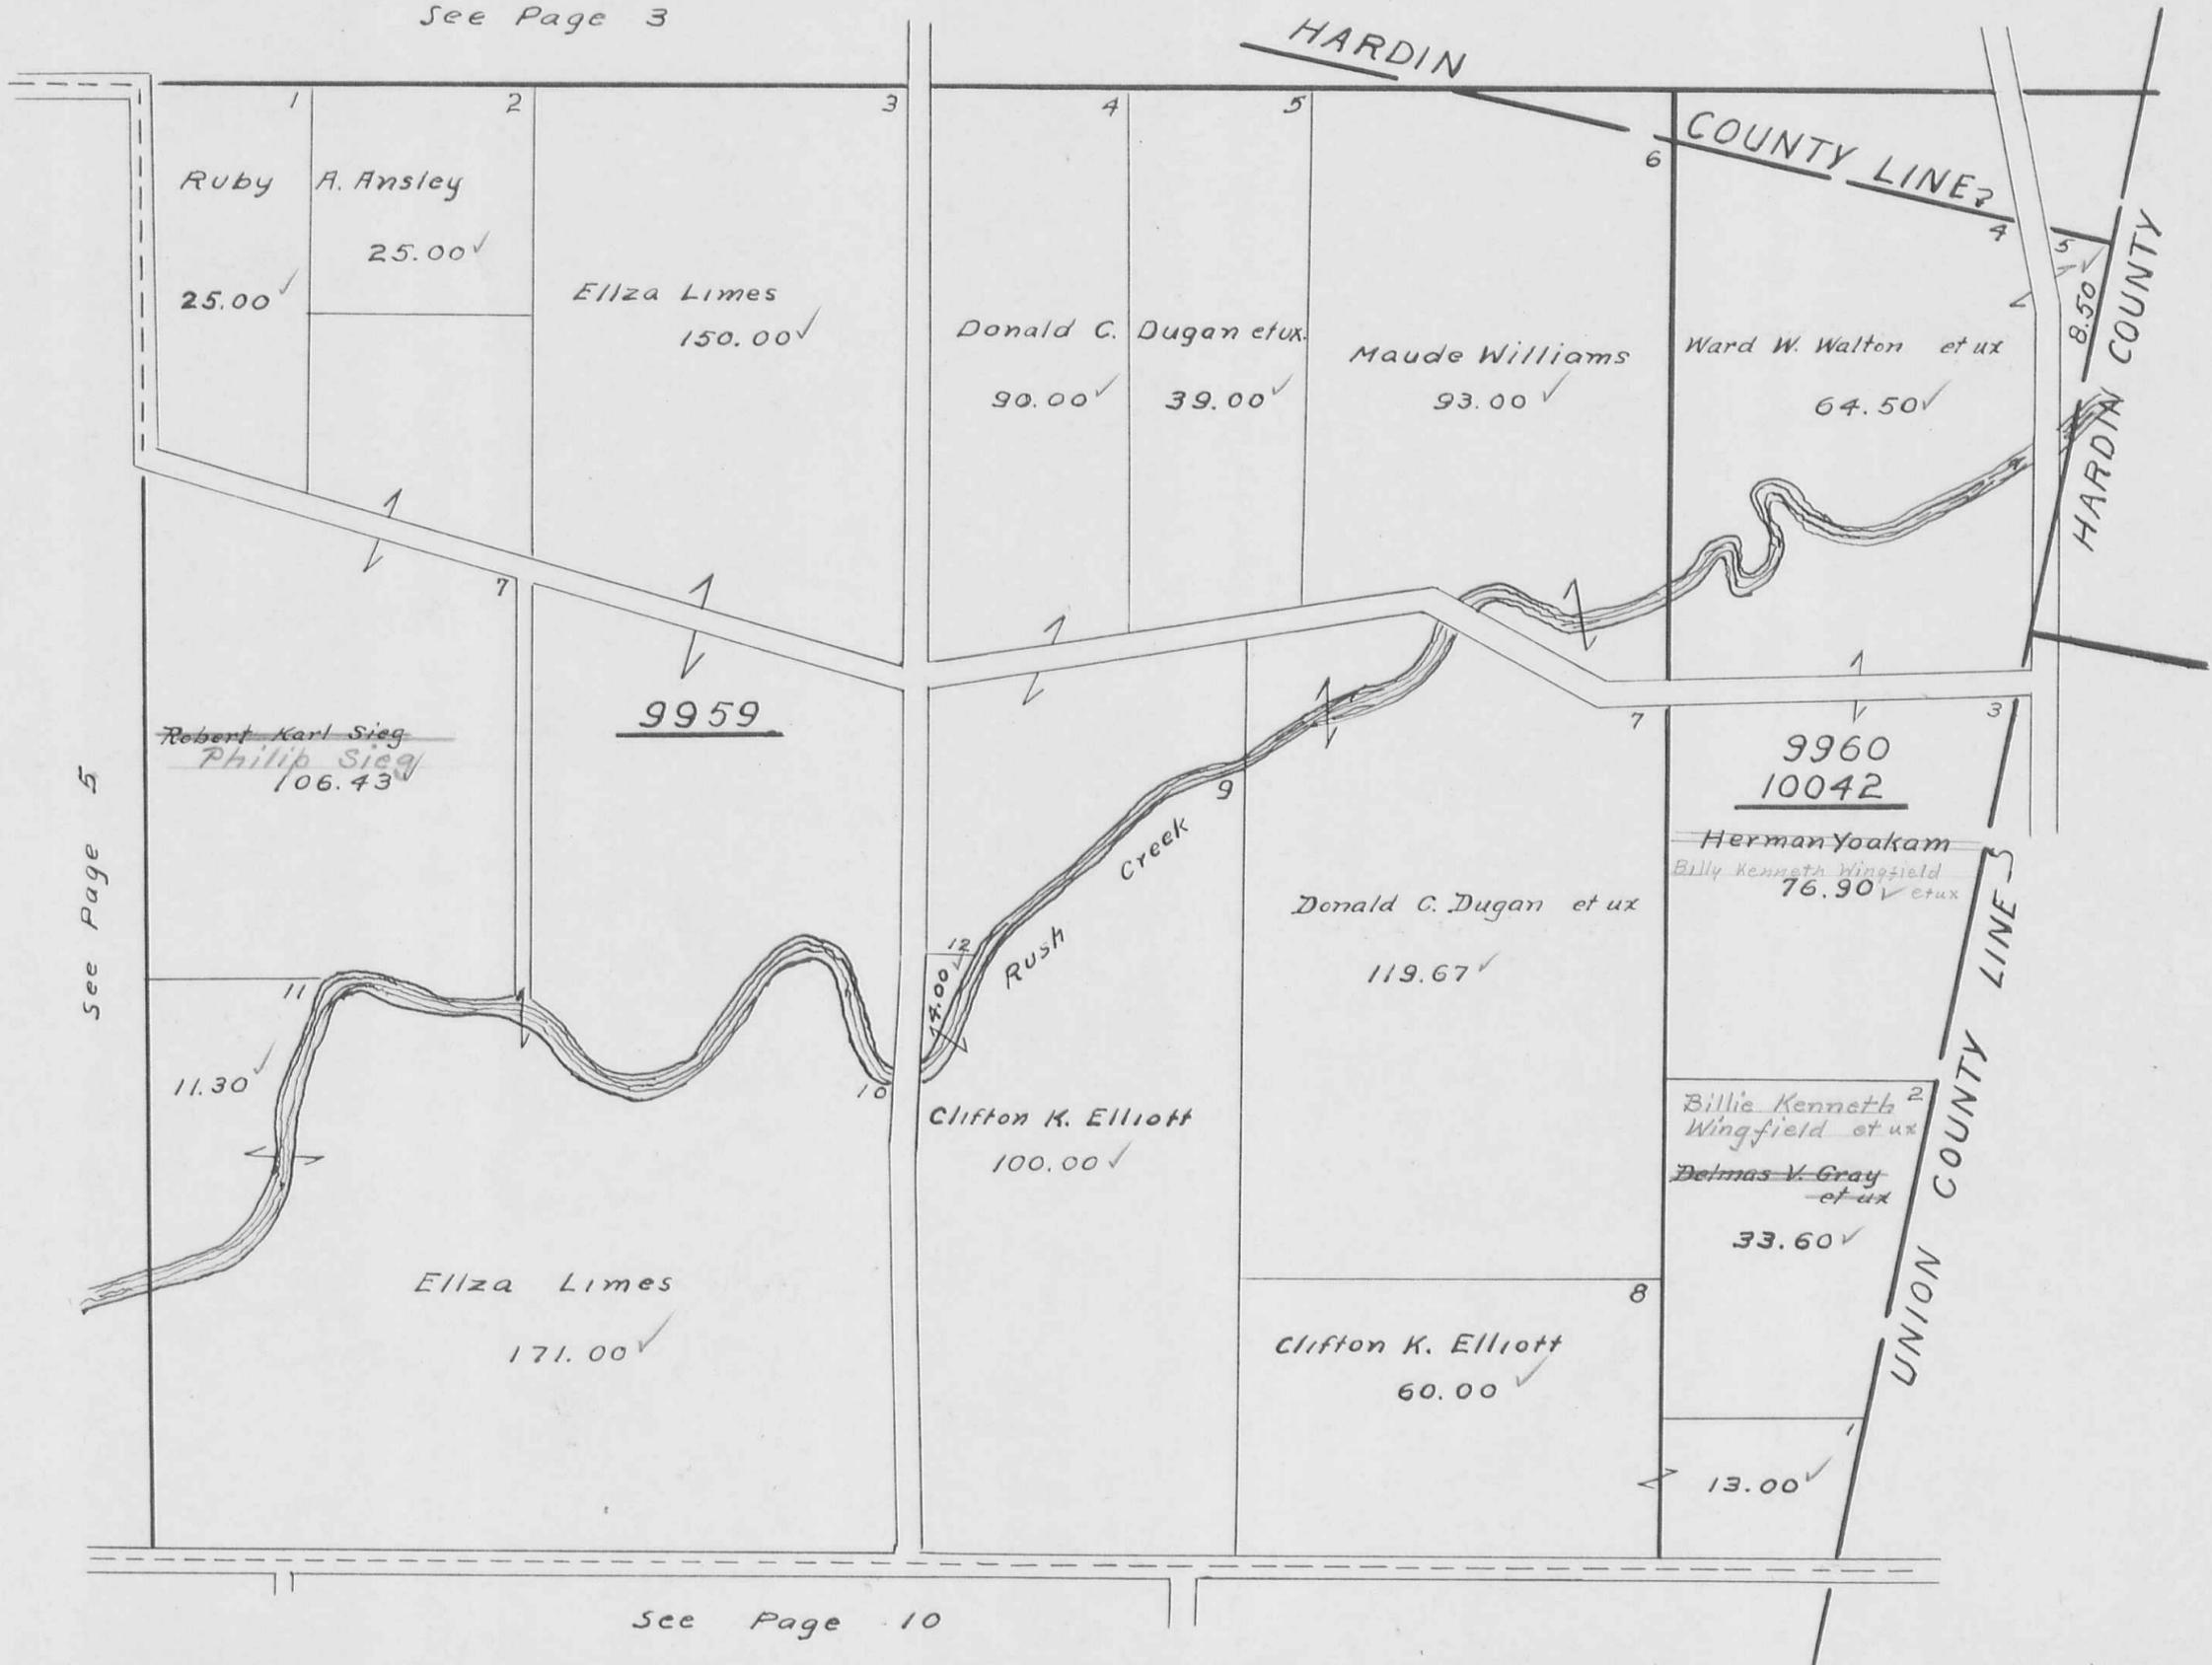


See Page 10

VIRGINIA MILITARY SURVEY 9937

SCALE 10 CHAINS TO THE INCH

See Page 4

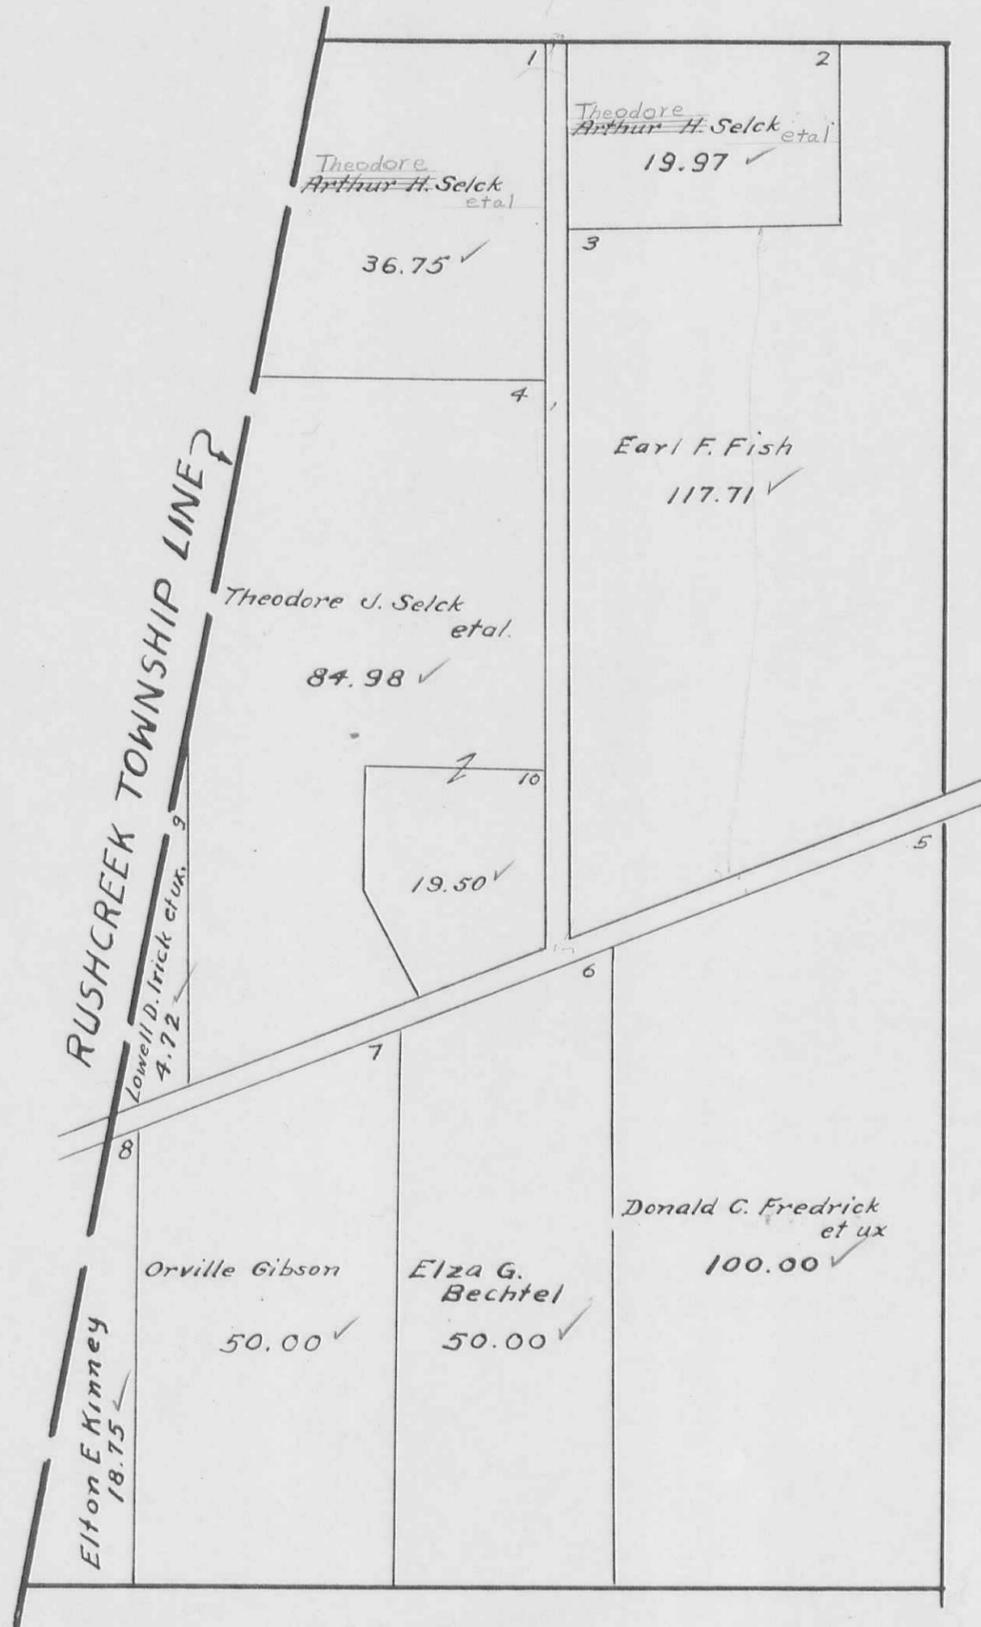

See Page 8


See Page 11

VIRGINIA MILITARY SURVEY 9938

SCALE 10 CHAINS TO THE INCH

80.12
11.60
91.72

See Page 4

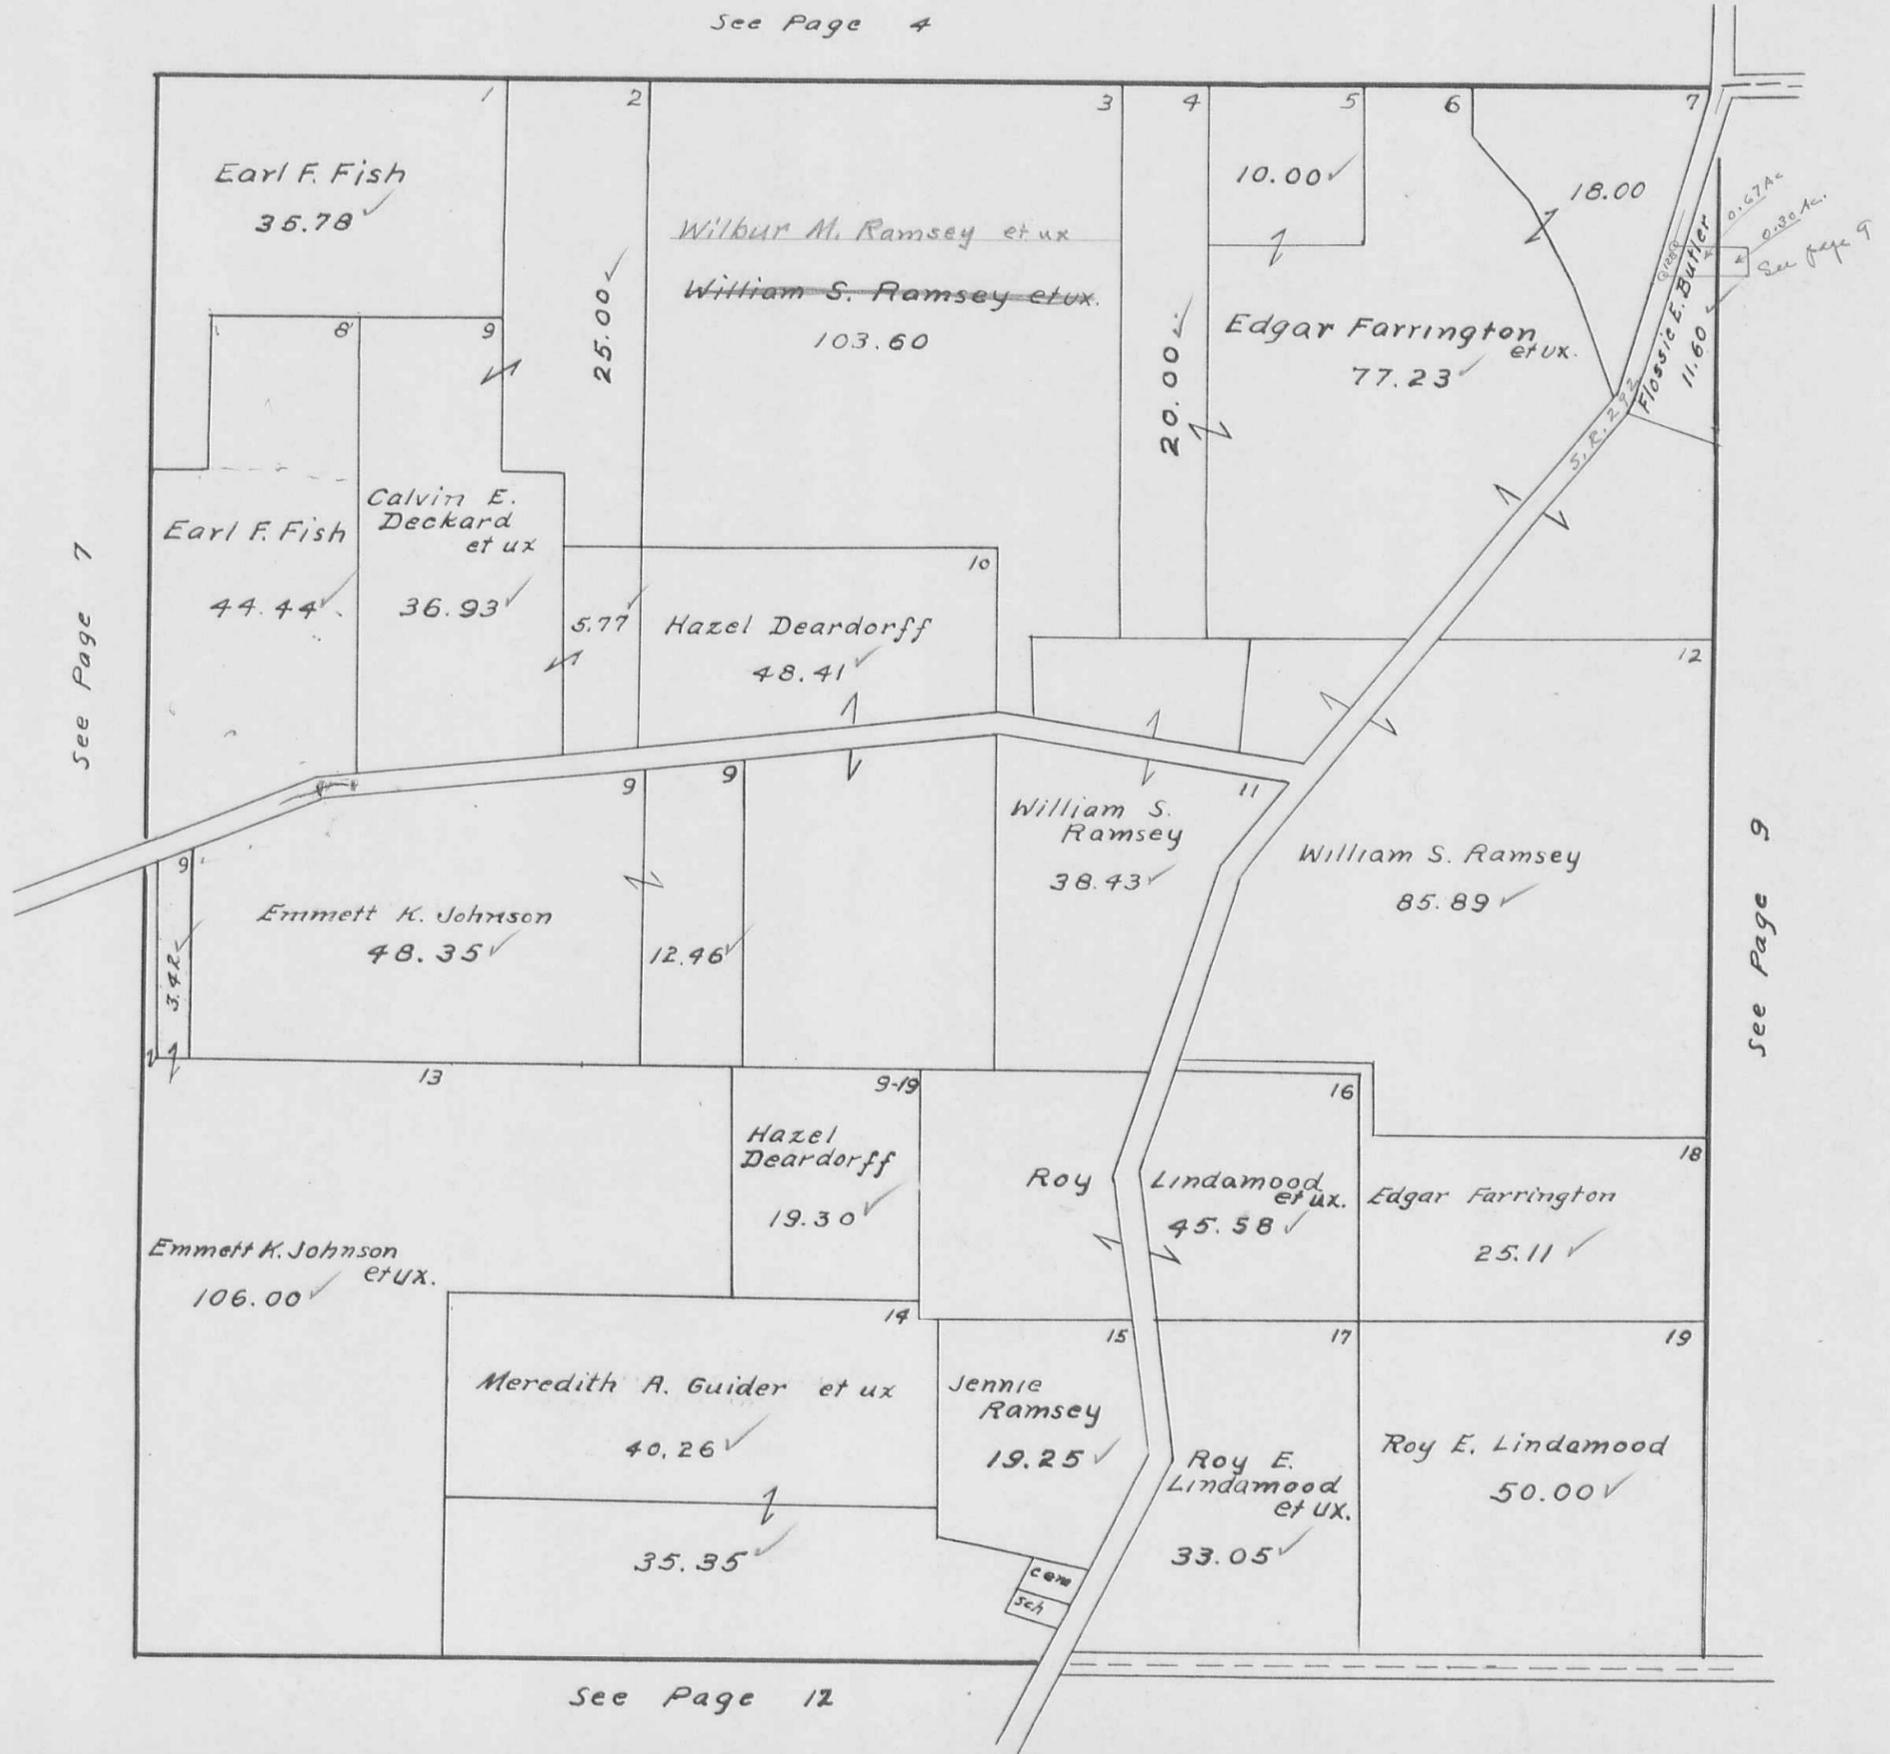

See Page 7


See Page 9

See Page 12

77.23
15.
92.23

VIRGINIA MILITARY SURVEY 10060

SCALE 10 CHAINS TO THE INCH

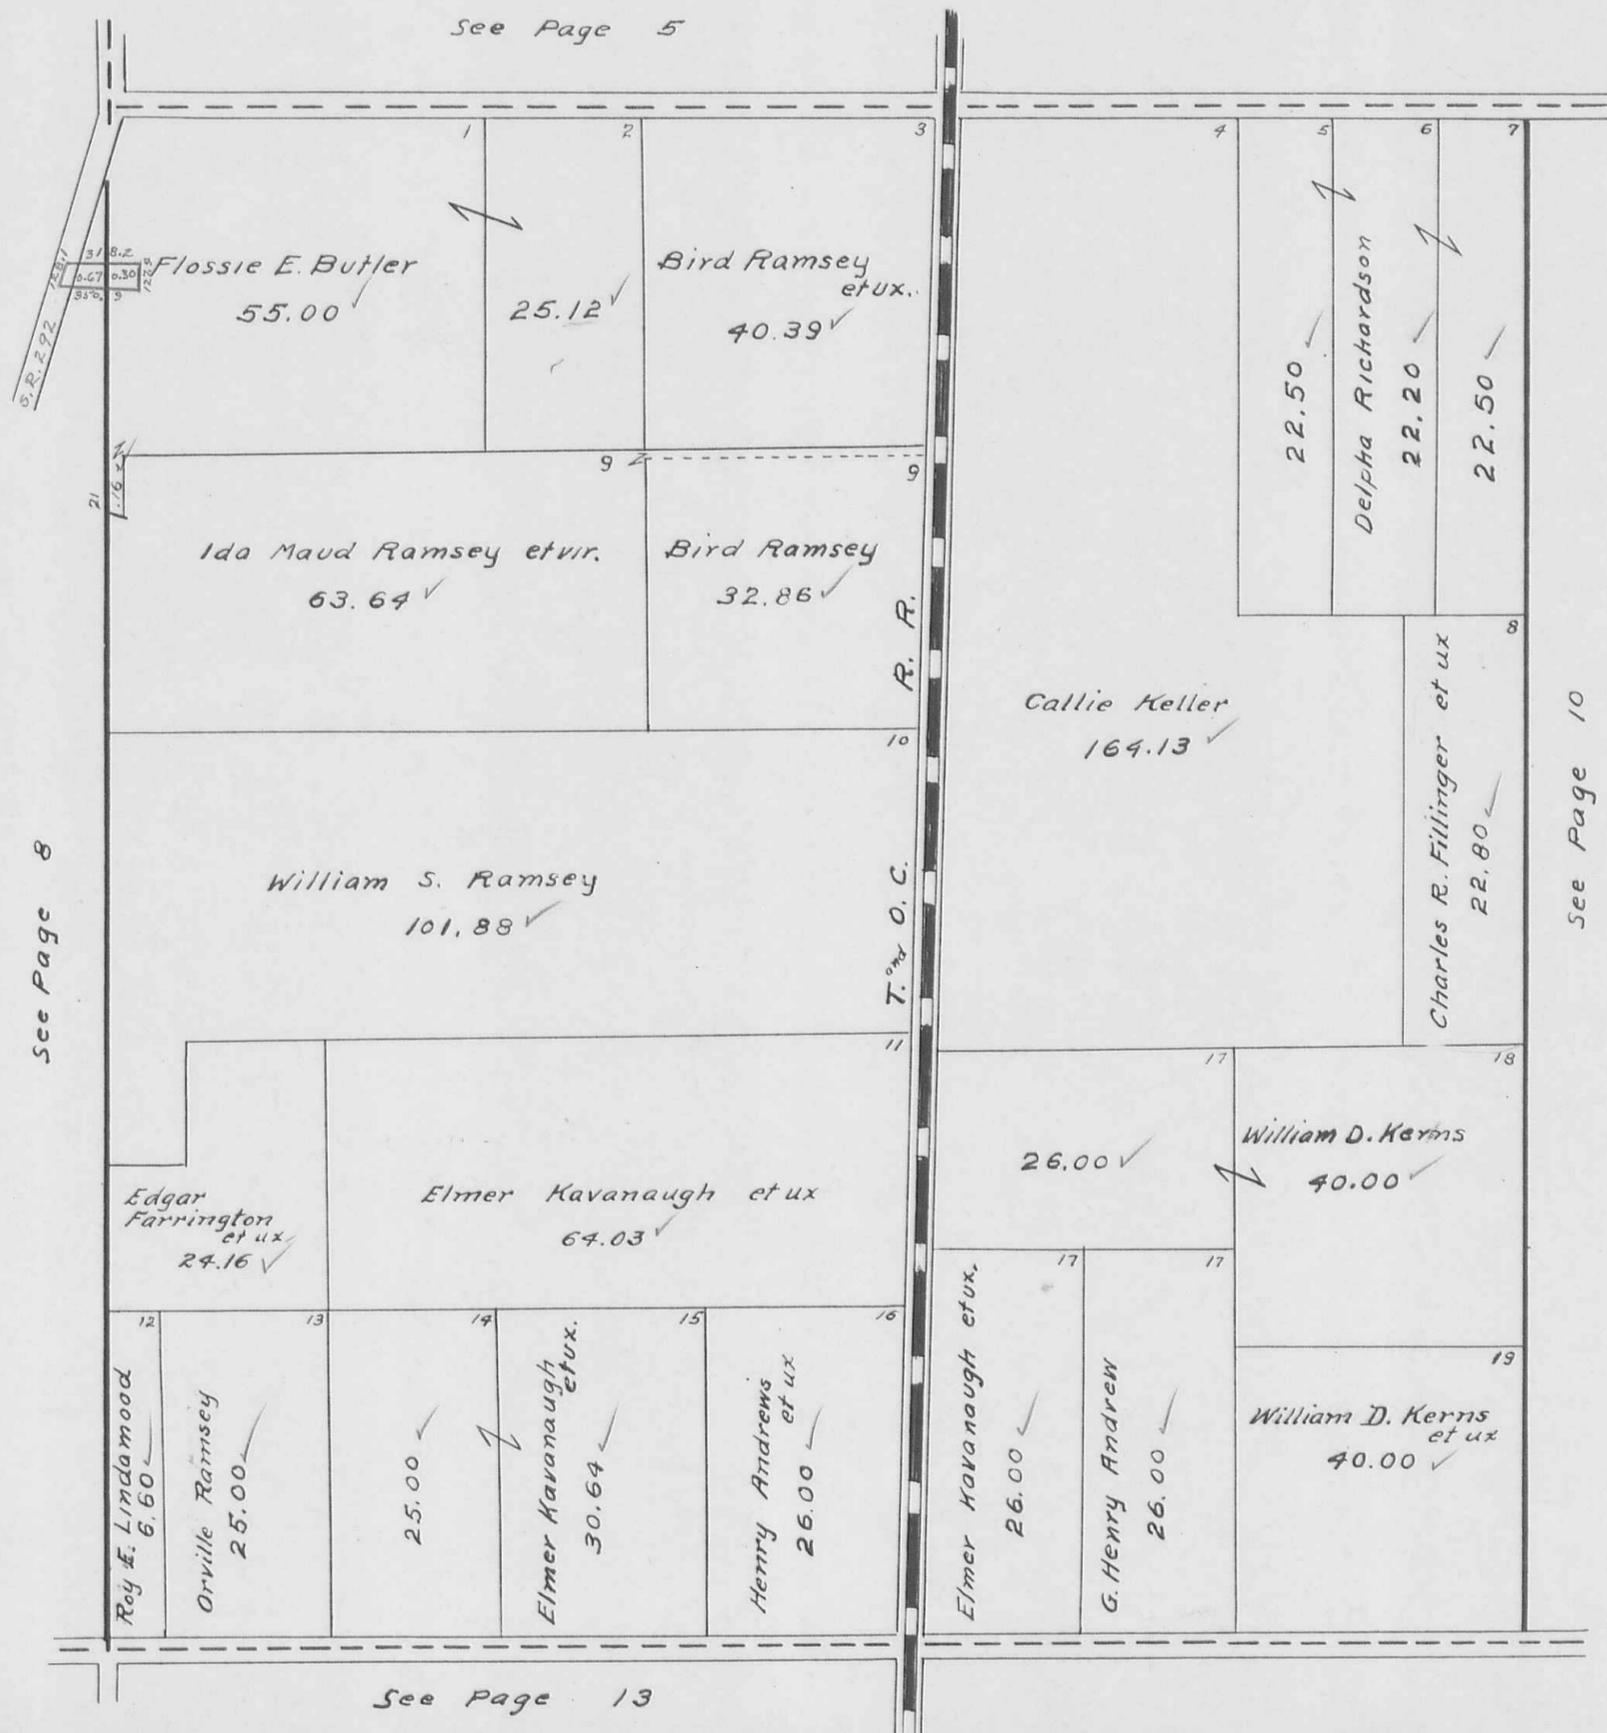

BOKESCREEK TOWNSHIP
VIRGINIA MILITARY SURVEYS 12112
7161

SCALE 10 CHAINS TO THE INCH

See Page 6



See Page 9

See Page 14

BOKE SCREEK TOWNSHIP

VIRGINIA MILITARY SURVEY 9912

SCALE 10 CHAINS TO THE INCH



See Page 7


See Page 12

See Page 15

RUSHCREEK TOWNSHIP LINE

BOKESCREEK TOWNSHIP
 VIRGINIA MILITARY SURVEY 9913


SCALE 10 CHAINS TO THE INCH

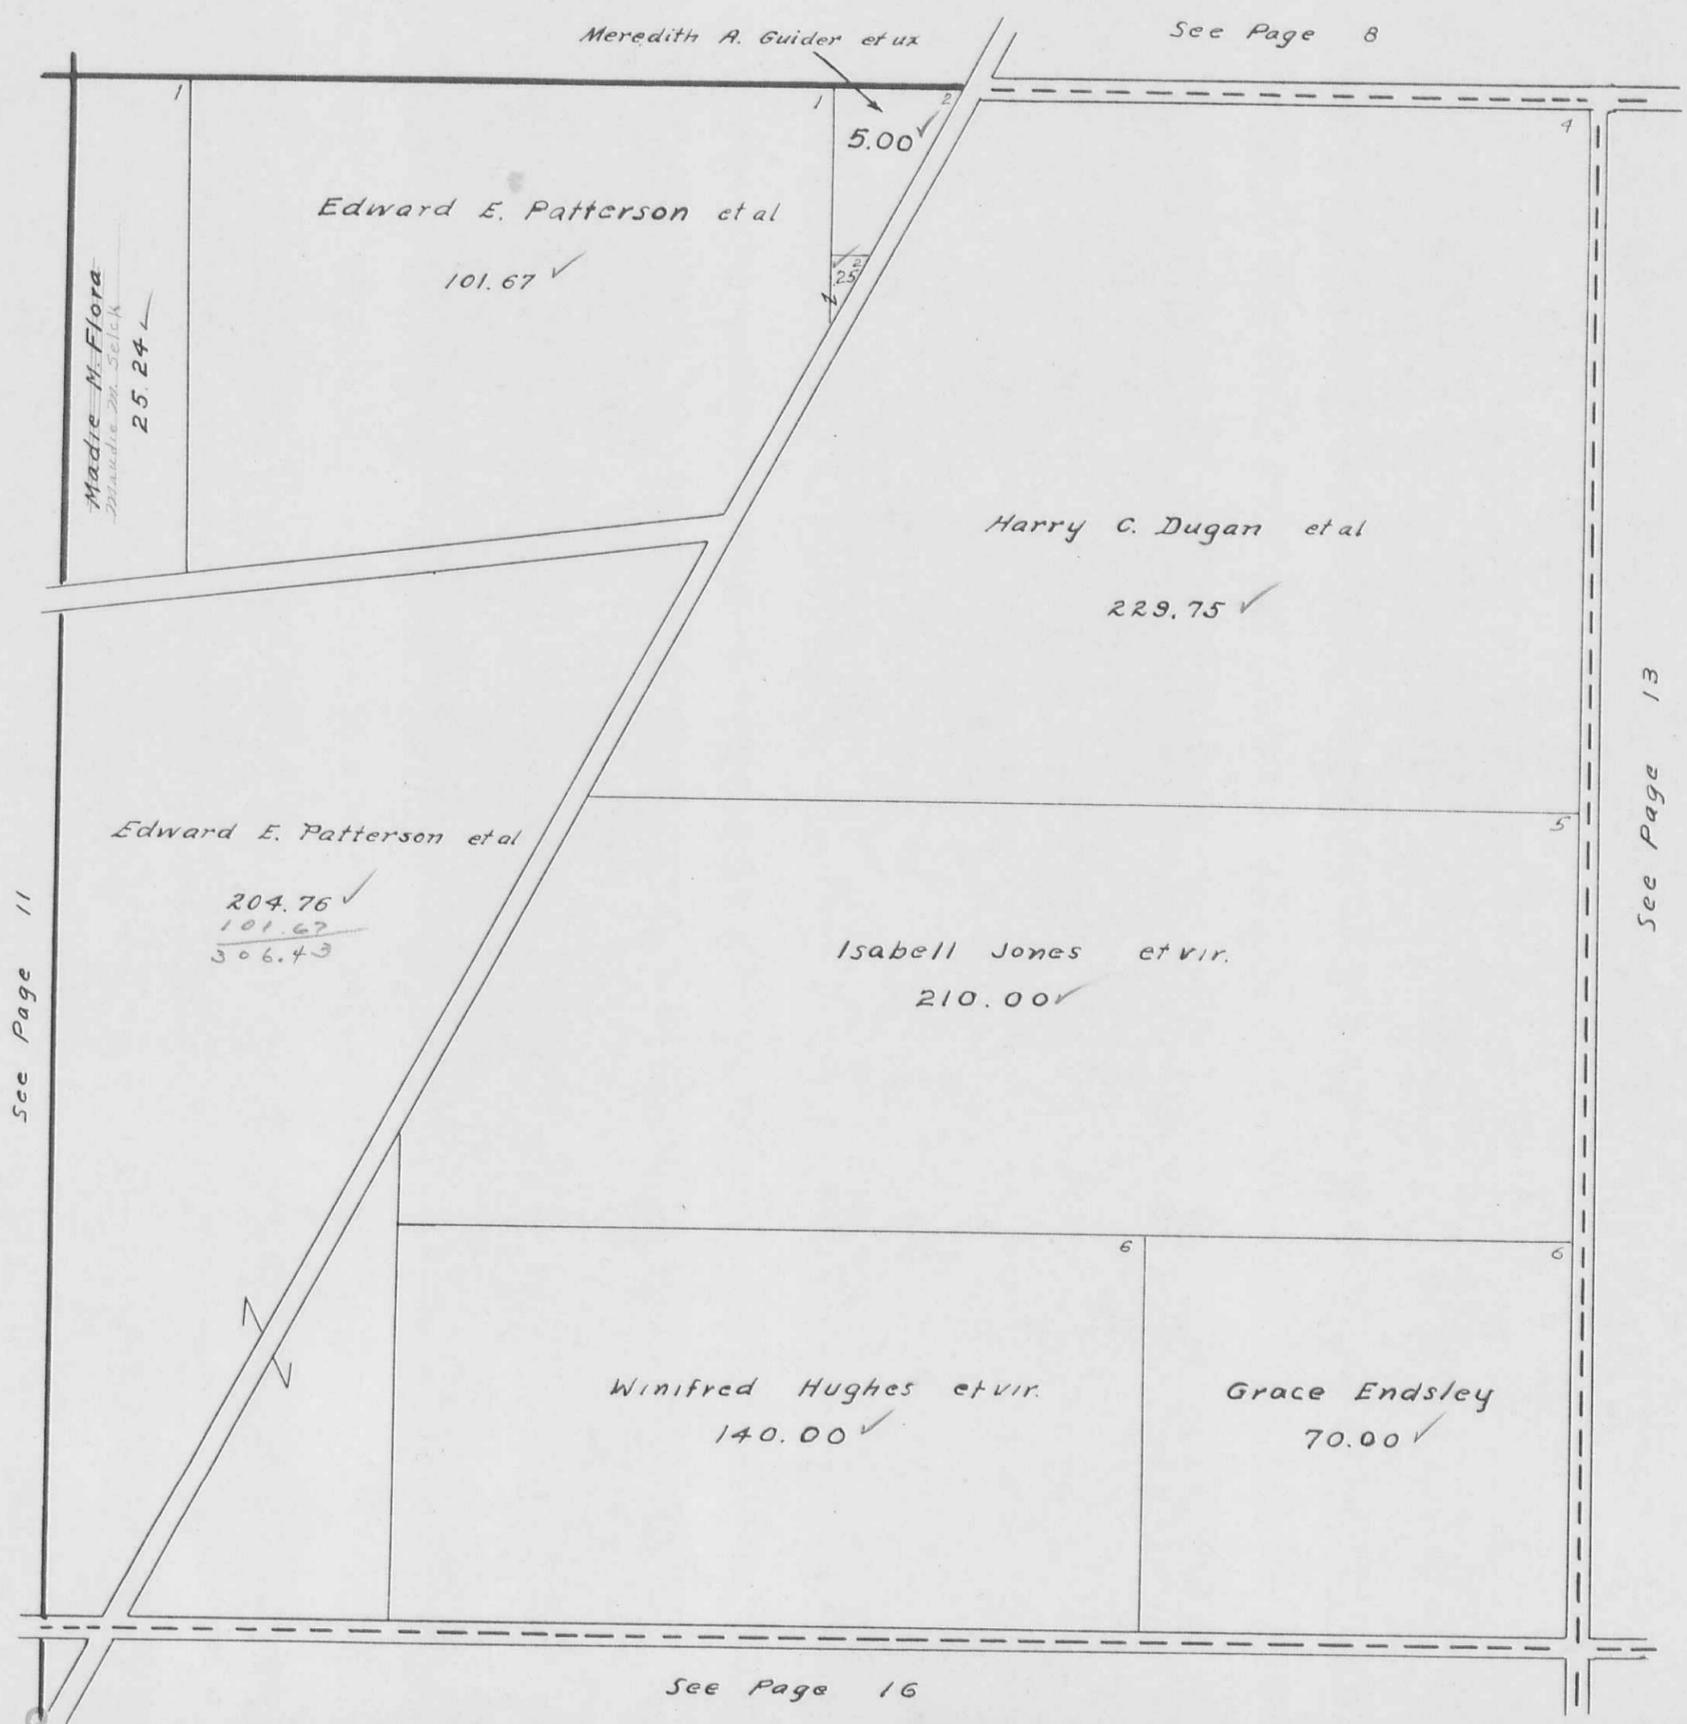

VIRGINIA MILITARY SURVEY 9914

SCALE 10 CHAINS TO THE INCH

See Page 9

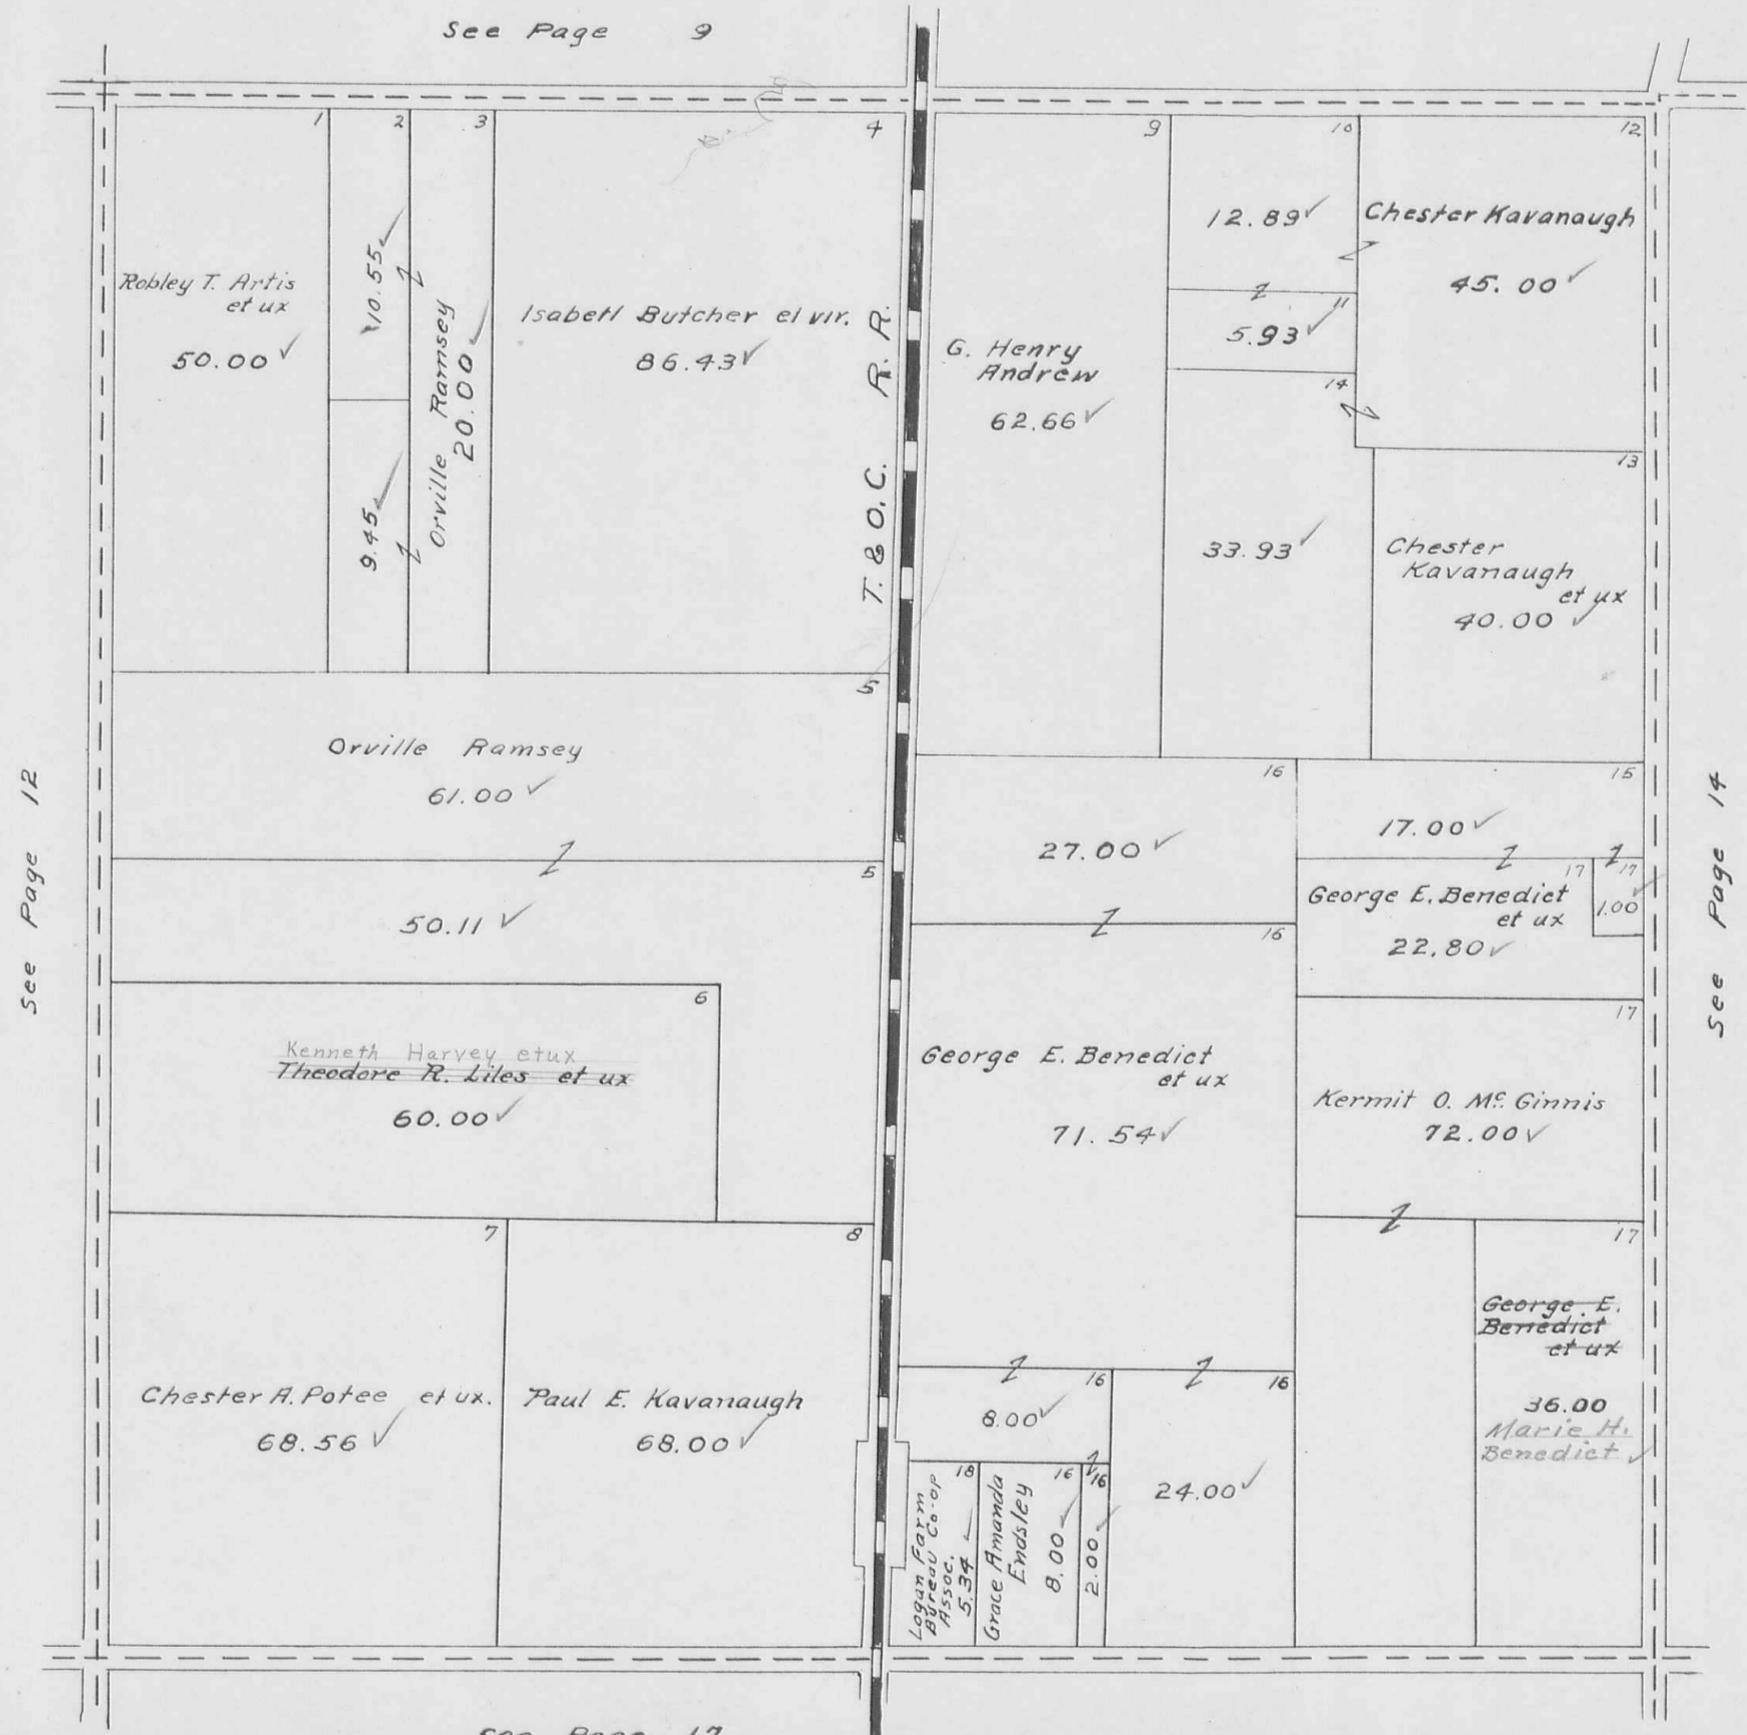

See Page 12


See Page 14

See Page 17

BOKESCREEK TOWNSHIP
VIRGINIA MILITARY SURVEY 9915

SCALE 10 CHAINS TO THE INCH

See Page 10

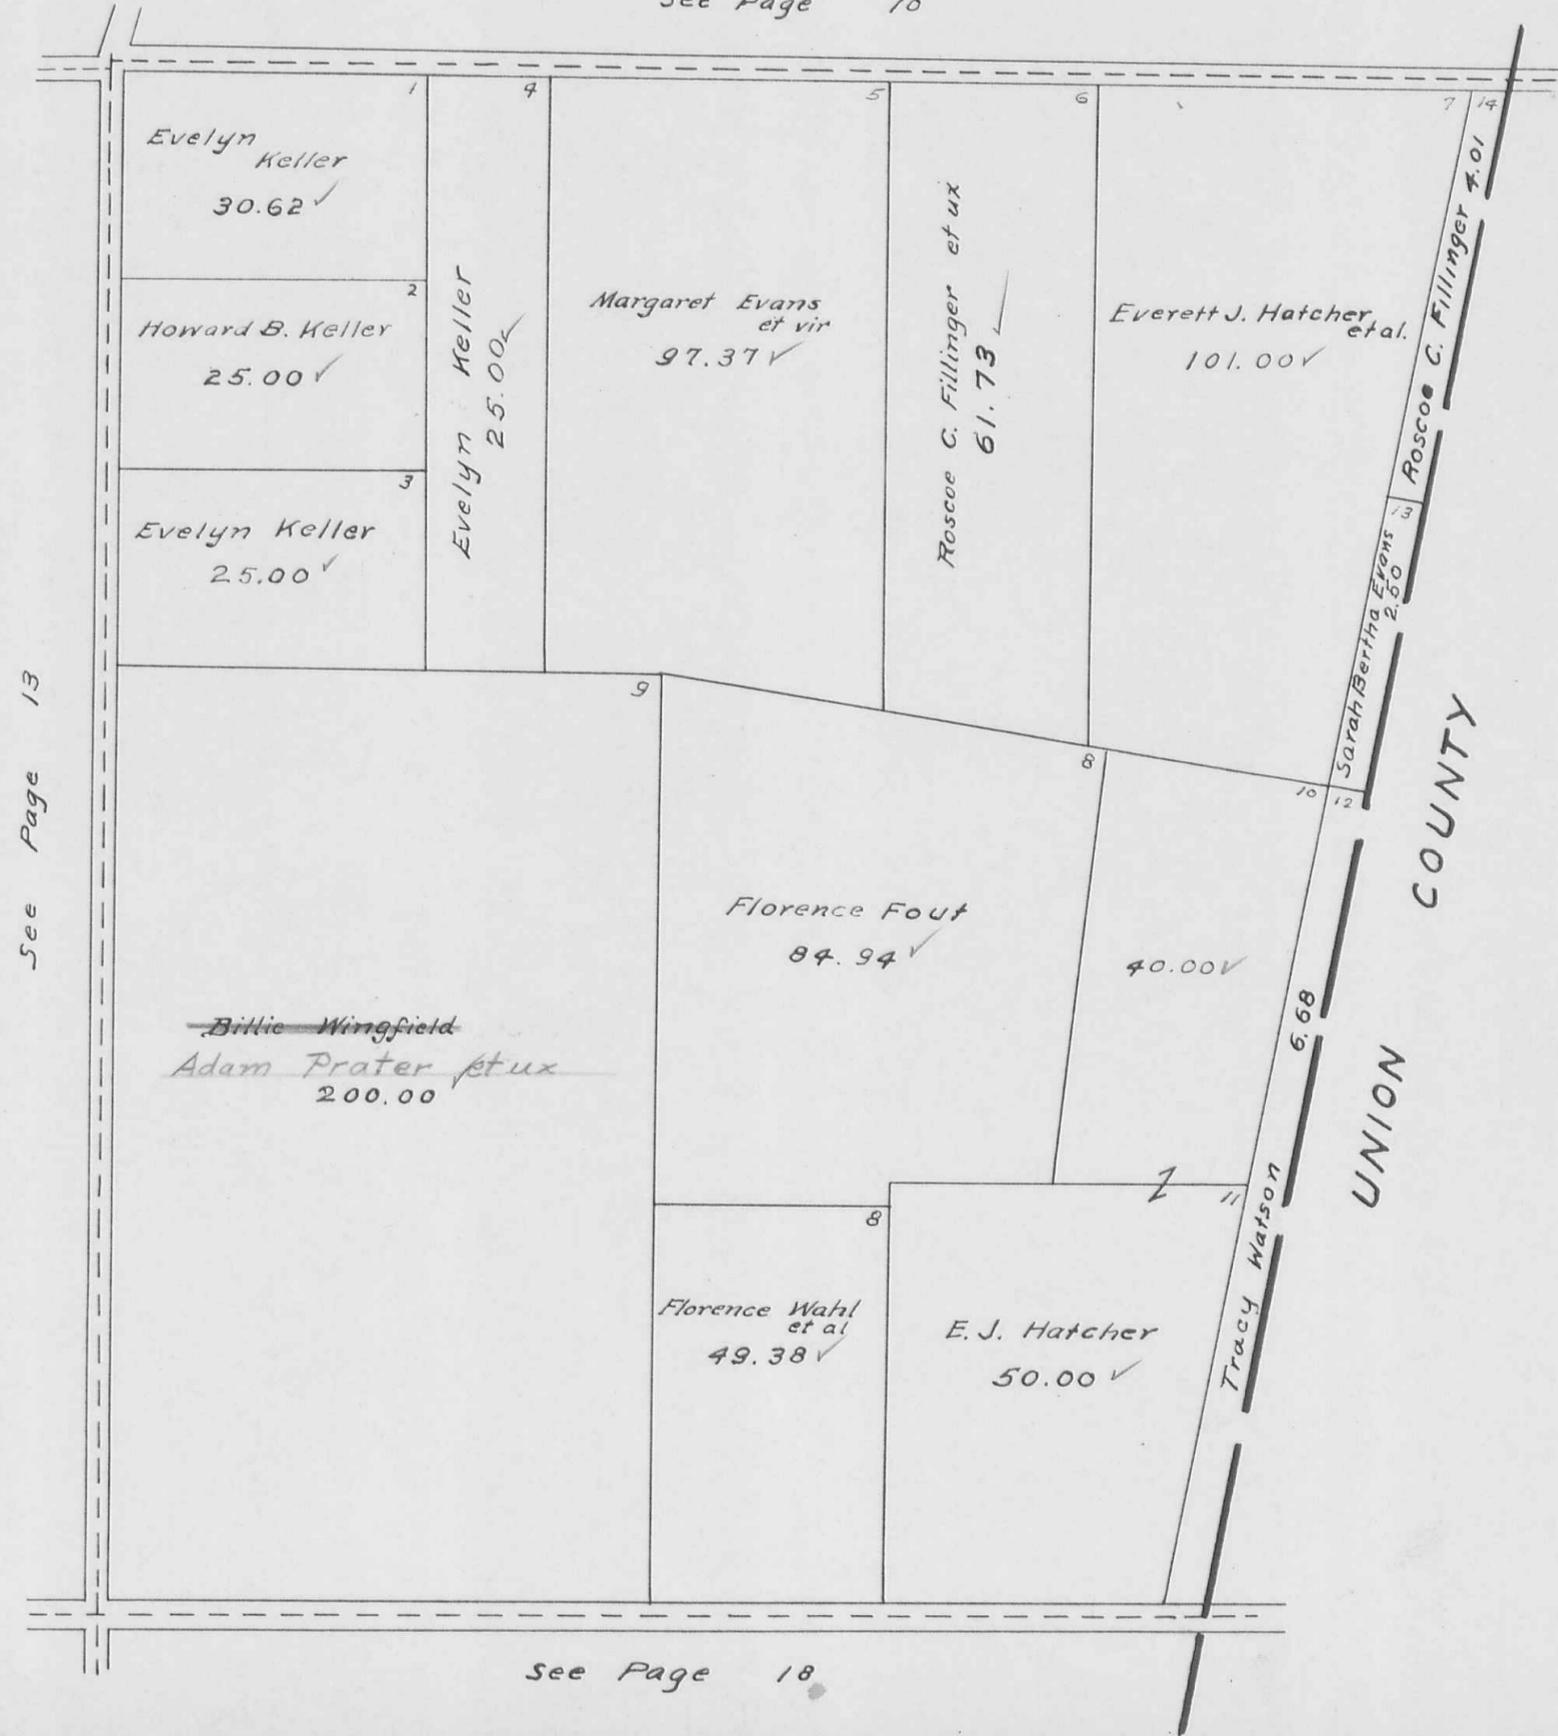


See Page 13

See Page 18

BOKE SCREEK TOWNSHIP
 VIRGINIA MILITARY SURVEY 9890


SCALE 10 CHAINS TO THE INCH

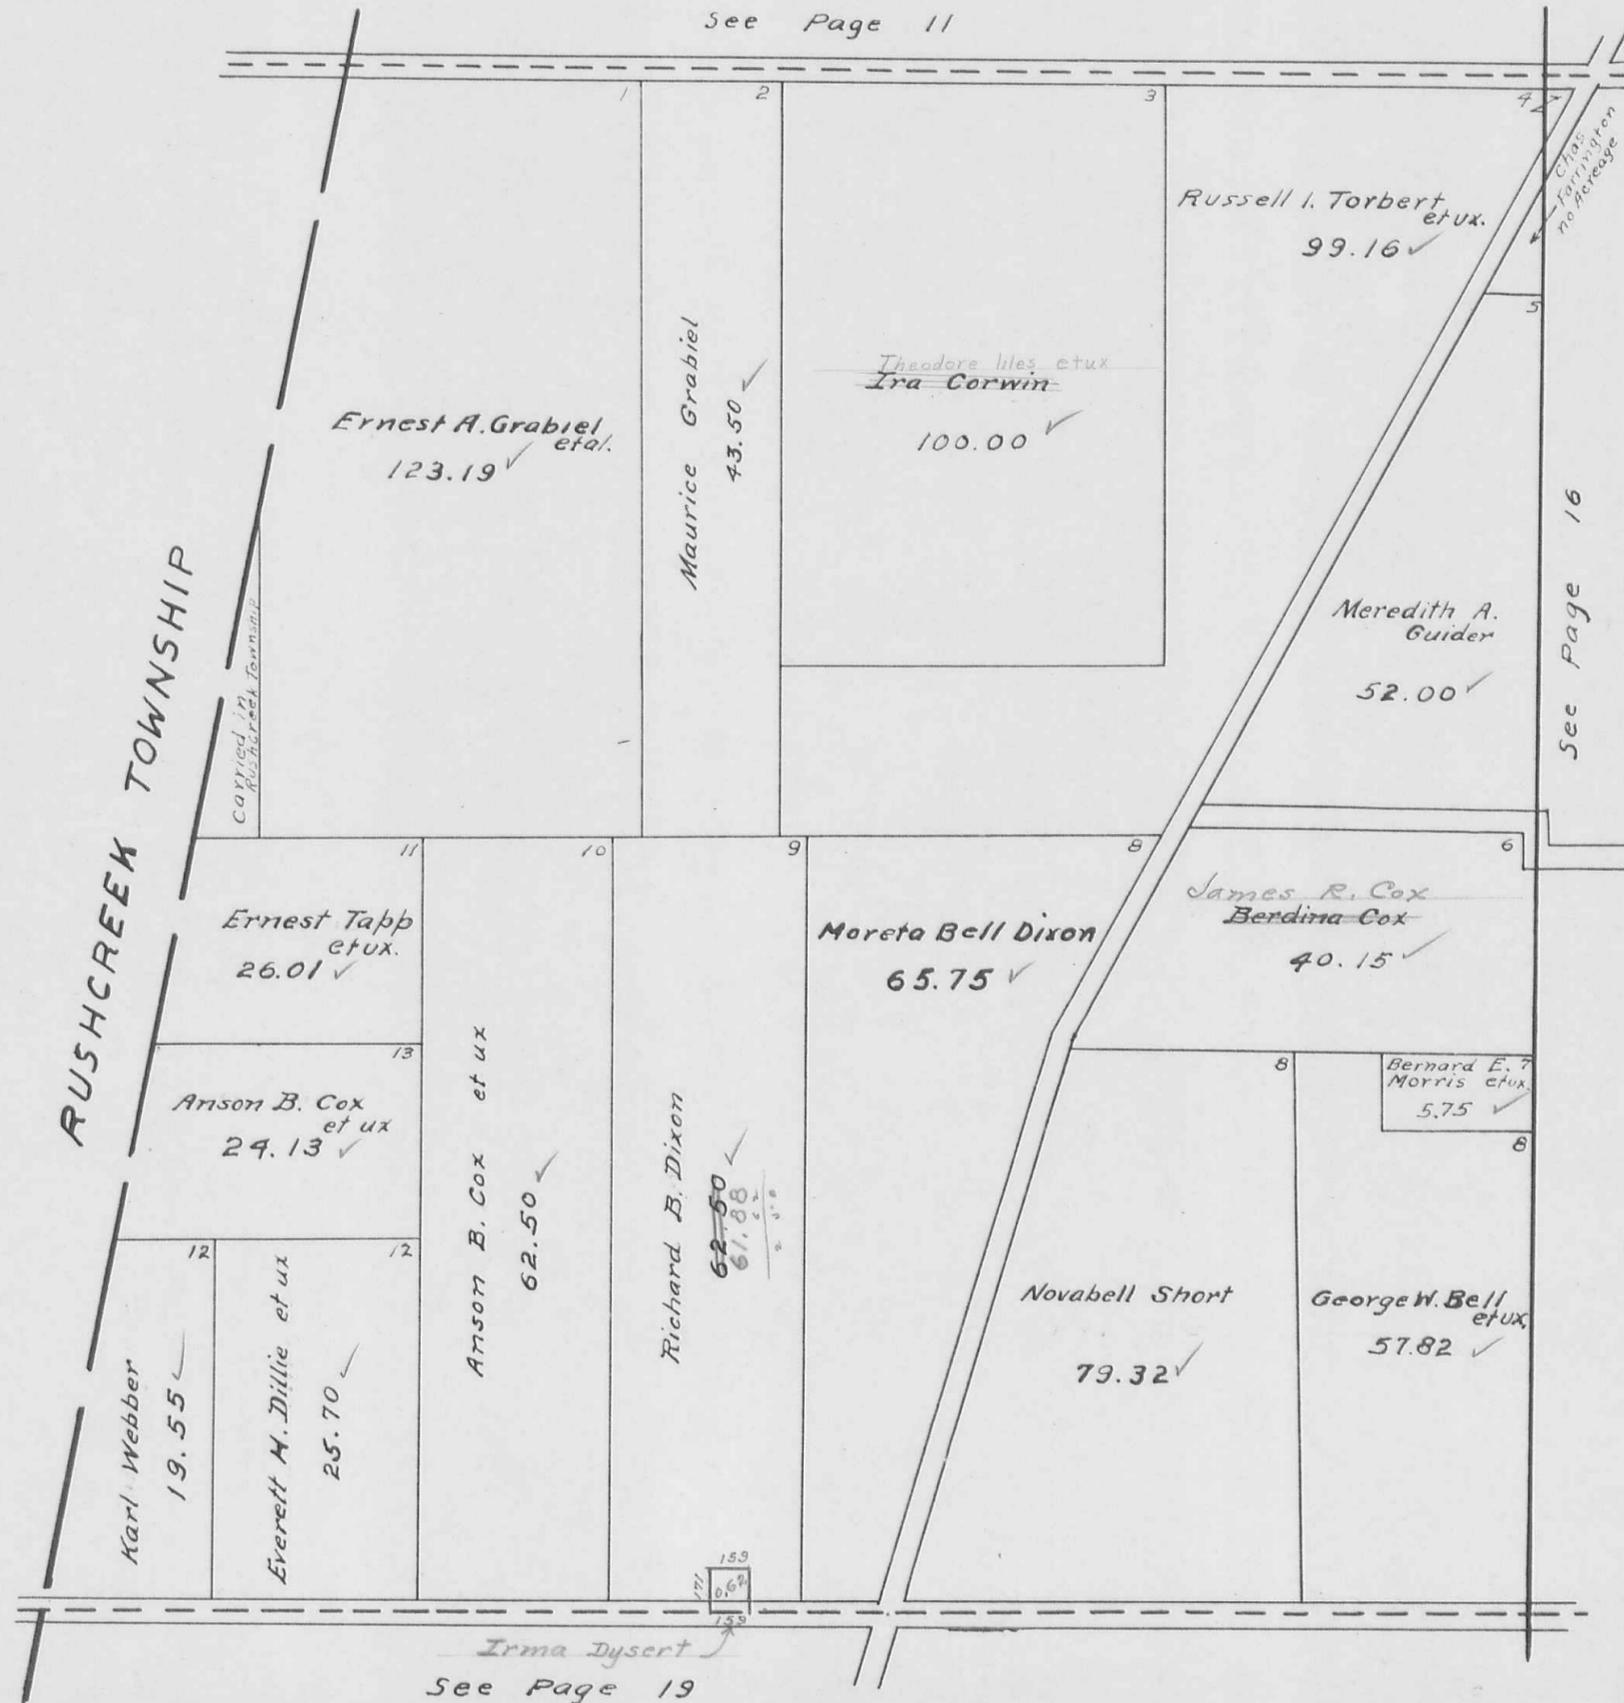

BOKESCREEK TOWNSHIP
VIRGINIA MILITARY SURVEY 9891

SCALE 10 CHAINS TO THE INCH

See Page 12

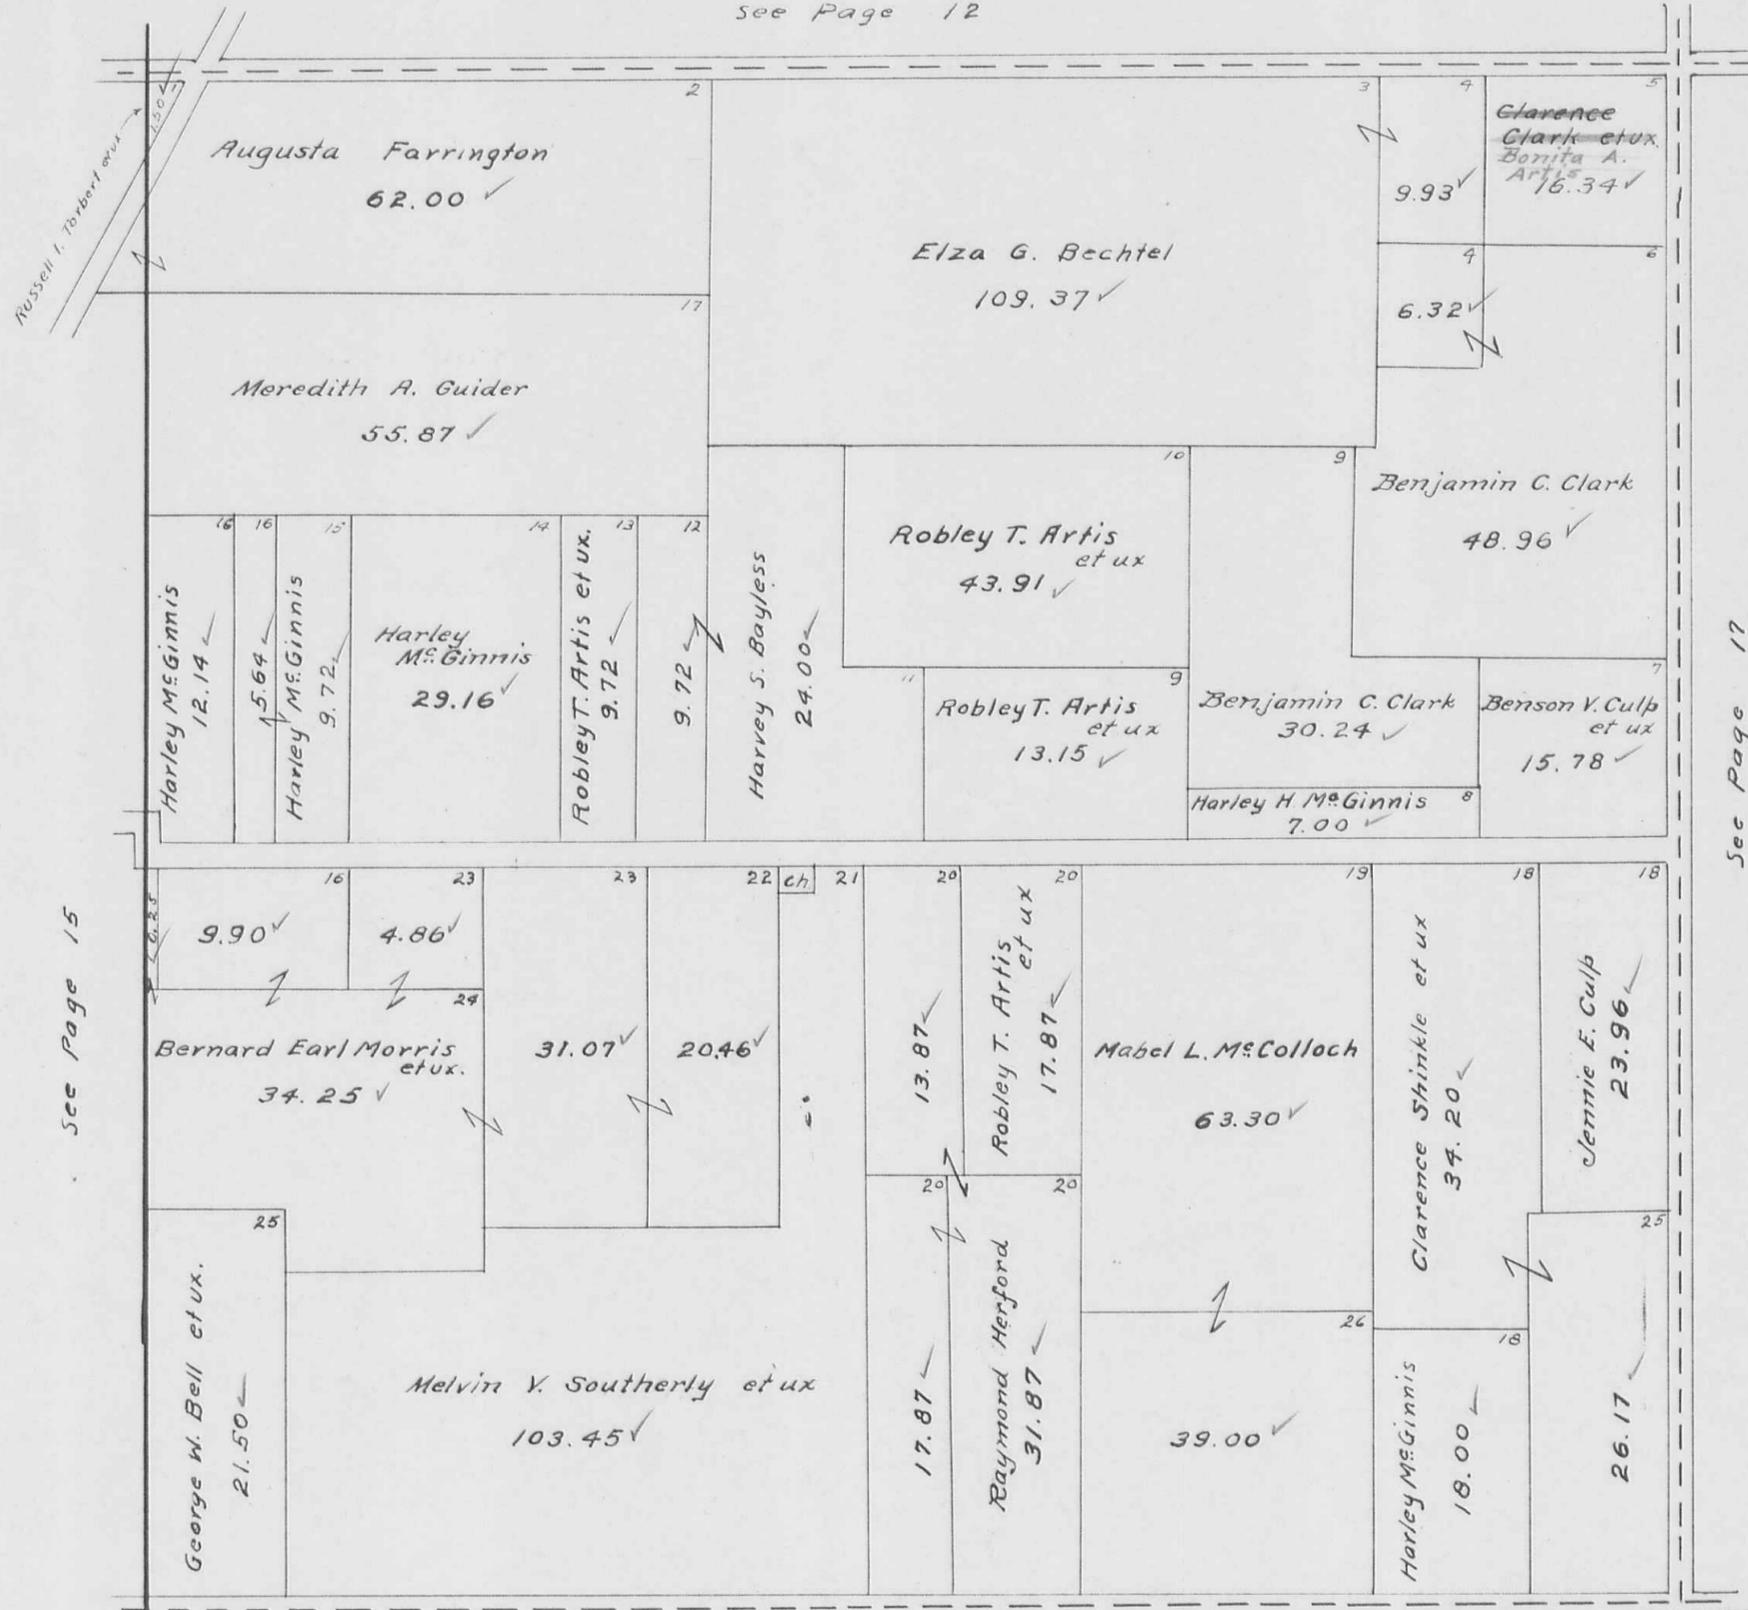

See Page 15


See Page 17

See Page 21

VIRGINIA MILITARY SURVEY 9892


SCALE 10 CHAINS TO THE INCH

See Page 13

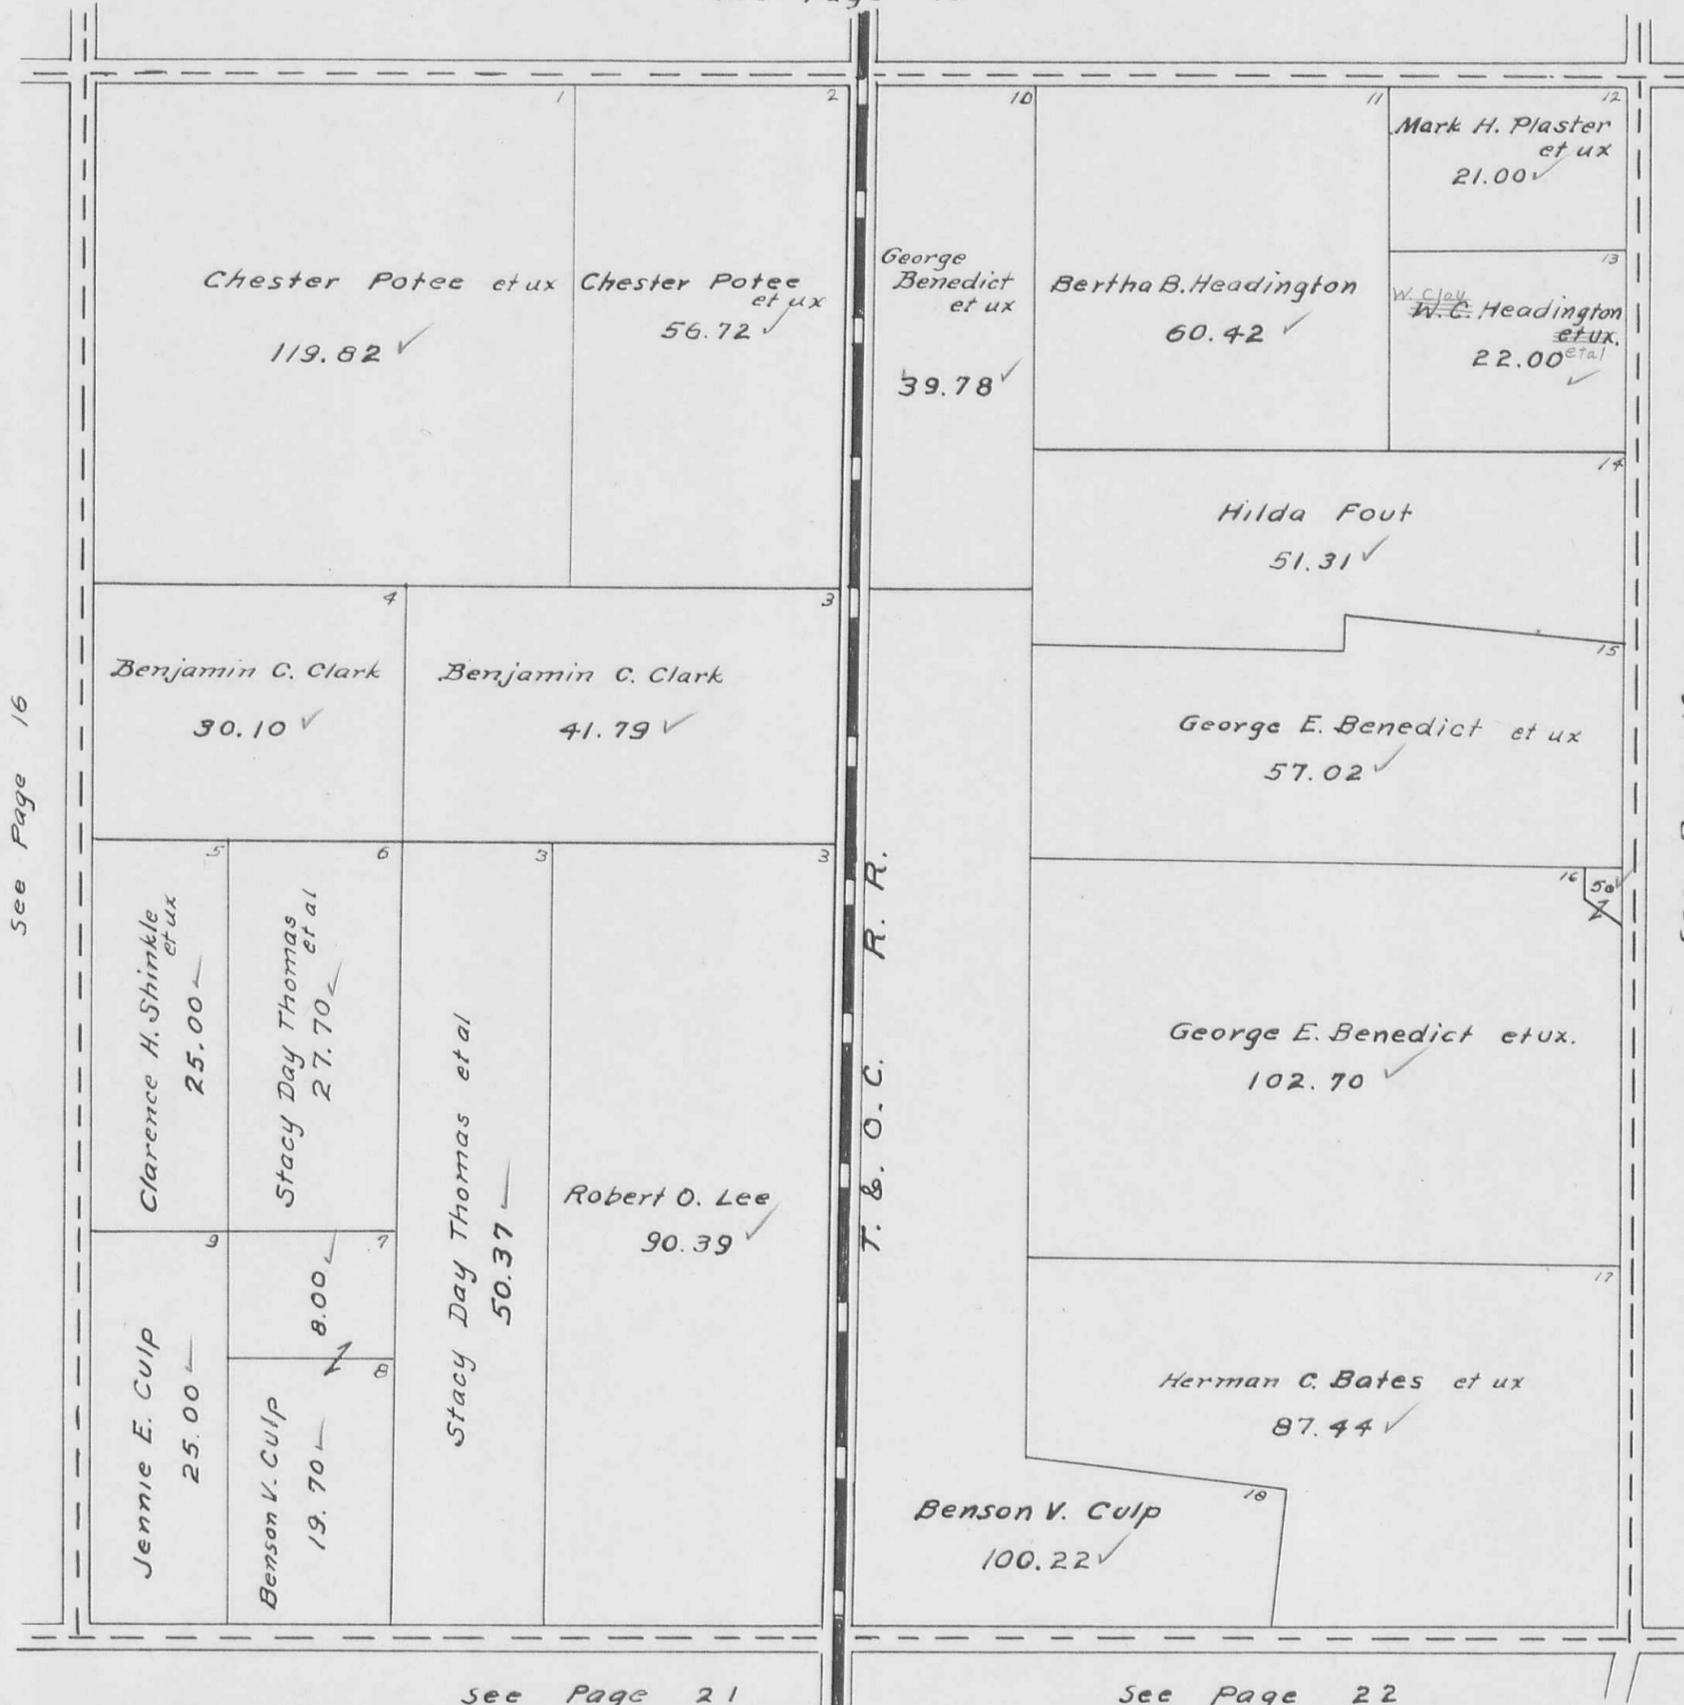

BOKE SCREEK TOWNSHIP
 VIRGINIA MILITARY SURVEY 9893

SCALE 10 CHAINS TO THE INCH

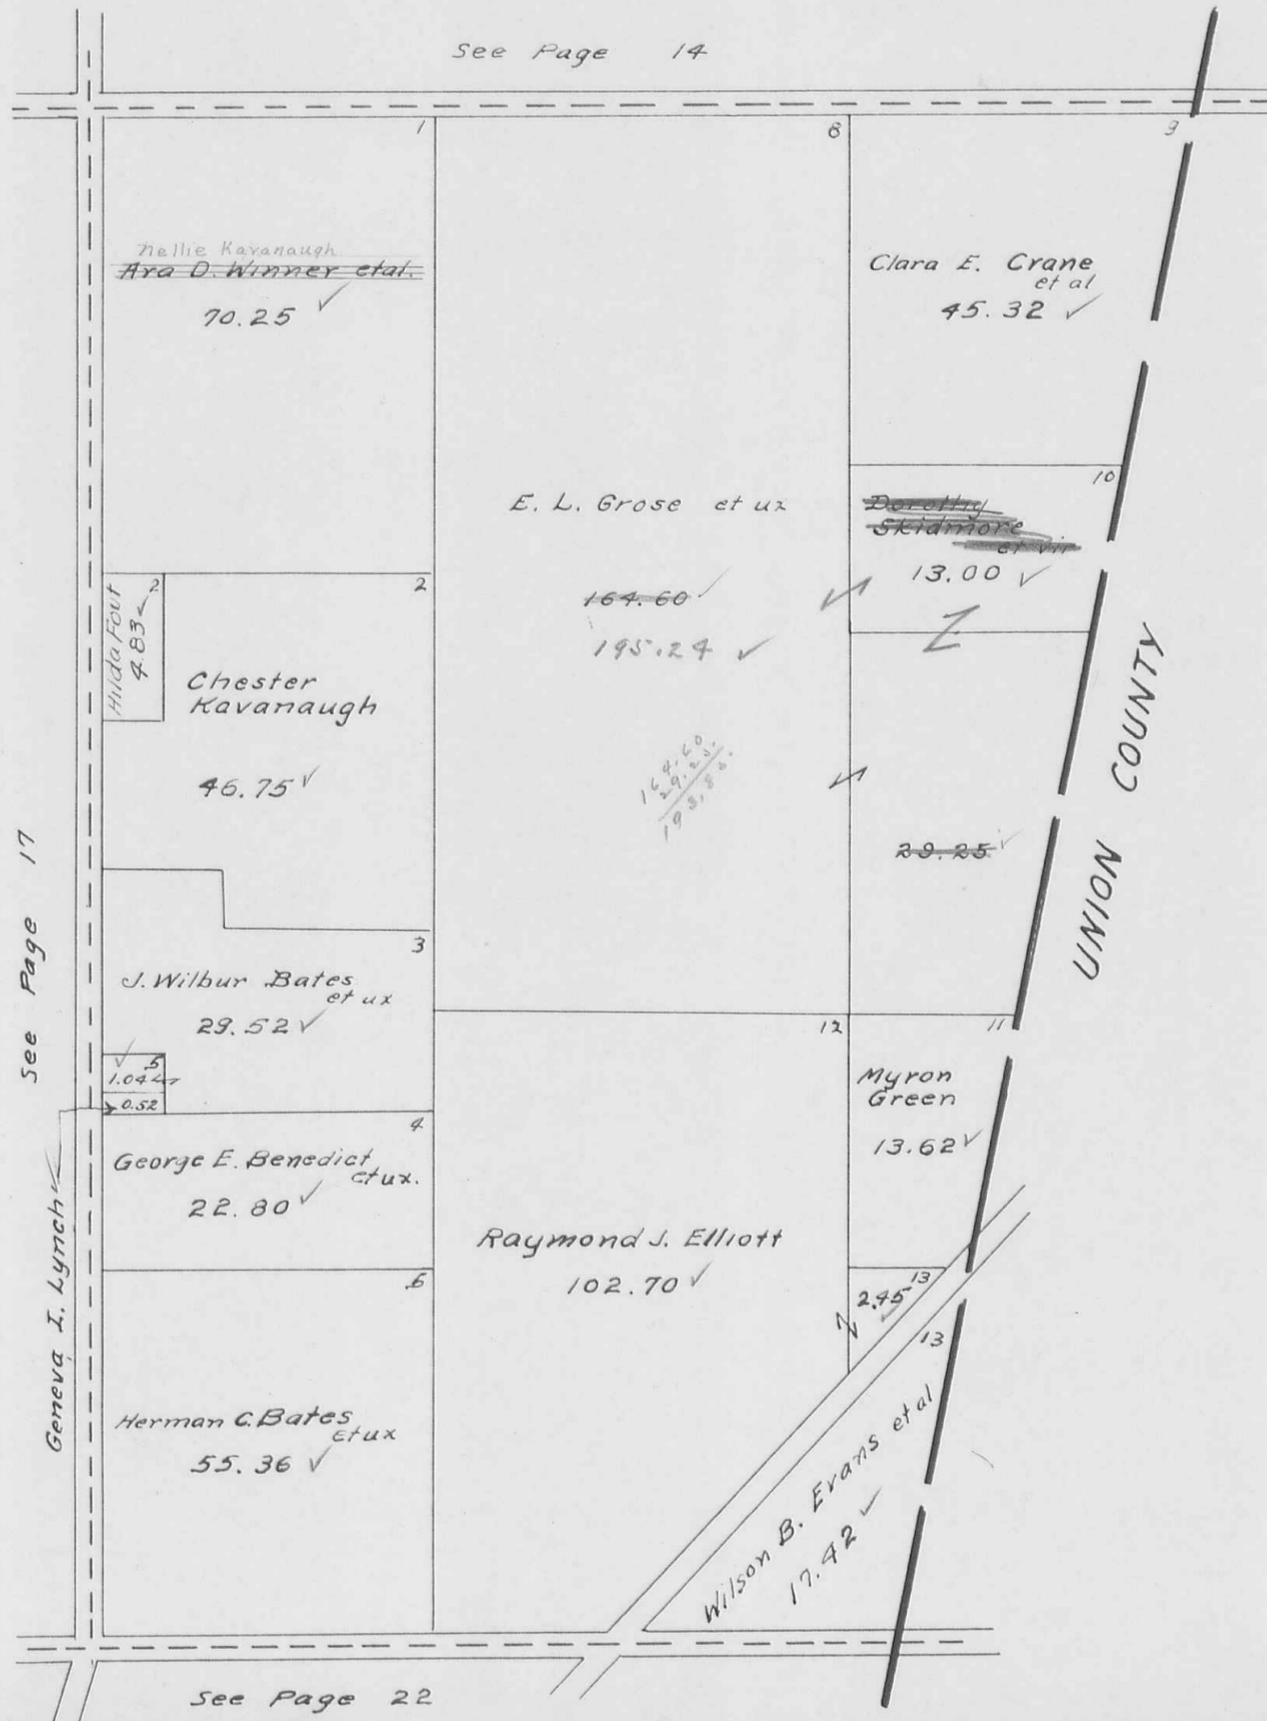


See Page 17

Geneva I. Lynch

BOKE SCREEK TOWNSHIP
VIRGINIA MILITARY SURVEYS

5288
13646
3472


SCALE 10 CHAINS TO THE INCH

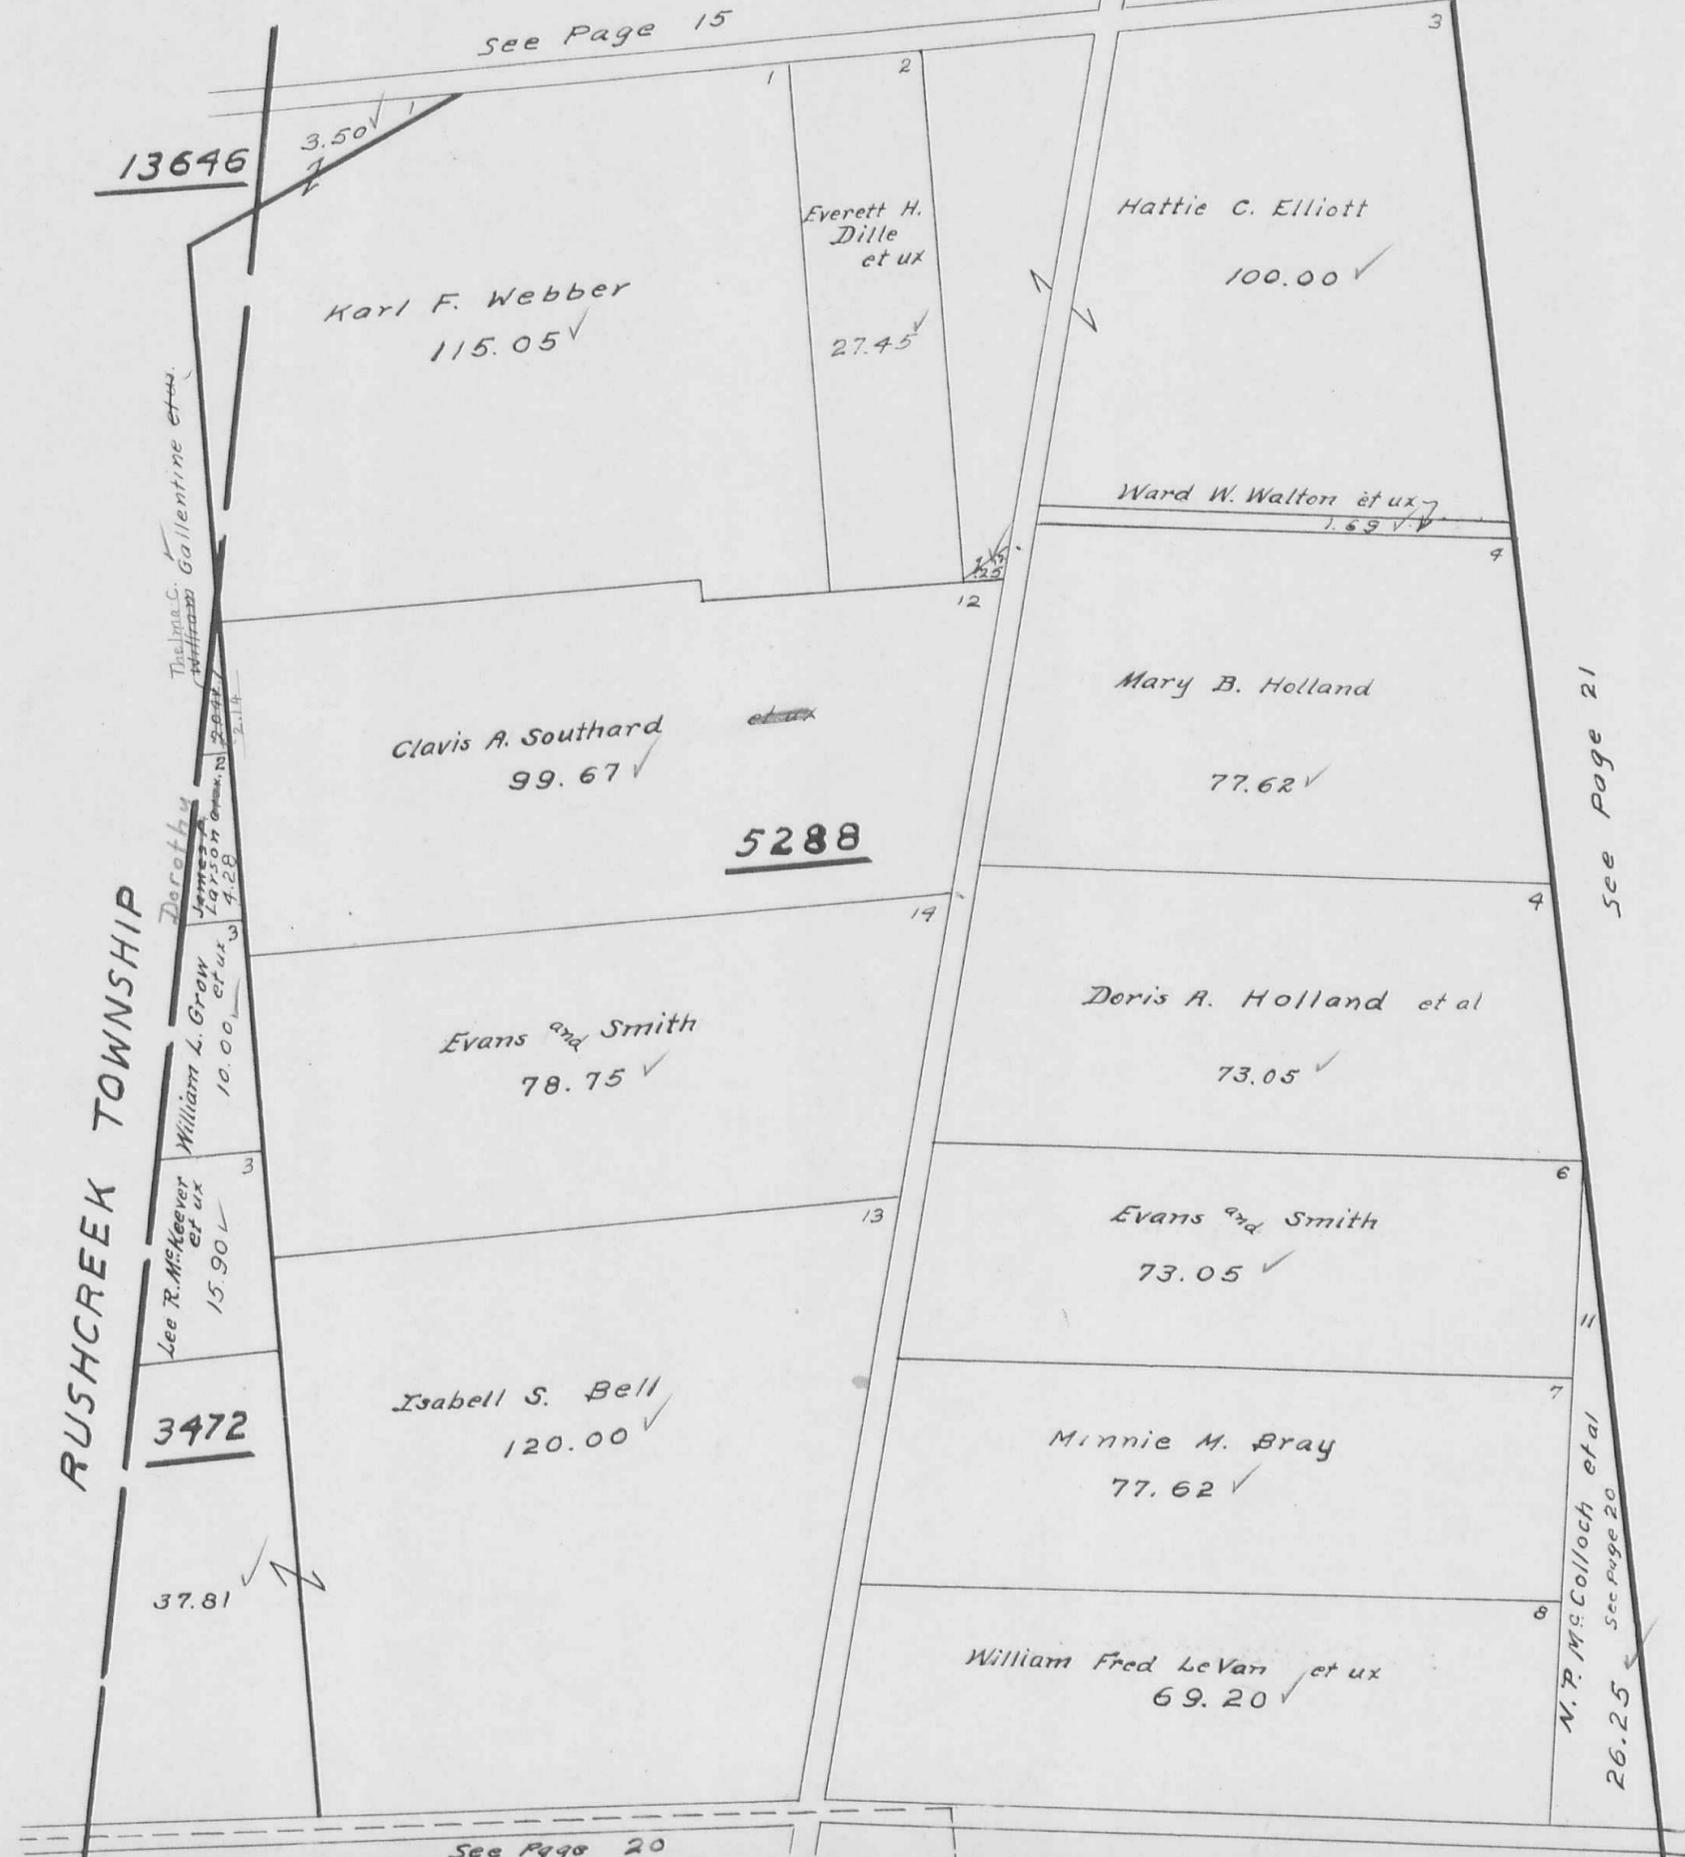

BOKESCREEK TOWNSHIP
VIRGINIA MILITARY SURVEYS

842
5288

SCALE 10 CHAINS TO THE INCH

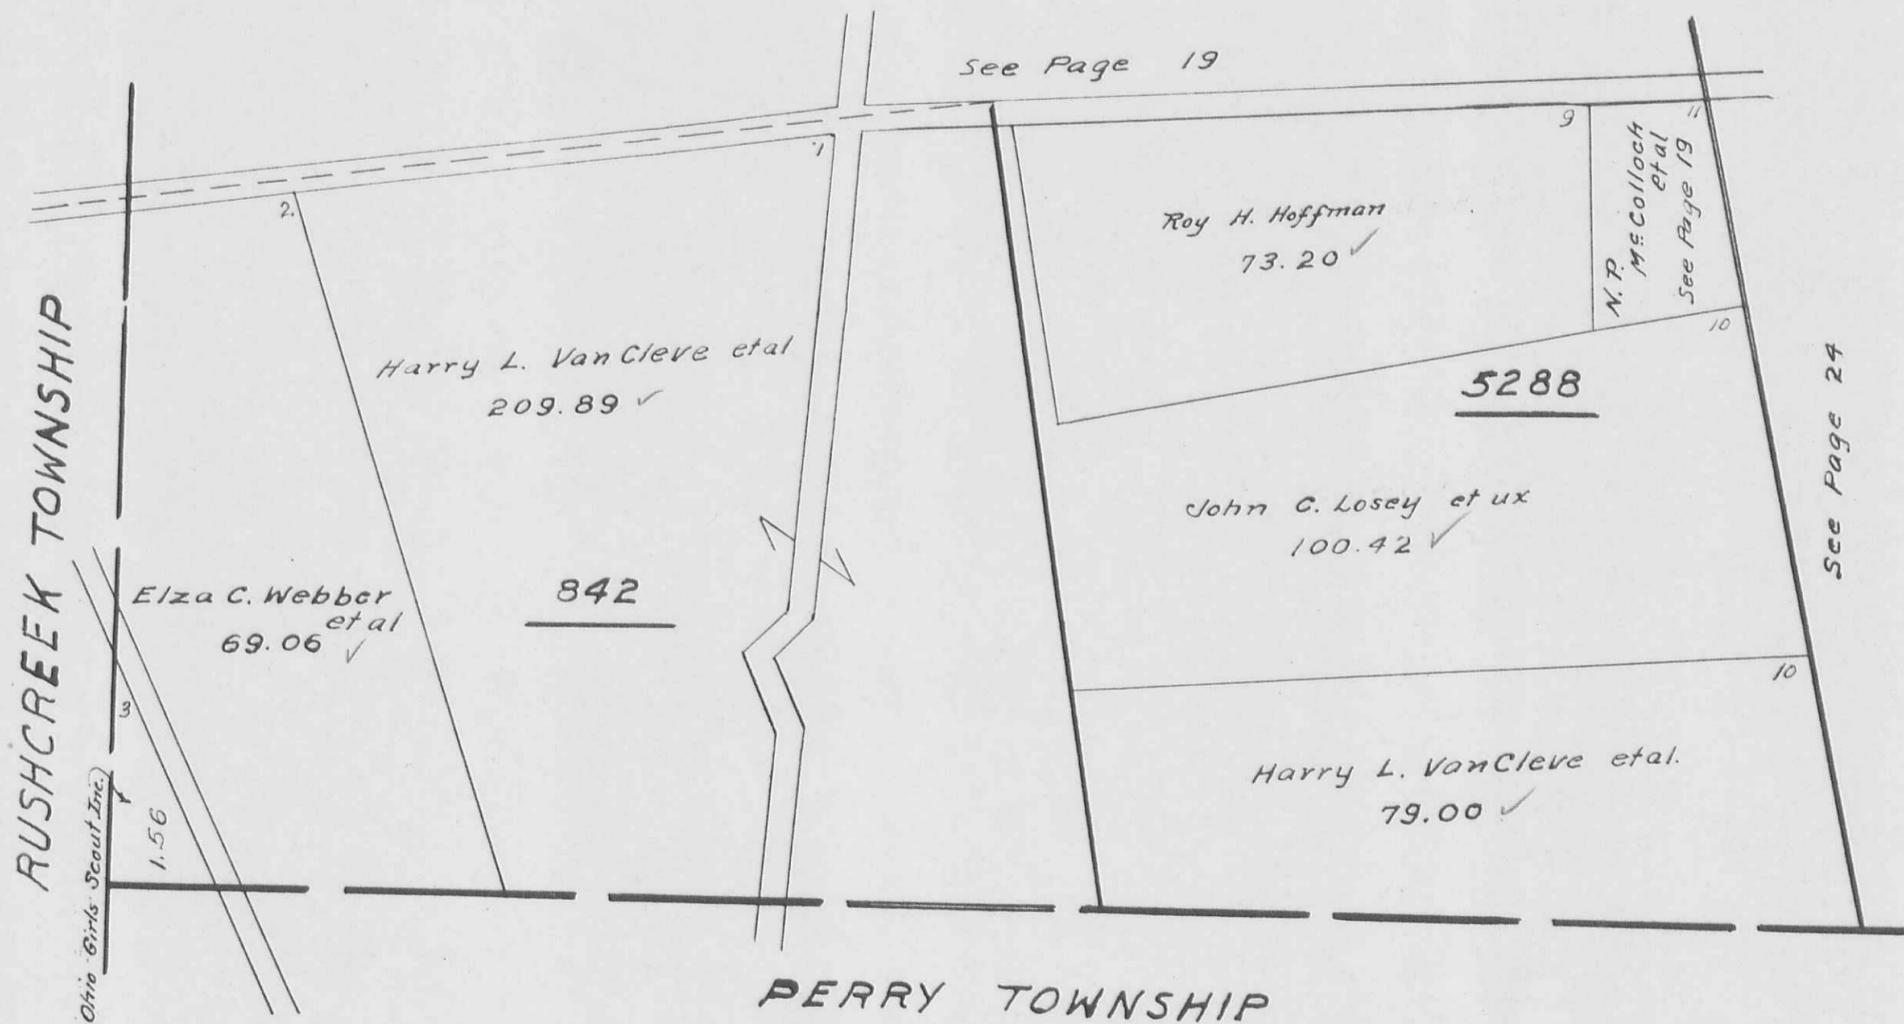

SCALE 10 CHAINS TO THE INCH

See Pages 15-16-17

T&O.C.
R.R.

Ward W. Walton et ux

1441.01 ✓

See Page 19


See Pages 22 - 23

See Page 23

G. W. Wilgus

BOKESCREEK TOWNSHIP
VIRGINIA MILITARY SURVEY 6154


SCALE 10 CHAINS TO THE INCH

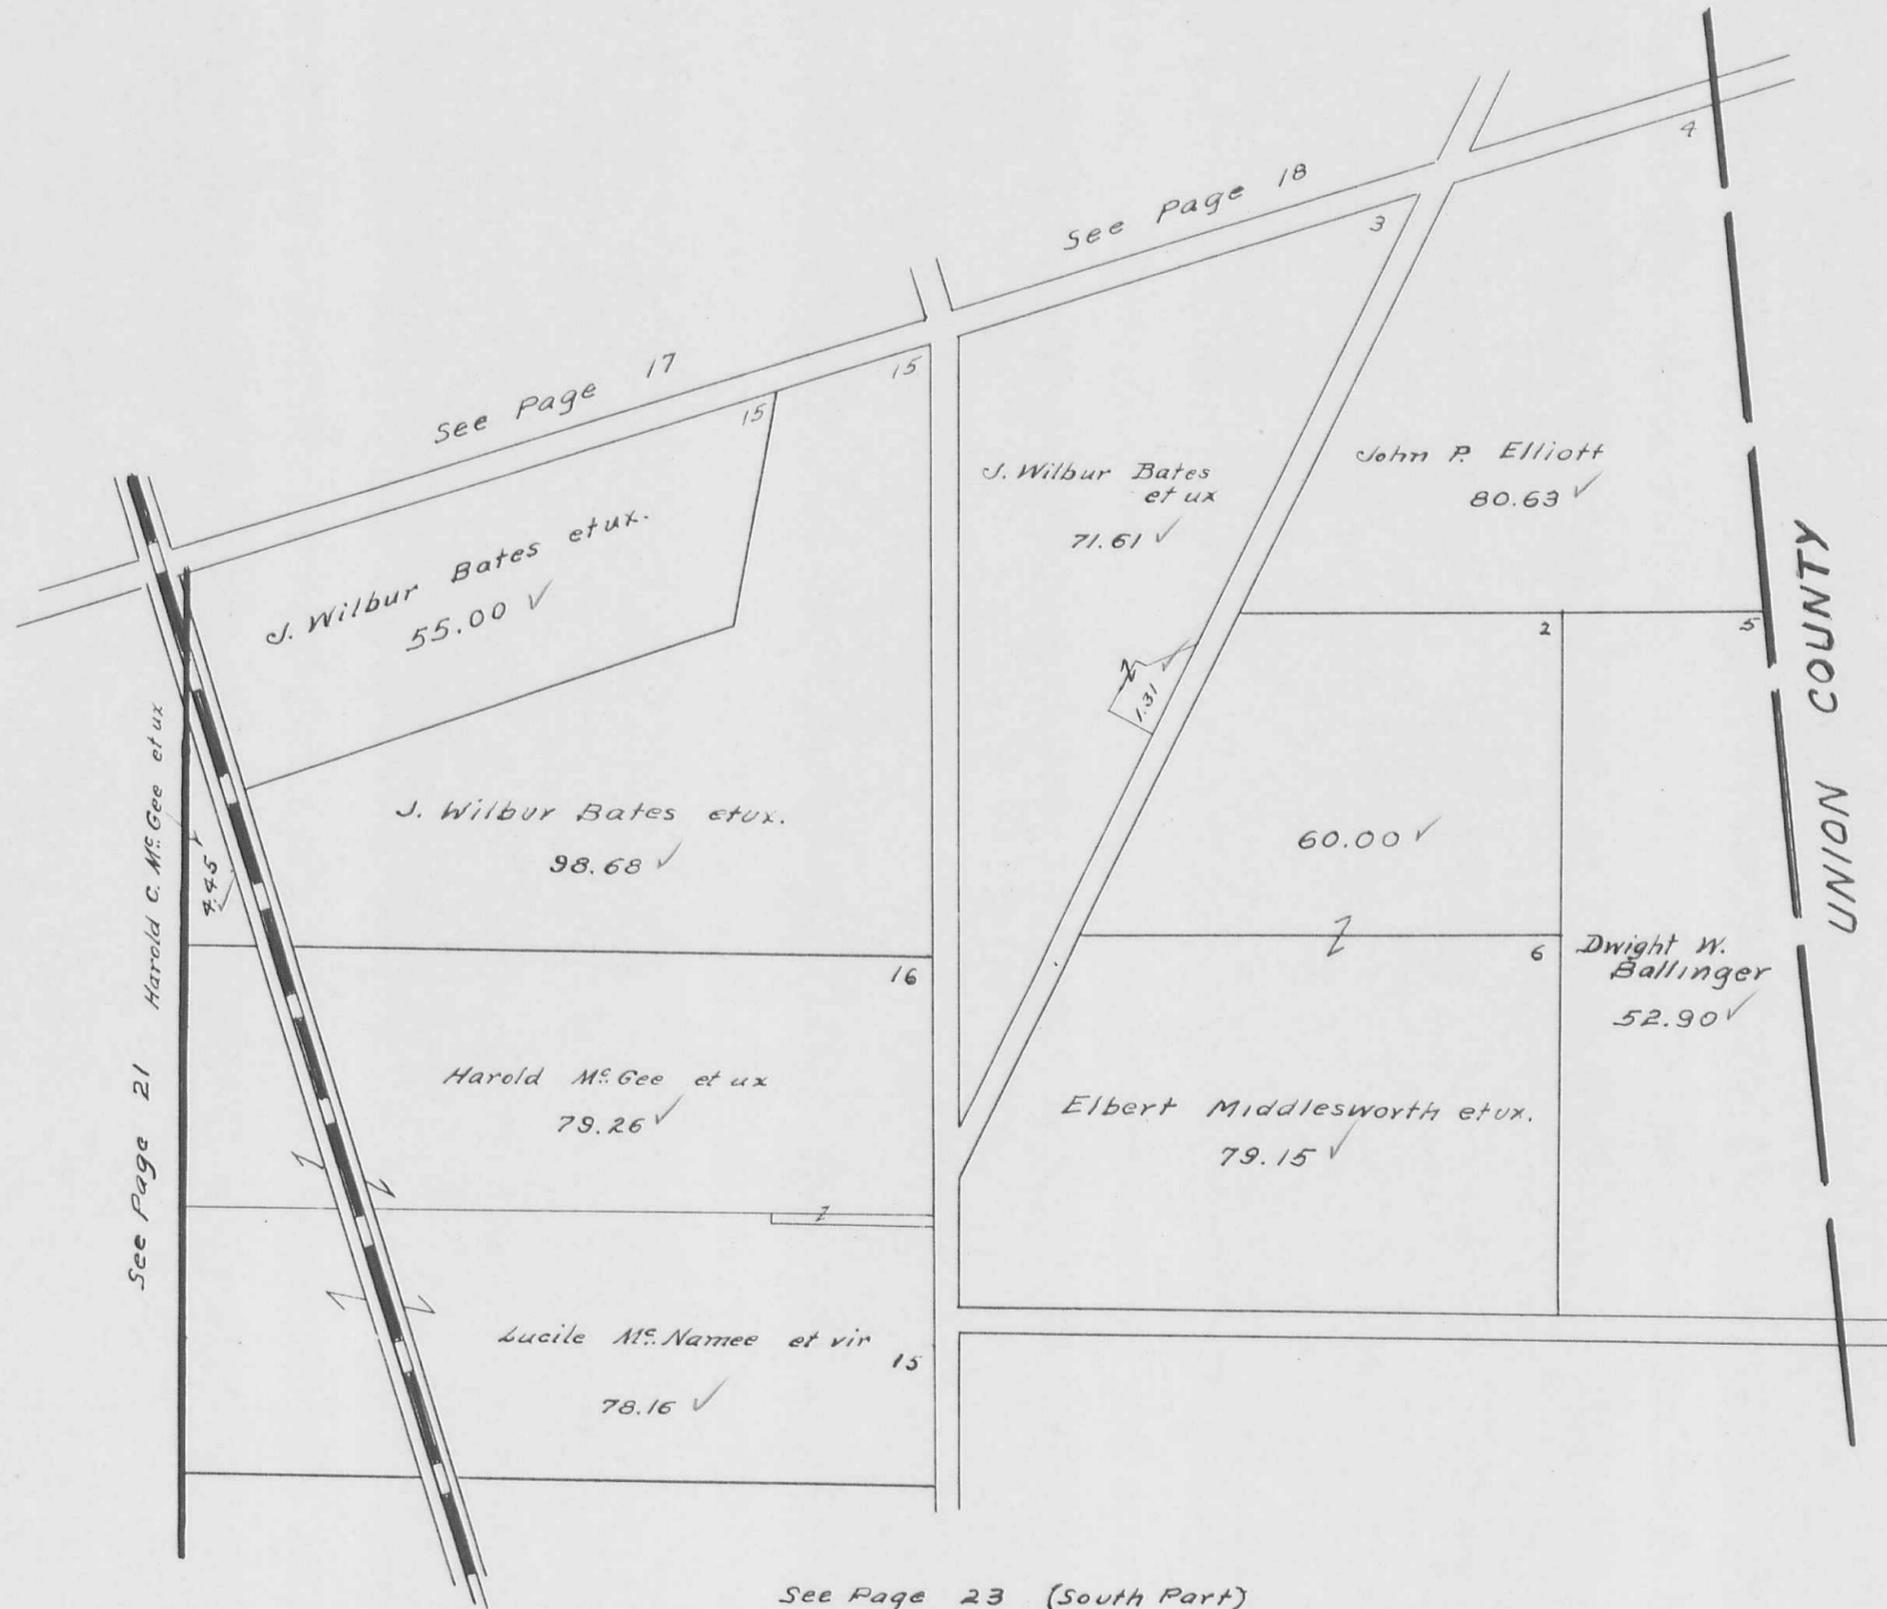

BOKESCREEK TOWNSHIP
 VIRGINIA MILITARY SURVEY 6154

SCALE 10 CHAINS TO THE INCH

See Page 22 (North Part)

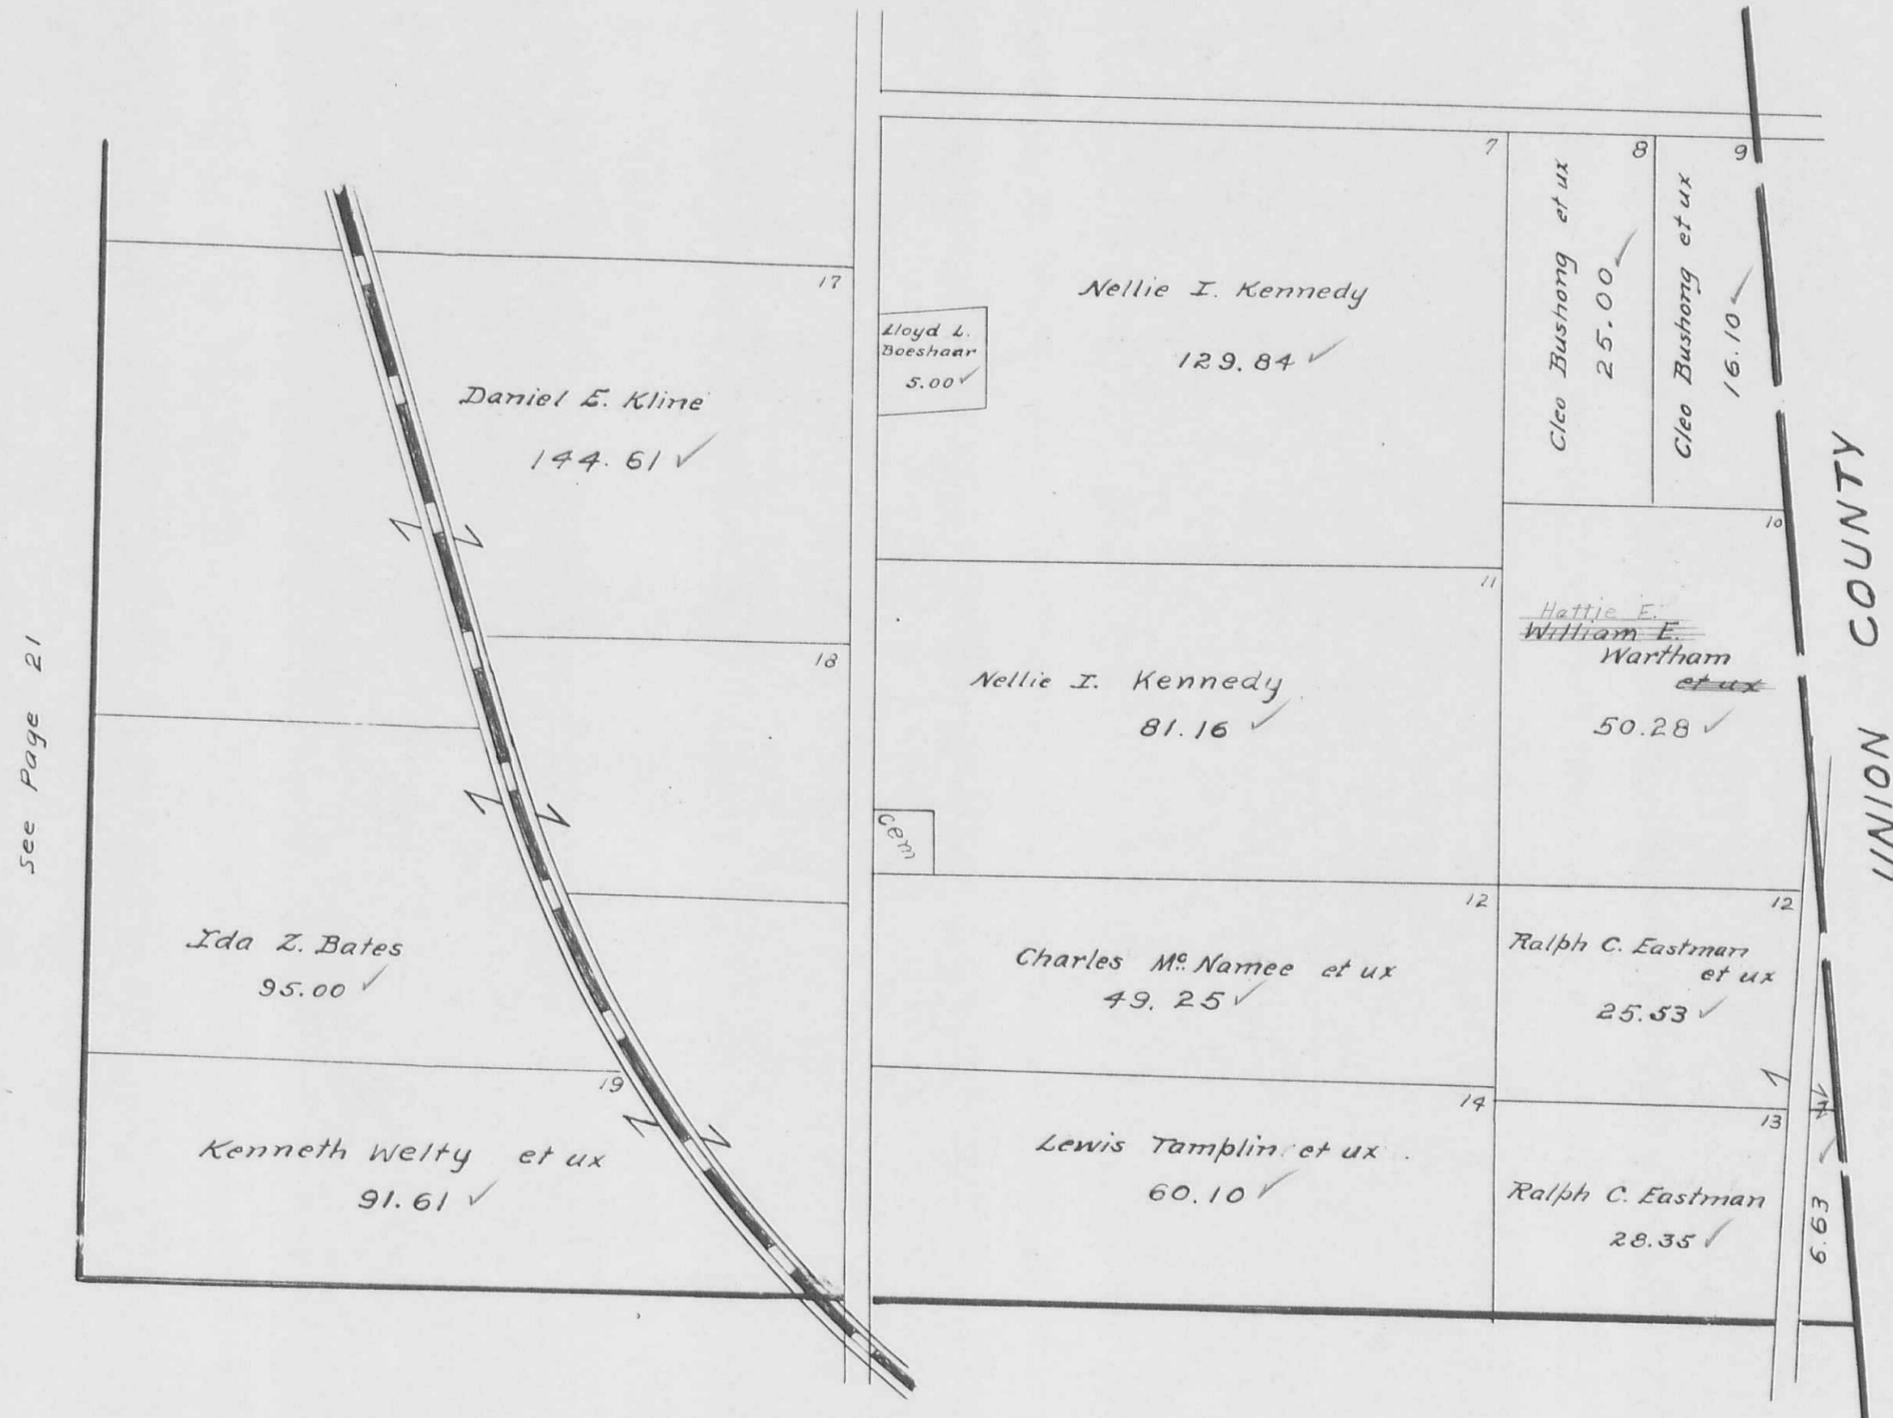


BOKESCREEK TOWNSHIP
VIRGINIA MILITARY SURVEYS

13068
6251

SCALE 10 CHAINS TO THE INCH

See Page 21

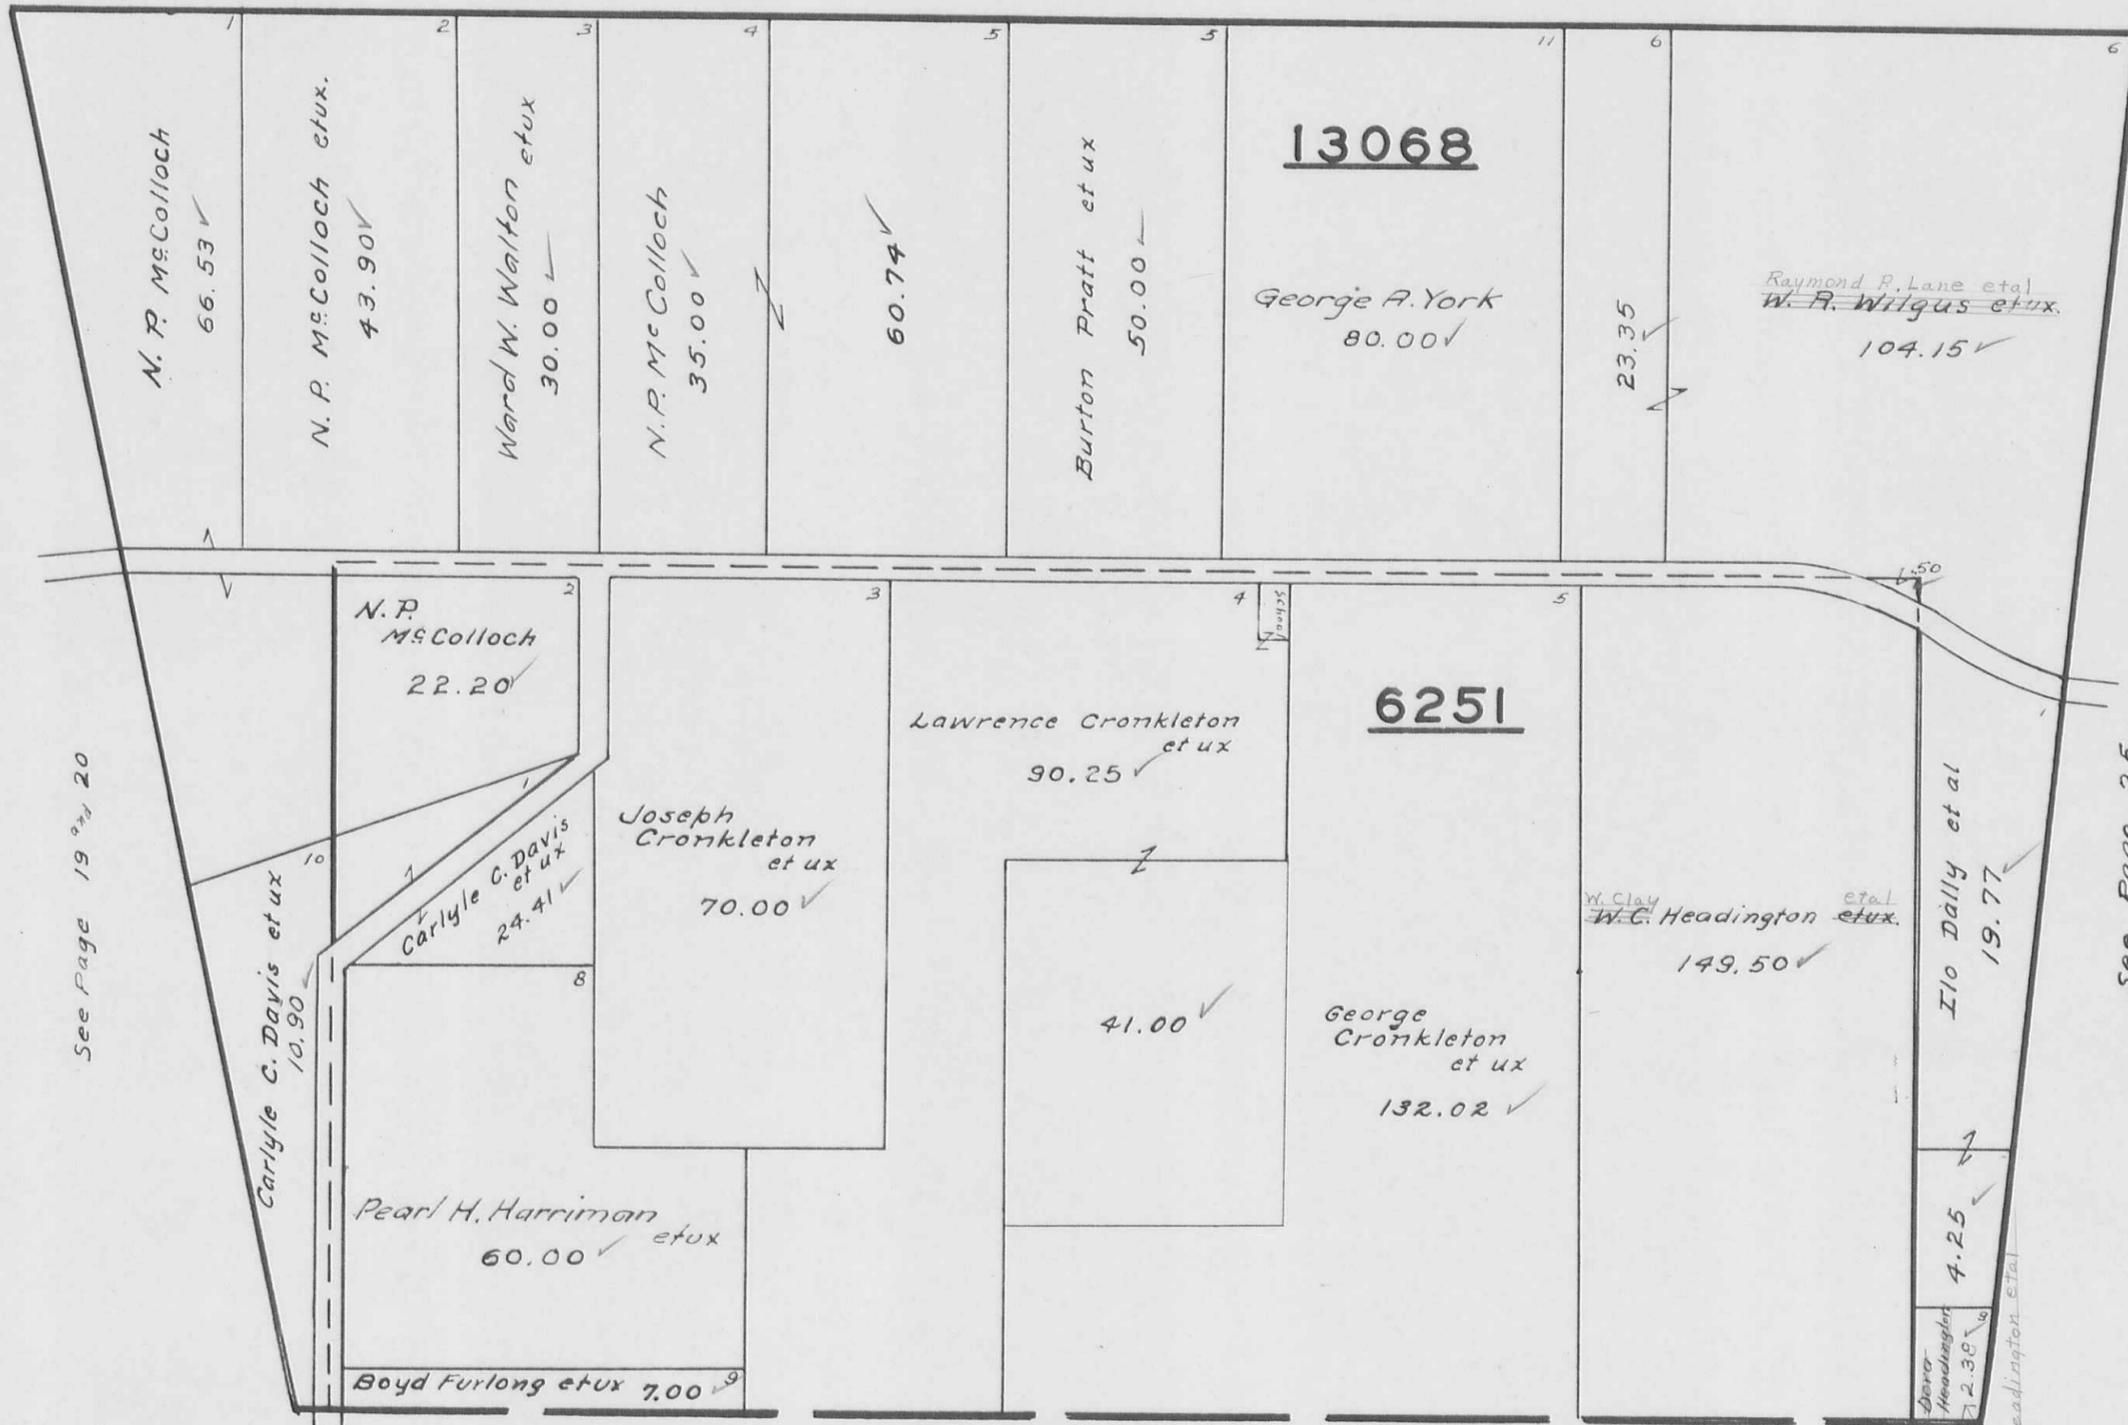

See Page 19 & 20

See Page 25


PERRY TOWNSHIP

BOKESCREEK TOWNSHIP
VIRGINIA MILITARY SURVEYS

775
6155

SCALE 10 CHAINS TO THE INCH

48 71
40 42
31 22

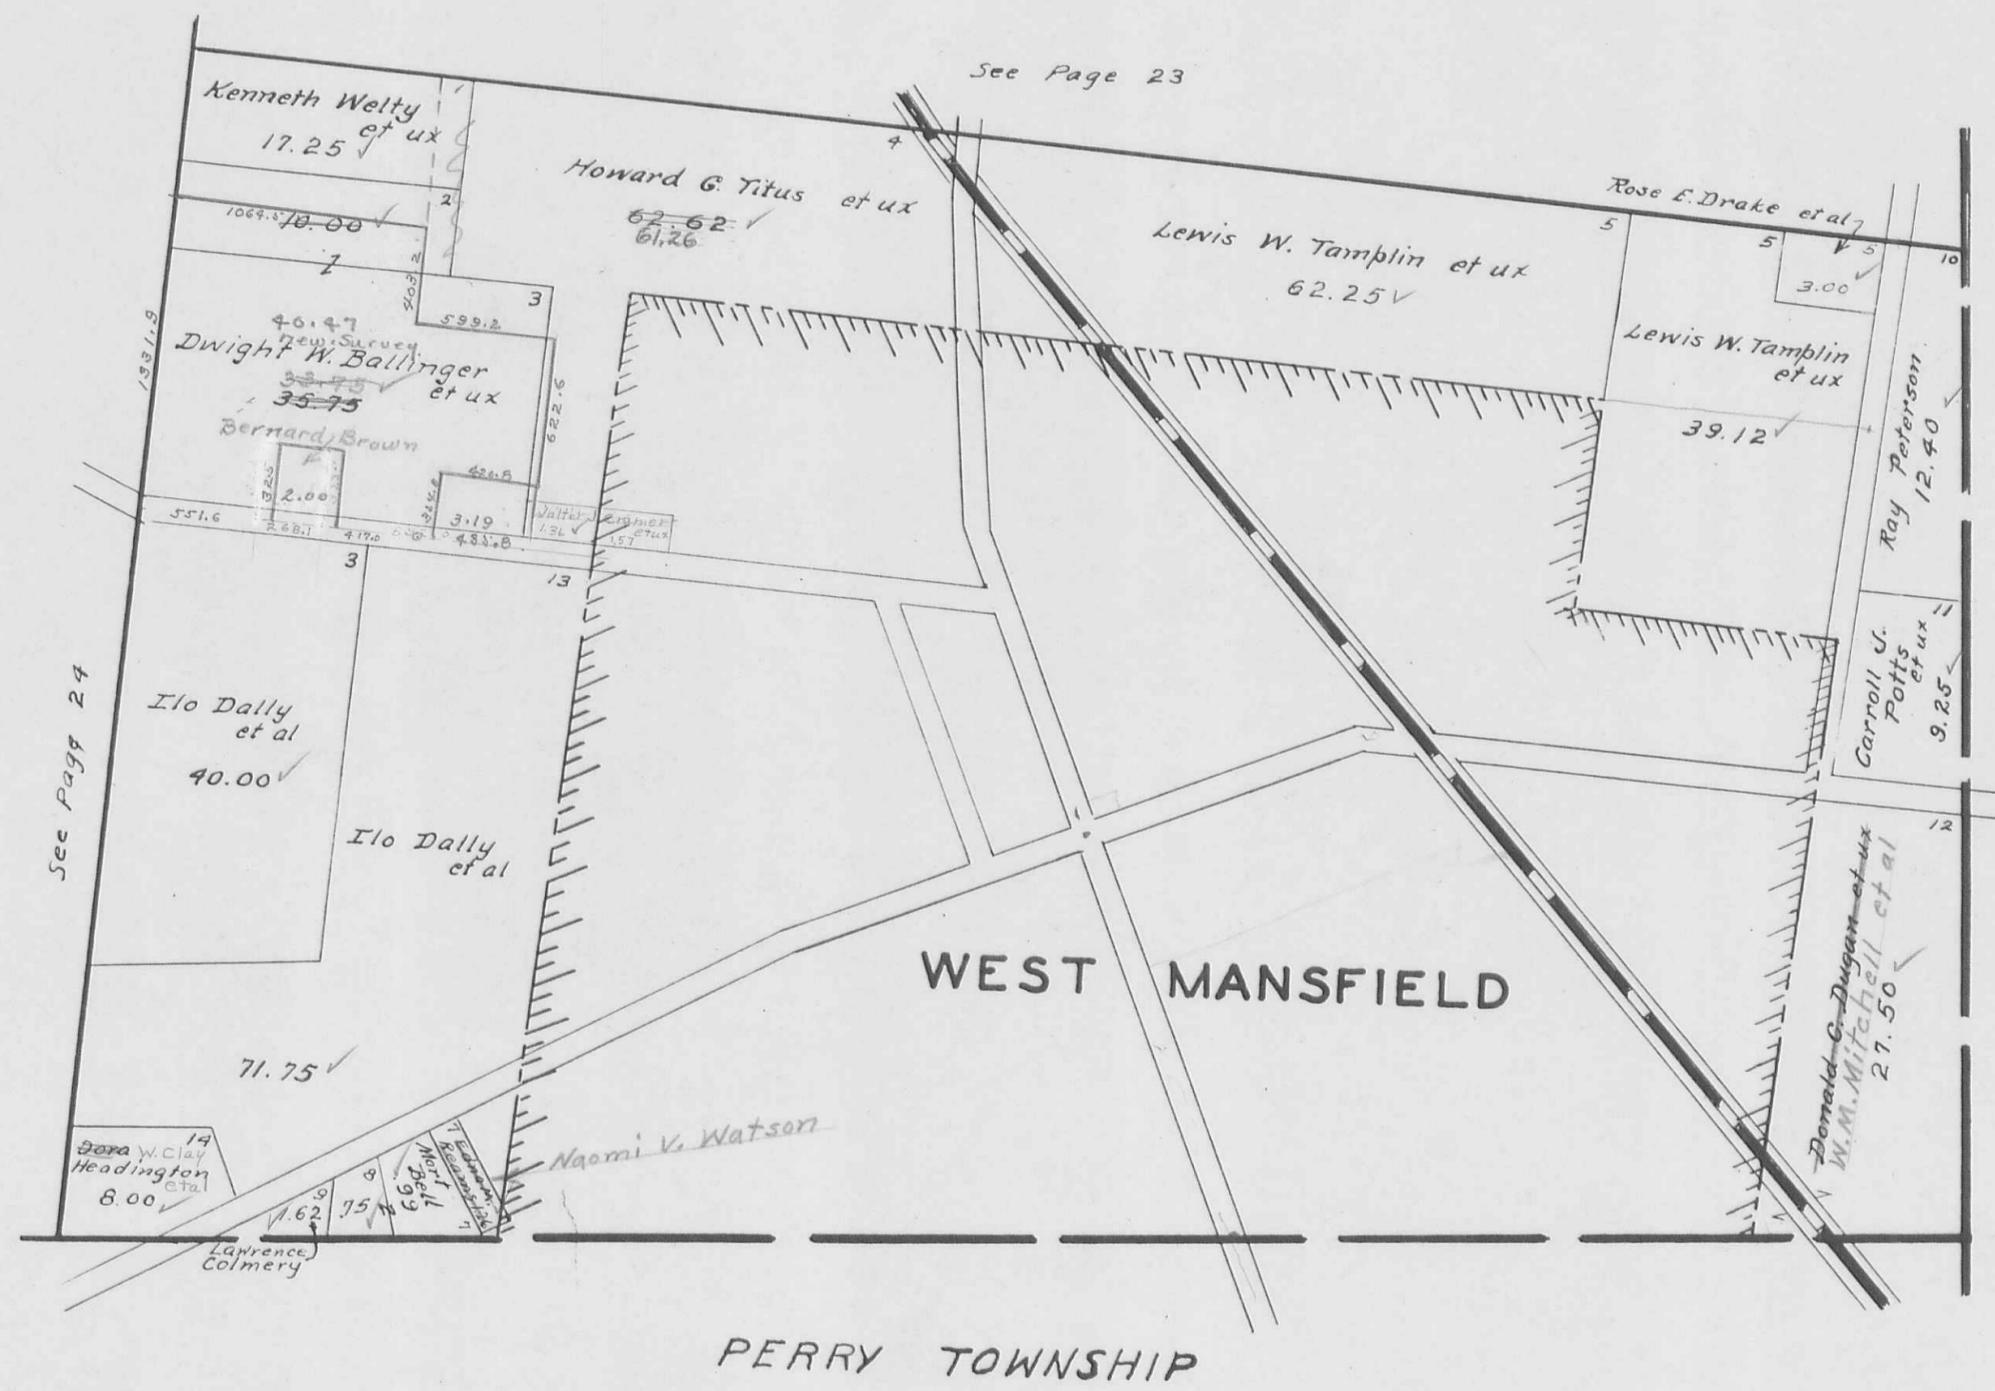

See Page 24

See Page 23

WEST MANSFIELD

UNION COUNTY

PERRY TOWNSHIP

BOKES CREEK TOWNSHIP
 VIRGINIA MILITARY SURVEY 10239

SCALE 1-INCH = 200 FEET

HARDIN COUNTY







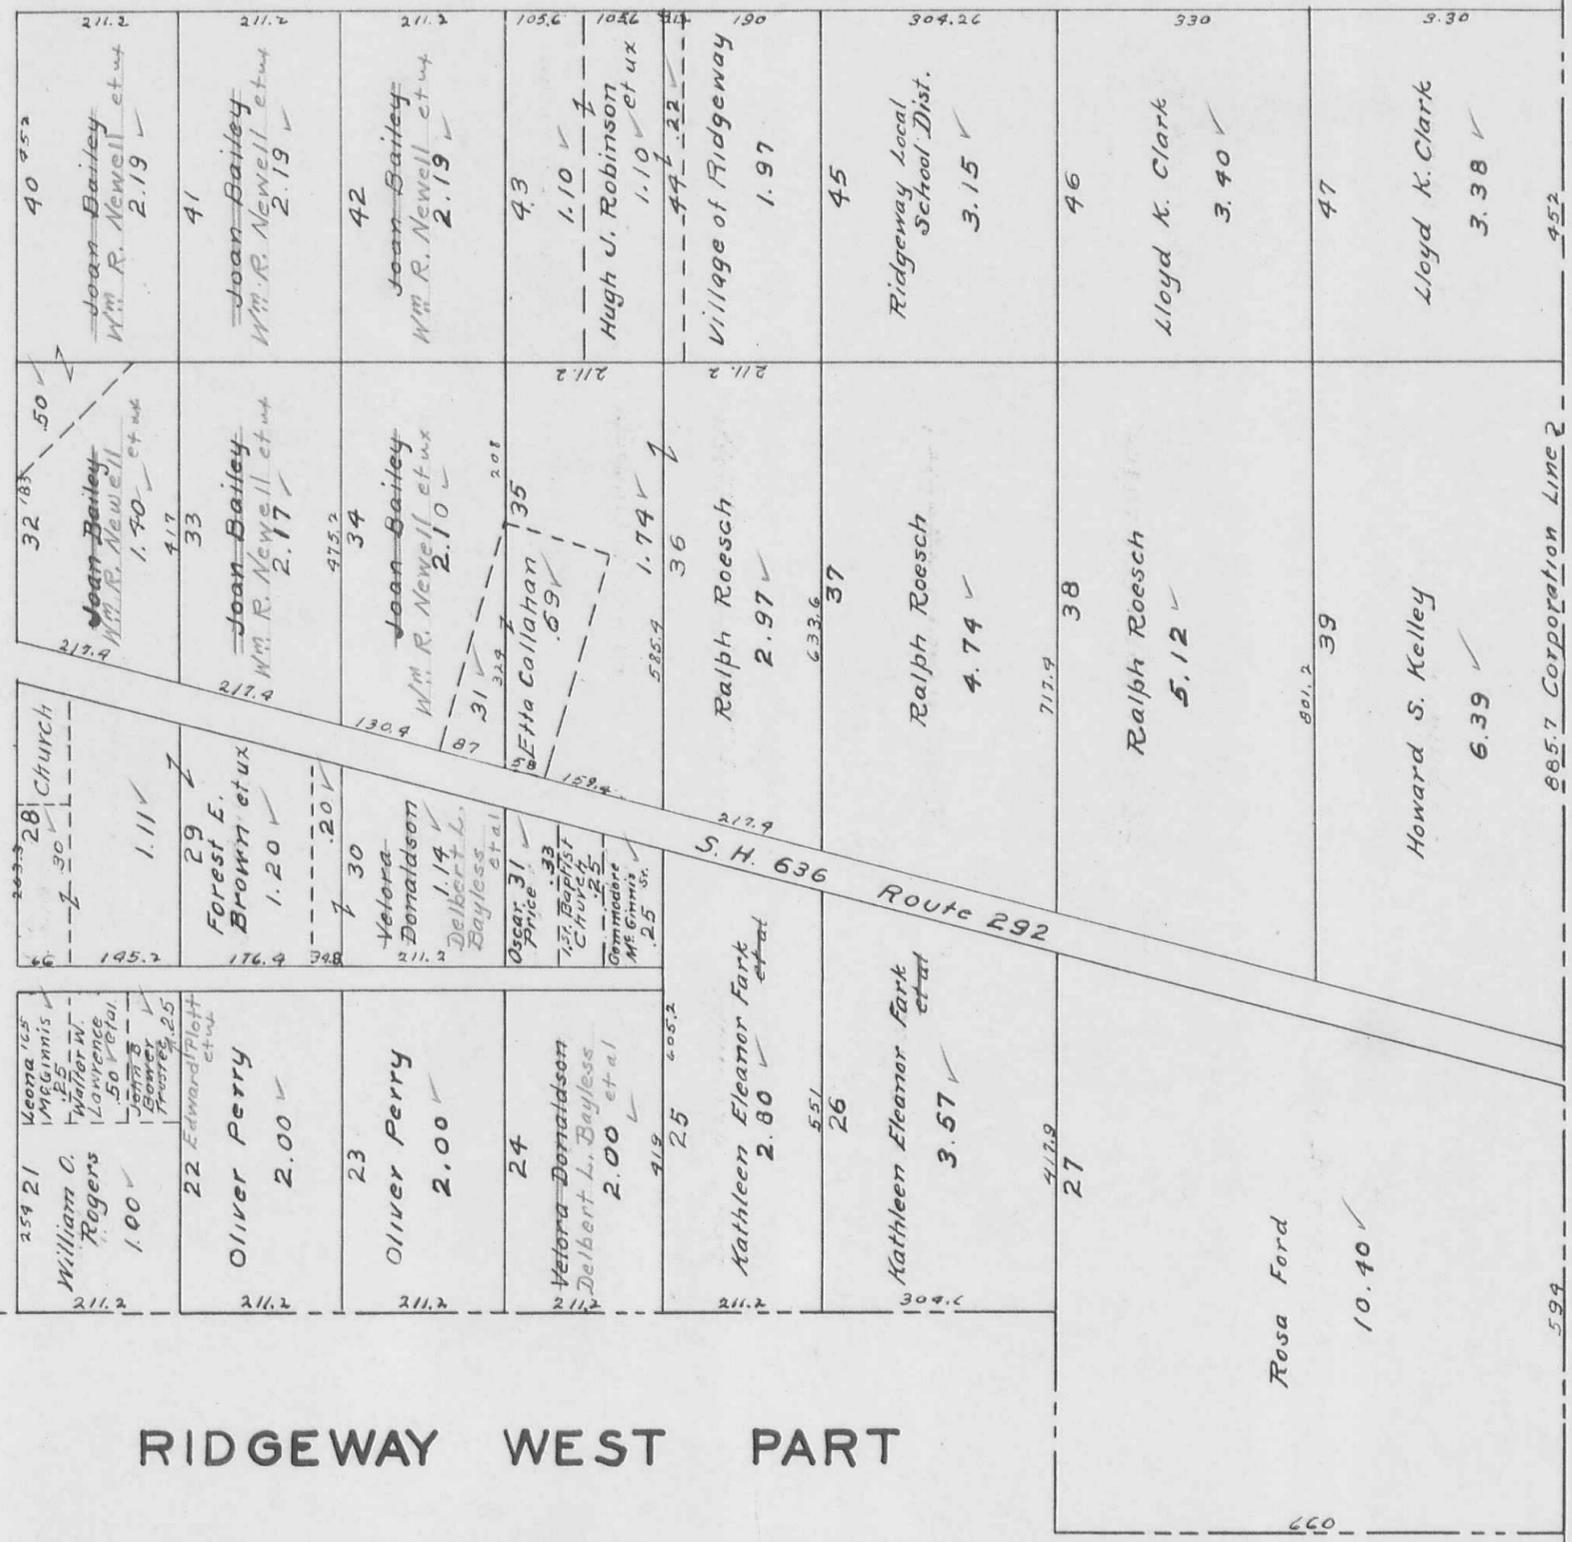

RIDGEWAY WEST PART

C. H. No. 40
 C. H. No. 121
 885.7 Corporation Line 2

120.4
 217.4

VIRGINIA MILITARY SURVEY 10239


SCALE 1-INCH = 200 FEET

T. & O. C. R. R.

Charley Whetsel et ux
13.00

H.O. Stump .12

Corporation Line P

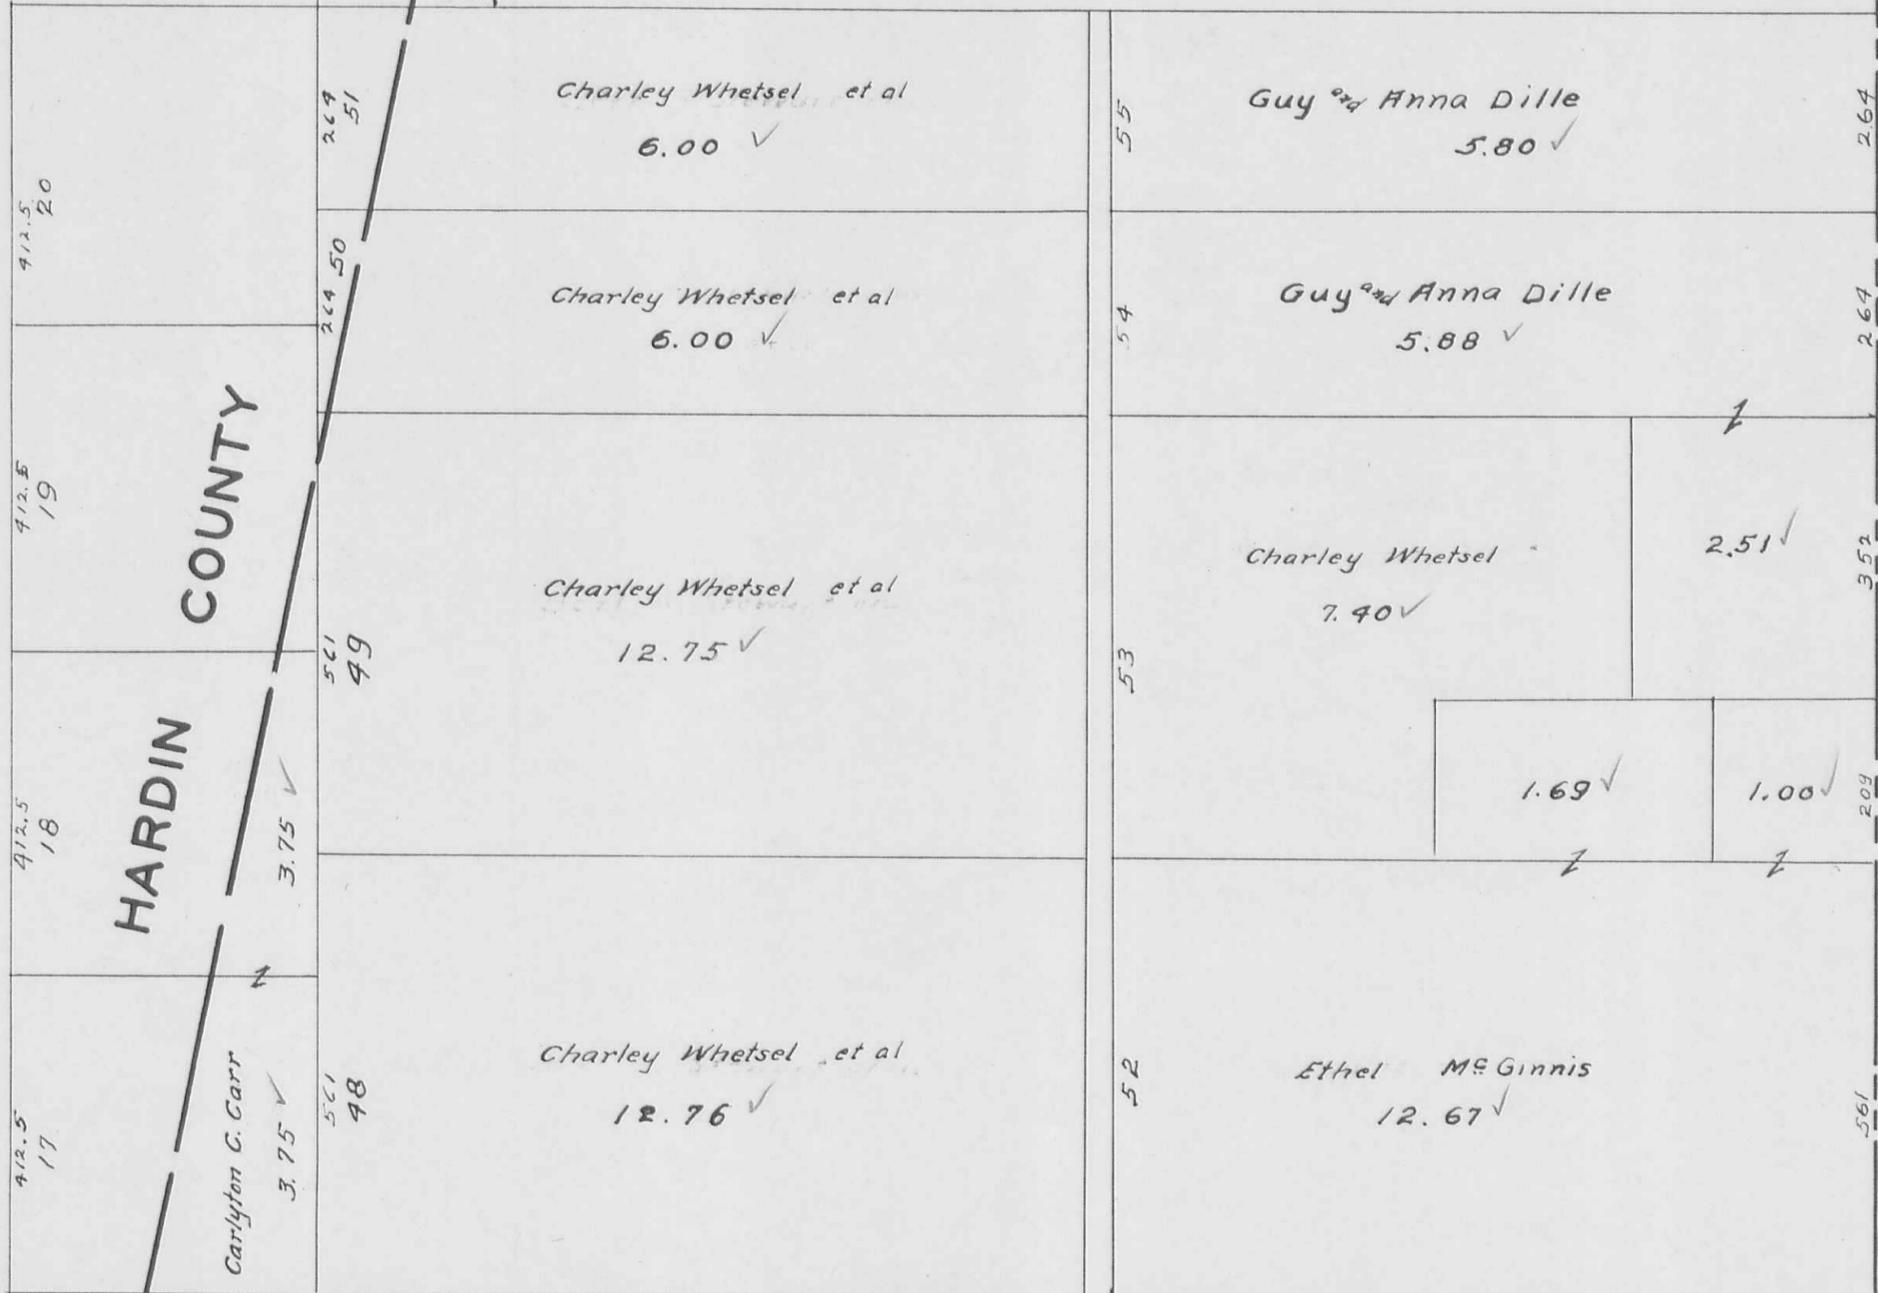

HARDIN COUNTY

RIDGEWAY EAST PART

VIRGINIA MILITARY SURVEYS 755 6155

SCALE 1-INCH = 200 FEET


CORRECTED TO Jan: 1, 1956 Jan: 1-1958

WEST MANSFIELD CORPORATION

SUBS 1 TO 56 INCLUSIVE



92

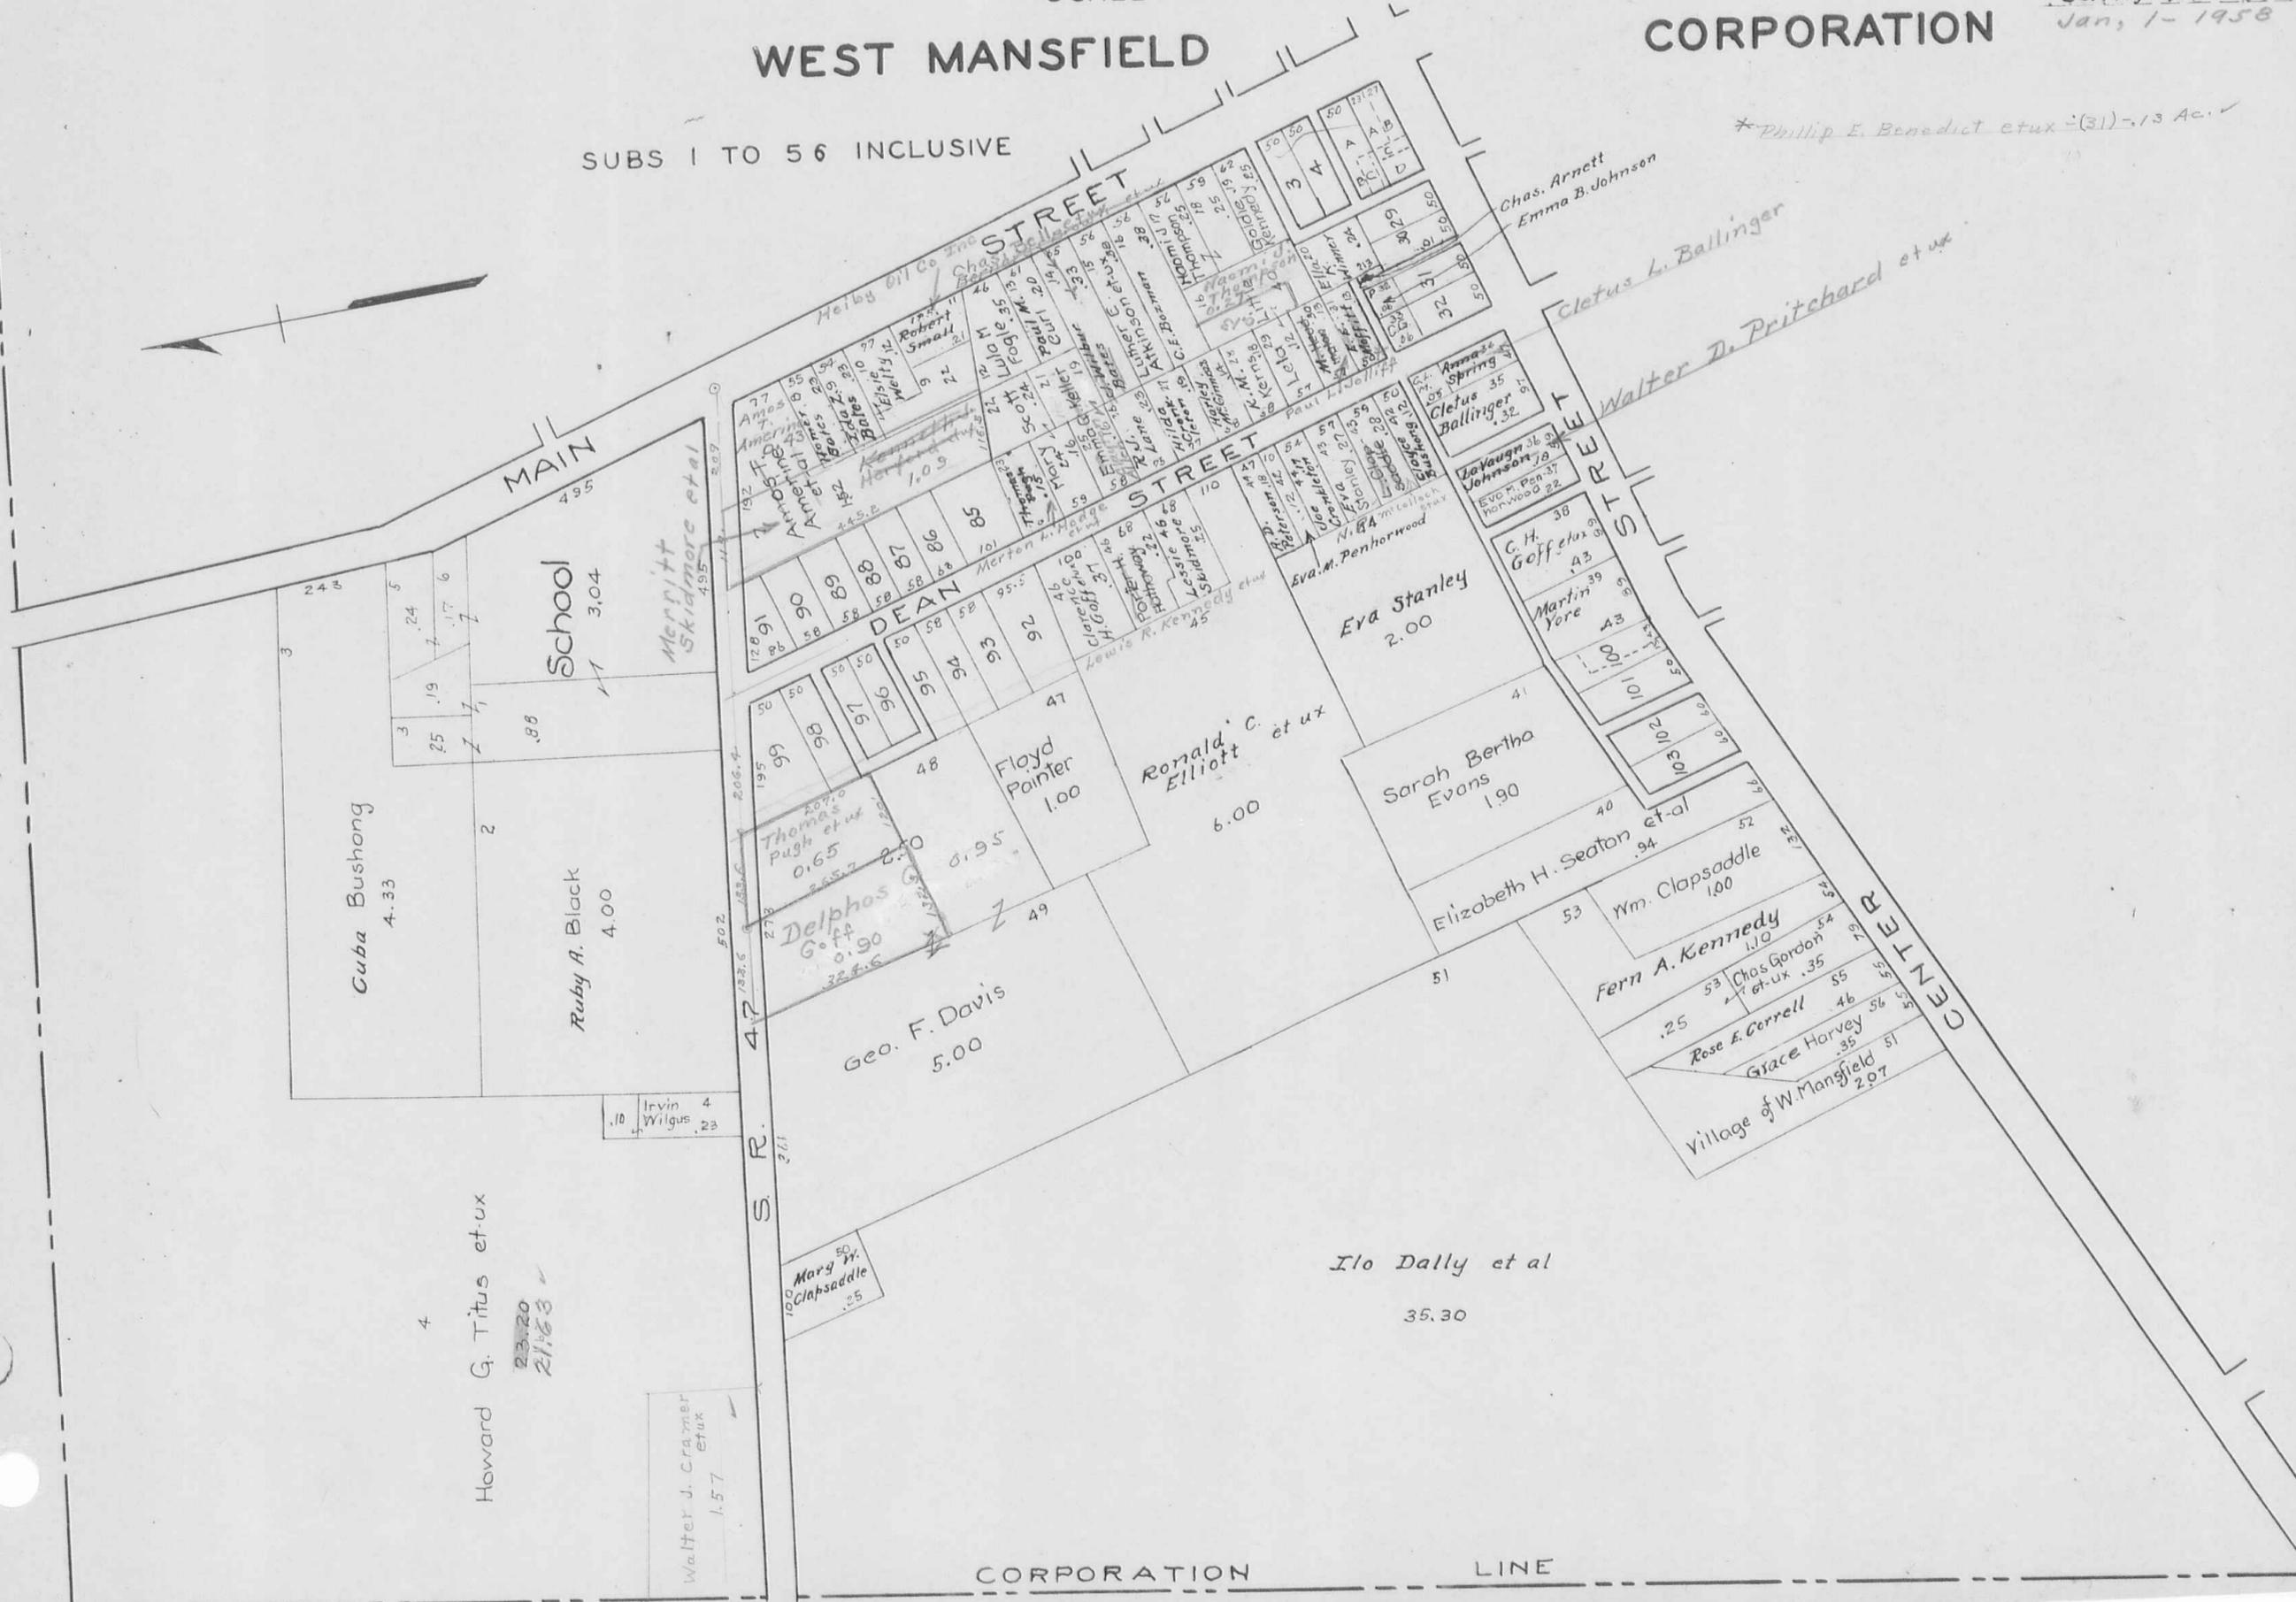

*Phillip E. Benedict et ux - (31) - 13 Ac.

Chas. Arnett
Emma B. Johnson

Cletus L. Ballinger

Walter D. Pritchard et ux

Merritt Skidmore et al

School

Eva Stanley
2.00

Ronald C. Elliott et ux
6.00

Sarah Bertha
Evans
1.90

Elizabeth H. Seaton et al
.94

Fern A. Kennedy
1.10

Rose E. Correll
46

Grace Harvey
.35

Village of W. Mansfield
2.07

Geo. F. Davis
5.00

Ruby A. Black
4.00

Cuba Bushong
4.33

Howard G. Titus et ux
23.20
21.63

Walter J. Cramer et ux
1.57

Mary W. Clapsaddle
.25

CORPORATION LINE

VIRGINIA MILITARY SURVEYS 755 6155

SCALE 1-INCH = 200 FEET

CORRECTED TO Jan. 1, 1955

WEST MANSFIELD CORPORATION


